

DRAWING INDEX	
GENERAL DRAWINGS	
XC-001	COVER SHEET AND DRAWING INDEX
PLAN DRAWINGS	
XC-A101	EAST BOWL PLAN
XC-D101	360 PLAN VIEW
ELEVATIONS	
XC-A201	EAST BOWL WEST ELEVATION
DETAILS	
XC-A501	EAST BOWL - SECTION & DETAILS @ CANOPY ROOF
XC-A502	EAST BOWL - WING WALL PLAN DETAILS
XC-A503	EAST BOWL - WING WALL ZEPP DETAILS
XC-A504	EAST BOWL - TYP ZEPP DETAILS
XC-A505	EAST BOWL - BACK KNIFE EDGE DETAIL
XC-A506	EAST BOWL - ANCHOR DETAILS
XC-D501	360 - TYPICAL CANOPY CROSS SECTION & DETAILS
XC-D502	360 - CANOPY CROSS SECTION AT WALKING PATH


miispel


# CITY OF SCOTTSDALE CIVIC CENTER PLAZA

RITOCH-POWELL  
**RPA** & Associates  
602-263-1177  
WWW.RPAENG.COM

**LAKE | FLATO**  
© 2021 Lake|Flato Architects, Inc.  
311 THIRD STREET  
SAN ANTONIO, TEXAS 78205  
P 210.227.3335 F 210.224.9515  
www.lakeflato.com

**ZAHNER**  
ARCHITECTURAL METAL  
1400 EAST NINTH STREET  
KANSAS CITY, MO 64106  
TEL: (816) 474-8882  
FAX: (816) 474-7994  
WWW.AZAHNER.COM

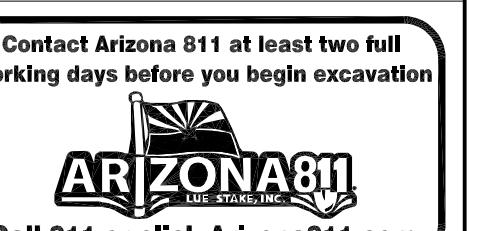SET ISSUE DATES				
DATE	ISSUE			
01/20/22 100% DRAWINGS				
<hr/> <hr/> <hr/>				
REVISIONS				
NO.	DATE	DESCRIPTION		
<hr/> <hr/> <hr/>				
Contact Arizona 811 at least two full working days before you begin excavation				
 Call 811 or click <a href="http://Arizona811.com">Arizona811.com</a>				
DATE: 01/20/2022 REVISION: BY:				
		PUBLIC WORKS		
		CAPITAL PROJECT MANAGEMENT		
		7447 E. INDIAN SCHOOL RD. SCOTTSDALE, ARIZONA 85251		
SHEET TITLE				
COVER SHEET AND DRAWING INDEX				
PROJECT TITLE CITY OF SCOTTSDALE CIVIC CENTER PLAZA				
THIS SHEET SCALED FOR 24X36" BORDER	SCALE DRAWN DS	DESIGNED AS-BUILT	BID NO. COS PROJECT NO. DG04	XC-001

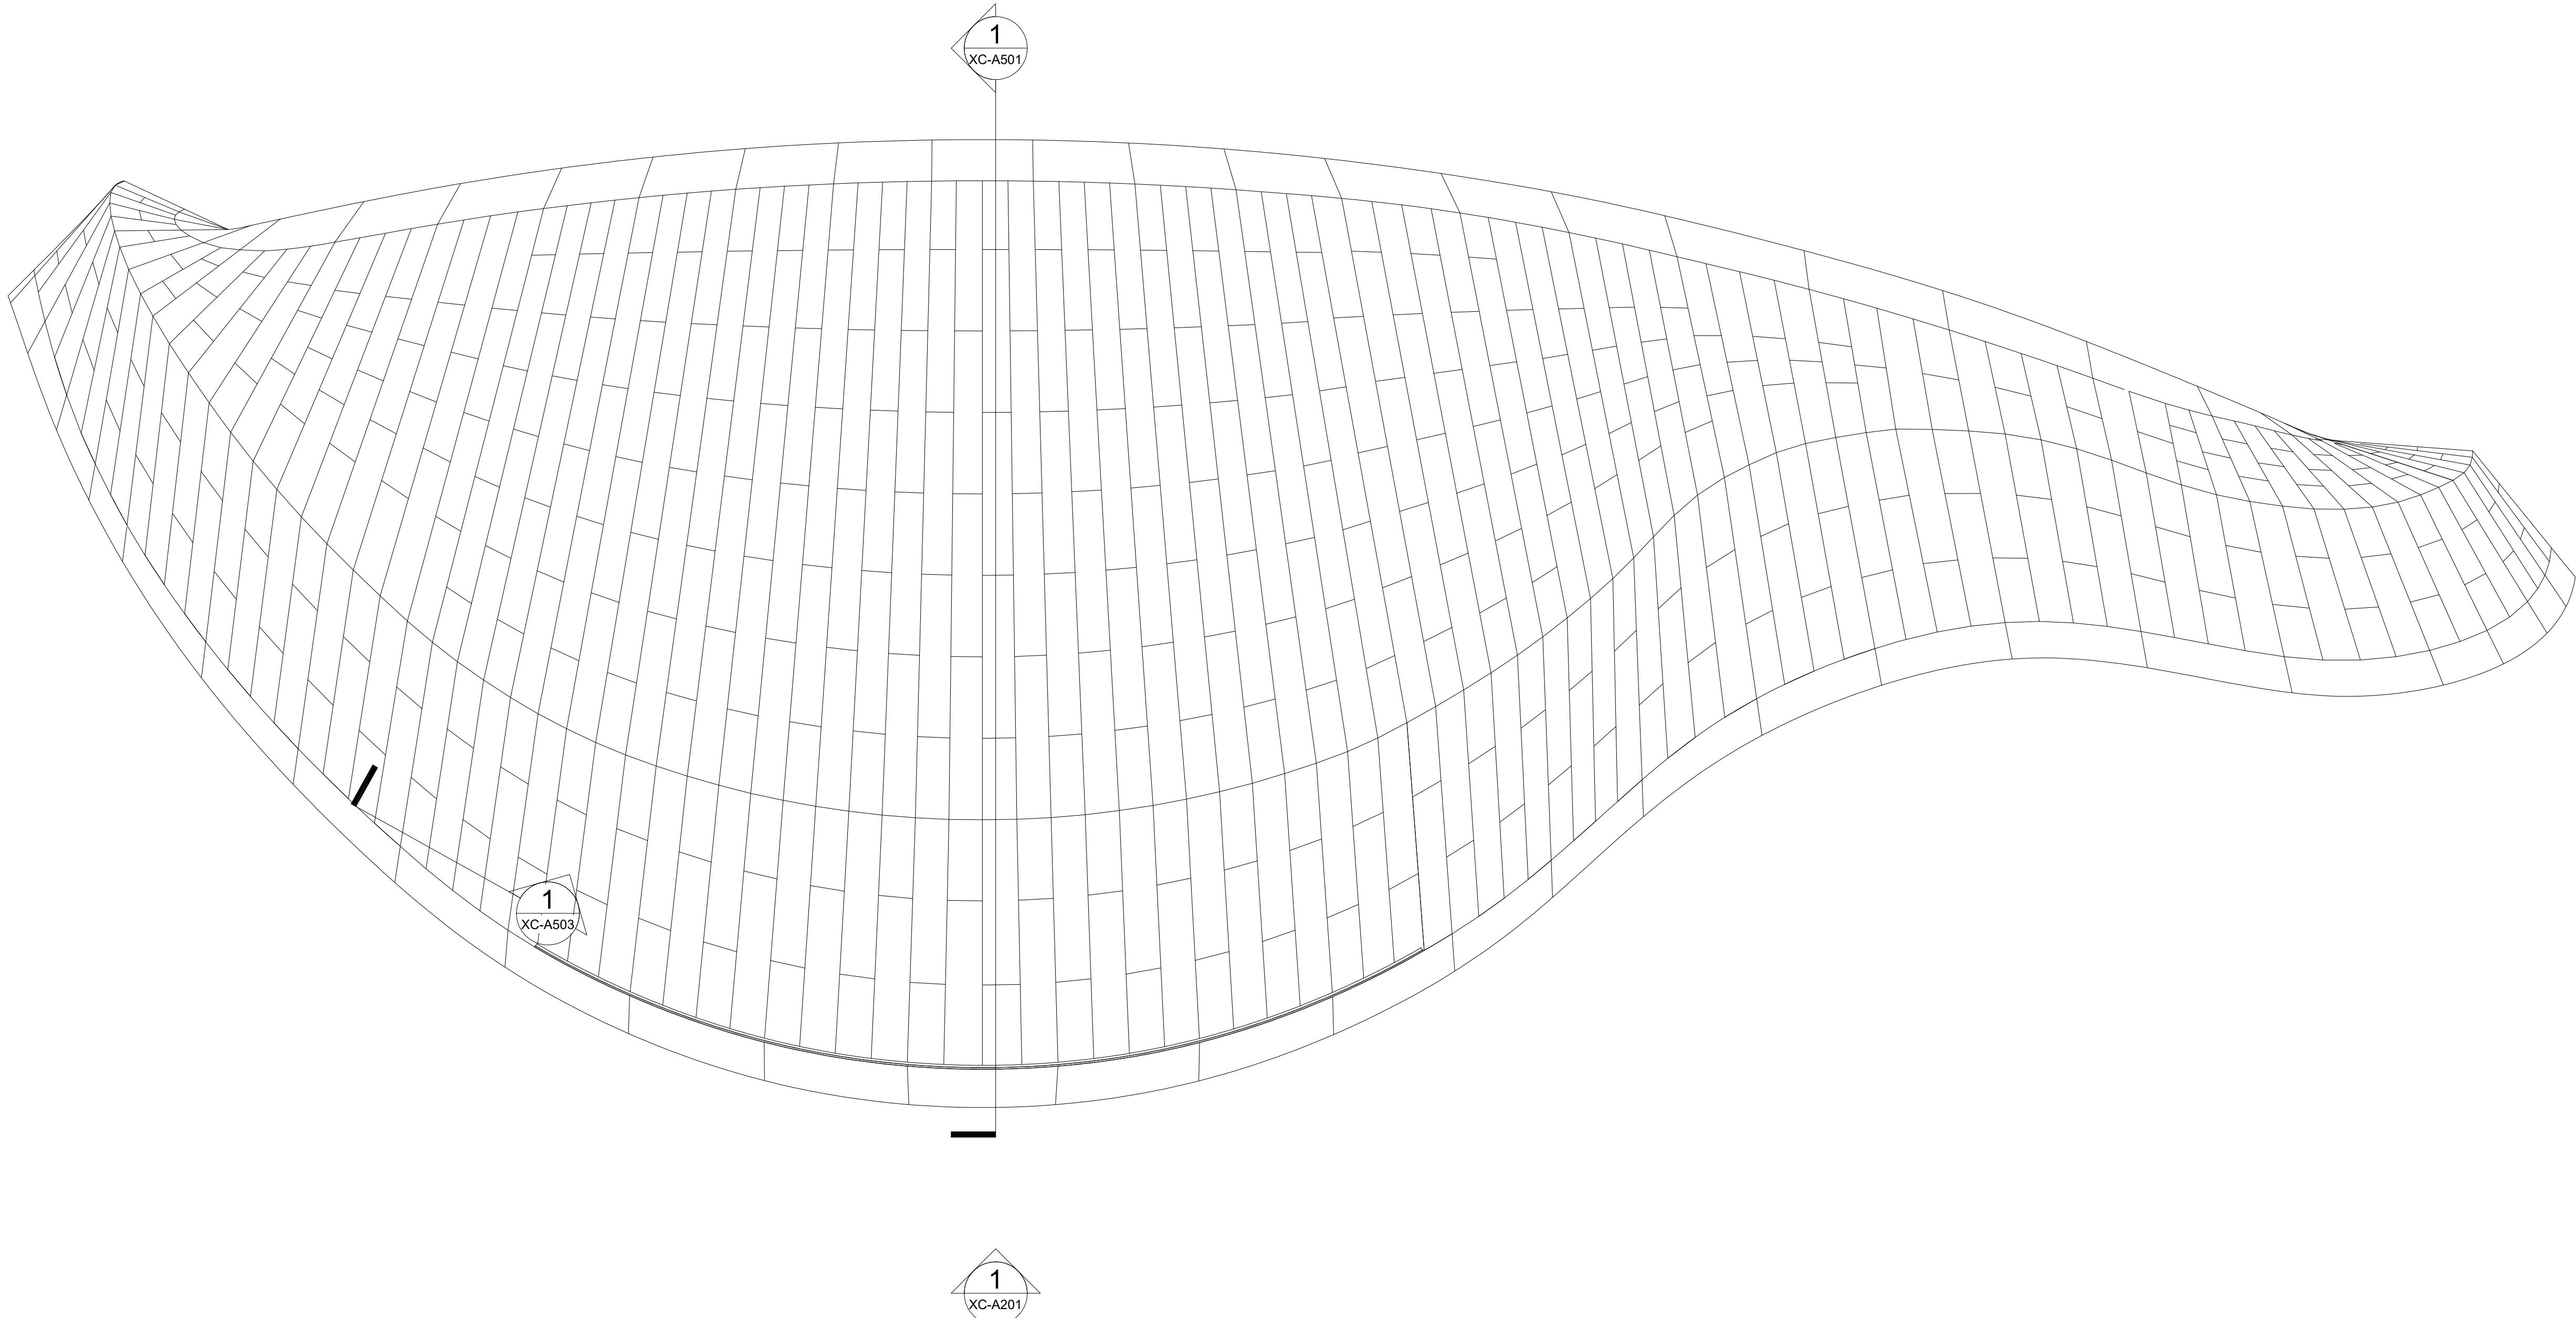


**EAST BOWL PLAN VIEW**

SCALE: 3/16" = 1'-0"

ZAHNER REF: N/A  
ARCH REF: N/A

SET ISSUE DATES		
DATE	ISSUE	
01/20/22 100% DRAWINGS		

REVISIONS		
NO.	DATE	DESCRIPTION

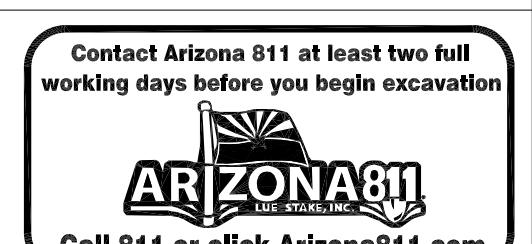


DATE: 01/20/2022		REVISION:	BY:
ENGINEER		PUBLIC WORKS	
		CAPITAL PROJECT MANAGEMENT	
		7447 E. INDIAN SCHOOL RD., SCOTTSDALE, ARIZONA 85251	
SHEET TITLE			

**EAST BOWL PLAN**

PROJECT TITLE		CITY OF SCOTTSDALE CIVIC CENTER PLAZA	
---------------	--	--	--

THIS SHEET SCALED FOR 24X36" BORDER	SCALE	DESIGNED	BID NO.	XC-A101
	DRAWN DS	AS-BUILT	COS PROJECT NO. DG04	

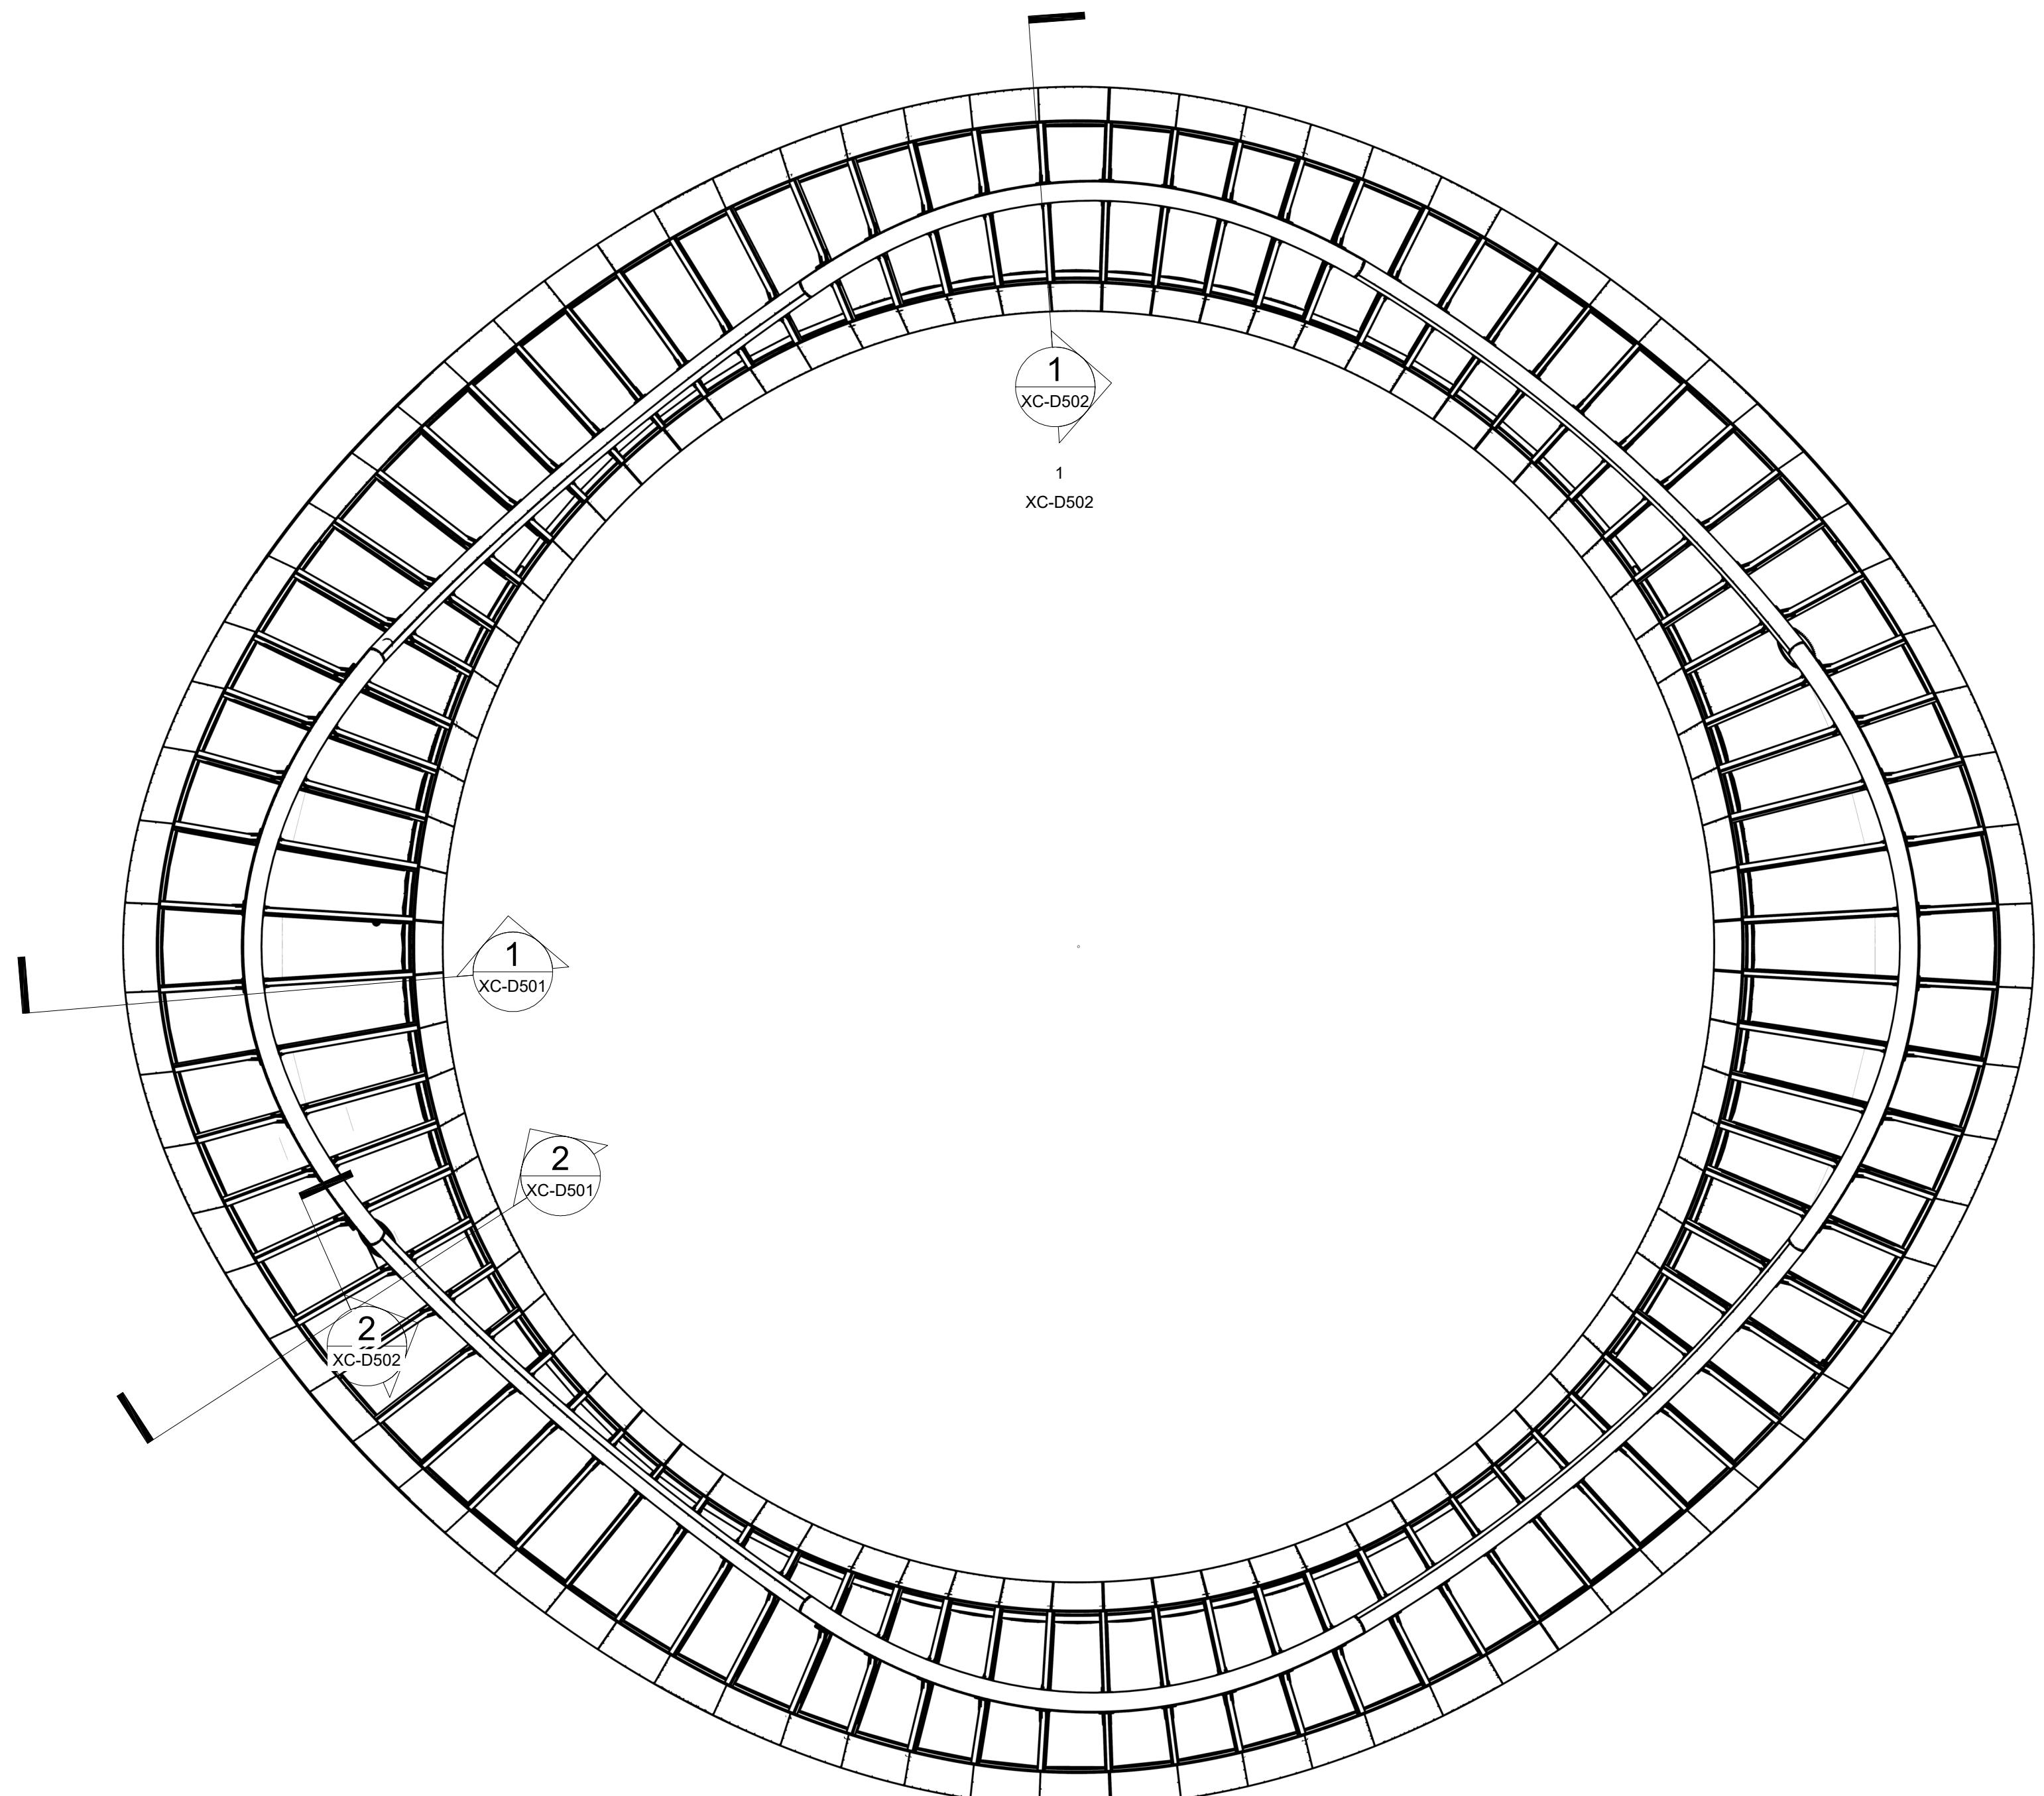

1 360 CANOPY - PLAN VIEW

SCALE: 1/8" = 1'-0"

ZAHNER REF: XX  
ARCH REF: XX

**360 CANOPY PLAN**

PROJECT TITLE CITY OF SCOTTSDALE  
CIVIC CENTER PLAZA

THIS SHEET SCALED FOR 24X36" BORDER	SCALE	DESIGNED	BID NO.	XC-D101
		DRAWN DS	AS-BUILT	COS PROJECT NO. DG04


SET ISSUE DATES  
DATE ISSUE  
01/20/22 100% DRAWINGS

REVISIONS

NO. DATE DESCRIPTION




DATE: 01/20/2022	REVISION:	BY:
ENGINEER		PUBLIC WORKS
		CAPITAL PROJECT MANAGEMENT
SHEET TITLE		
CITY OF SCOTTSDALE CIVIC CENTER PLAZA		
PROJECT TITLE		
SCOTTSDALE, ARIZONA 85251		

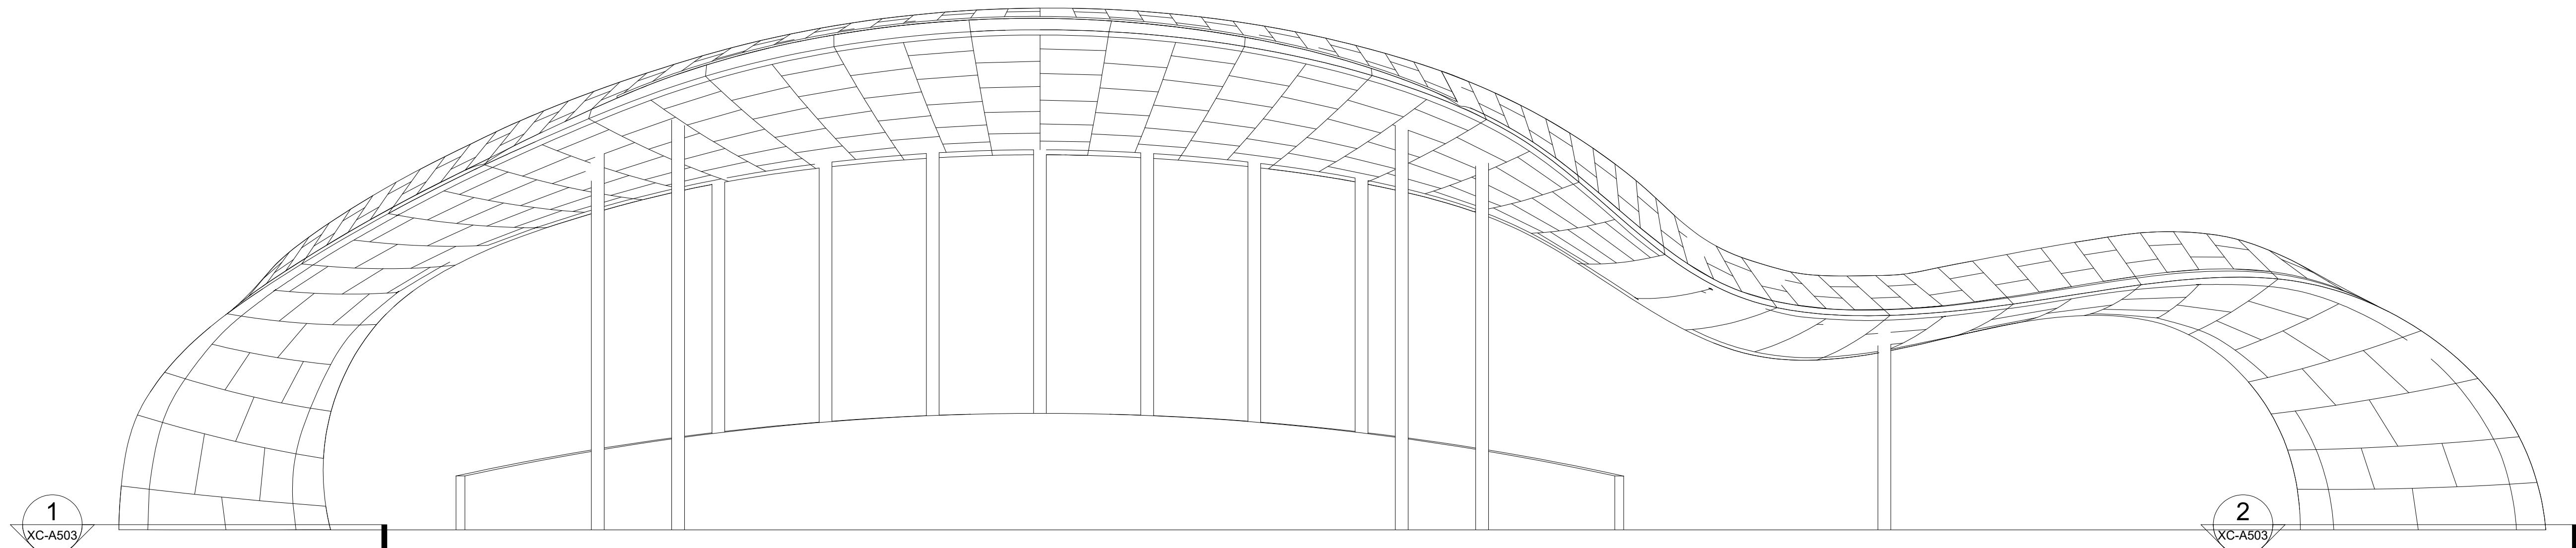

① EAST BOWL WEST ELEVATION  
SCALE: 3/16" = 1'-0"  
ZAHNER REF: N/A  
ARCH REF: N/A

SET ISSUE DATES		
DATE	ISSUE	BY:
01/20/22 100% DRAWINGS		
REVISIONS		
NO.	DATE	DESCRIPTION

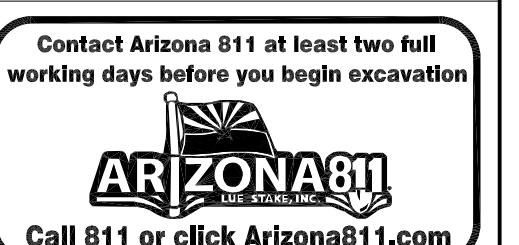


DATE: 01/20/2022	REVISION:	BY:
ENGINEER		PUBLIC WORKS
		CAPITAL PROJECT MANAGEMENT
SHEET TITLE  CITY OF SCOTTSDALE CIVIC CENTER PLAZA		


EAST BOWL WEST ELEVATION

PROJECT TITLE		CITY OF SCOTTSDALE CIVIC CENTER PLAZA	
DESIGNED	BID NO.	SCALE	XC-A201
DRAWN DS	AS-BUILT	COS PROJECT NO.	DG04


THIS SHEET SCALED  
FOR 24X36" BORDER

© 2021 Lake|Flato Architects, Inc.

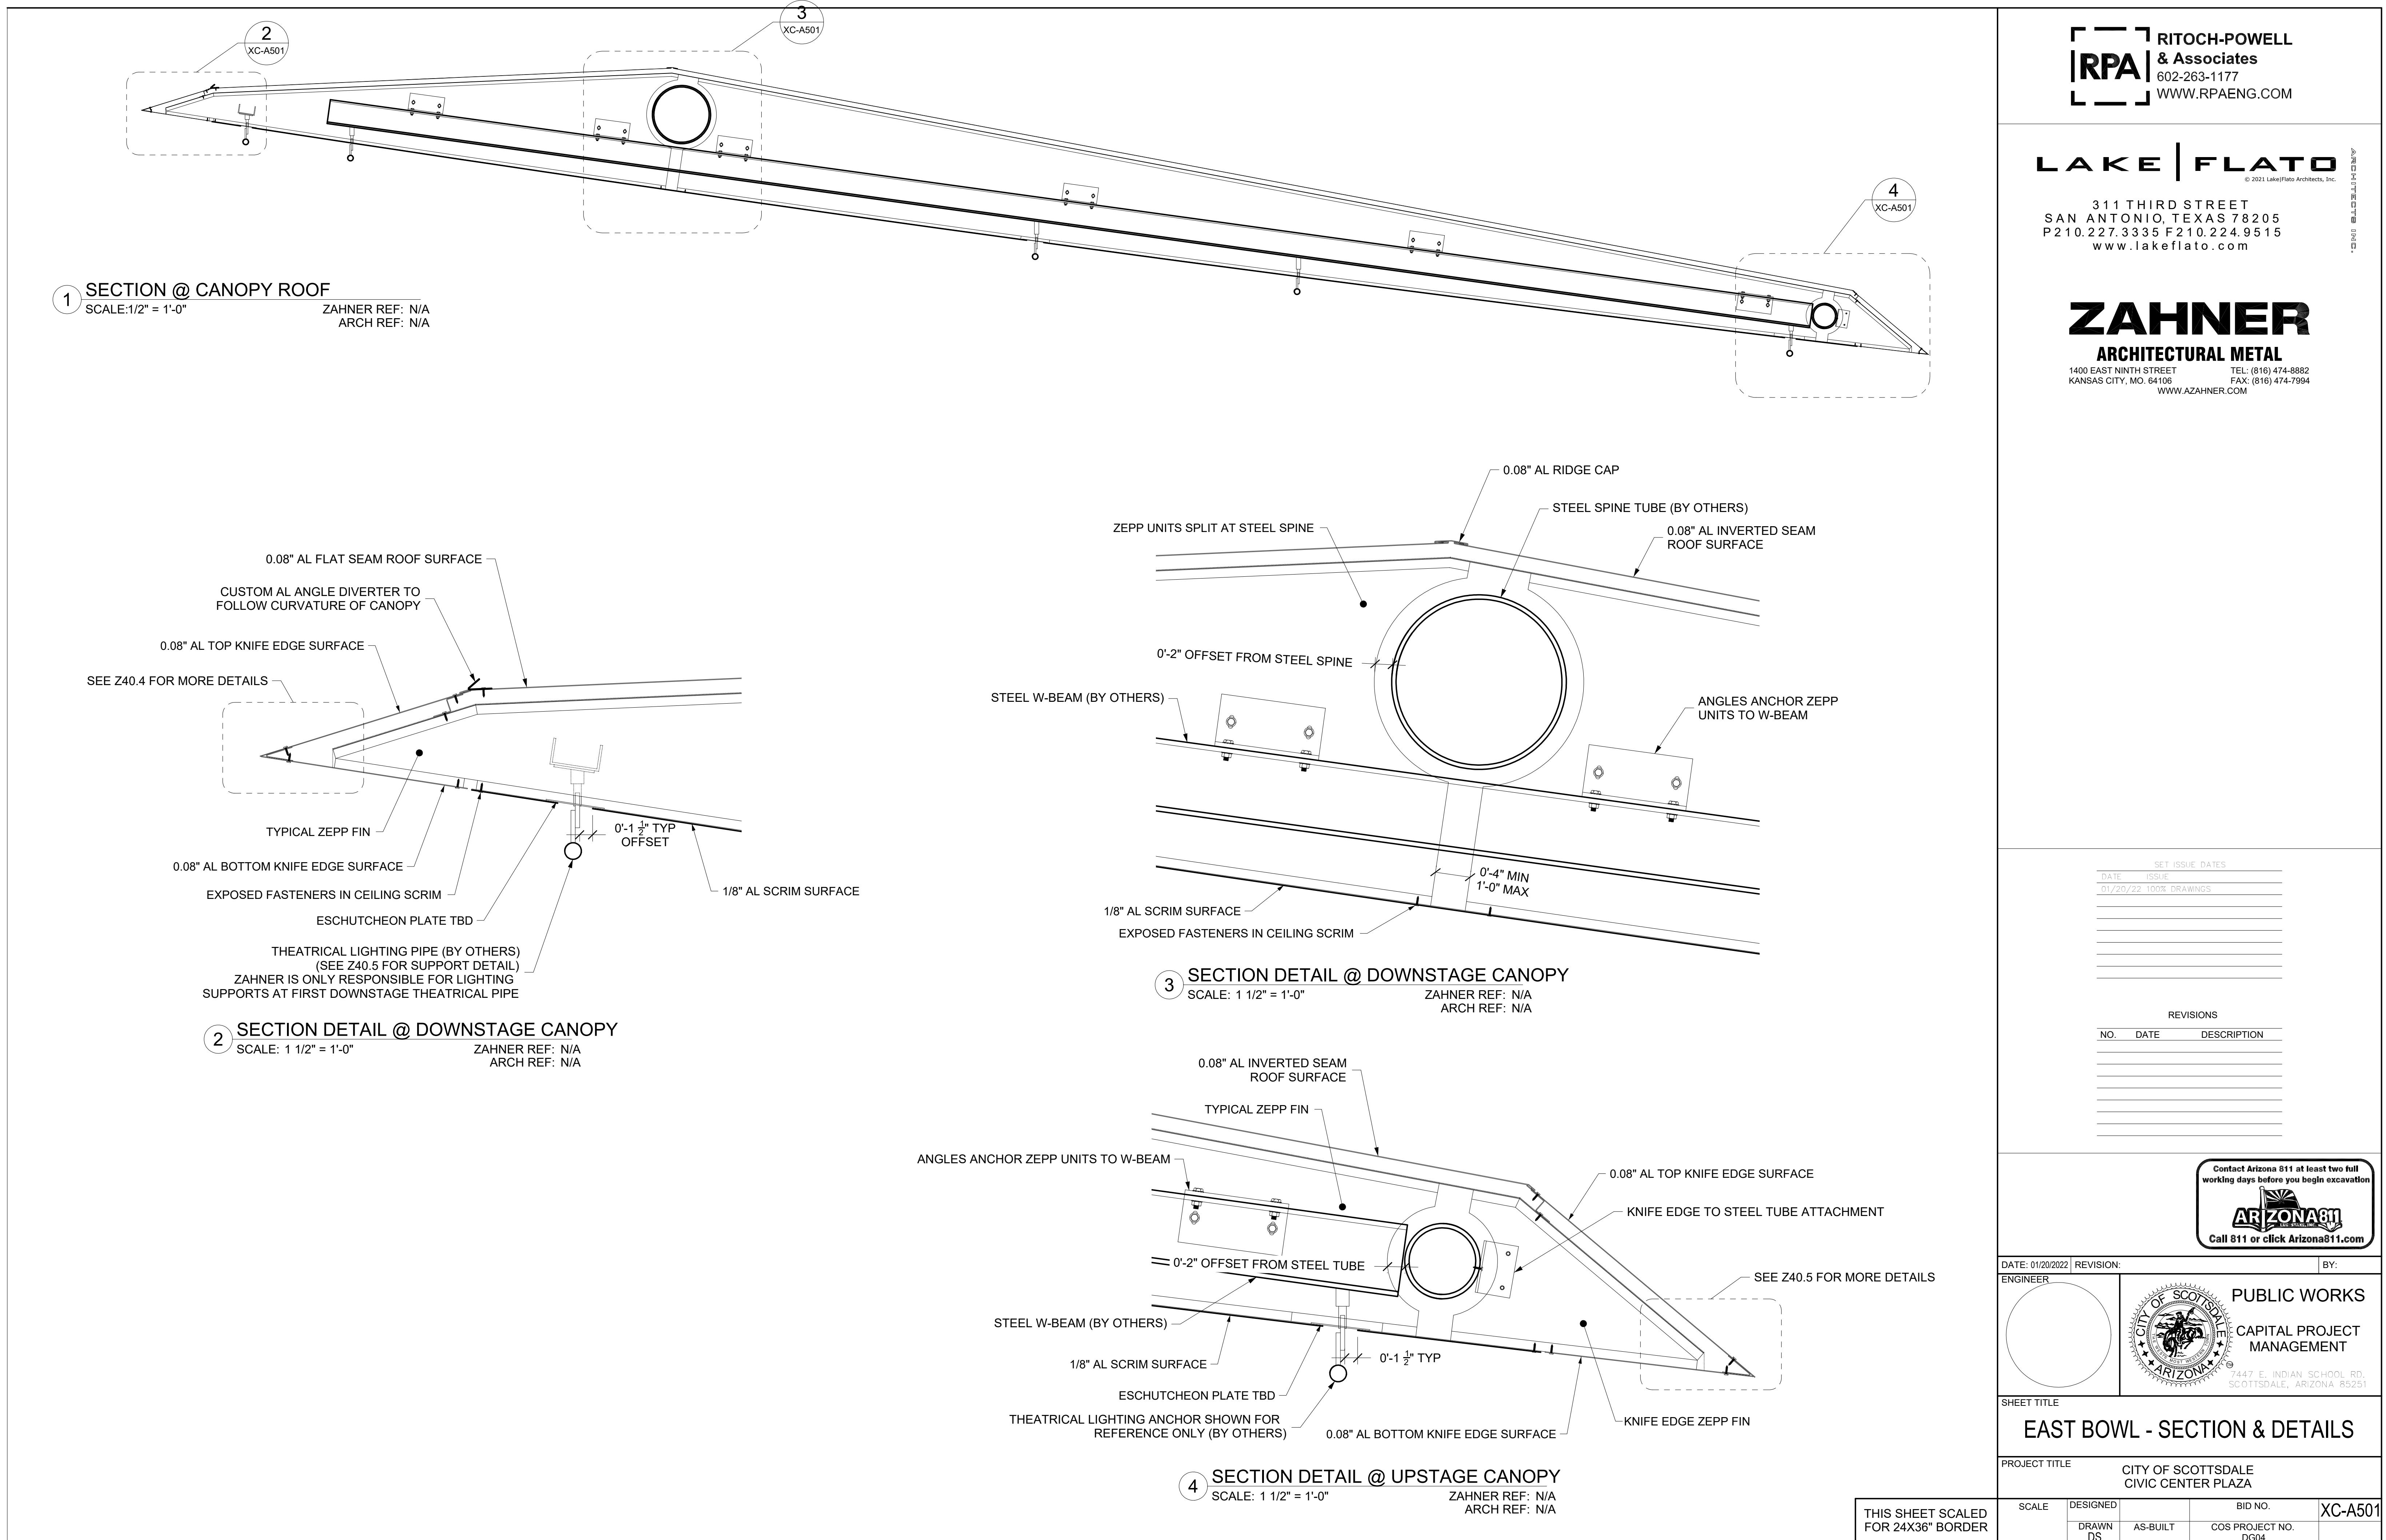


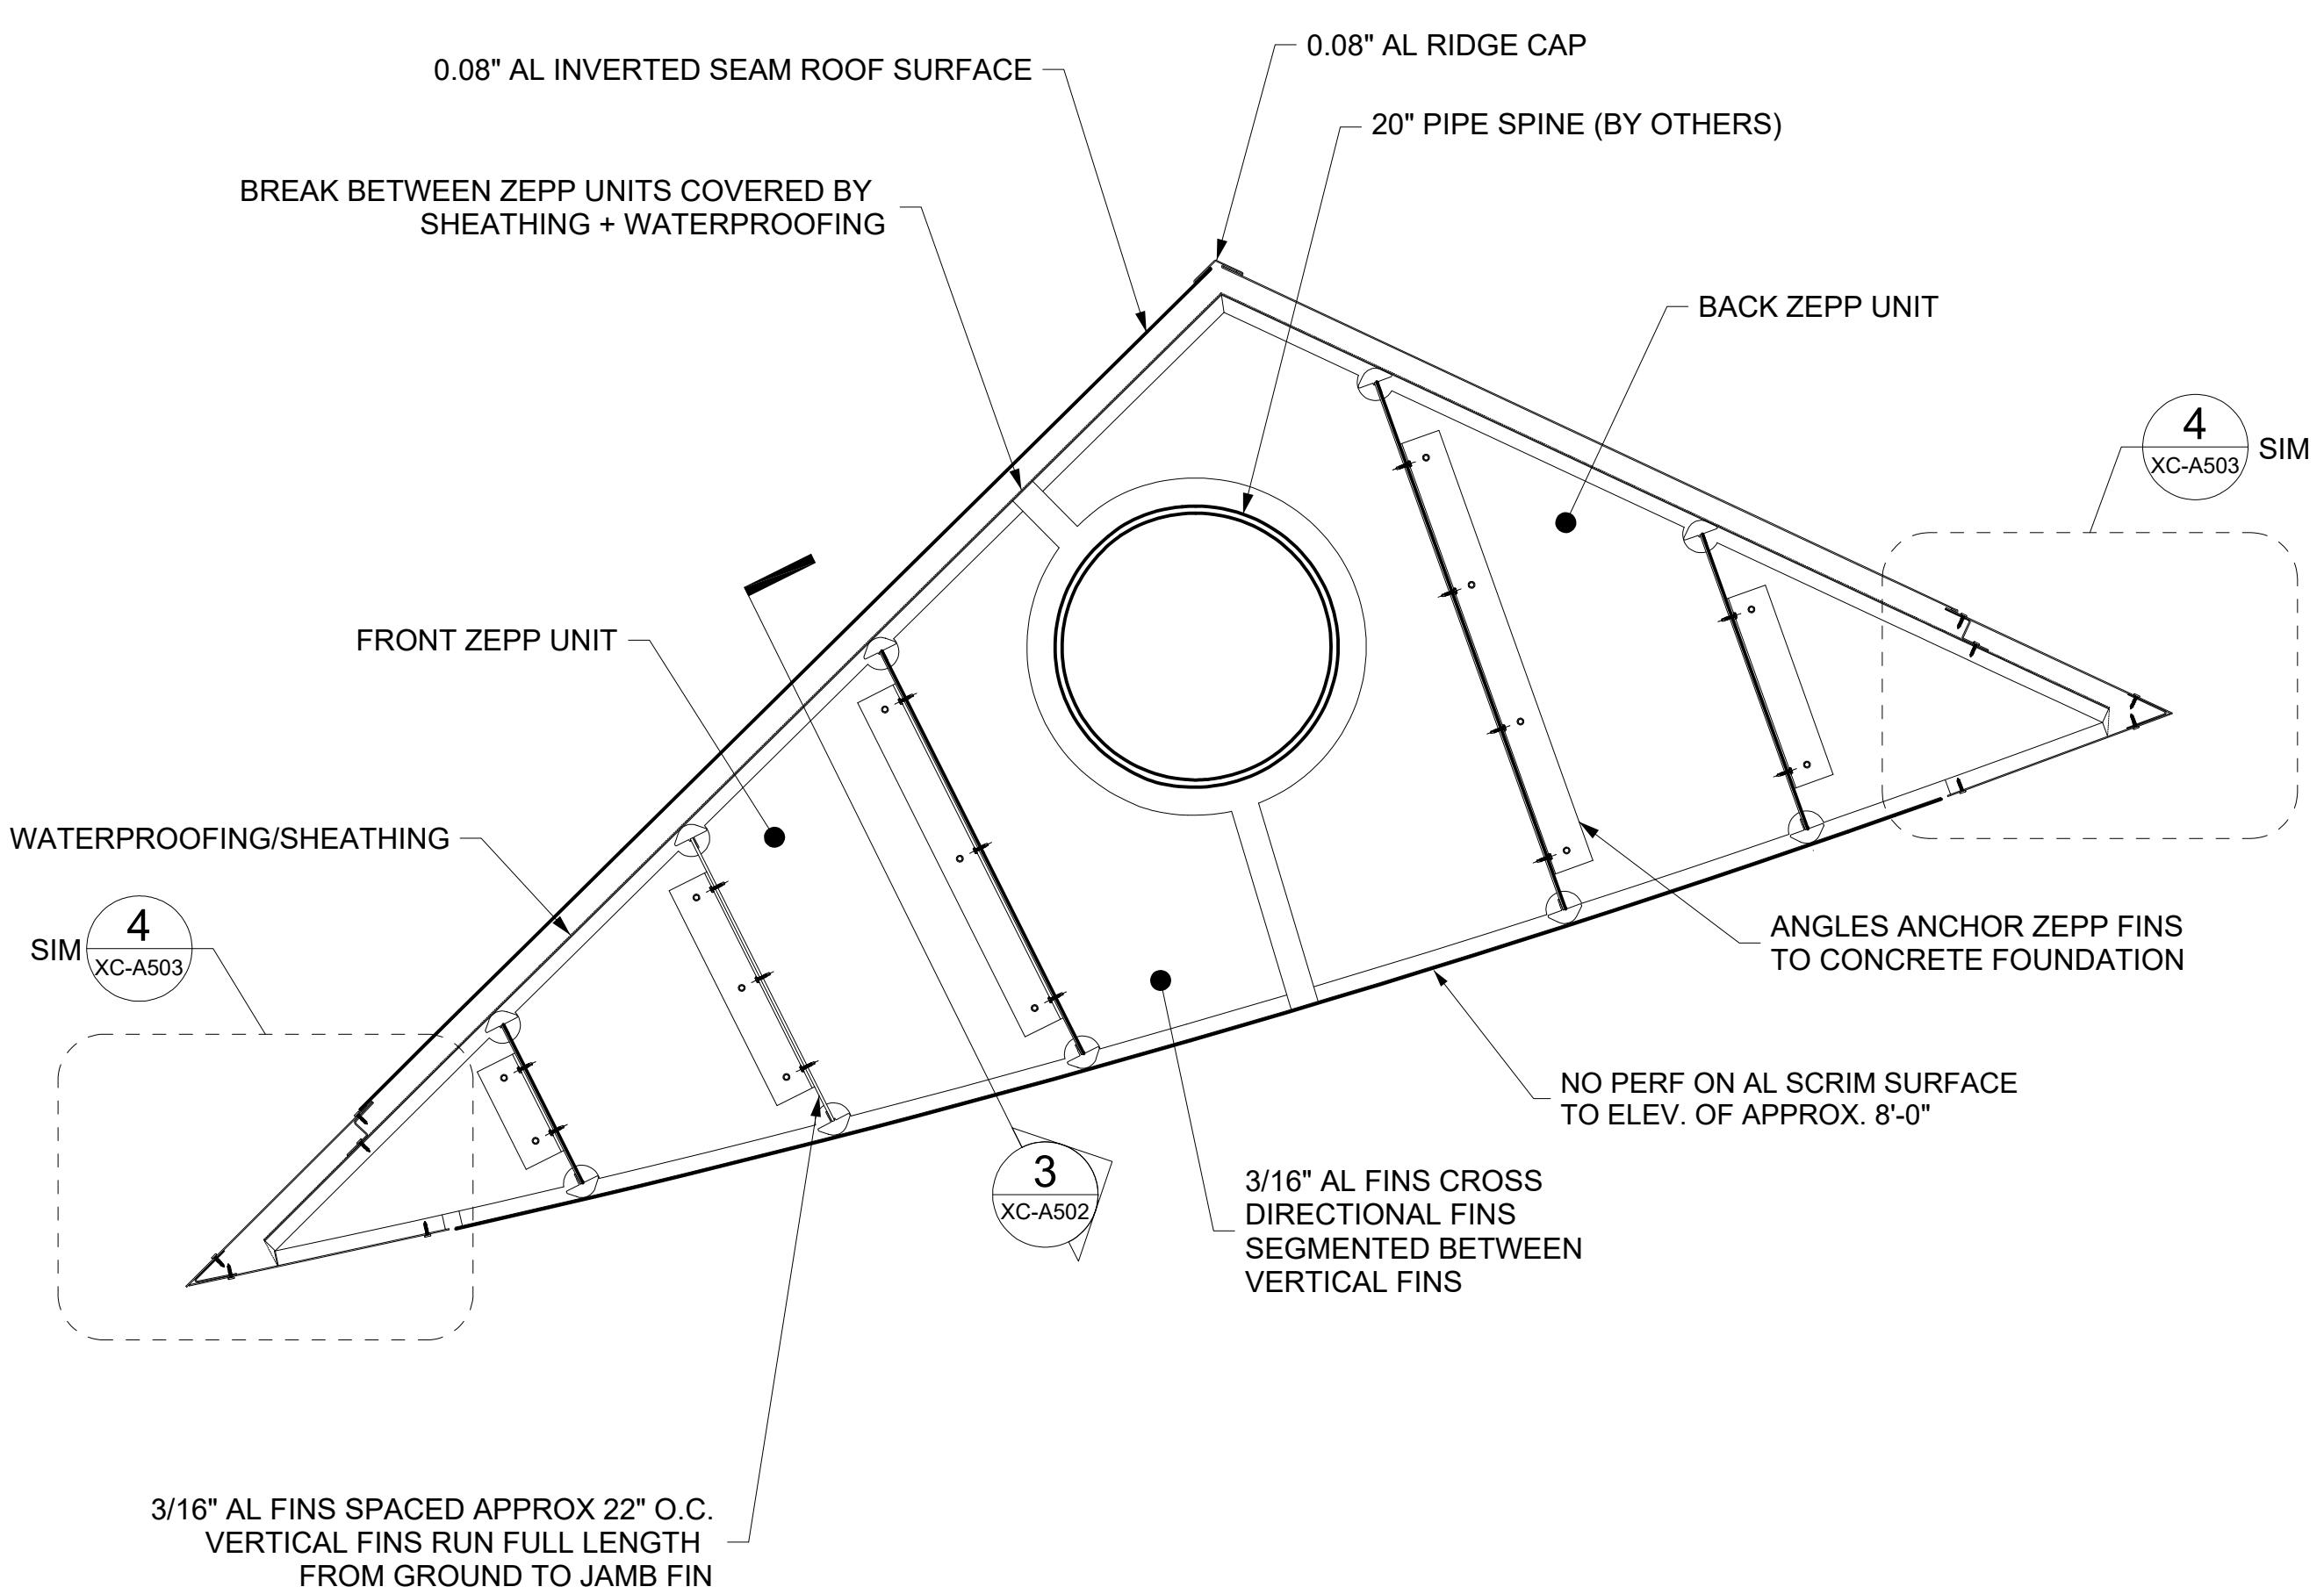

**1 PLAN DETAIL @ NORTH WING WALL**  
SCALE: 1" = 1'-0"  
ZAHNER REF: N/A  
ARCH REF: N/A

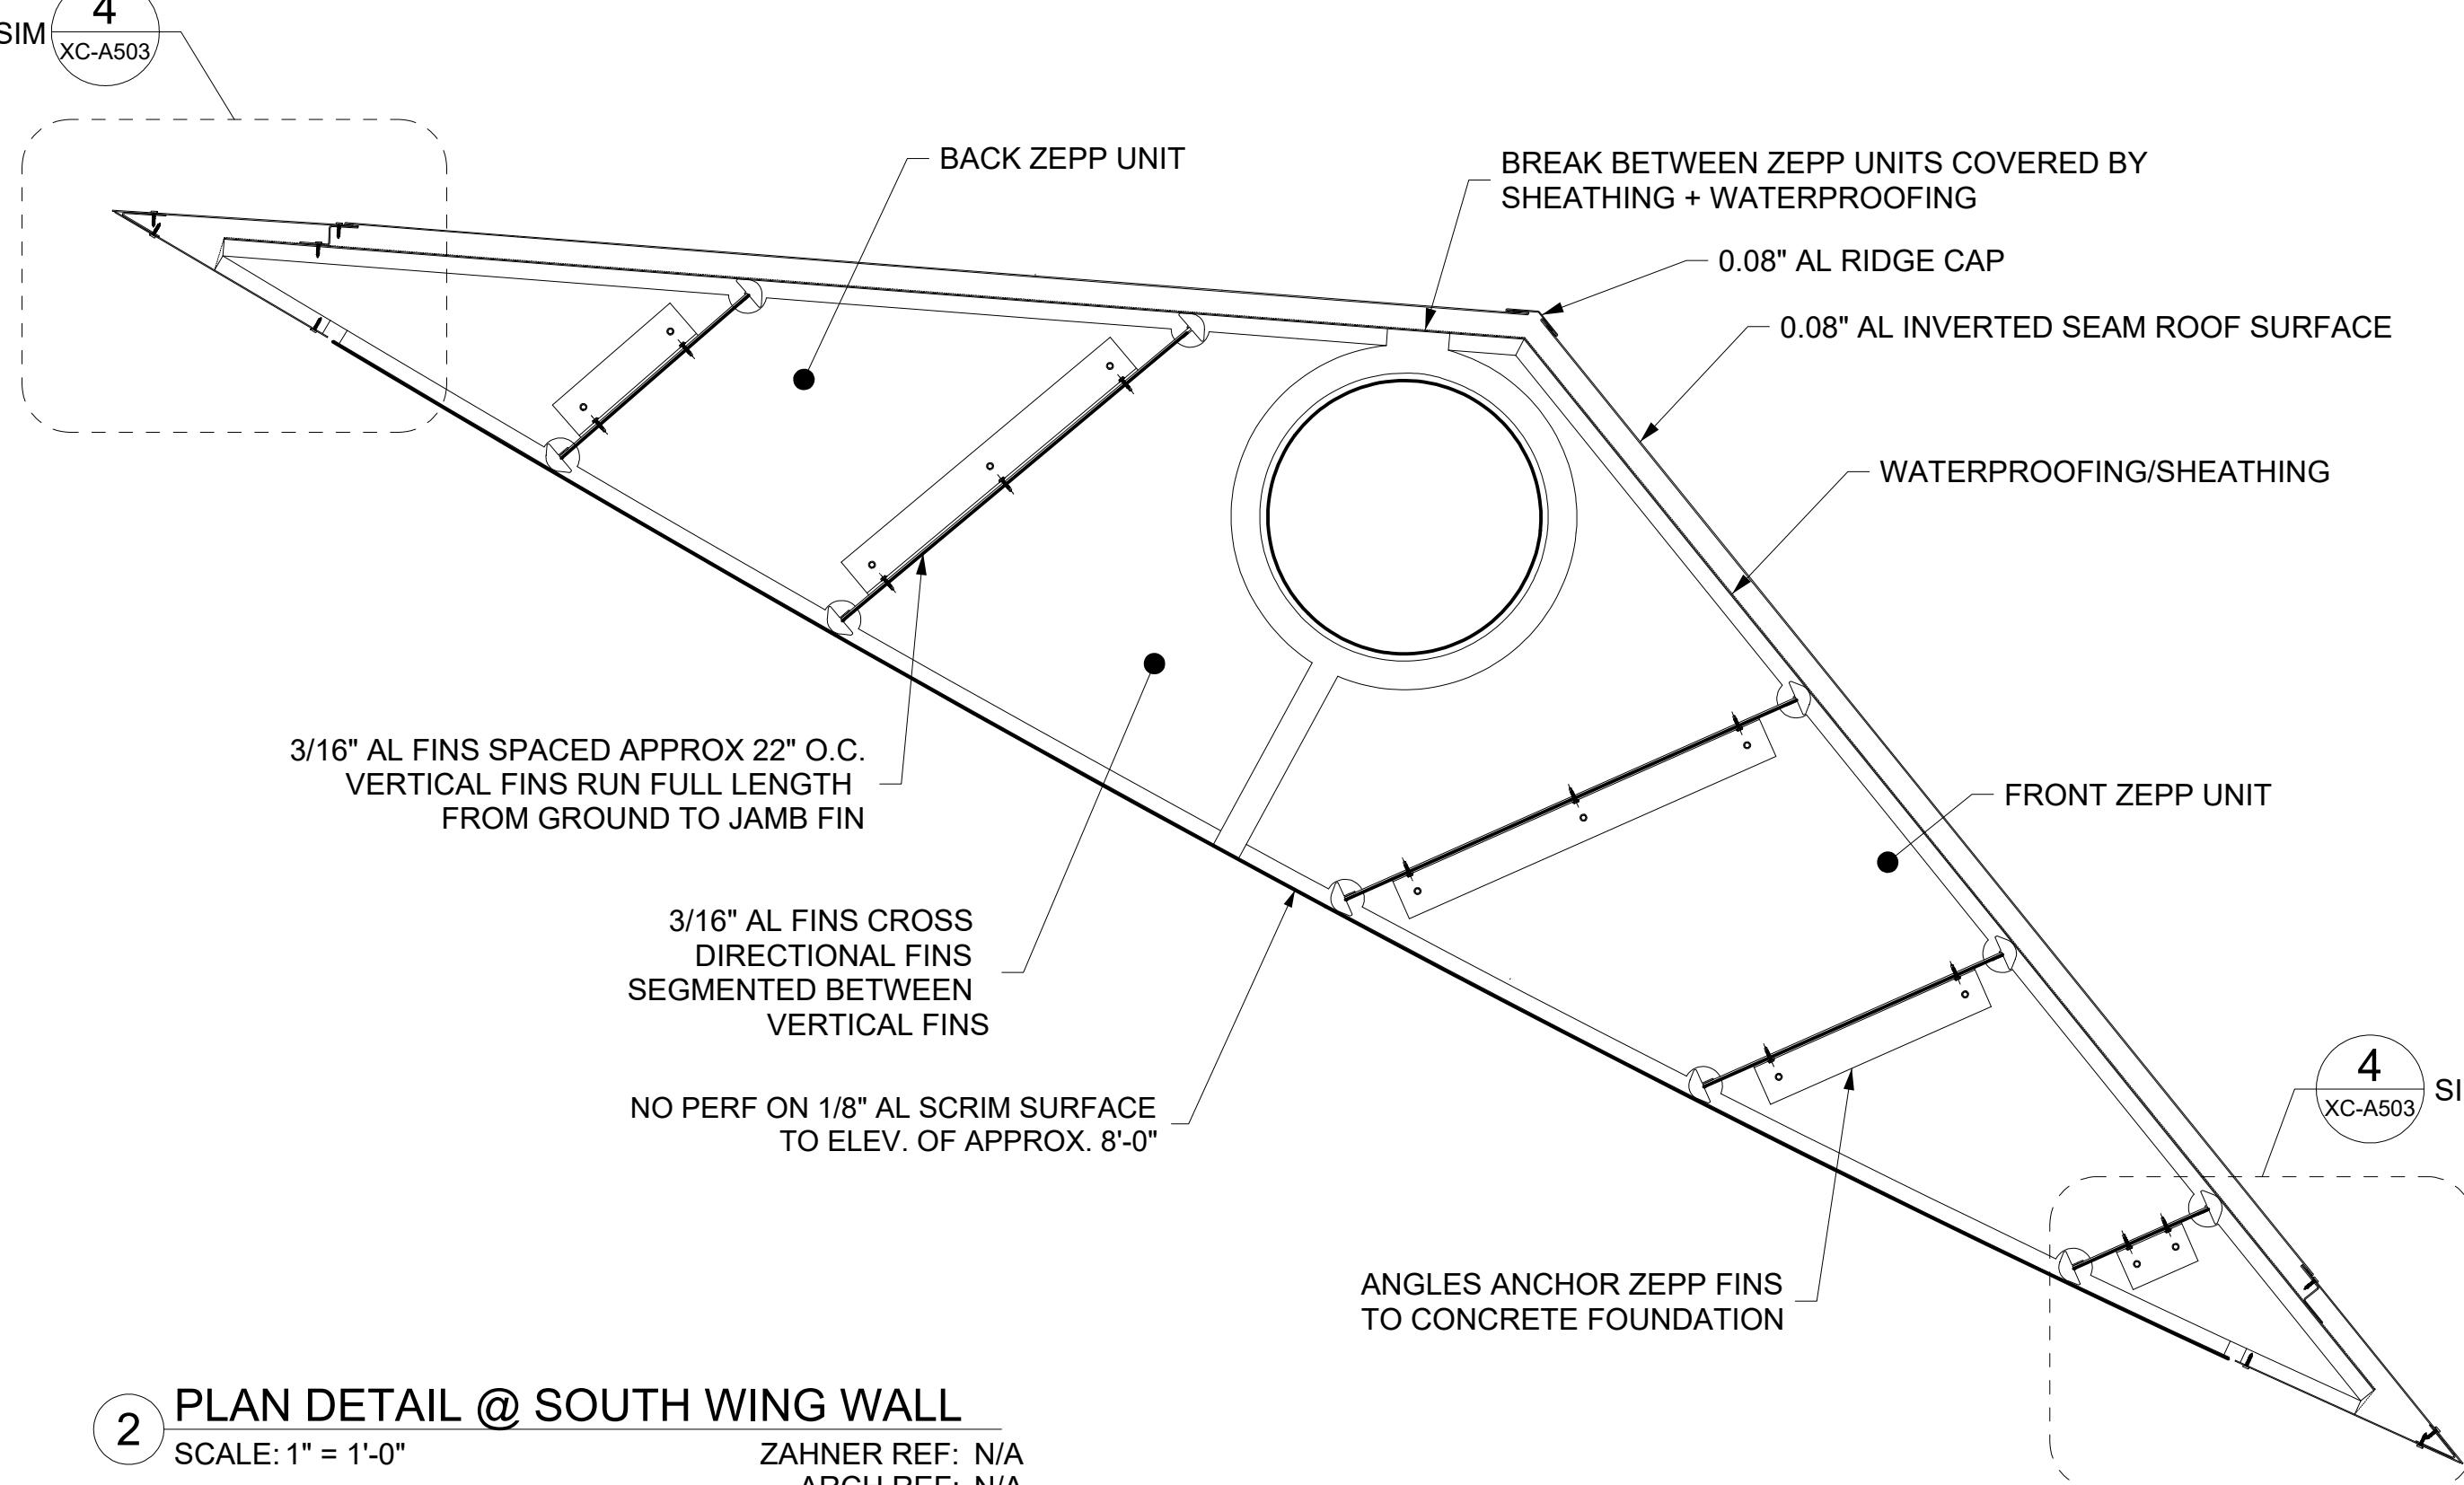


**2 PLAN DETAIL @ SOUTH WING WALL**  
SCALE: 1" = 1'-0"  
ZAHNER REF: N/A  
ARCH REF: N/A

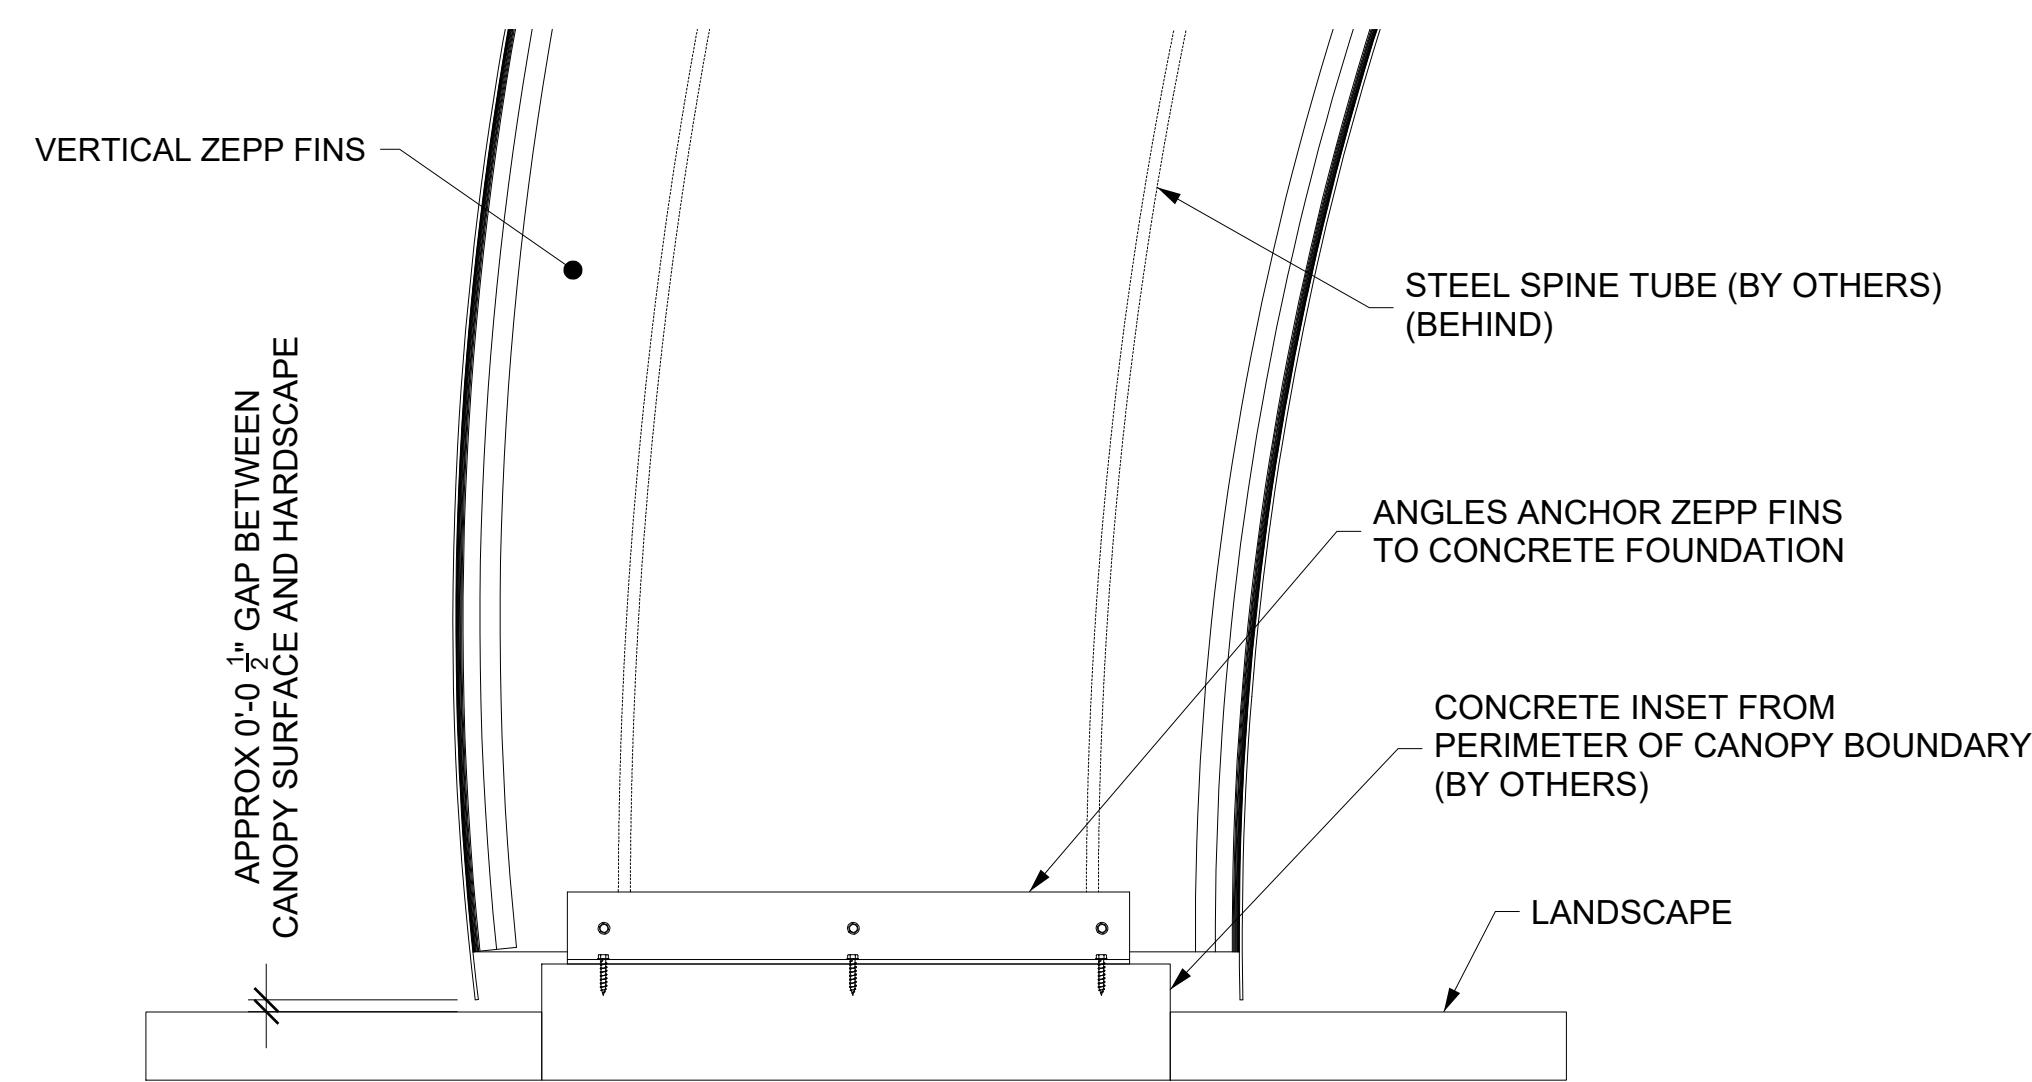

**3 SECTION DETAIL @ NORTH WING WALL**  
SCALE: 1 1/2" = 1'-0"  
ZAHNER REF: N/A  
ARCH REF: N/A

SET ISSUE DATES		
DATE	ISSUE	
01/20/22 100% DRAWINGS		
REVISIONS		
NO.	DATE	DESCRIPTION

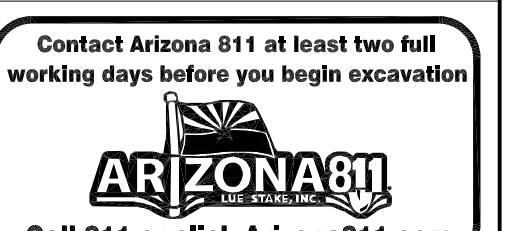


DATE: 01/20/2022	REVISION:	BY:
ENGINEER		PUBLIC WORKS
		CAPITAL PROJECT MANAGEMENT
7447 E. INDIAN SCHOOL RD., SCOTTSDALE, ARIZONA 85251		


**EAST BOWL - WING WALL PLAN DETAILS**

PROJECT TITLE: CITY OF SCOTTSDALE CIVIC CENTER PLAZA


THIS SHEET SCALED FOR 24X36" BORDER	SCALE	DESIGNED	BID NO.	XC-A502
	DRAWN DS	AS-BUILT	COS PROJECT NO. DG04	

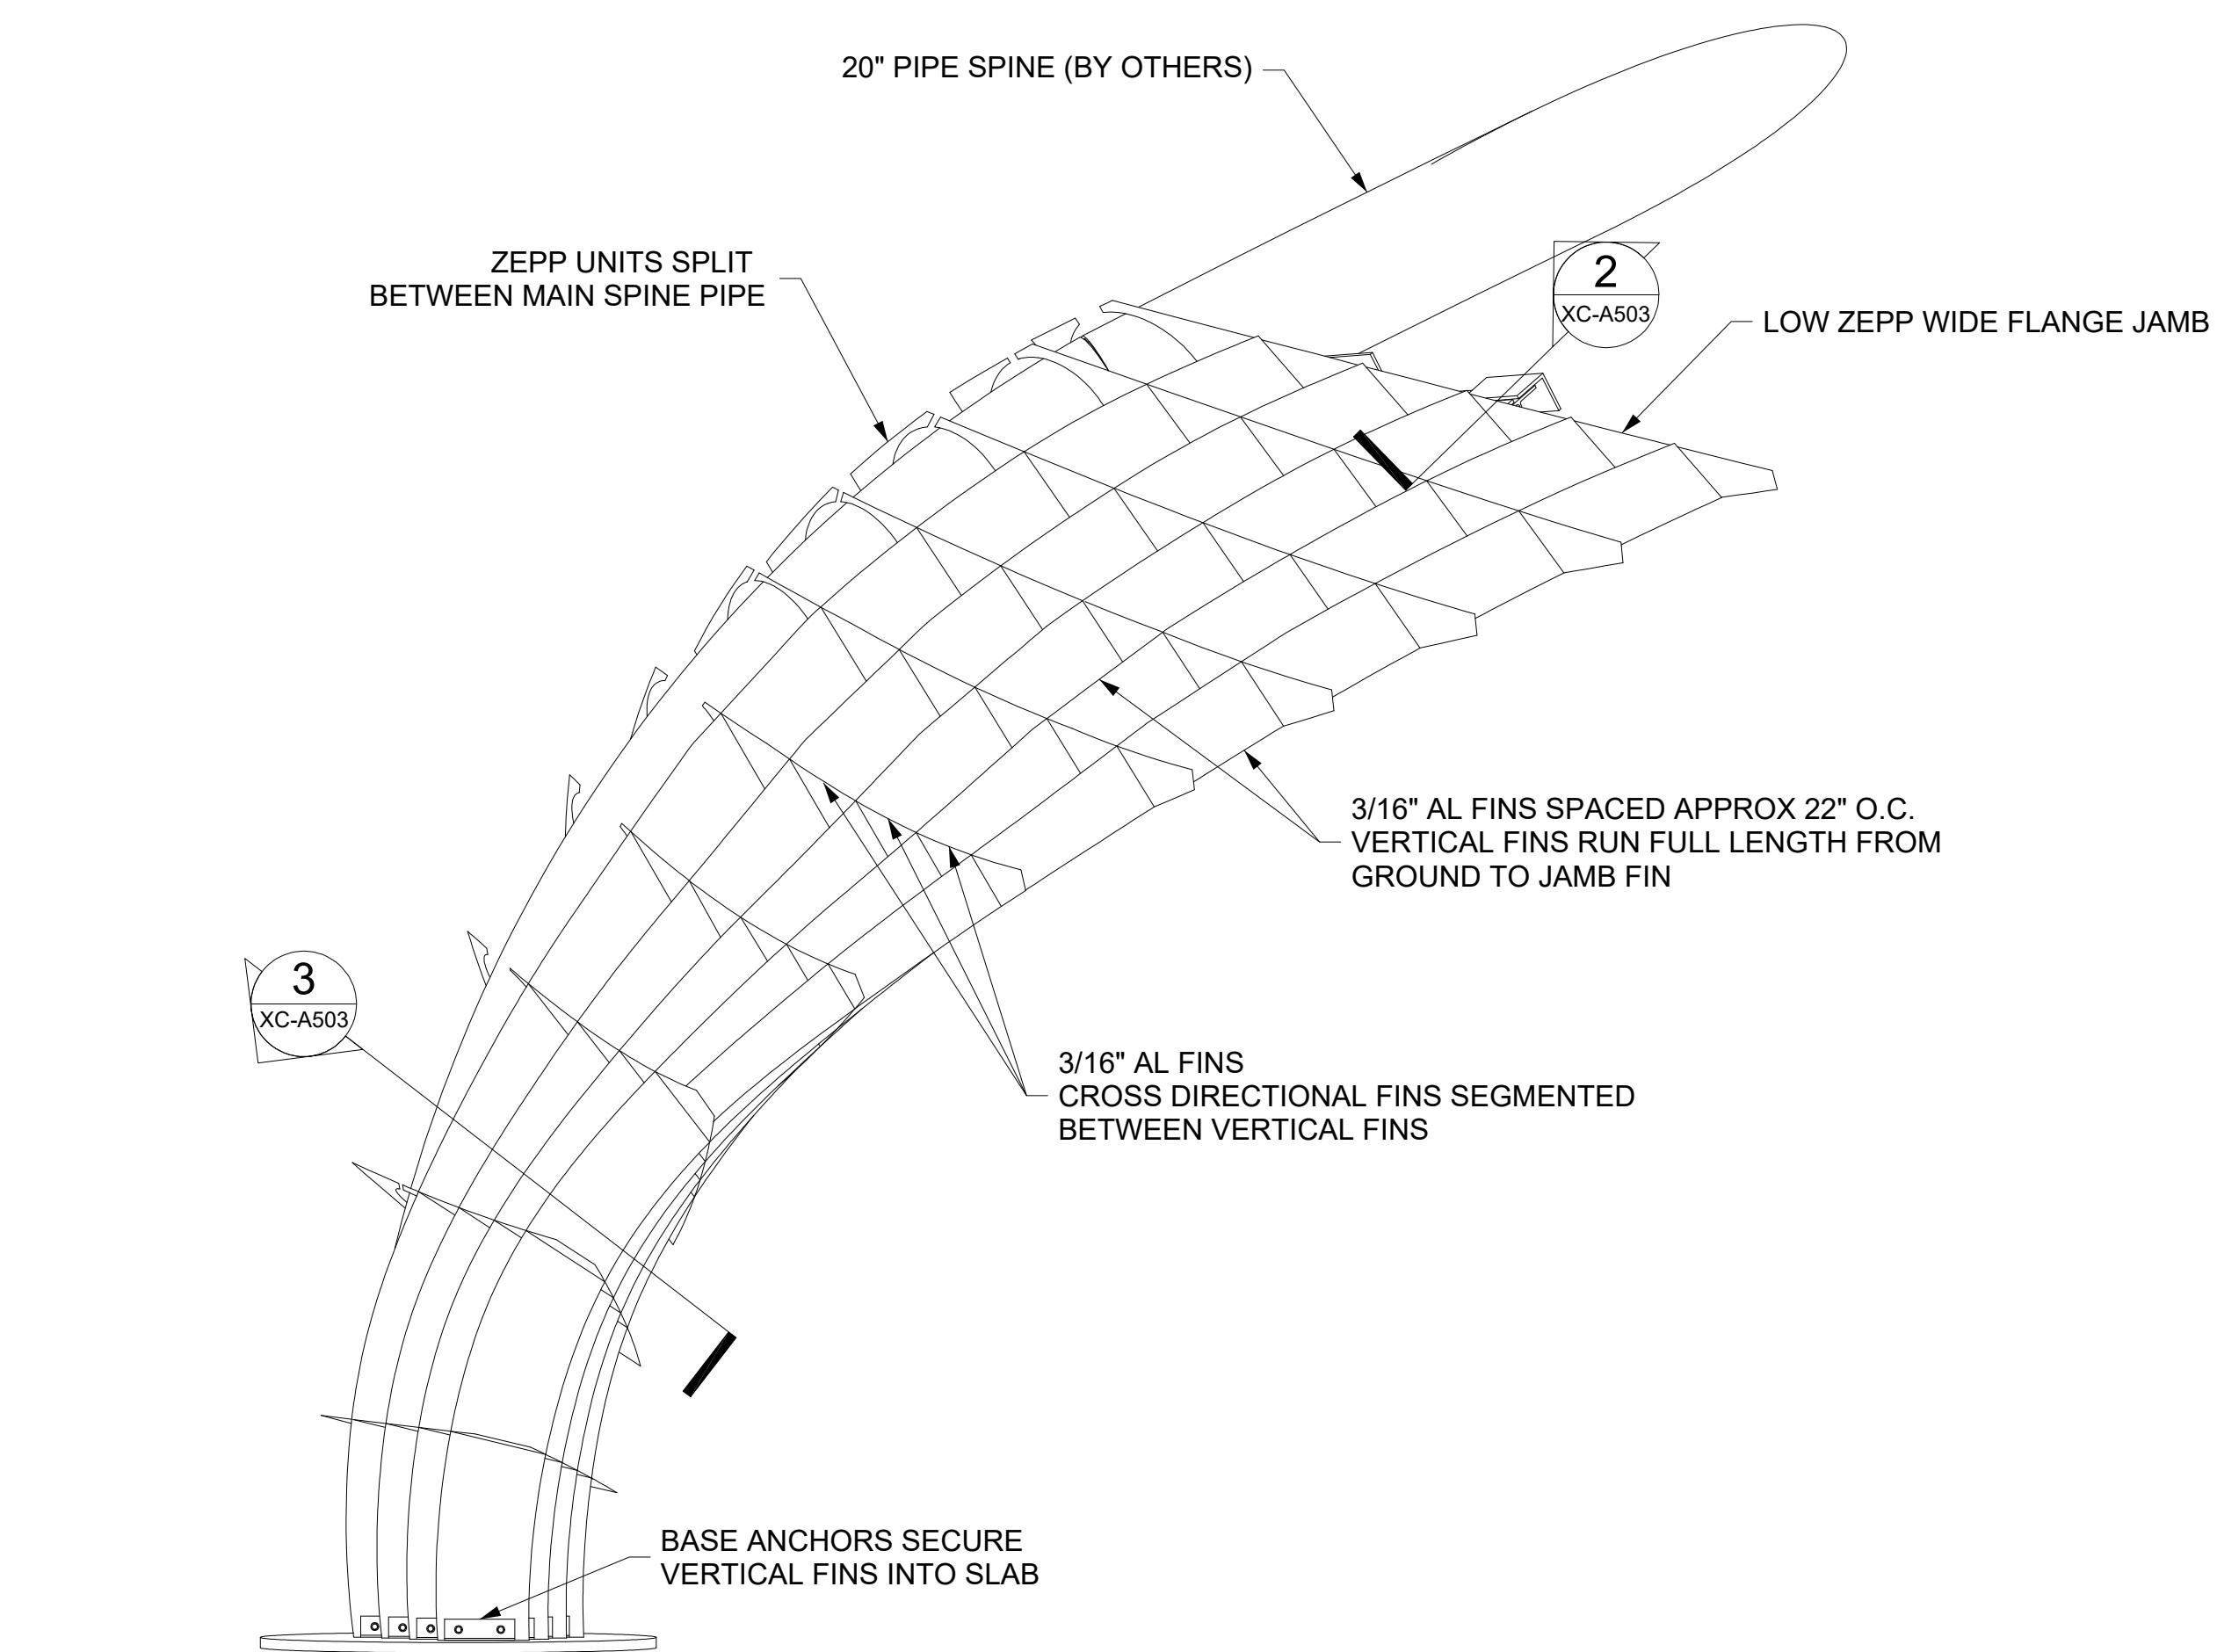


**1 WING WALL ZEPP SUB STRUCTURE**  
 SCALE: 1/2" = 1'-0"  
 ZAHNER REF: N/A  
 ARCH REF: N/A

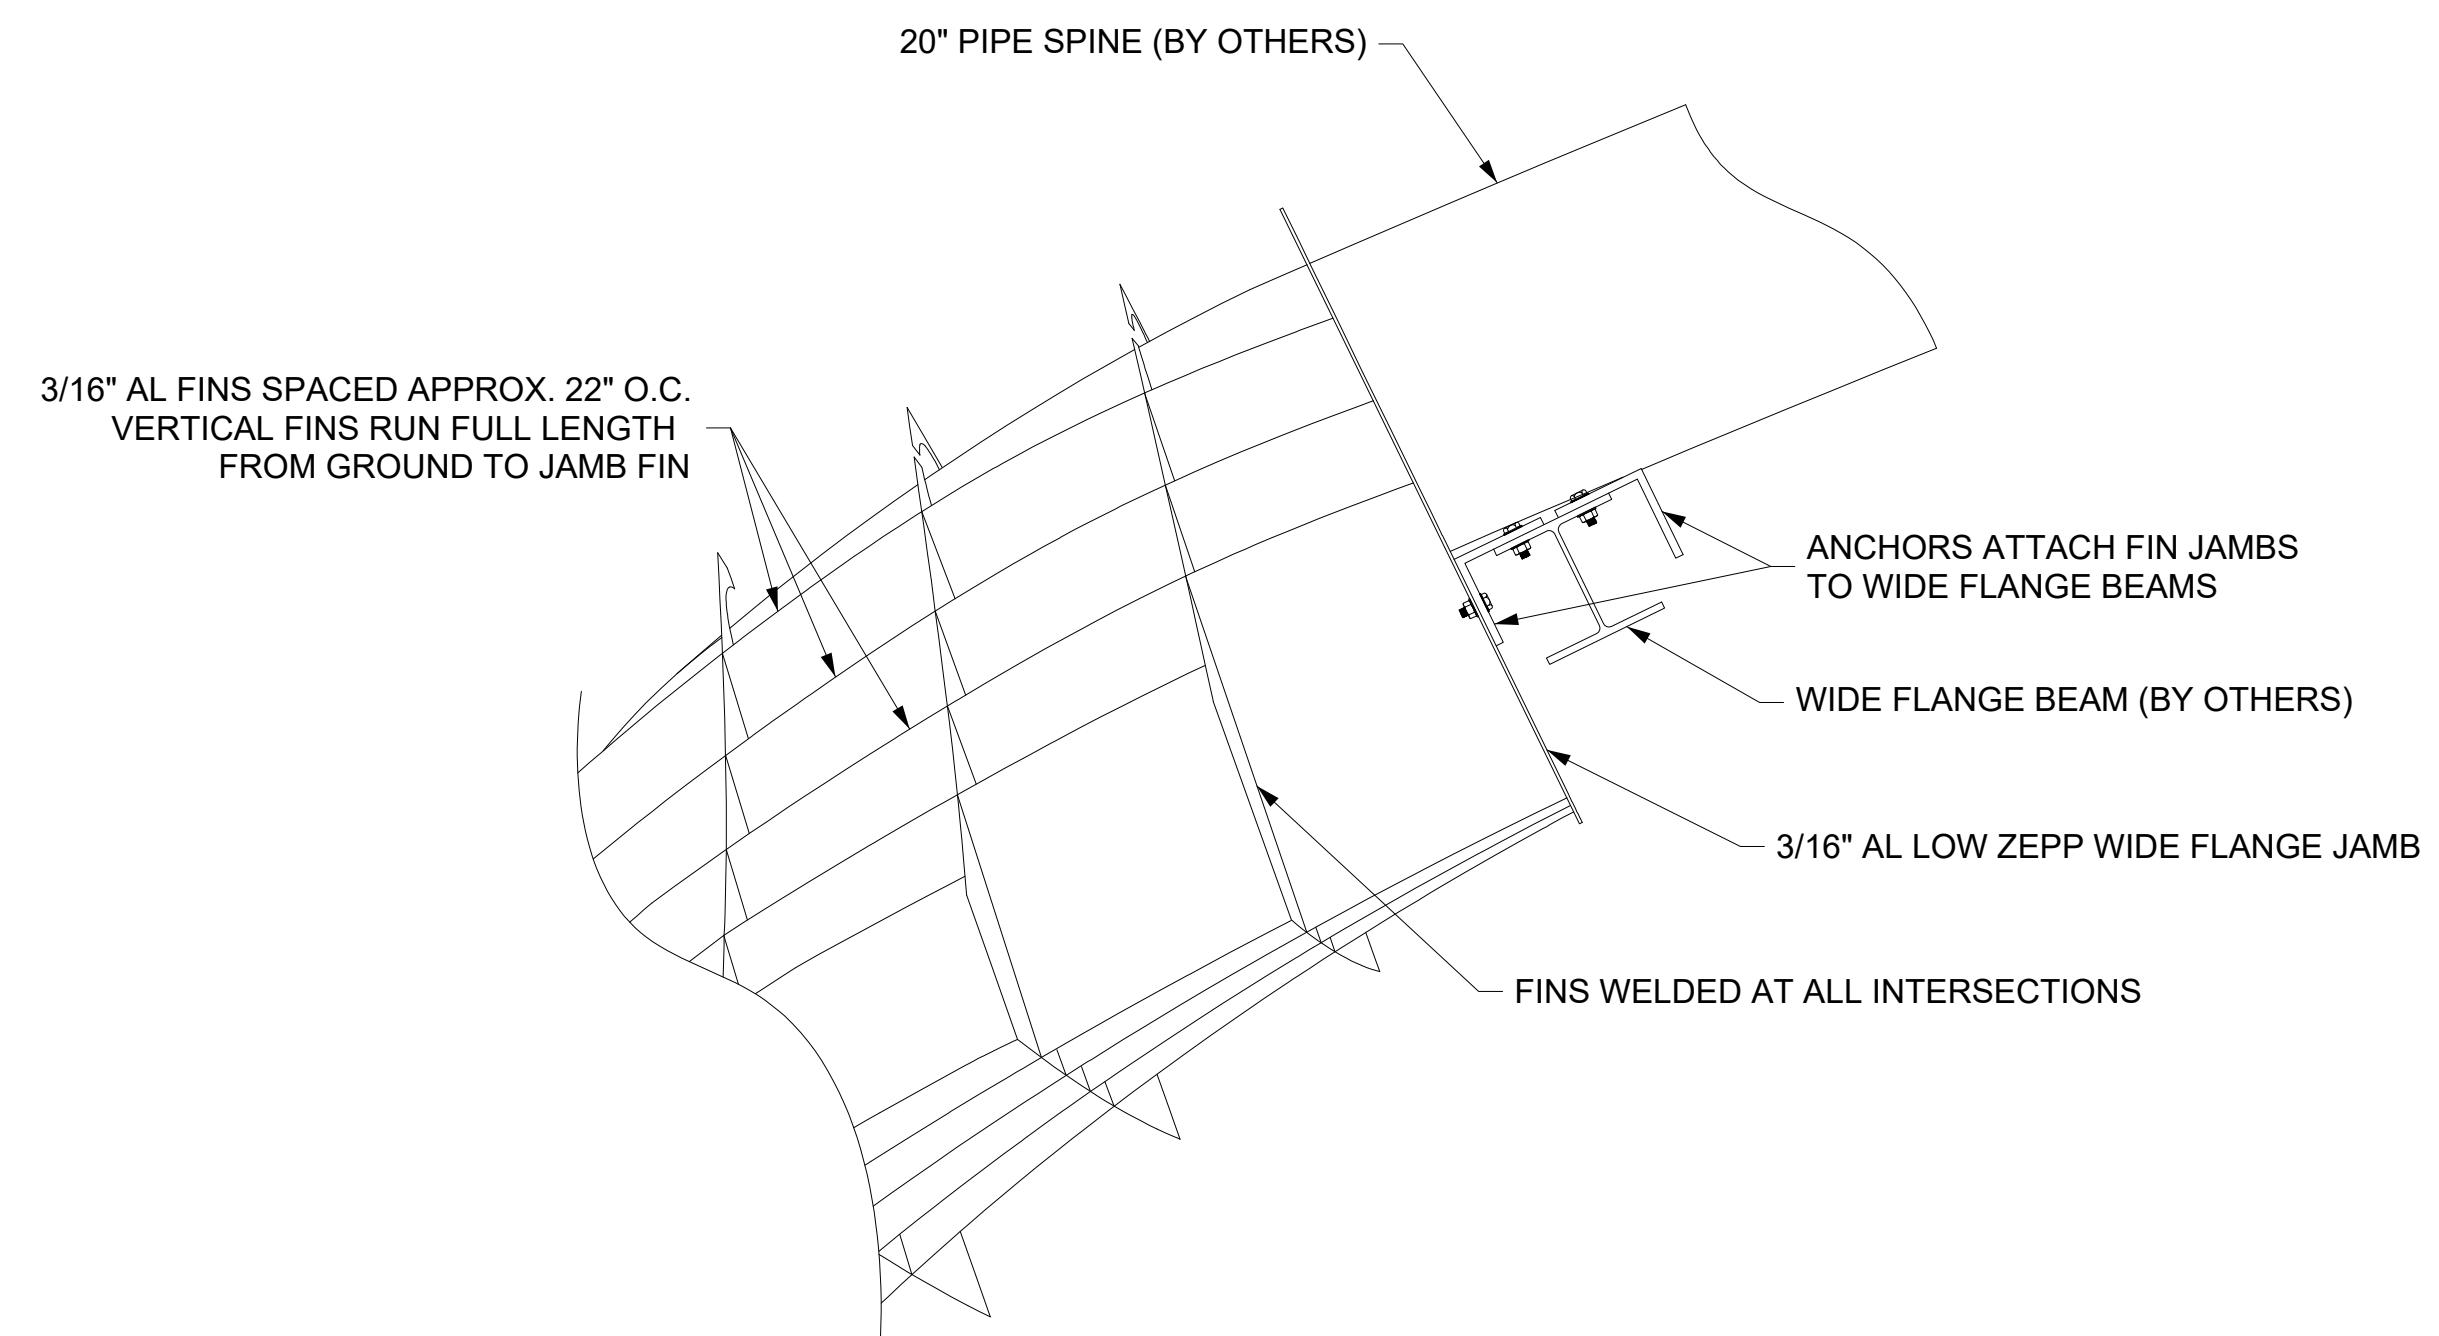

**2 WING WALL ZEPP UNIT ATTACHMENT TO STEEL**  
 SCALE: 1" = 1'-0"  
 ZAHNER REF: N/A  
 ARCH REF: N/A

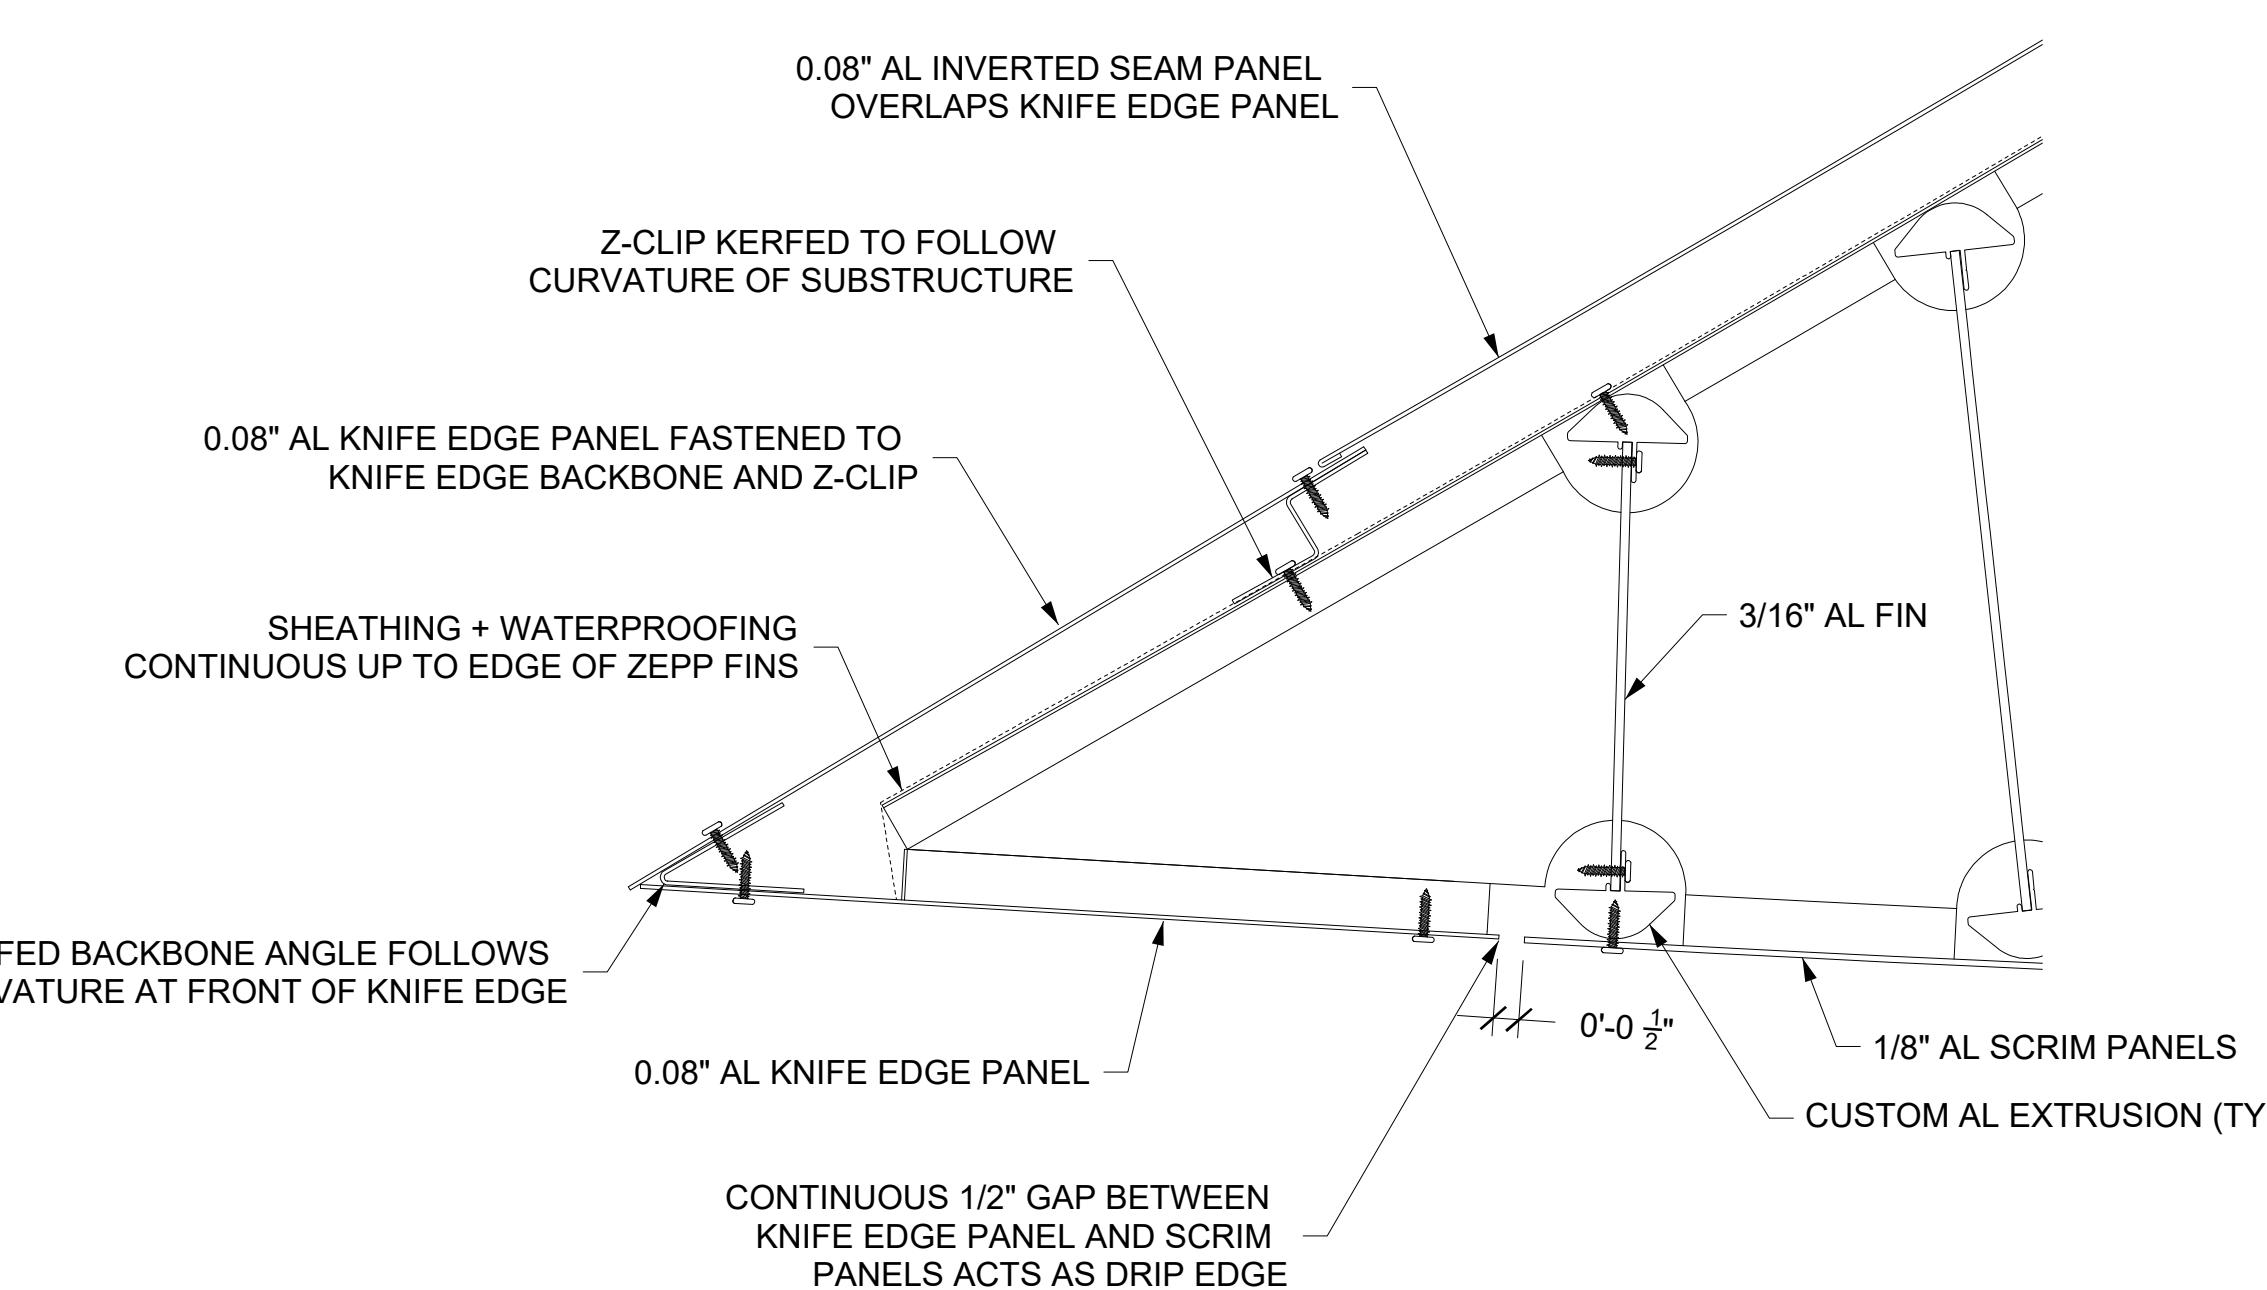


**4 KNIFE EDGE DETAILS**  
 SCALE: 3" = 1'-0"  
 ZAHNER REF: N/A  
 ARCH REF: N/A

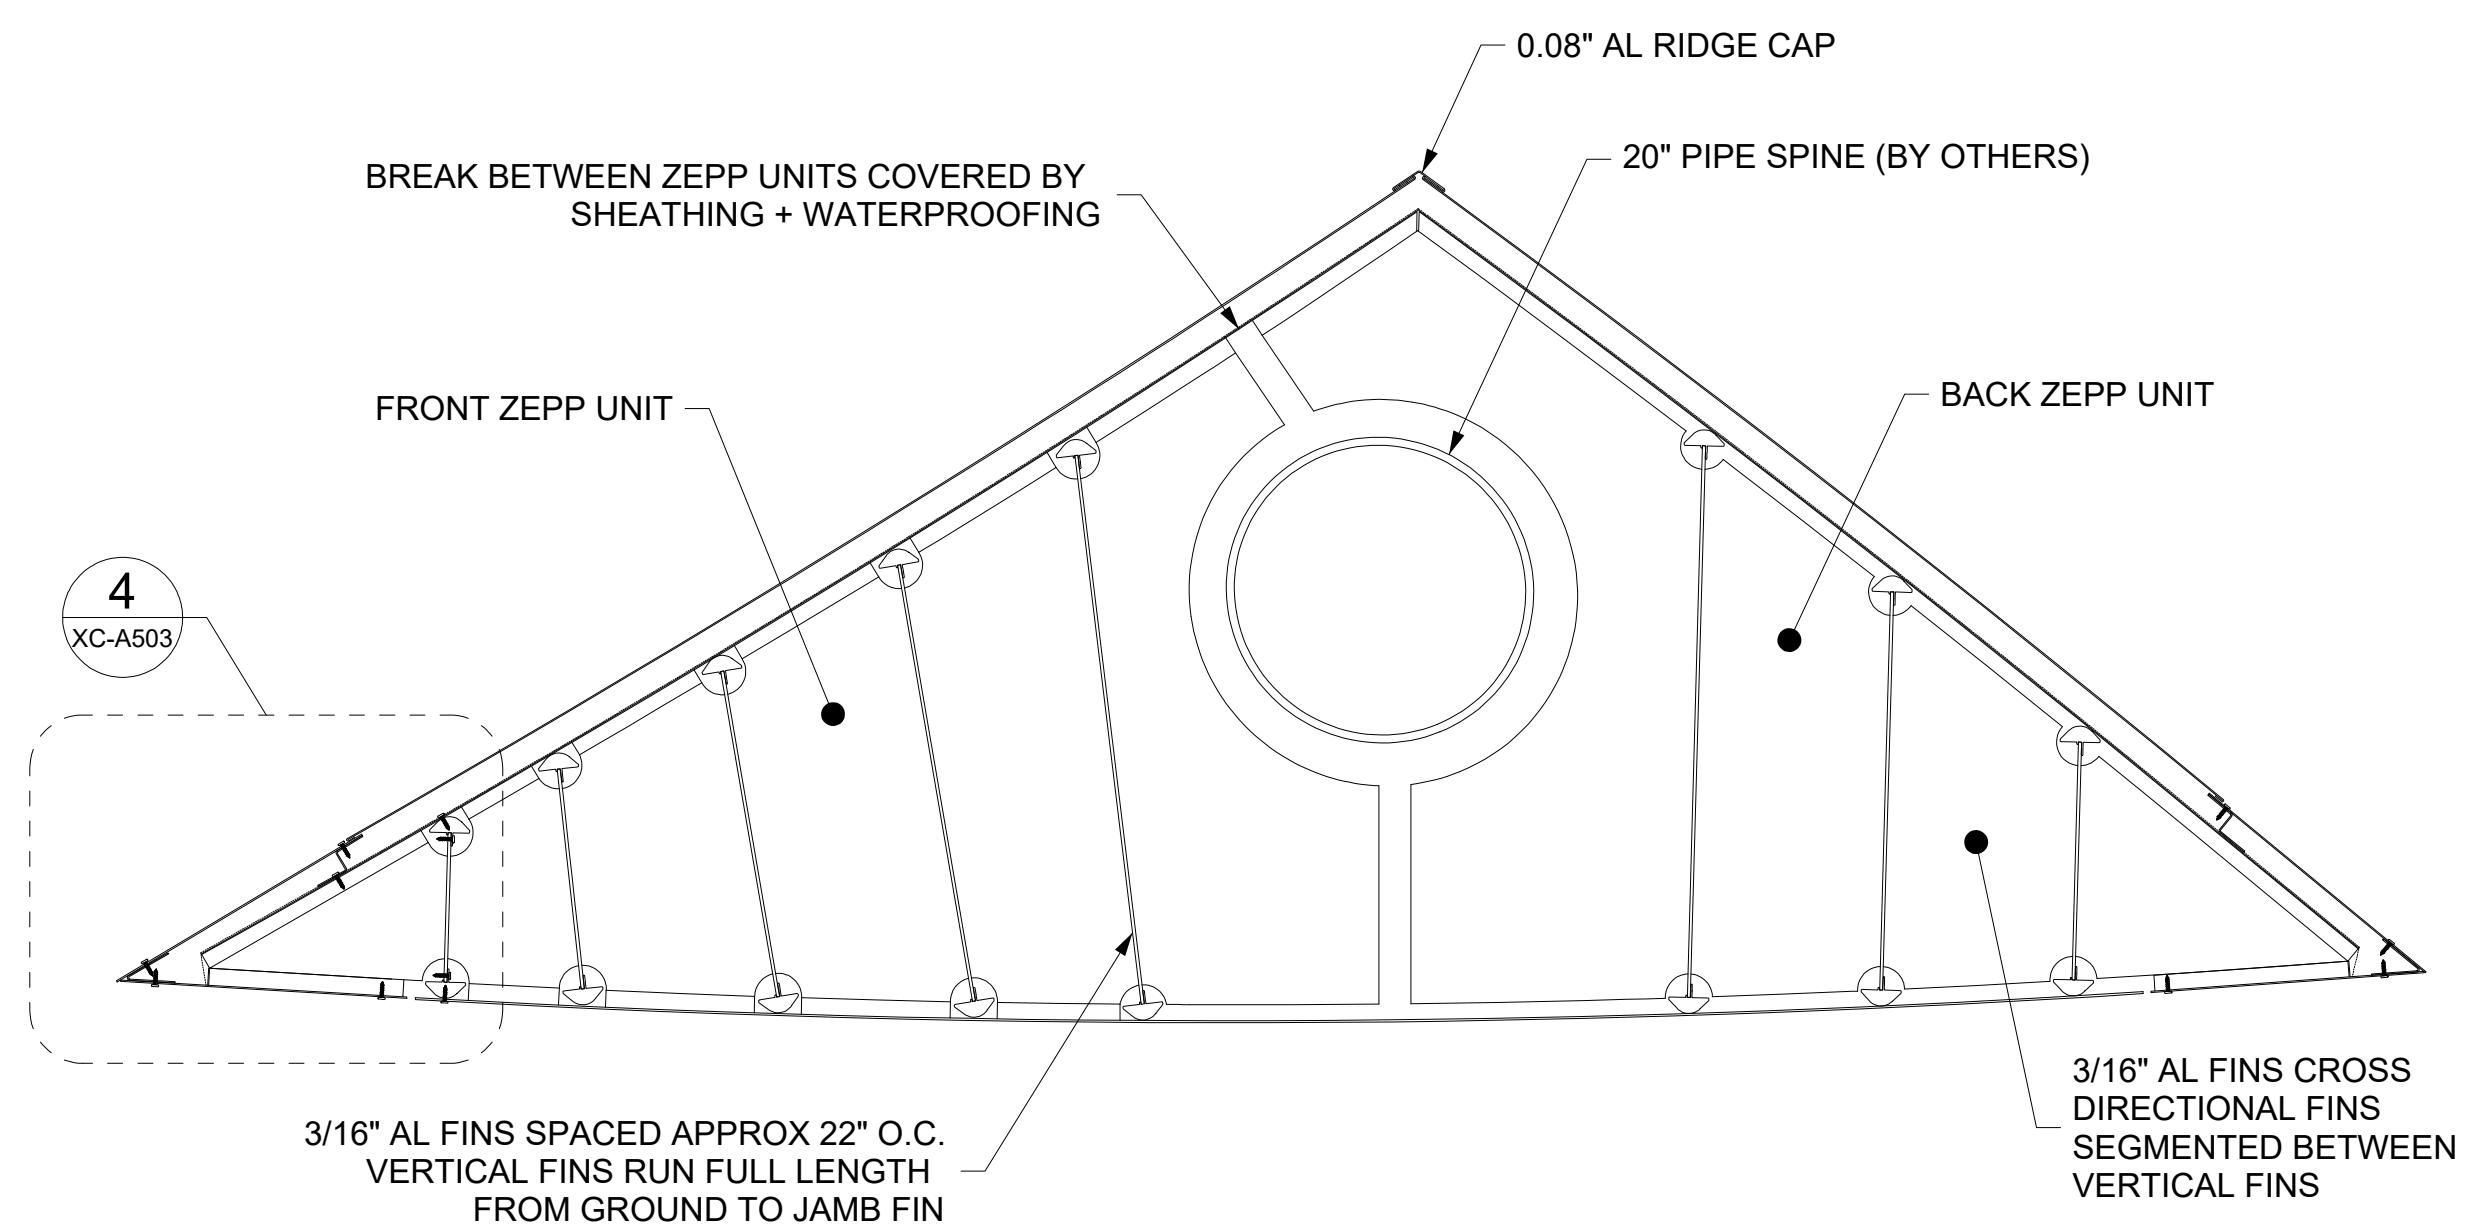

**3 SECTION B-B**  
**WING WALL ZEPP TYPICAL CROSS SECTION**  
 SCALE: ---  
 ZAHNER REF: N/A  
 ARCH REF: N/A




SET ISSUE DATES		
DATE	ISSUE	
01/20/22 100% DRAWINGS		
REVISIONS		
NO.	DATE	DESCRIPTION

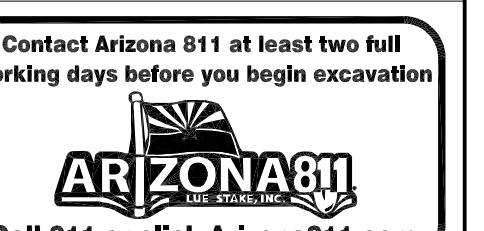


DATE: 01/20/2022		REVISION:	BY:
ENGINEER		PUBLIC WORKS	
		CAPITAL PROJECT MANAGEMENT	
SHEET TITLE		7447 E. INDIAN SCHOOL RD. SCOTTSDALE, ARIZONA 85251	

EAST BOWL - WING WALL ZEPP DETAILS  
 PROJECT TITLE: CITY OF SCOTTSDALE CIVIC CENTER PLAZA

THIS SHEET SCALED FOR 24X36" BORDER	SCALE	DESIGNED	BID NO.	XC-A503
	DRAWN DS	AS-BUILT	COS PROJECT NO.	DG04

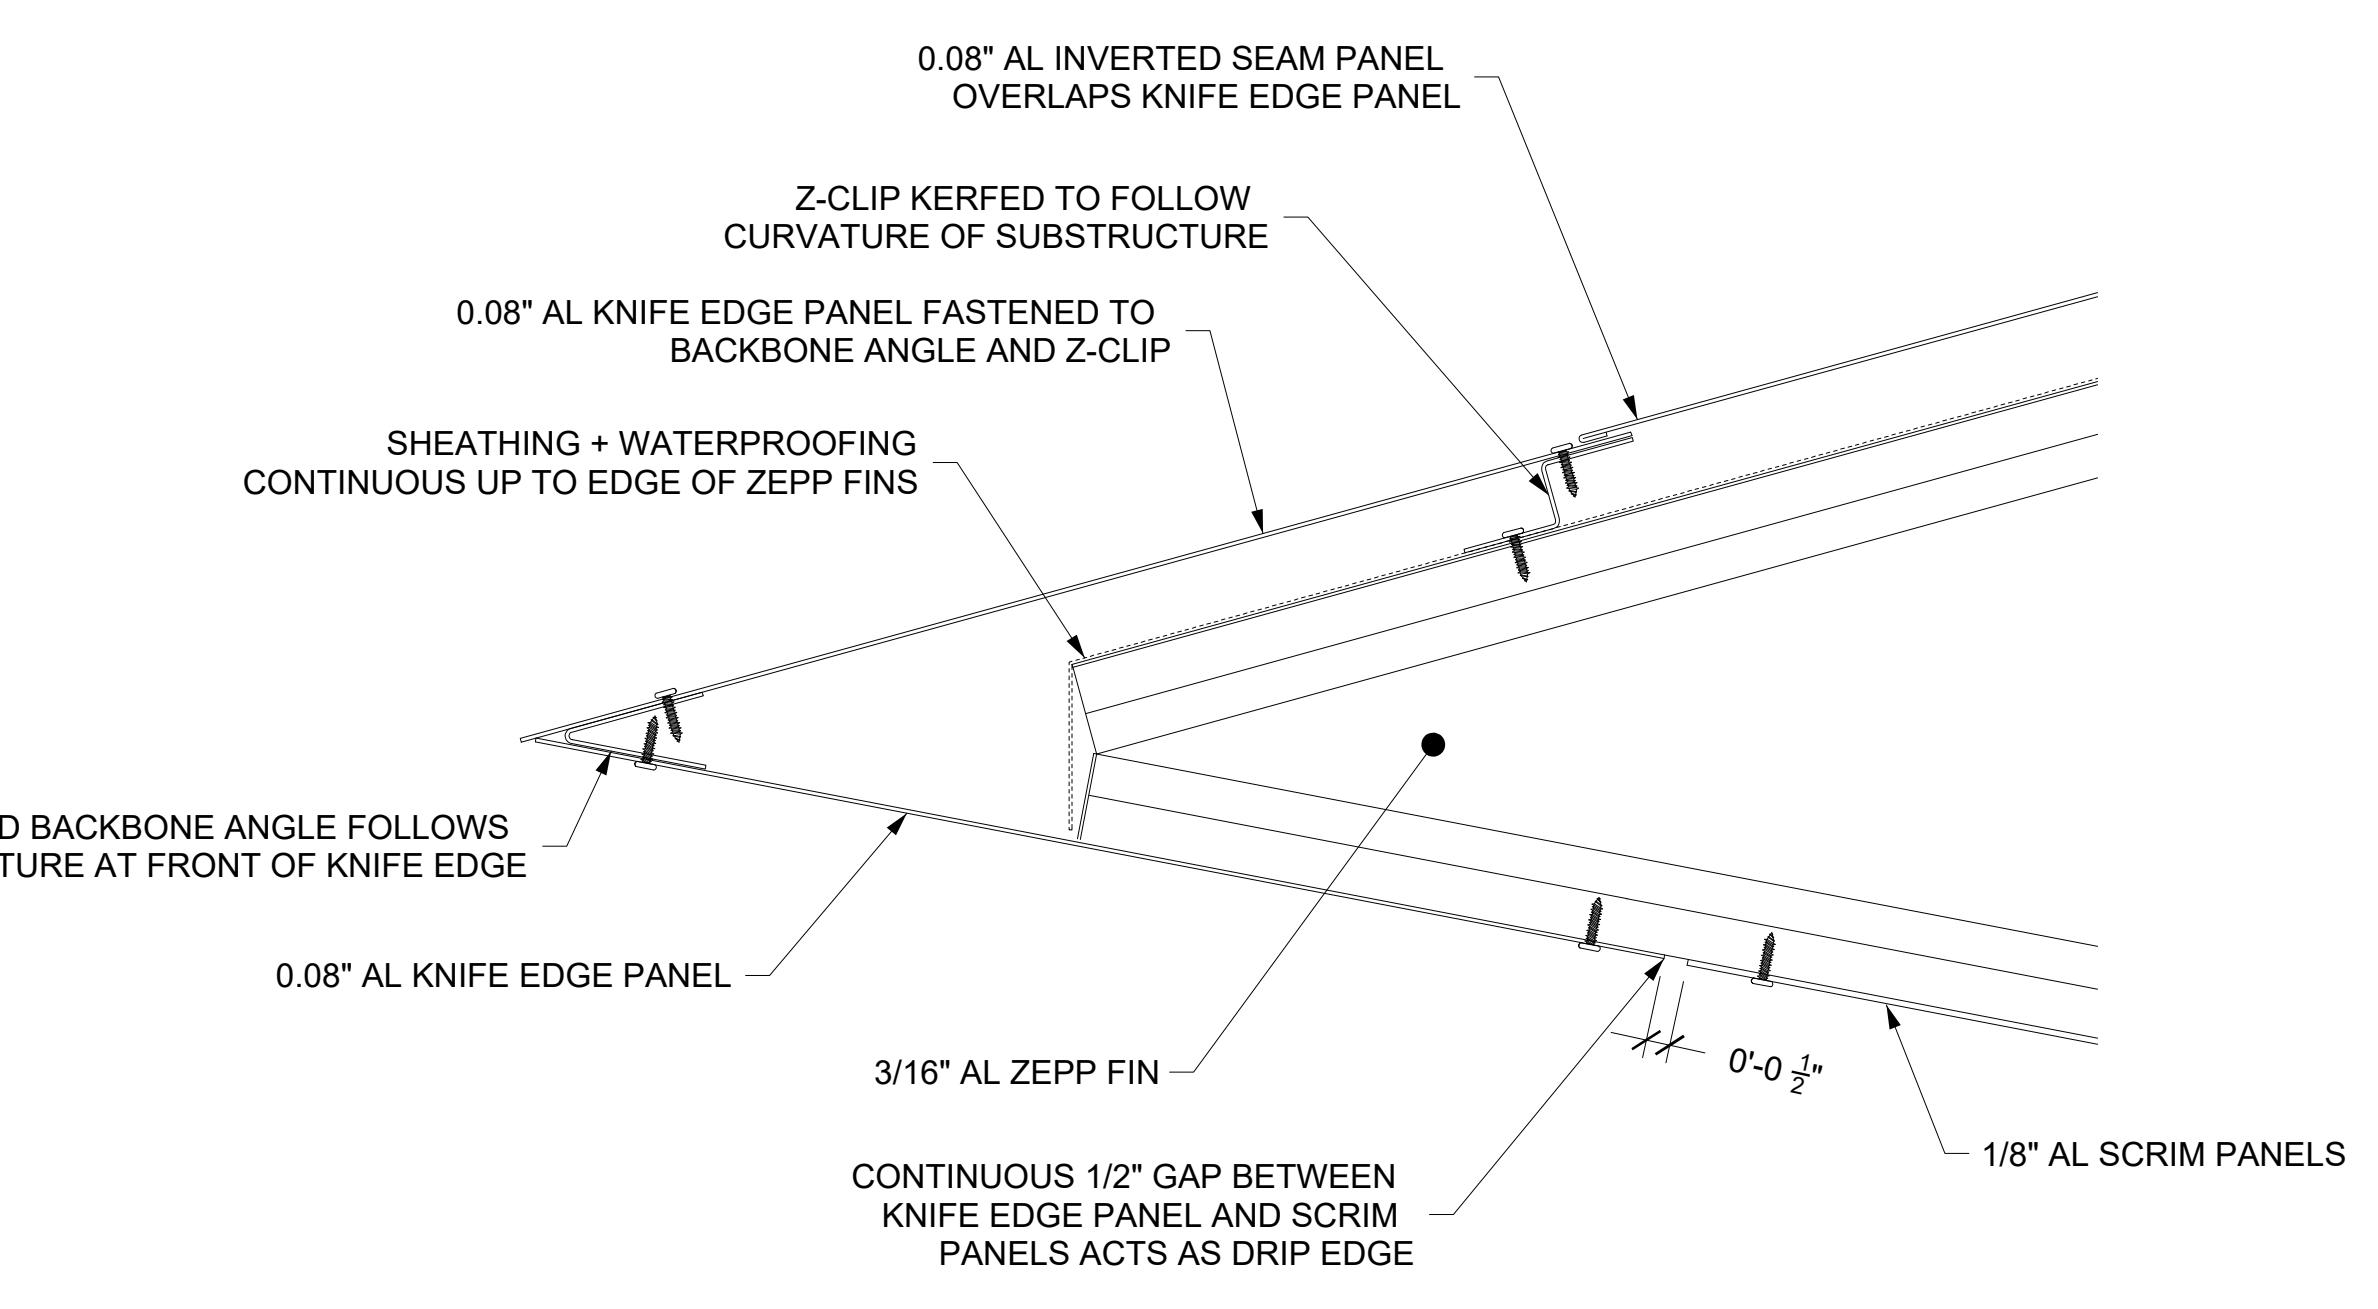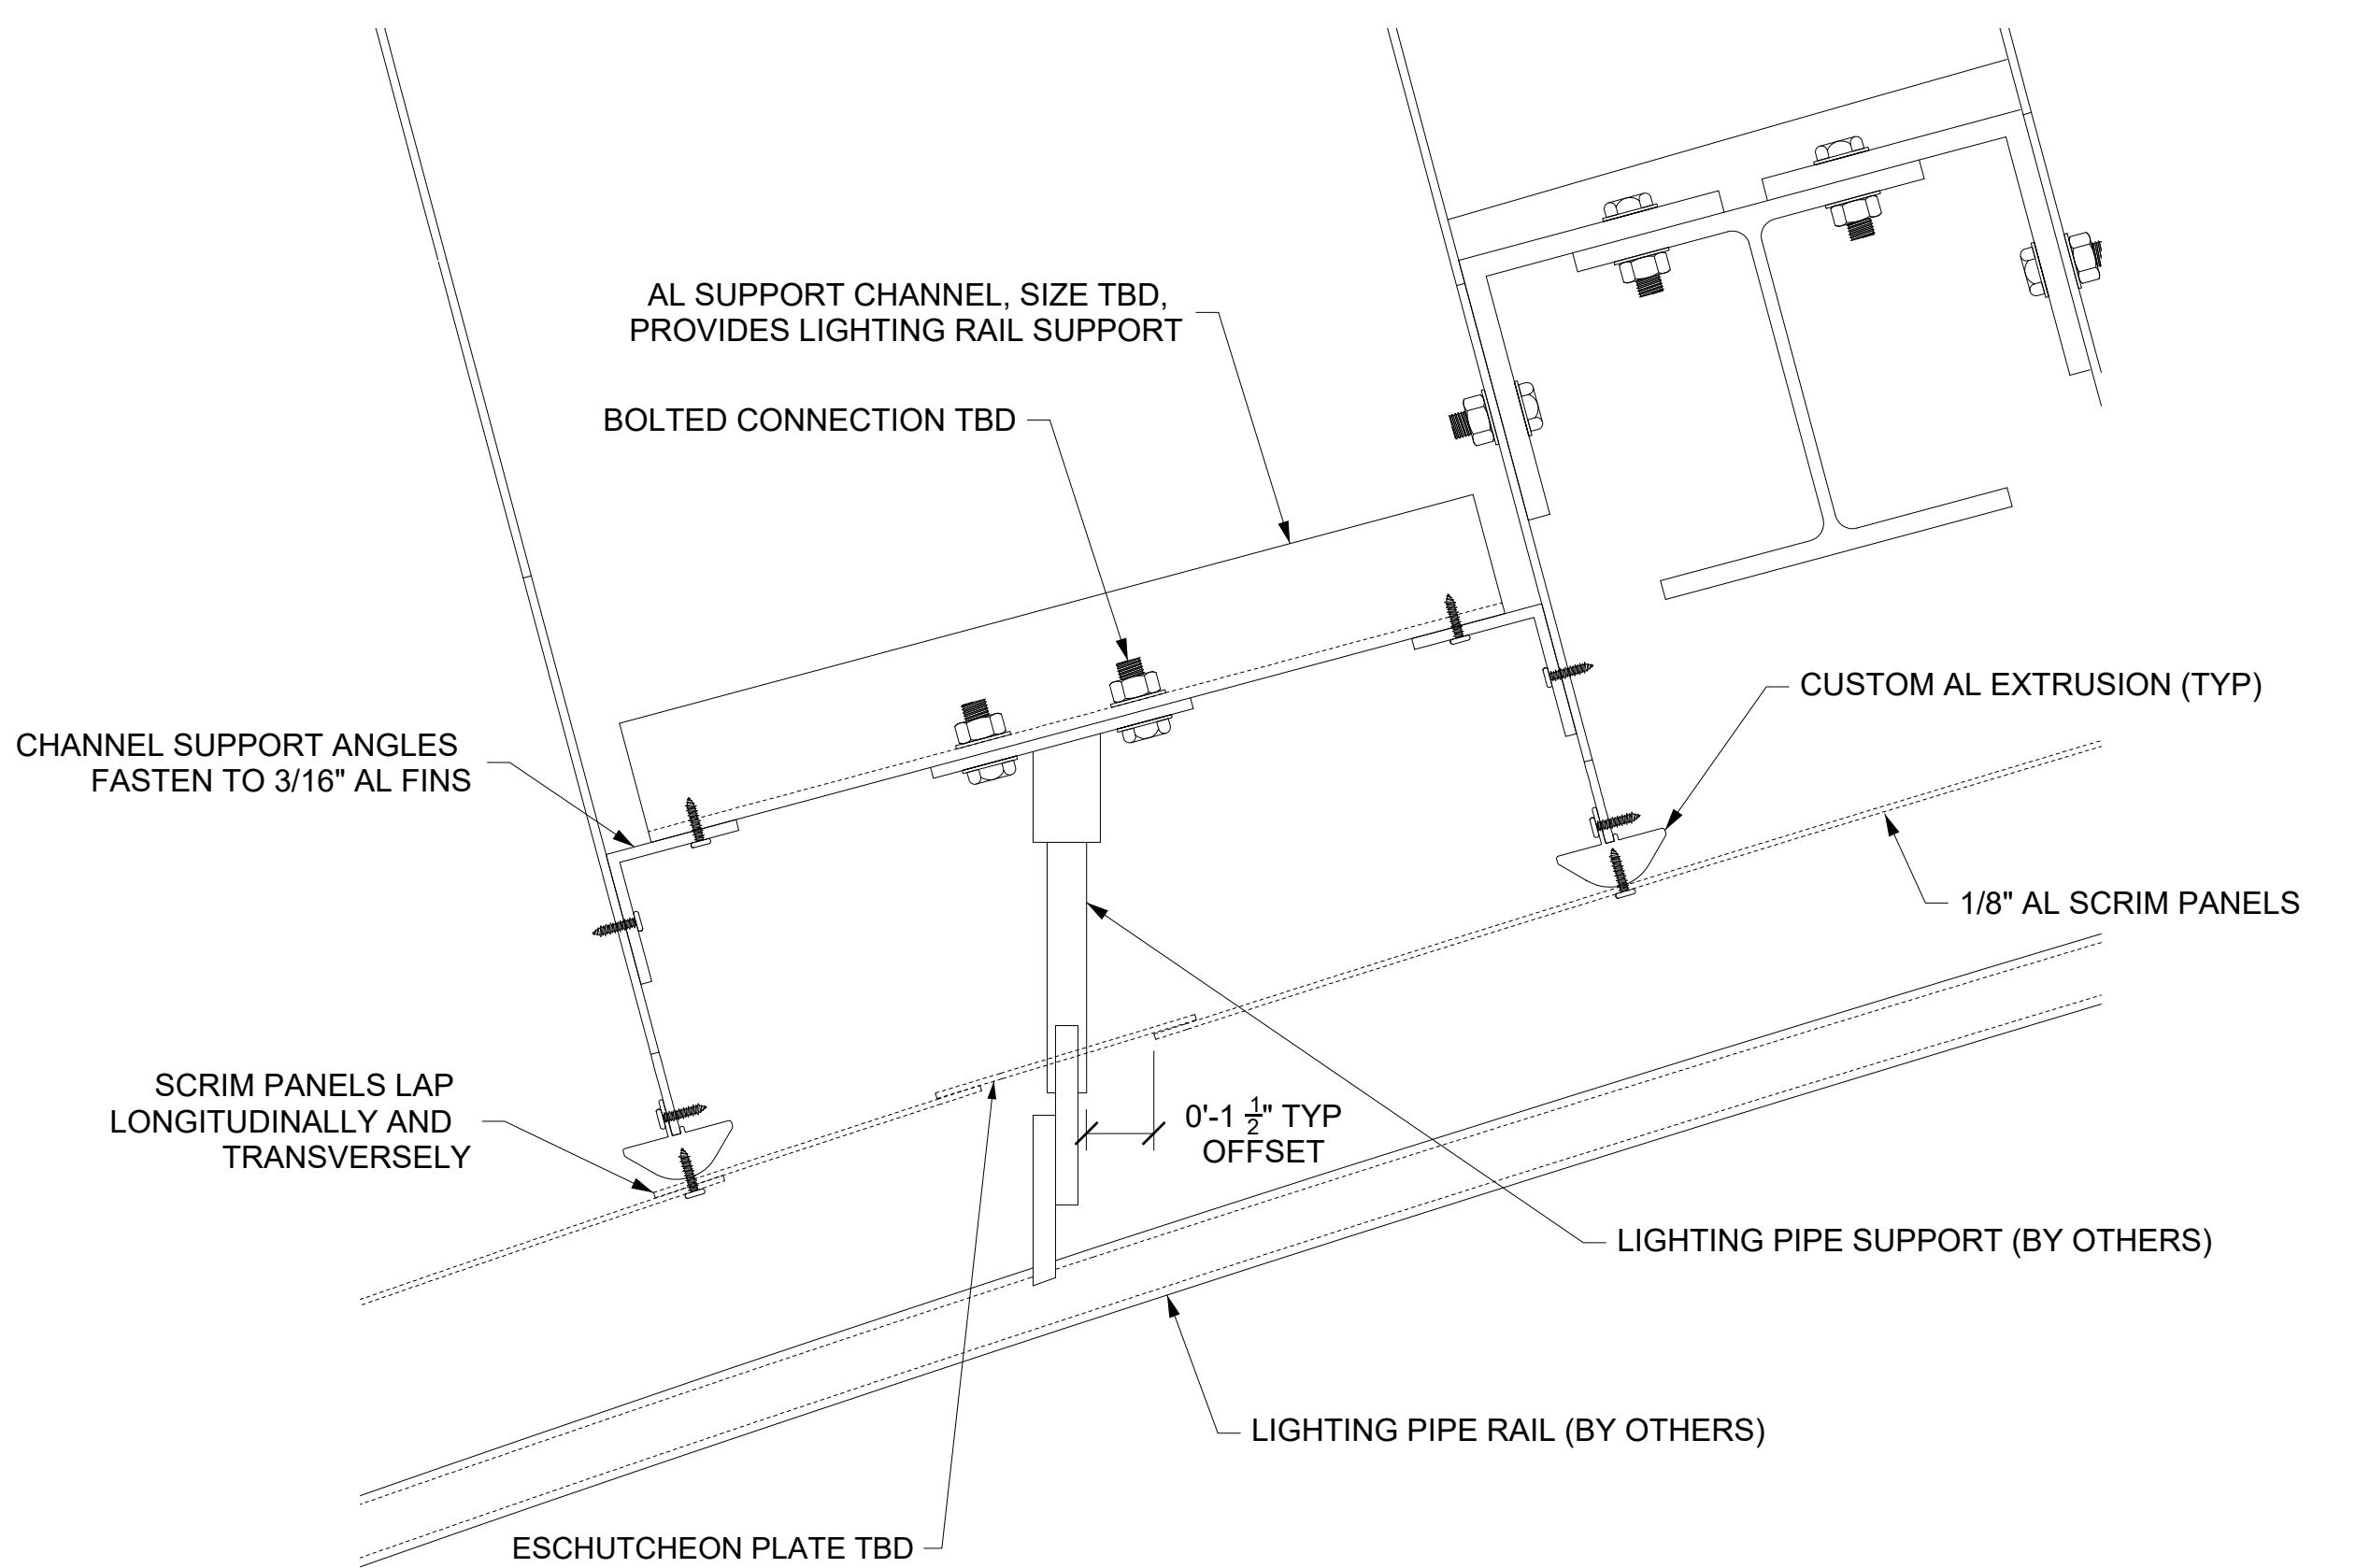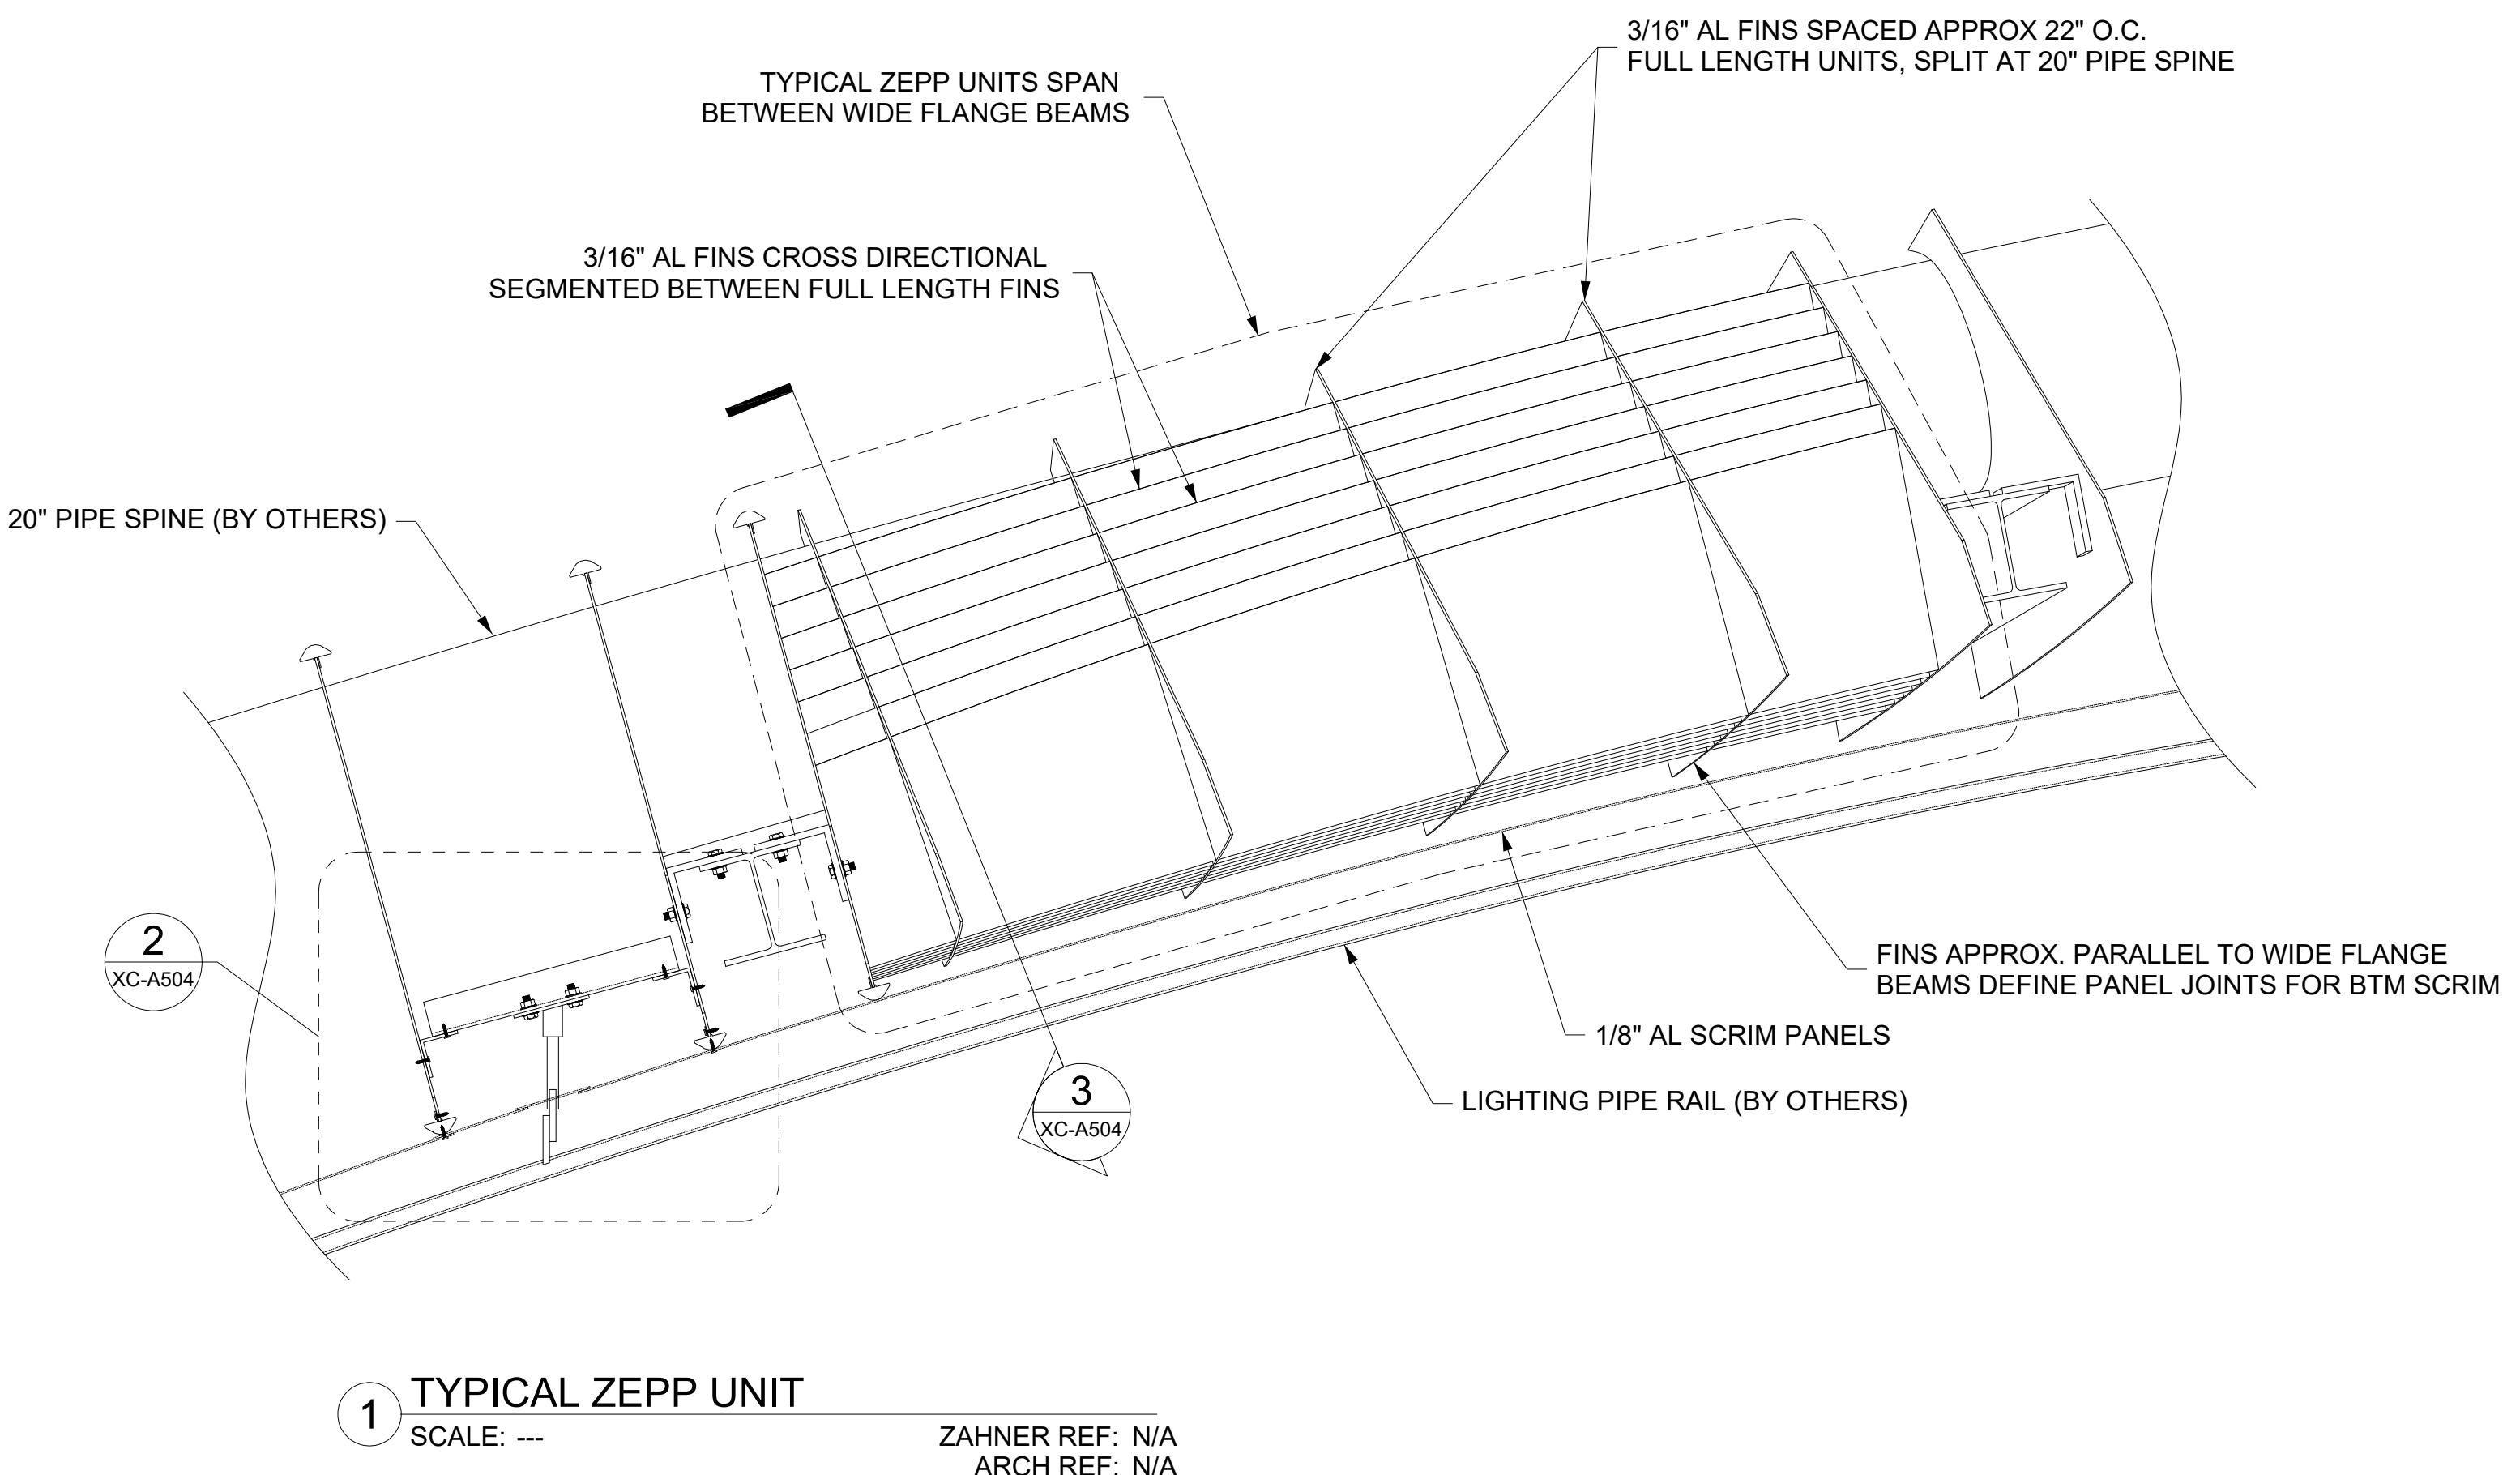

SET ISSUE DATES		
DATE	ISSUE	
01/20/22 100% DRAWINGS		
REVISIONS		
NO.	DATE	DESCRIPTION

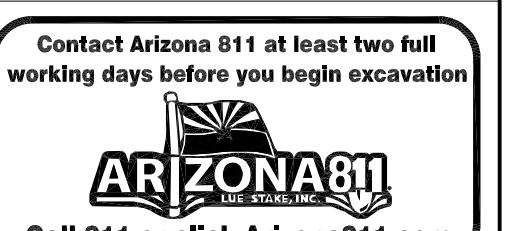


DATE: 01/20/2022	REVISION:	BY:
ENGINEER		PUBLIC WORKS
		CAPITAL PROJECT MANAGEMENT
7447 E. INDIAN SCHOOL RD. SCOTTSDALE, ARIZONA 85251		
SHEET TITLE		

### EAST BOWL - TYP ZEPP DETAILS

PROJECT TITLE CITY OF SCOTTSDALE CIVIC CENTER PLAZA

THIS SHEET SCALED FOR 24X36" BORDER	SCALE	DESIGNED	BID NO.	XC-A504
		DRAWN DS	AS-BUILT	COS PROJECT NO. DG04

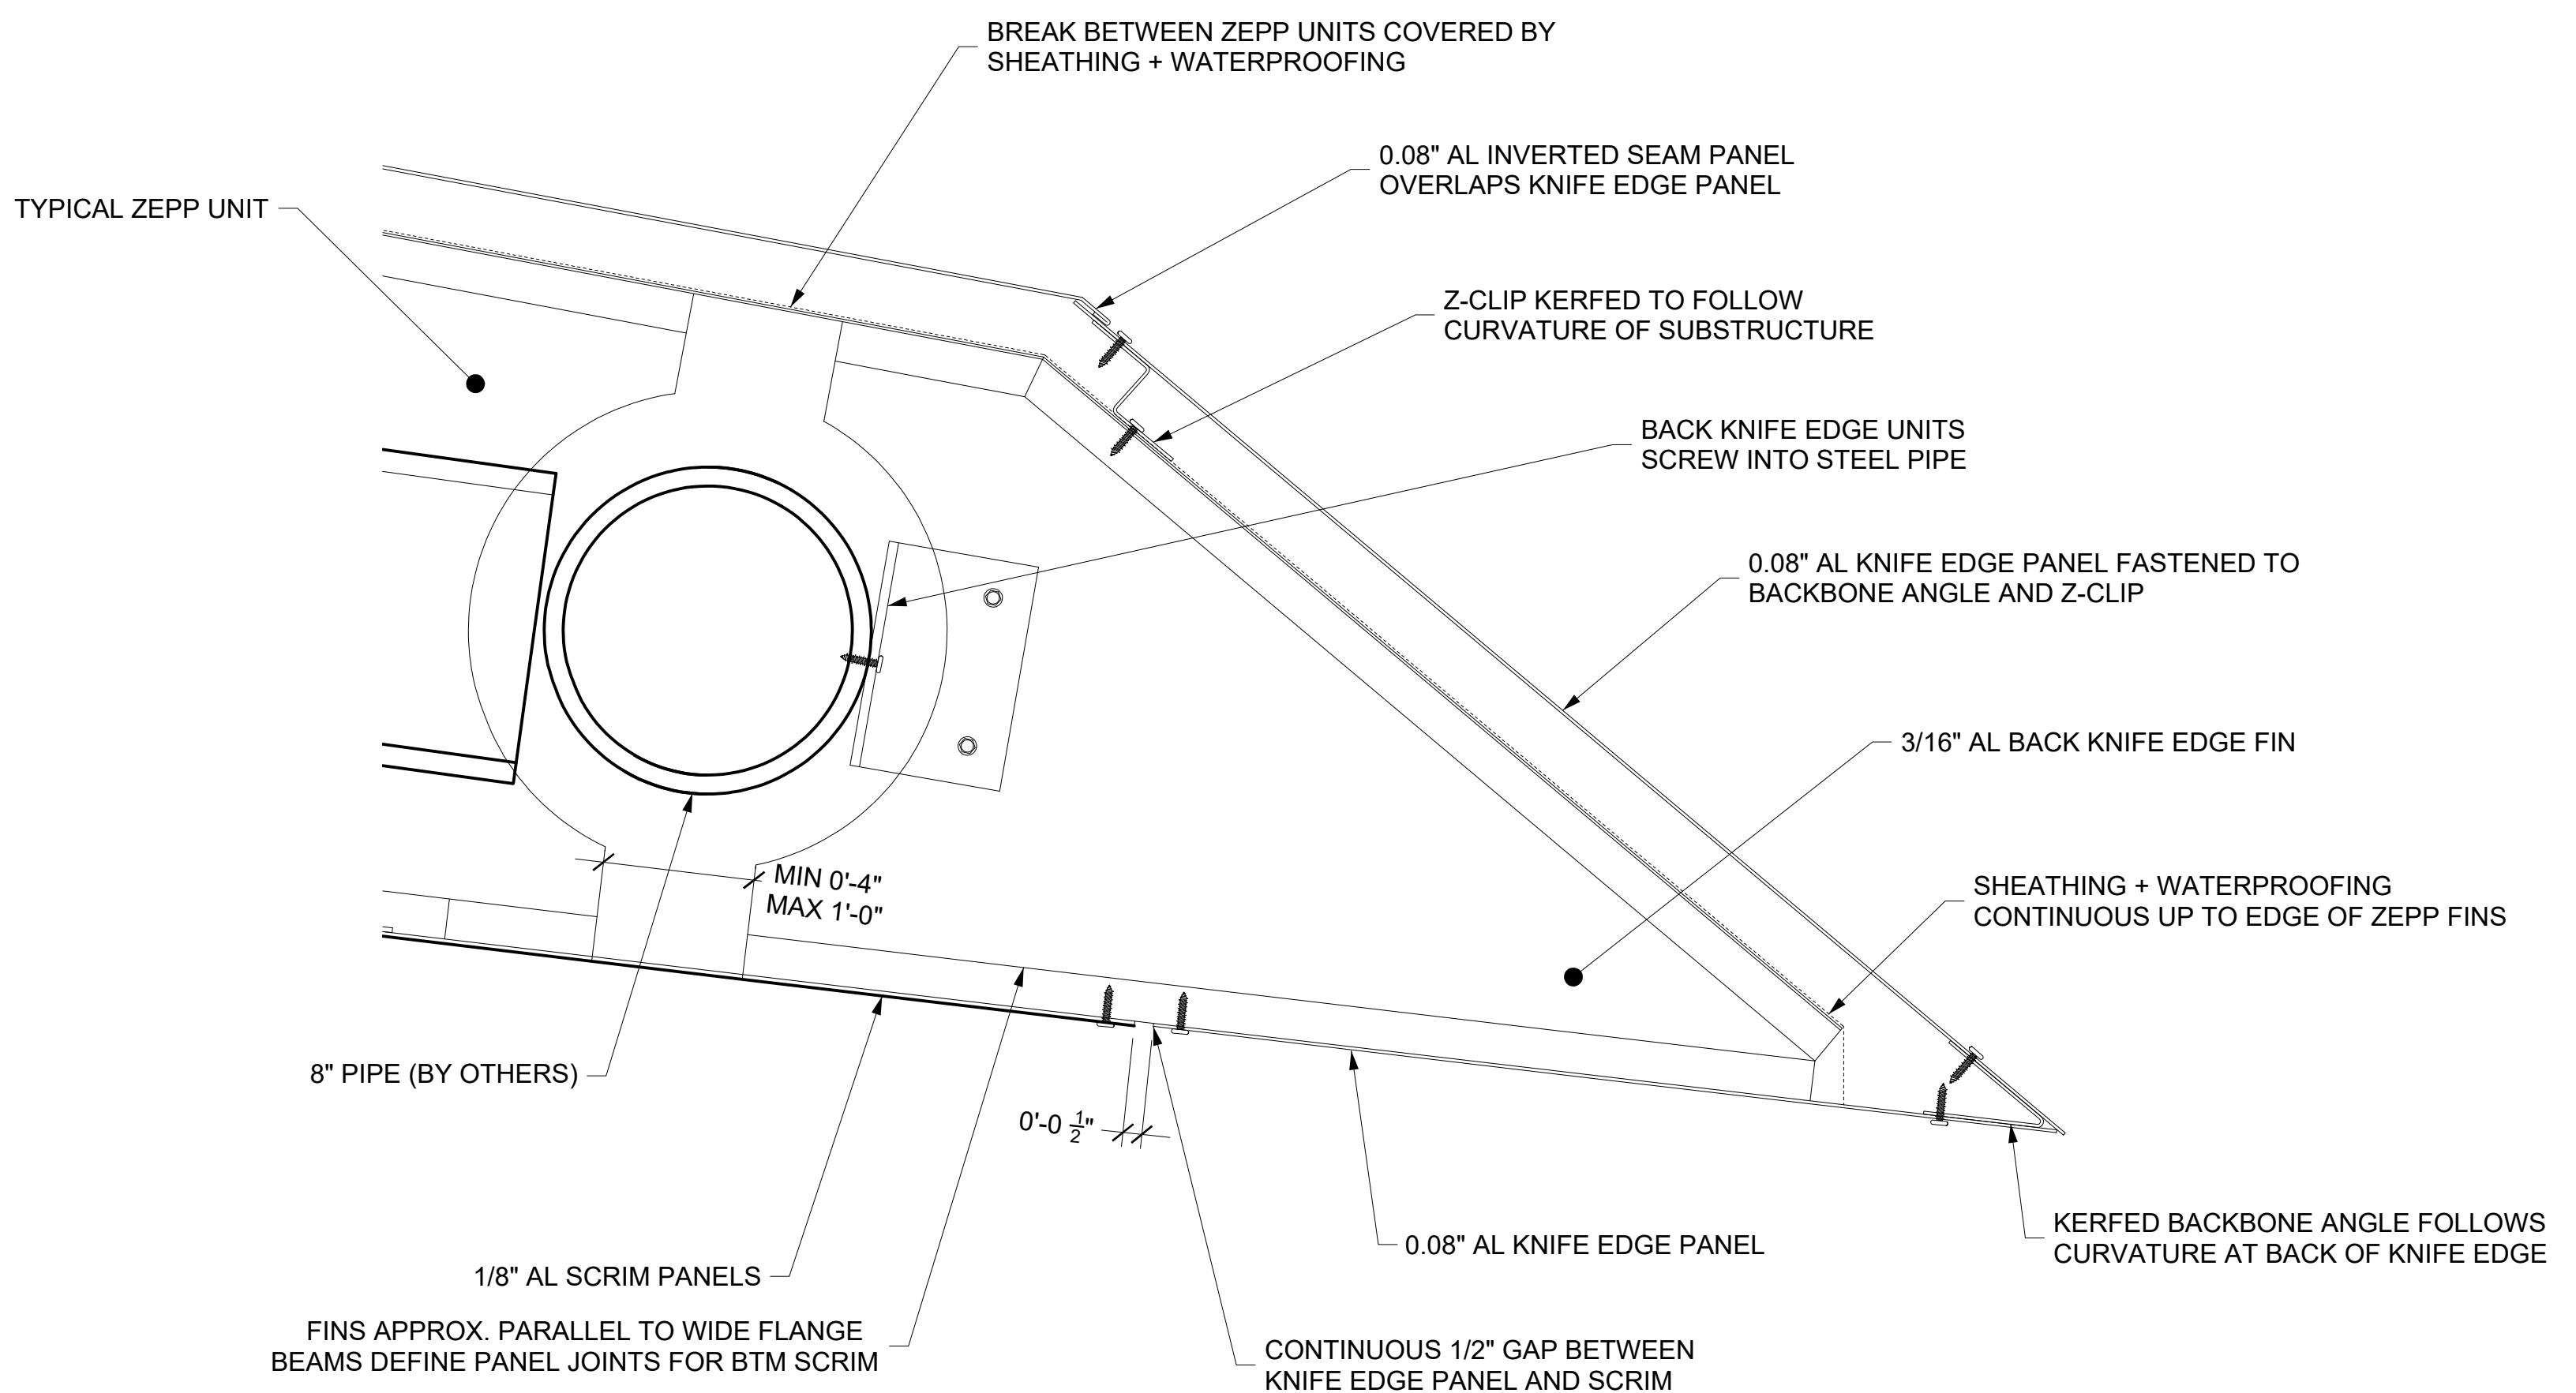

## **1 BACK KNIFE EDGE DETAIL**

SCALE: 3' = 1'-0"

---

ZAHNER REF: N/A  
ARCH REF: N/A

The logo consists of a stylized 'RPA' monogram enclosed in a square frame. The letters are bold and have a geometric, hatched texture. To the right of the monogram, the company name 'RITOCH-POWELL & Associates' is written in a large, sans-serif font. Below the name is the phone number '602-263-1177' and the website 'WWW.RPAENG.COM'. The entire logo is set against a white background.

**L A K E | F L A T O**

© 2021 Lake|Flato Architects, Inc.

311 THIRD STREET  
SAN ANTONIO, TEXAS 78205  
P 210.227.3335 F 210.224.9515  
[www.lakeflato.com](http://www.lakeflato.com)

# ZAHNER

## ARCHITECTURAL METAL

## REVISIONS

---

---


---

---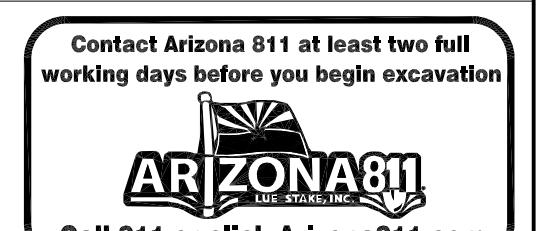

DATE: 01/20/2022	REVISION:	BY:
ENGINEER	 <p><b>PUBLIC WORKS</b></p> <p><b>CAPITAL PROJECT MANAGEMENT</b></p> <p>7447 E. INDIAN SCHOOL RD. SCOTTSDALE, ARIZONA 85251</p>	

# FAST BOWI - BACK KNIFE EDGE DETAIL

PROJECT TITLE	CITY OF SCOTTSDALE CIVIC CENTER PLAZA
---------------	--


THIS SHEET SCALED FOR 24X36" BORDER	SCALE	DESIGNED		BID NO.	XC-A505
		DRAWN DS	AS-BUILT	COS PROJECT NO. DG04	

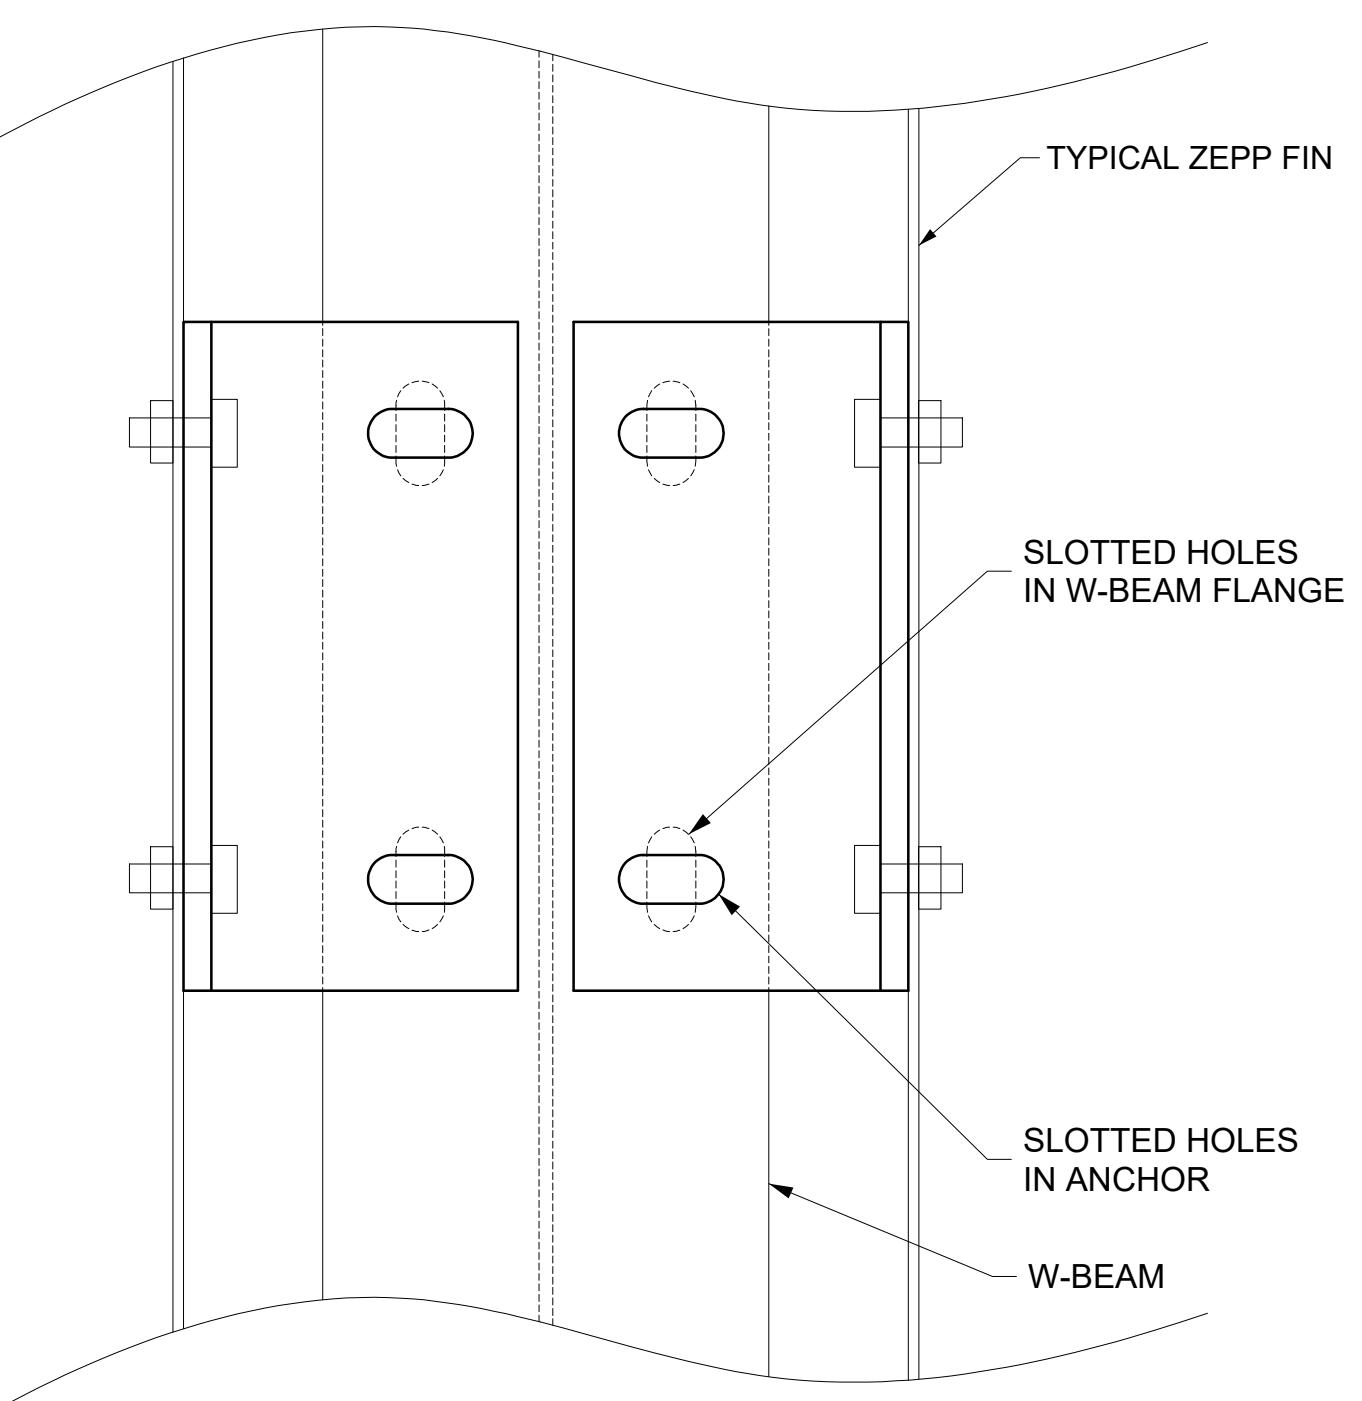

**SECTION A-A**

SCALE: --

ZAHNER REF: N/A  
ARCH REF: N/A

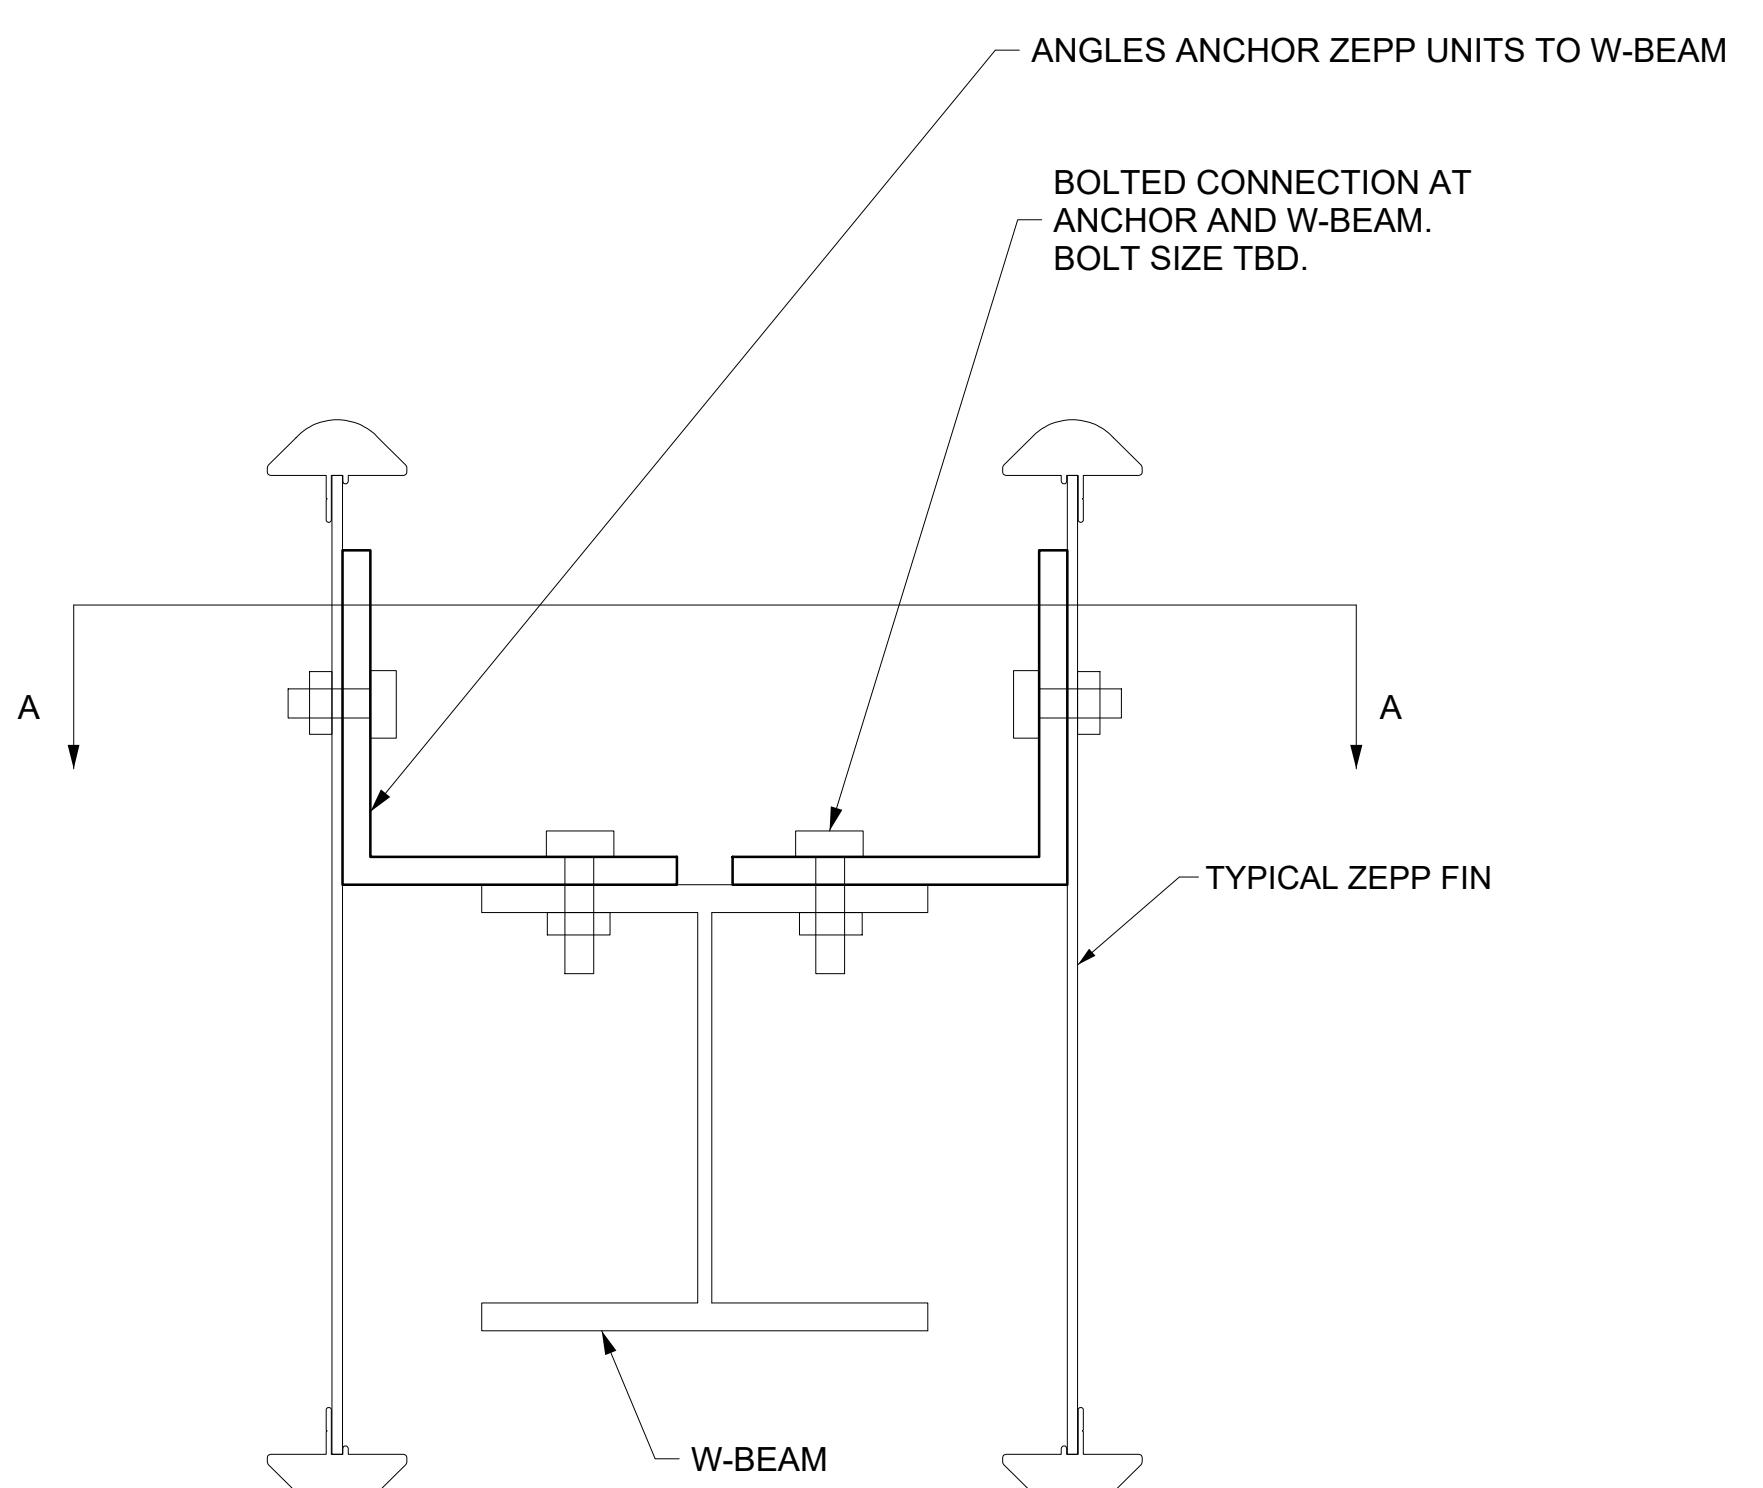



## ANCHOR DETAIL SCALE: ---

2 SCALE

---


ZAHNER REF: N/A  
ARCH REF: N/A

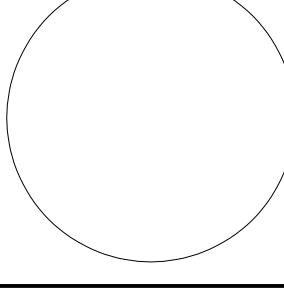SET ISSUE DATES				
DATE	ISSUE			
01/20/22 100% DRAWINGS				
<hr/> <hr/> <hr/> <hr/> <hr/>				
REVISIONS				
NO.	DATE	DESCRIPTION		
		<hr/> <hr/> <hr/> <hr/> <hr/>		
<div style="text-align: right; padding: 10px;"> <p>Contact Arizona 811 at least two full working days before you begin excavation</p>  <p>Call 811 or click <a href="http://Arizona811.com">Arizona811.com</a></p> </div>				
DATE: 01/20/2022		REVISION:		BY:
ENGINEER 		<b>PUBLIC WORKS</b>  <b>CAPITAL PROJECT MANAGEMENT</b> <small>7447 E. INDIAN SCHOOL RD. SCOTTSDALE, ARIZONA 85251</small>		
SHEET TITLE				
<h1>EAST BOWL - ANCHOR DETAILS</h1>				
PROJECT TITLE		<b>CITY OF SCOTTSDALE</b> <b>CIVIC CENTER PLAZA</b>		
D R	SCALE	DESIGNED	BID NO.	
	DRAWN DS	AS-BUILT	COS PROJECT NO. DG04	
				XC-A506

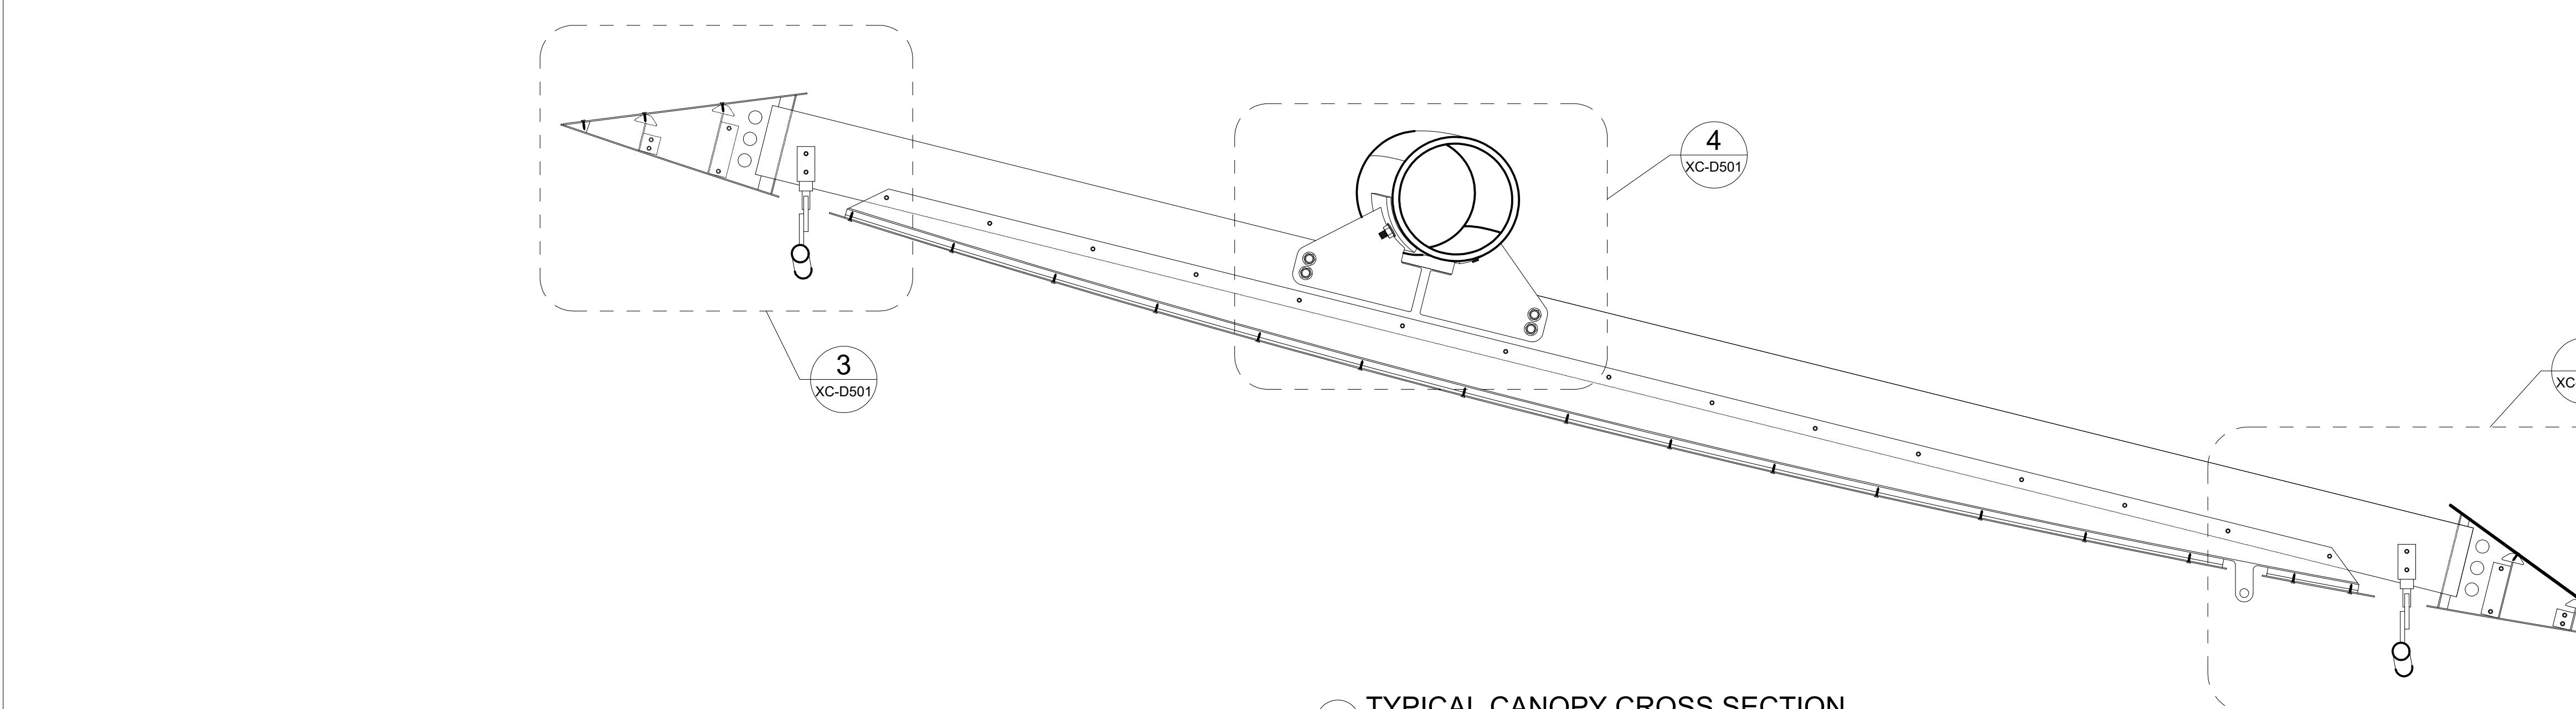


1 TYPICAL CANOPY CROSS SECTION

SCALE: 1" = 1'-0"  
ZAHNER REF: N/A  
ARCH REF: N/A

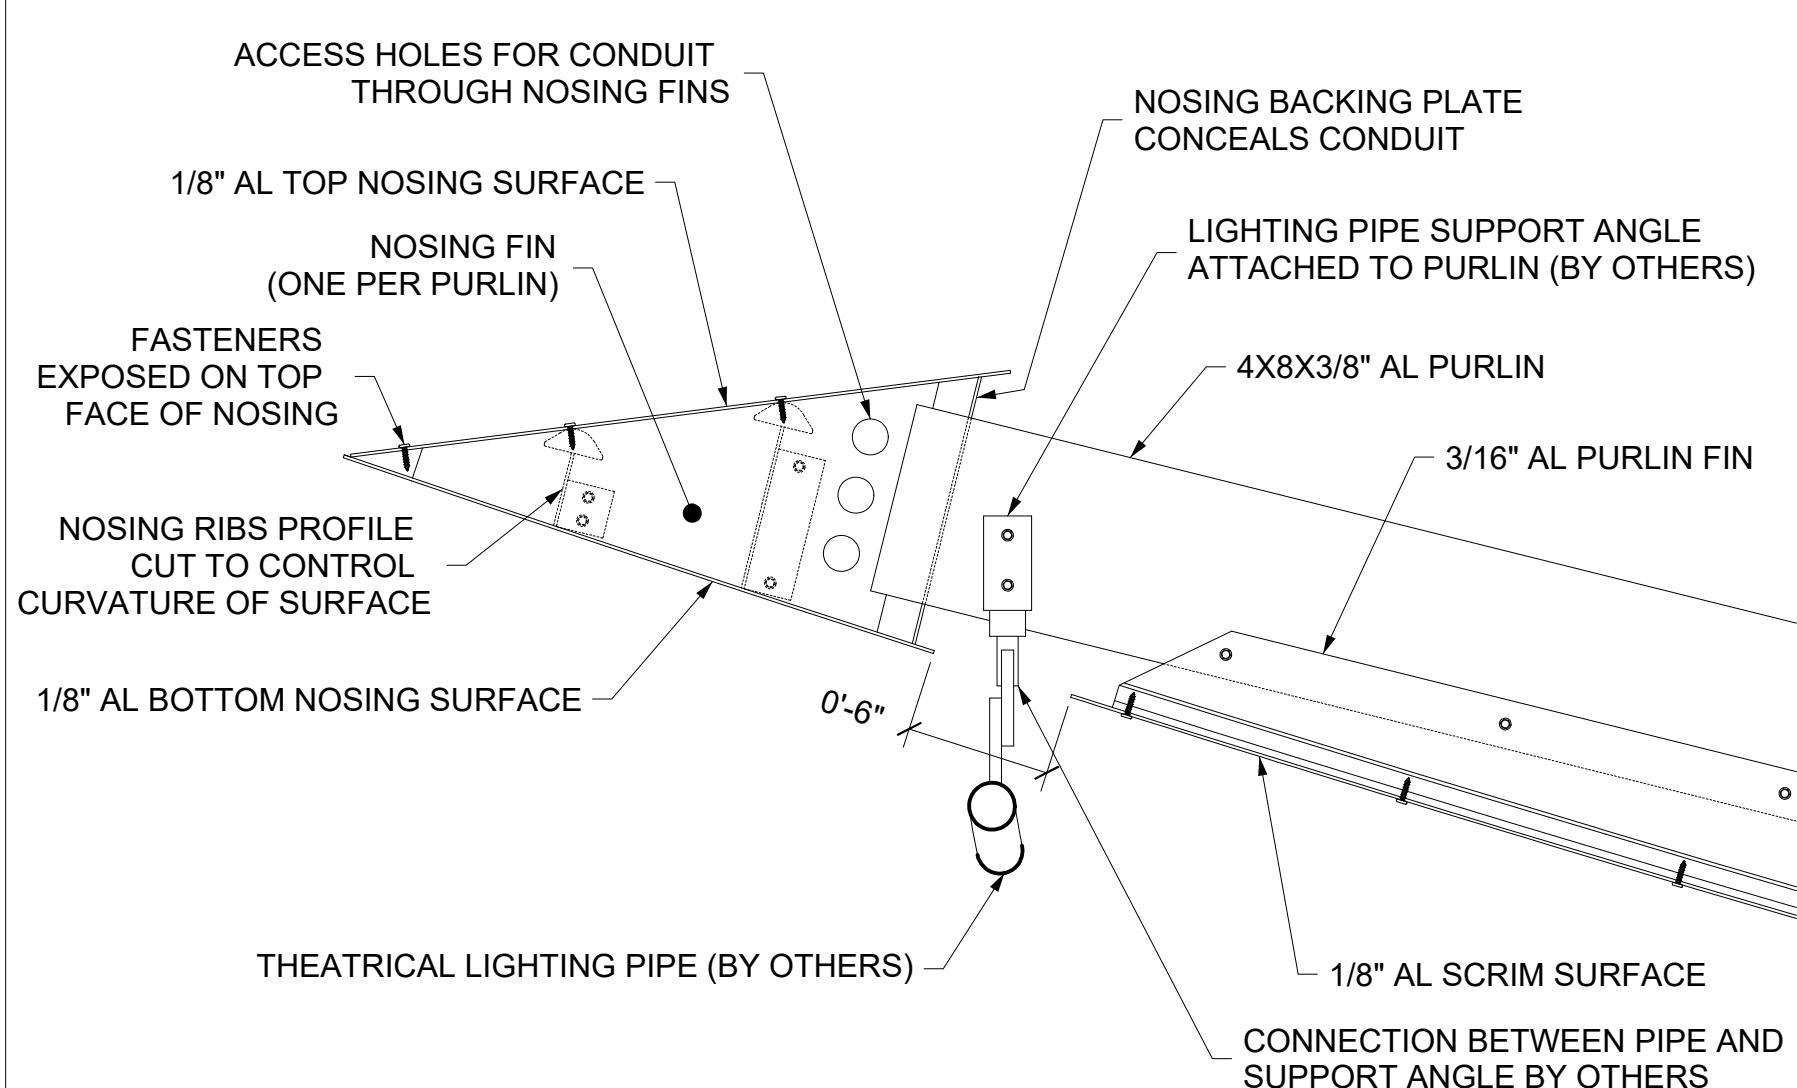


3 OUTSIDE NOSING DETAIL

SCALE: 1" = 1'-0"  
ZAHNER REF: N/A  
ARCH REF: N/A

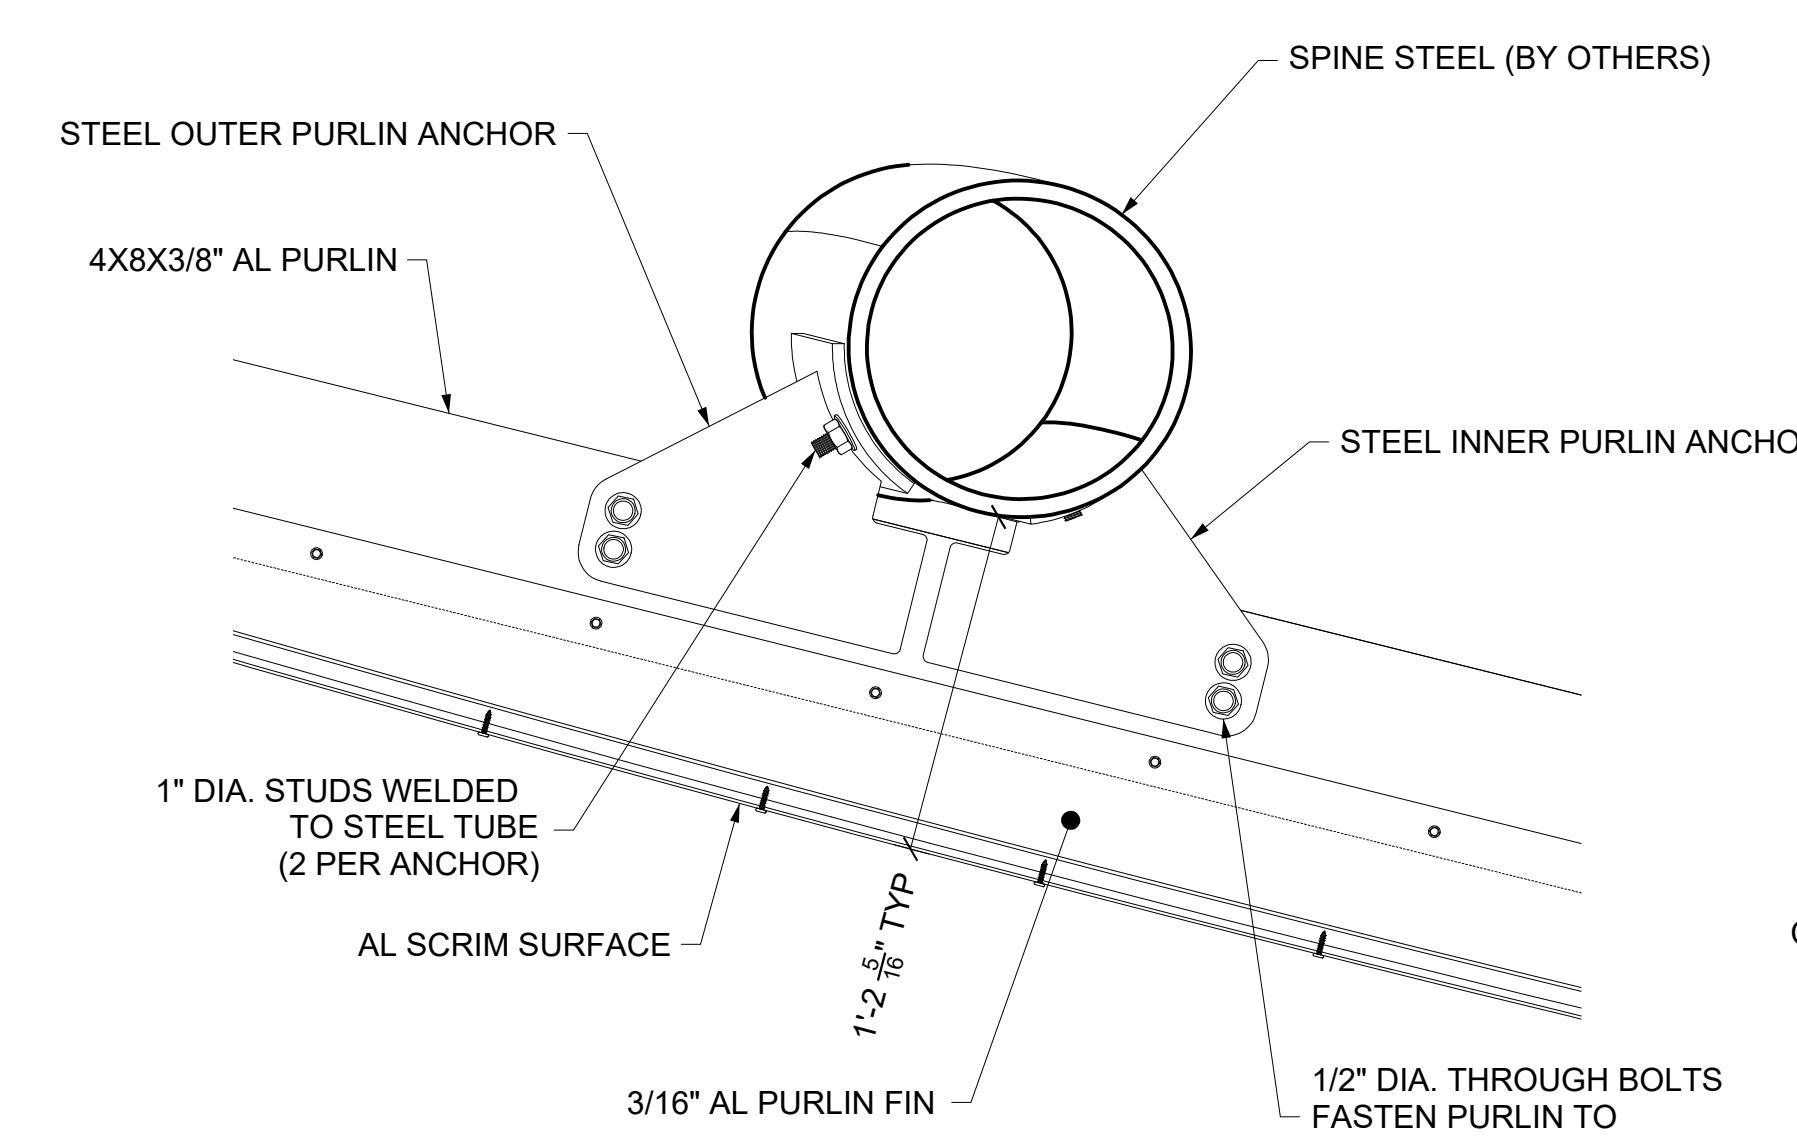


4 ANCHOR DETAIL

SCALE: 1" = 1'-0"  
ZAHNER REF: N/A  
ARCH REF: N/A

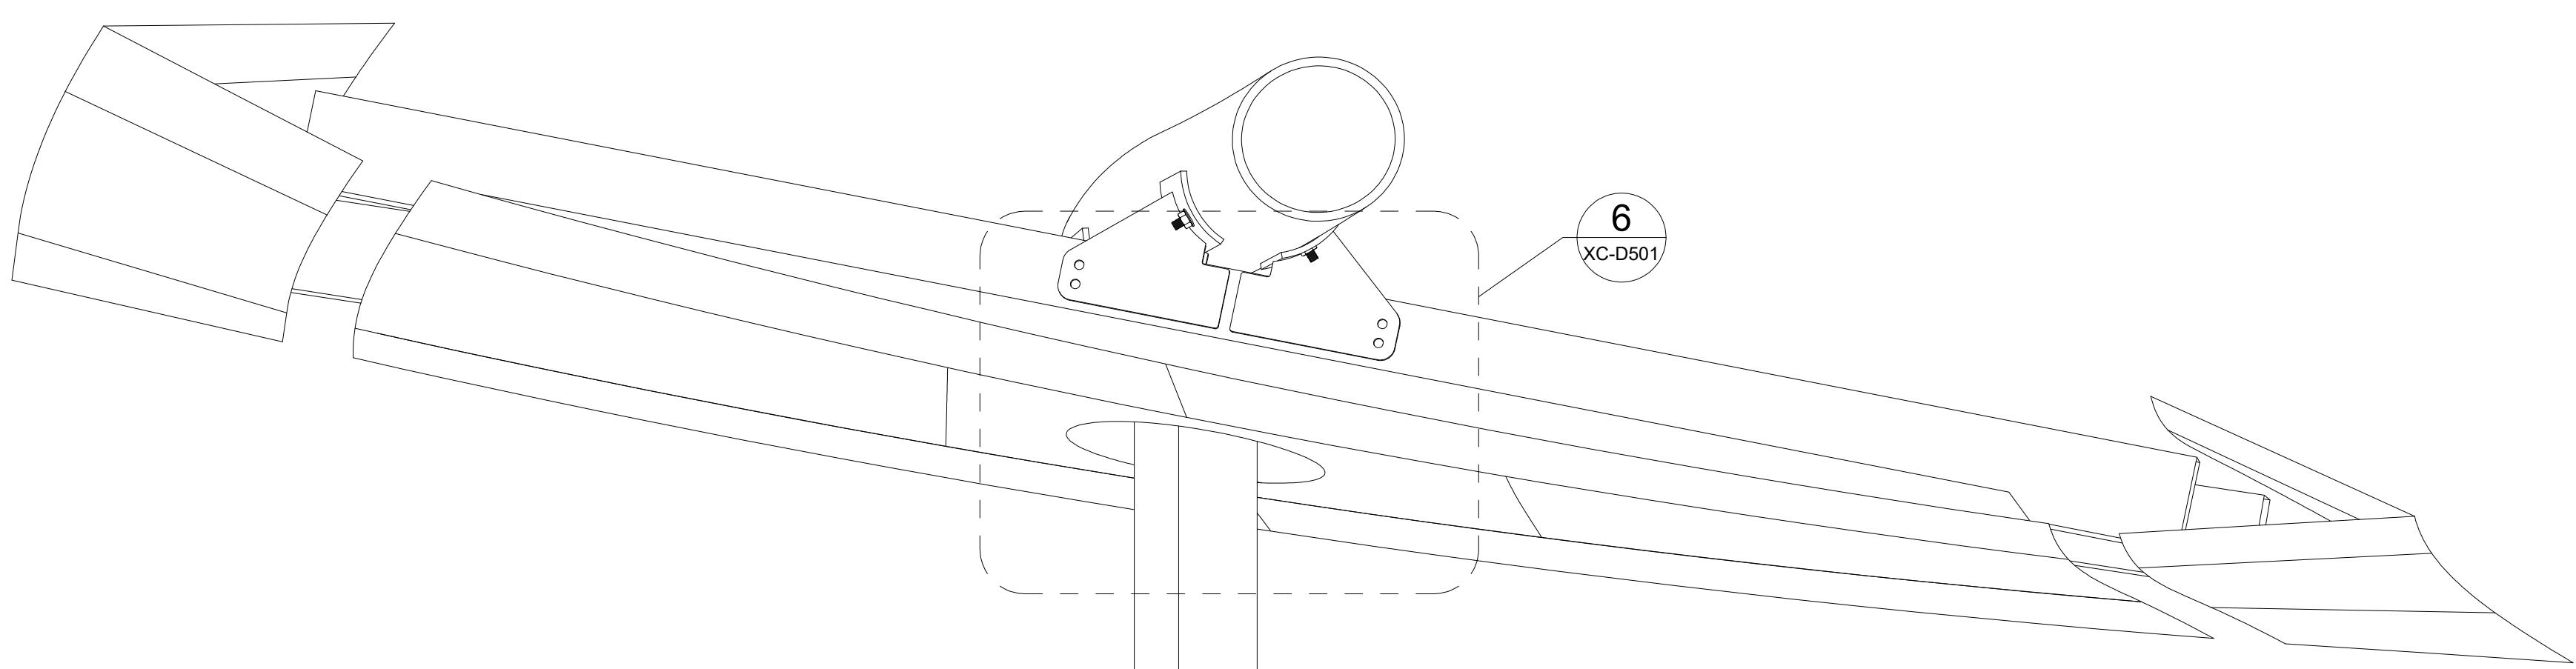


2 CANOPY CROSS SECTION AT COLUMNS

SCALE: 1" = 1'-0"  
ZAHNER REF: N/A  
ARCH REF: N/A

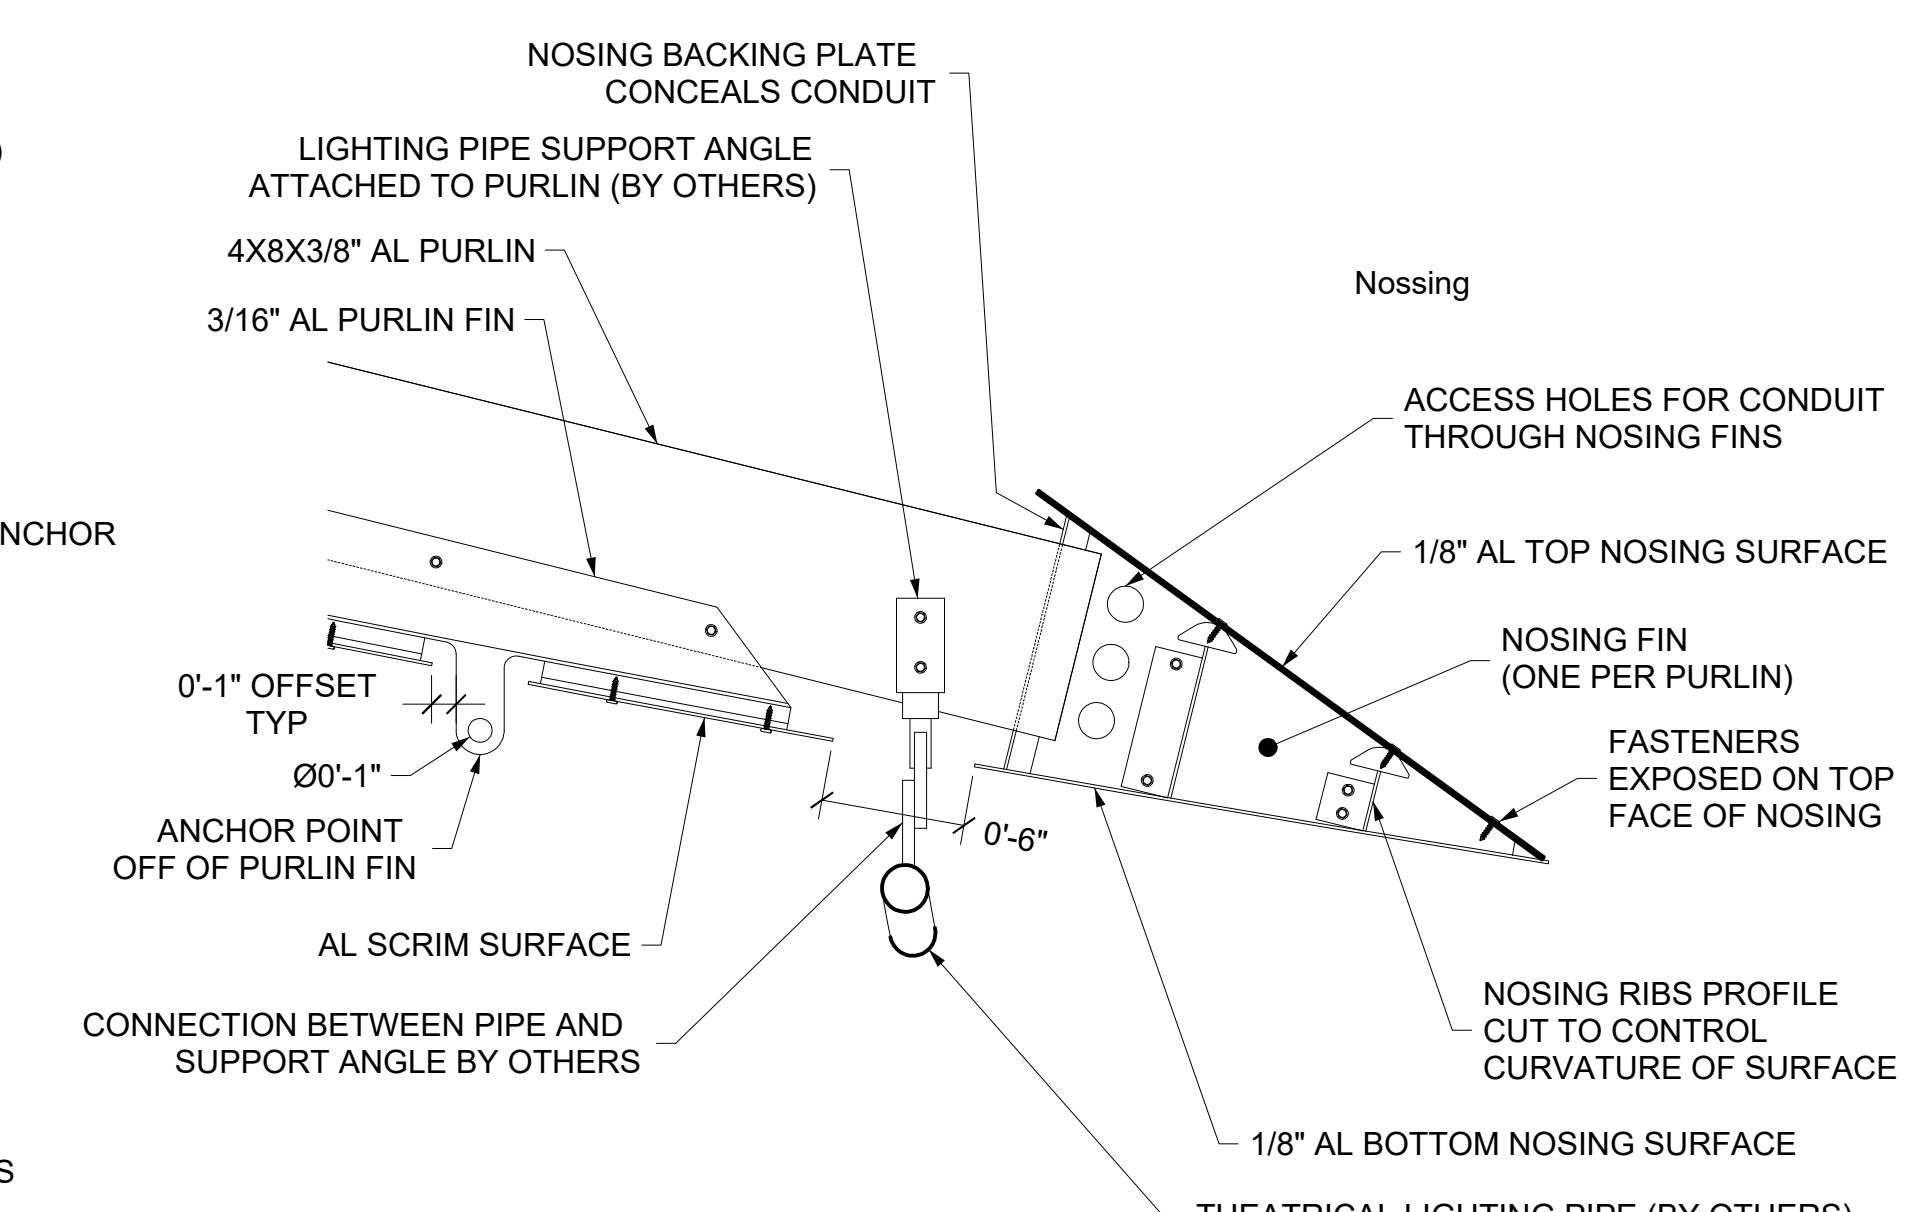

5 INSIDE NOSING DETAIL

SCALE: 1" = 1'-0"  
ZAHNER REF: N/A  
ARCH REF: N/A

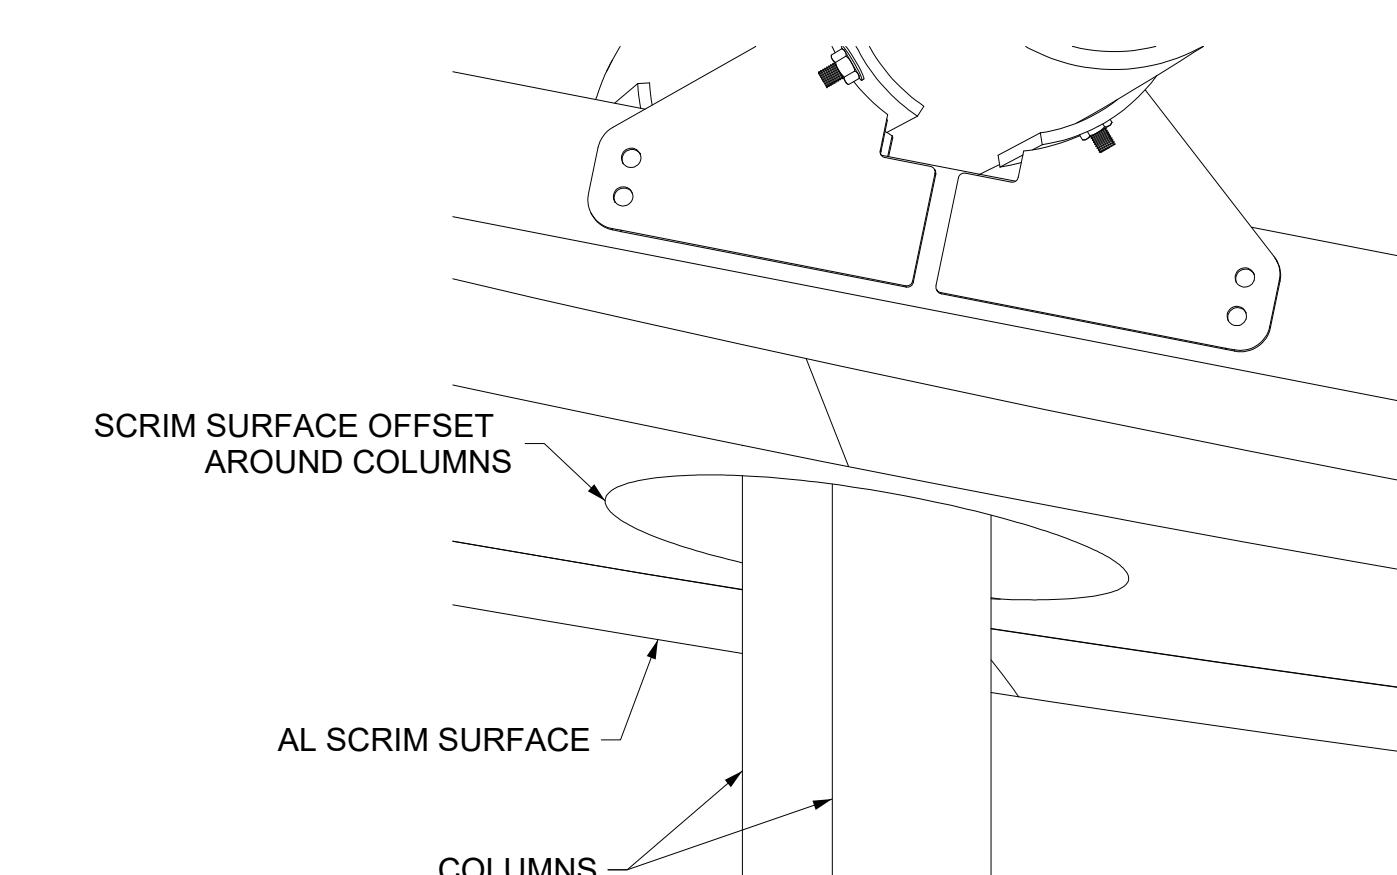

6 SCRIM DETAIL AT COLUMN

SCALE: 1" = 1'-0"  
ZAHNER REF: N/A  
ARCH REF: N/A


THIS SHEET SCALED  
FOR 24X36" BORDER

SET ISSUE DATES		
DATE	ISSUE	
01/20/22 100% DRAWINGS		

REVISIONS		
NO.	DATE	DESCRIPTION




DATE: 01/20/2022	REVISION:	BY:
ENGINEER		
CITY OF SCOTTSDALE CIVIC CENTER PLAZA		
CAPITAL PROJECT MANAGEMENT		
7447 E. INDIAN SCHOOL RD. SCOTTSDALE, ARIZONA 85251		
SHEET TITLE		
360 CANOPY - TYPICAL CANOPY SECTION DETAILS		
PROJECT TITLE		
SCALE	DESIGNED	BID NO.
DRAWN DS	AS-BUILT	COS PROJECT NO. DG04

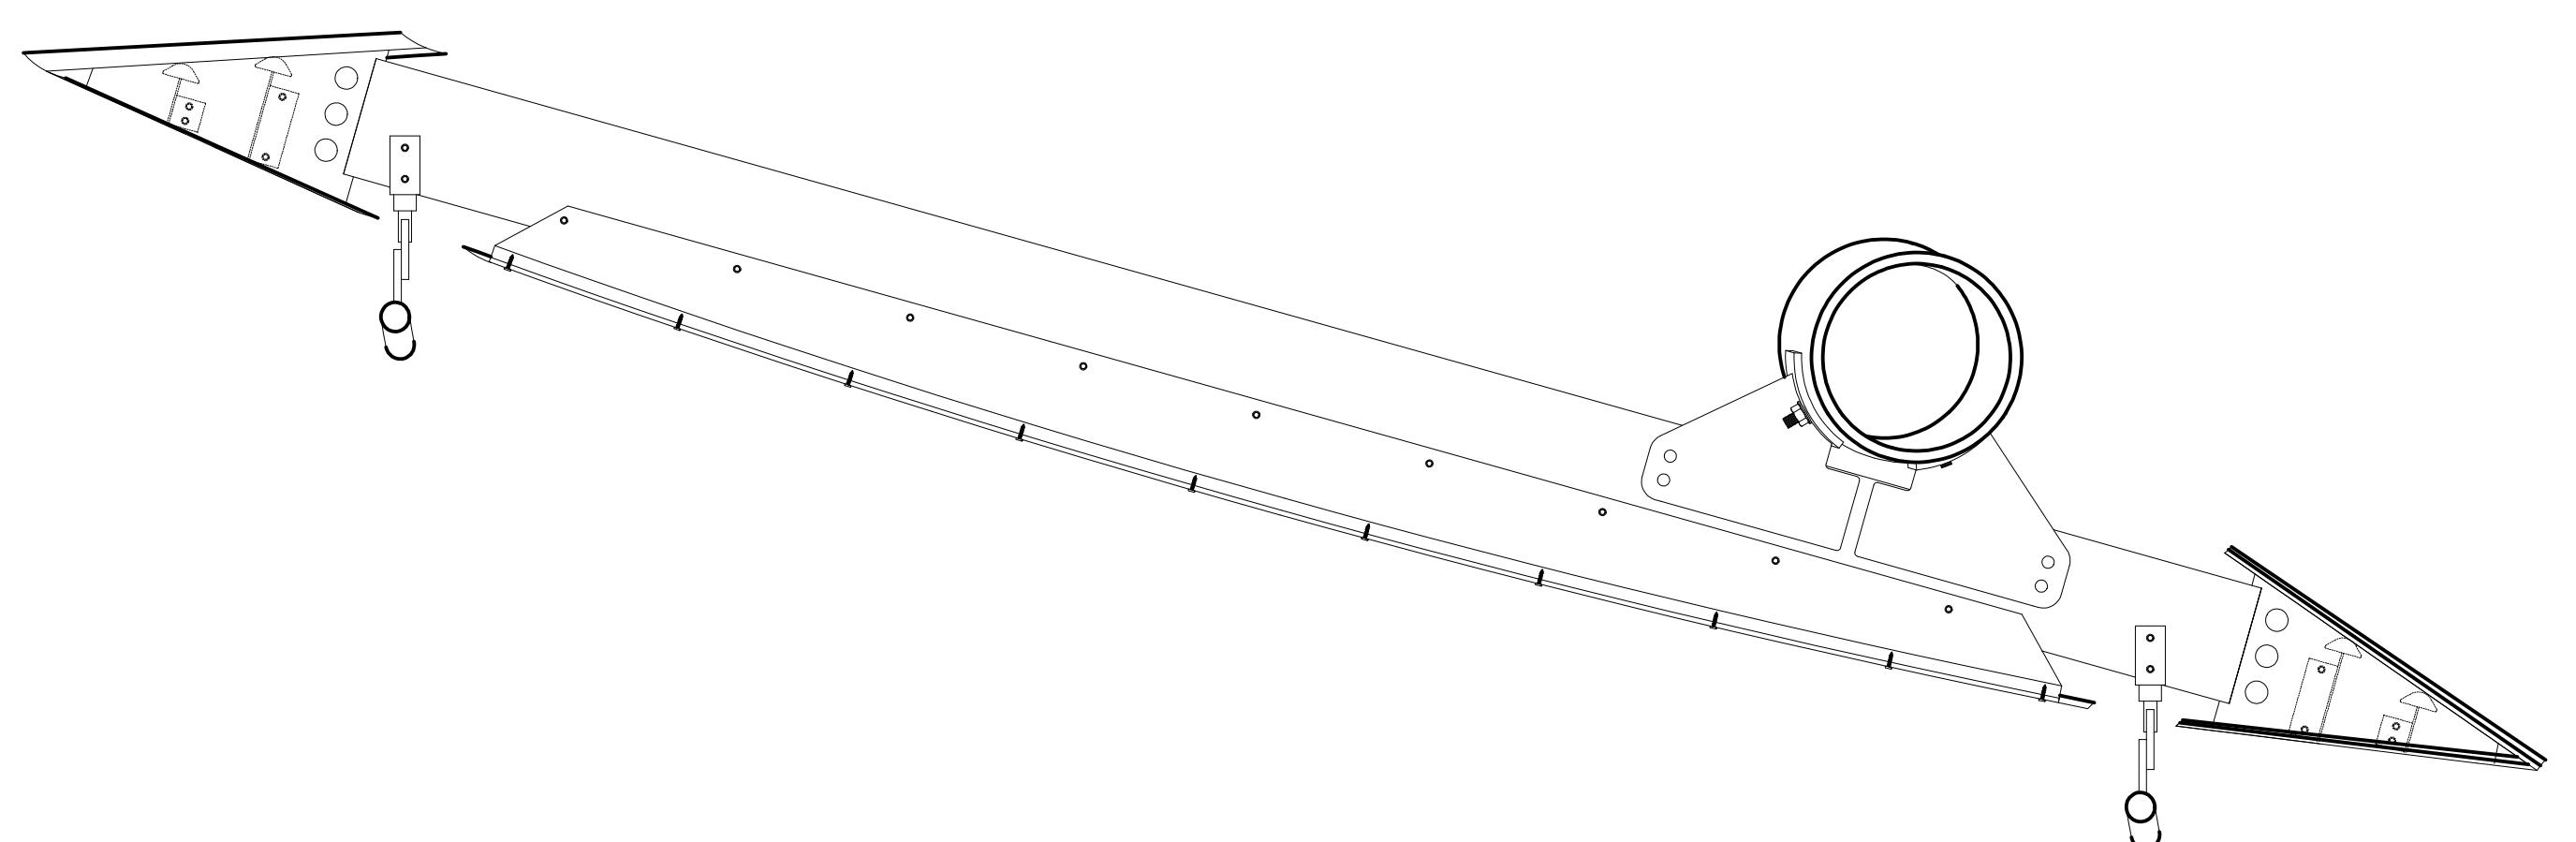

① CANOPY CROSS SECTION AT WALKING PATH

SCALE: 1" = 1'-0"  
ZAHNER REF: N/A  
ARCH REF: N/A

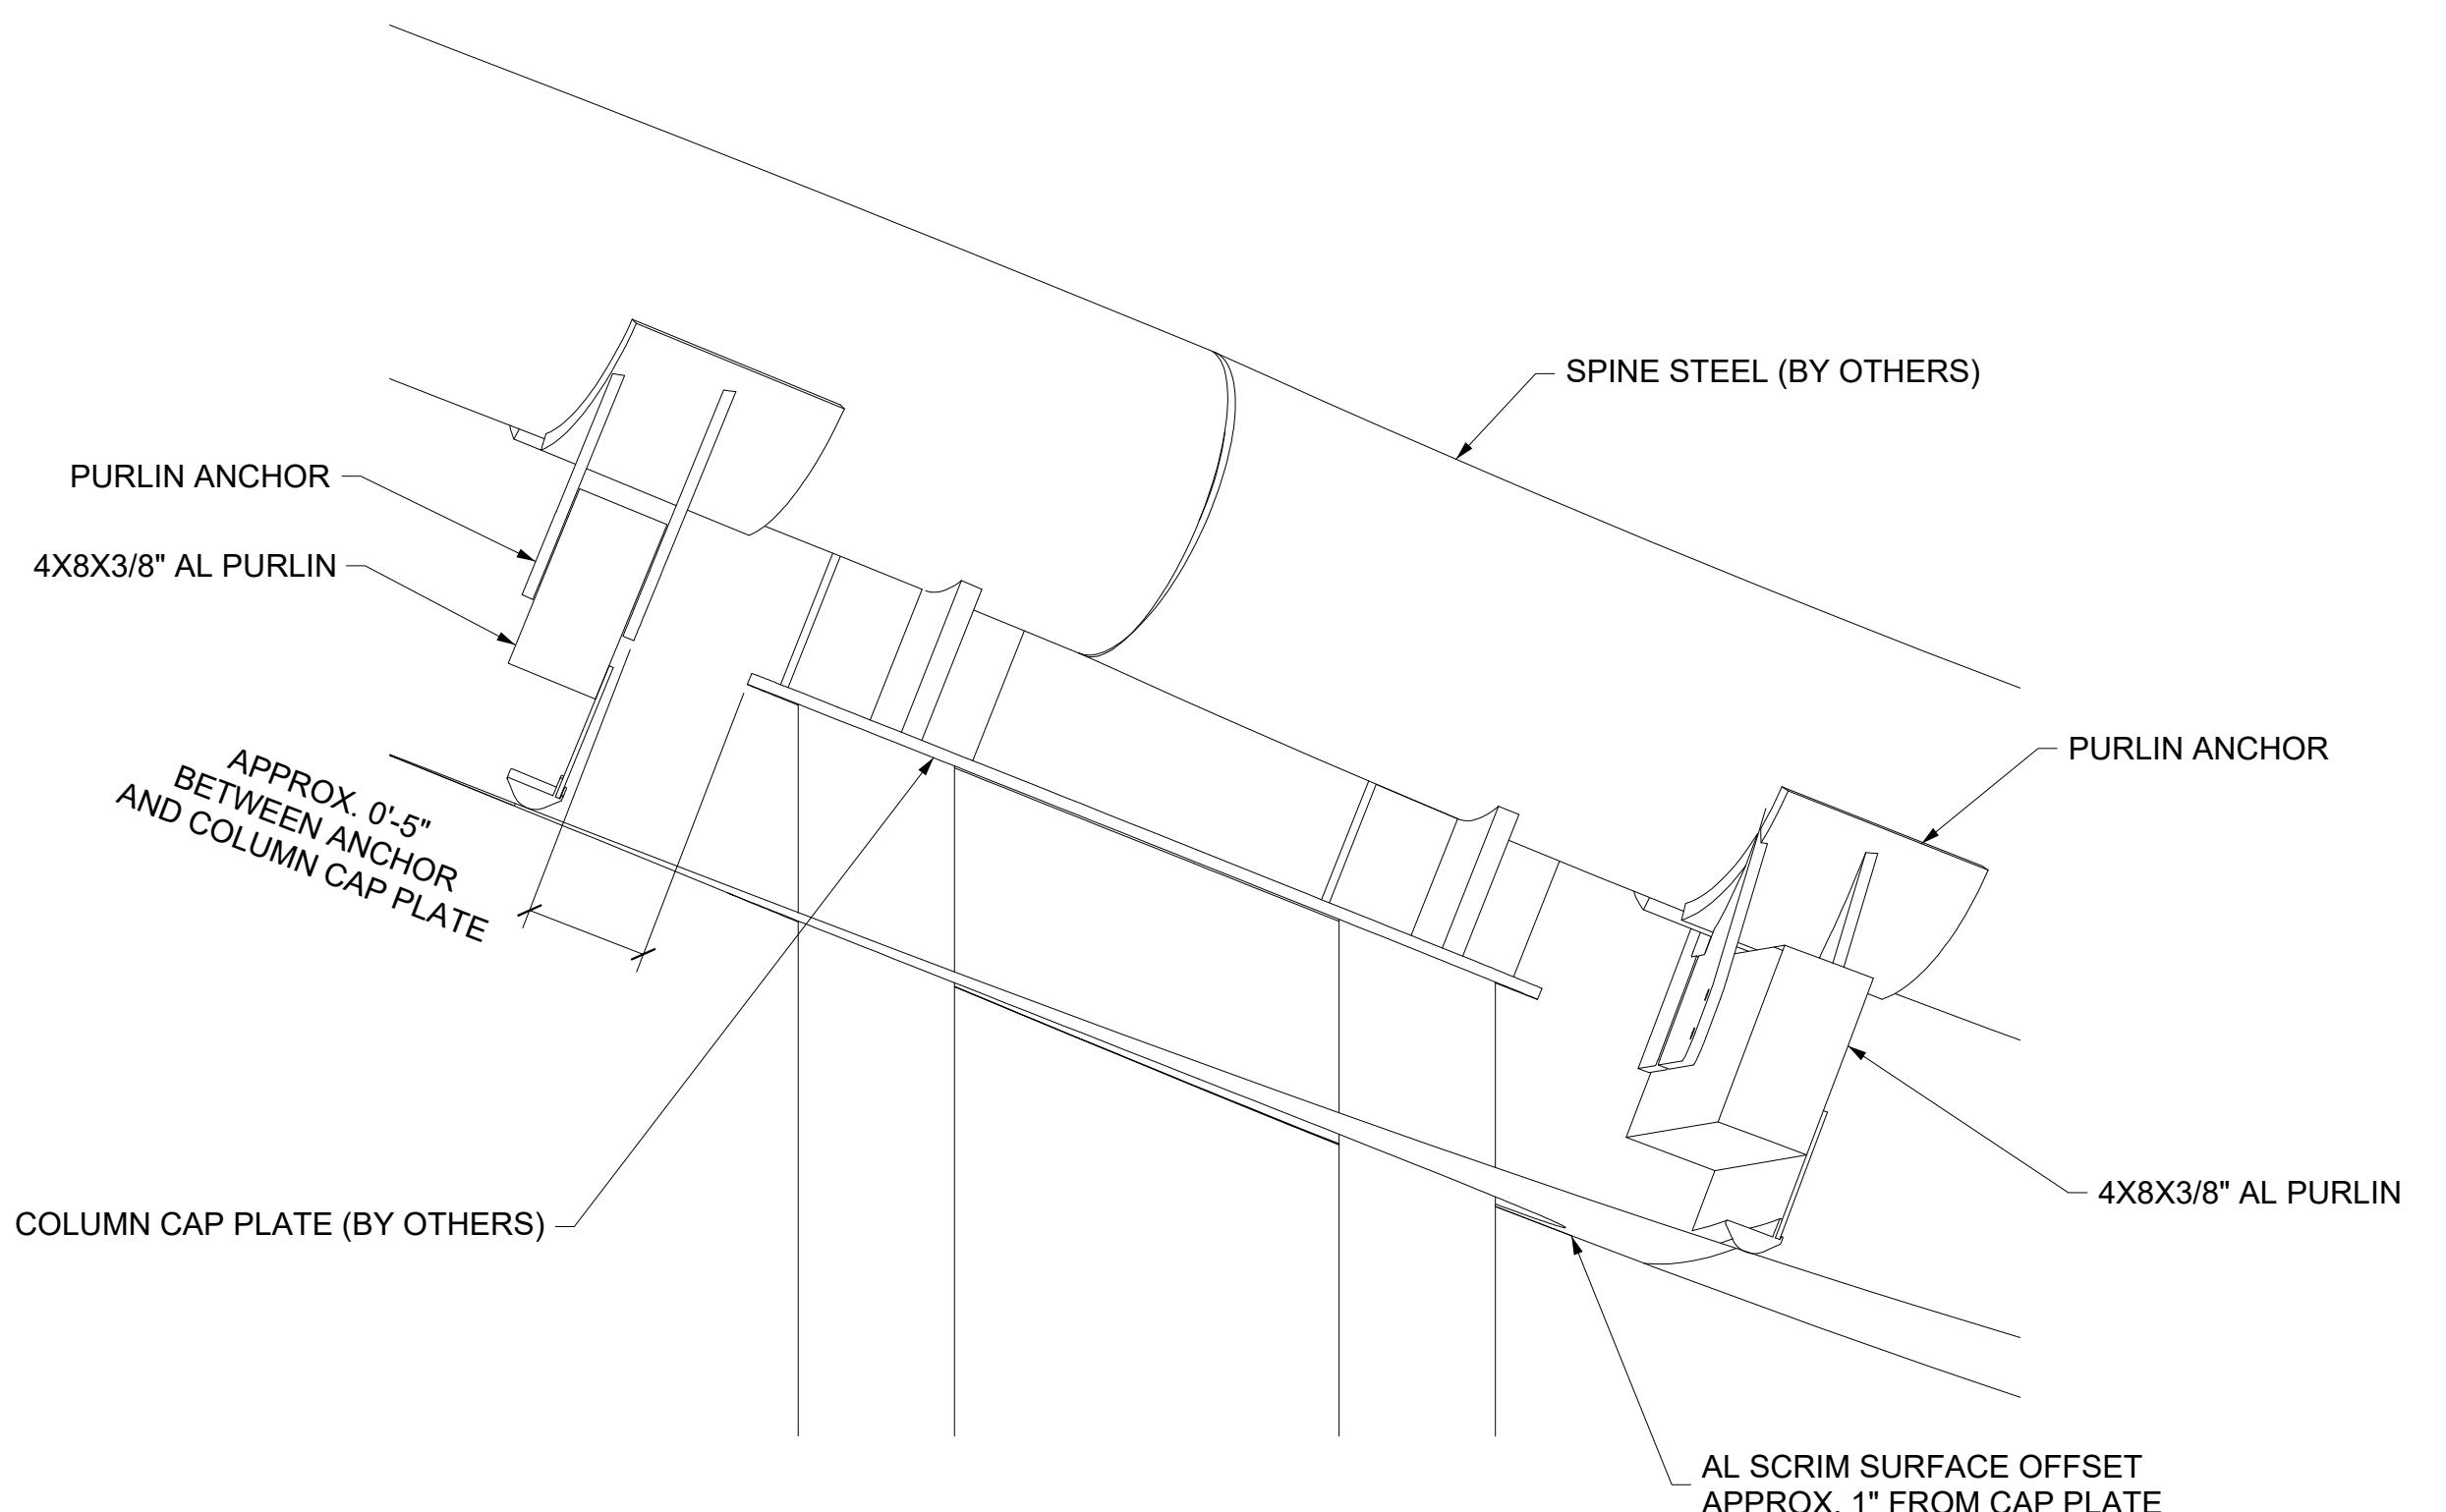

② CANOPY CROSS SECTION AT COLUMNS

SCALE: 1 1/2" = 1'-0"  
ZAHNER REF: N/A  
ARCH REF: N/A

SET ISSUE DATES		
DATE	ISSUE	
01/20/22 100% DRAWINGS		
BY:		
REVISIONS		
NO.	DATE	DESCRIPTION
Contact Arizona 811 at least two full working days before you begin excavation		
Call 811 or click <a href="http://Arizona811.com">Arizona811.com</a>		
DATE: 01/20/2022 REVISION: BY:		
ENGINEER	PUBLIC WORKS	
		CAPITAL PROJECT MANAGEMENT
7447 E. INDIAN SCHOOL RD., SCOTTSDALE, ARIZONA 85251		
SHEET TITLE		
360 CANOPY - CROSS SECTION AT WALKING PATH		
PROJECT TITLE		
CITY OF SCOTTSDALE CIVIC CENTER PLAZA		
THIS SHEET SCALED FOR 24X36" BORDER		
SCALE	DESIGNED	BID NO.
DRAWN DS	AS-BUILT	COS PROJECT NO. DG04