


DRAWING INDEX	
GENERAL DRAWINGS	
XC-001	COVER SHEET AND DRAWING INDEX
PLAN DRAWINGS	
XC-A101	EAST BOWL PLAN
XC-D101	360 PLAN VIEW
ELEVATIONS	
XC-A201	EAST BOWL WEST ELEVATION
DETAILS	
XC-A501	EAST BOWL - SECTION & DETAILS @ CANOPY ROOF
XC-A502	EAST BOWL - WING WALL PLAN DETAILS
XC-A503	EAST BOWL - WING WALL ZEPP DETAILS
XC-A504	EAST BOWL - TYP ZEPP DETAILS
XC-A505	EAST BOWL - BACK KNIFE EDGE DETAIL
XC-A506	EAST BOWL - ANCHOR DETAILS
XC-D501	360 - TYPICAL CANOPY CROSS SECTION & DETAILS
XC-D502	360 - CANOPY CROSS SECTION AT WALKING PATH

miispel

CITY OF SCOTTSDALE CIVIC CENTER PLAZA



SET ISSUE DATES		
DATE	ISSUE	
01/20/22 100% DRAWINGS		
REVISIONS		
NO.	DATE	DESCRIPTION
Contact Arizona 811 at least two full working days before you begin excavation		
ARIZONA811 Call 811 or click Arizona811.com		
DATE: 01/20/2022 REVISION:		BY:
PUBLIC WORKS CAPITAL PROJECT MANAGEMENT <small>7447 E. INDIAN SCHOOL RD. SCOTTSDALE, ARIZONA 85251</small>		SHEET TITLE
COVER SHEET AND DRAWING INDEX		
PROJECT TITLE CITY OF SCOTTSDALE CIVIC CENTER PLAZA		
THIS SHEET SCALED FOR 24X36" BORDER <small>DRAWN DS AS-BUILT COS PROJECT NO. DG04</small>		SCALE <small>XC-001</small>

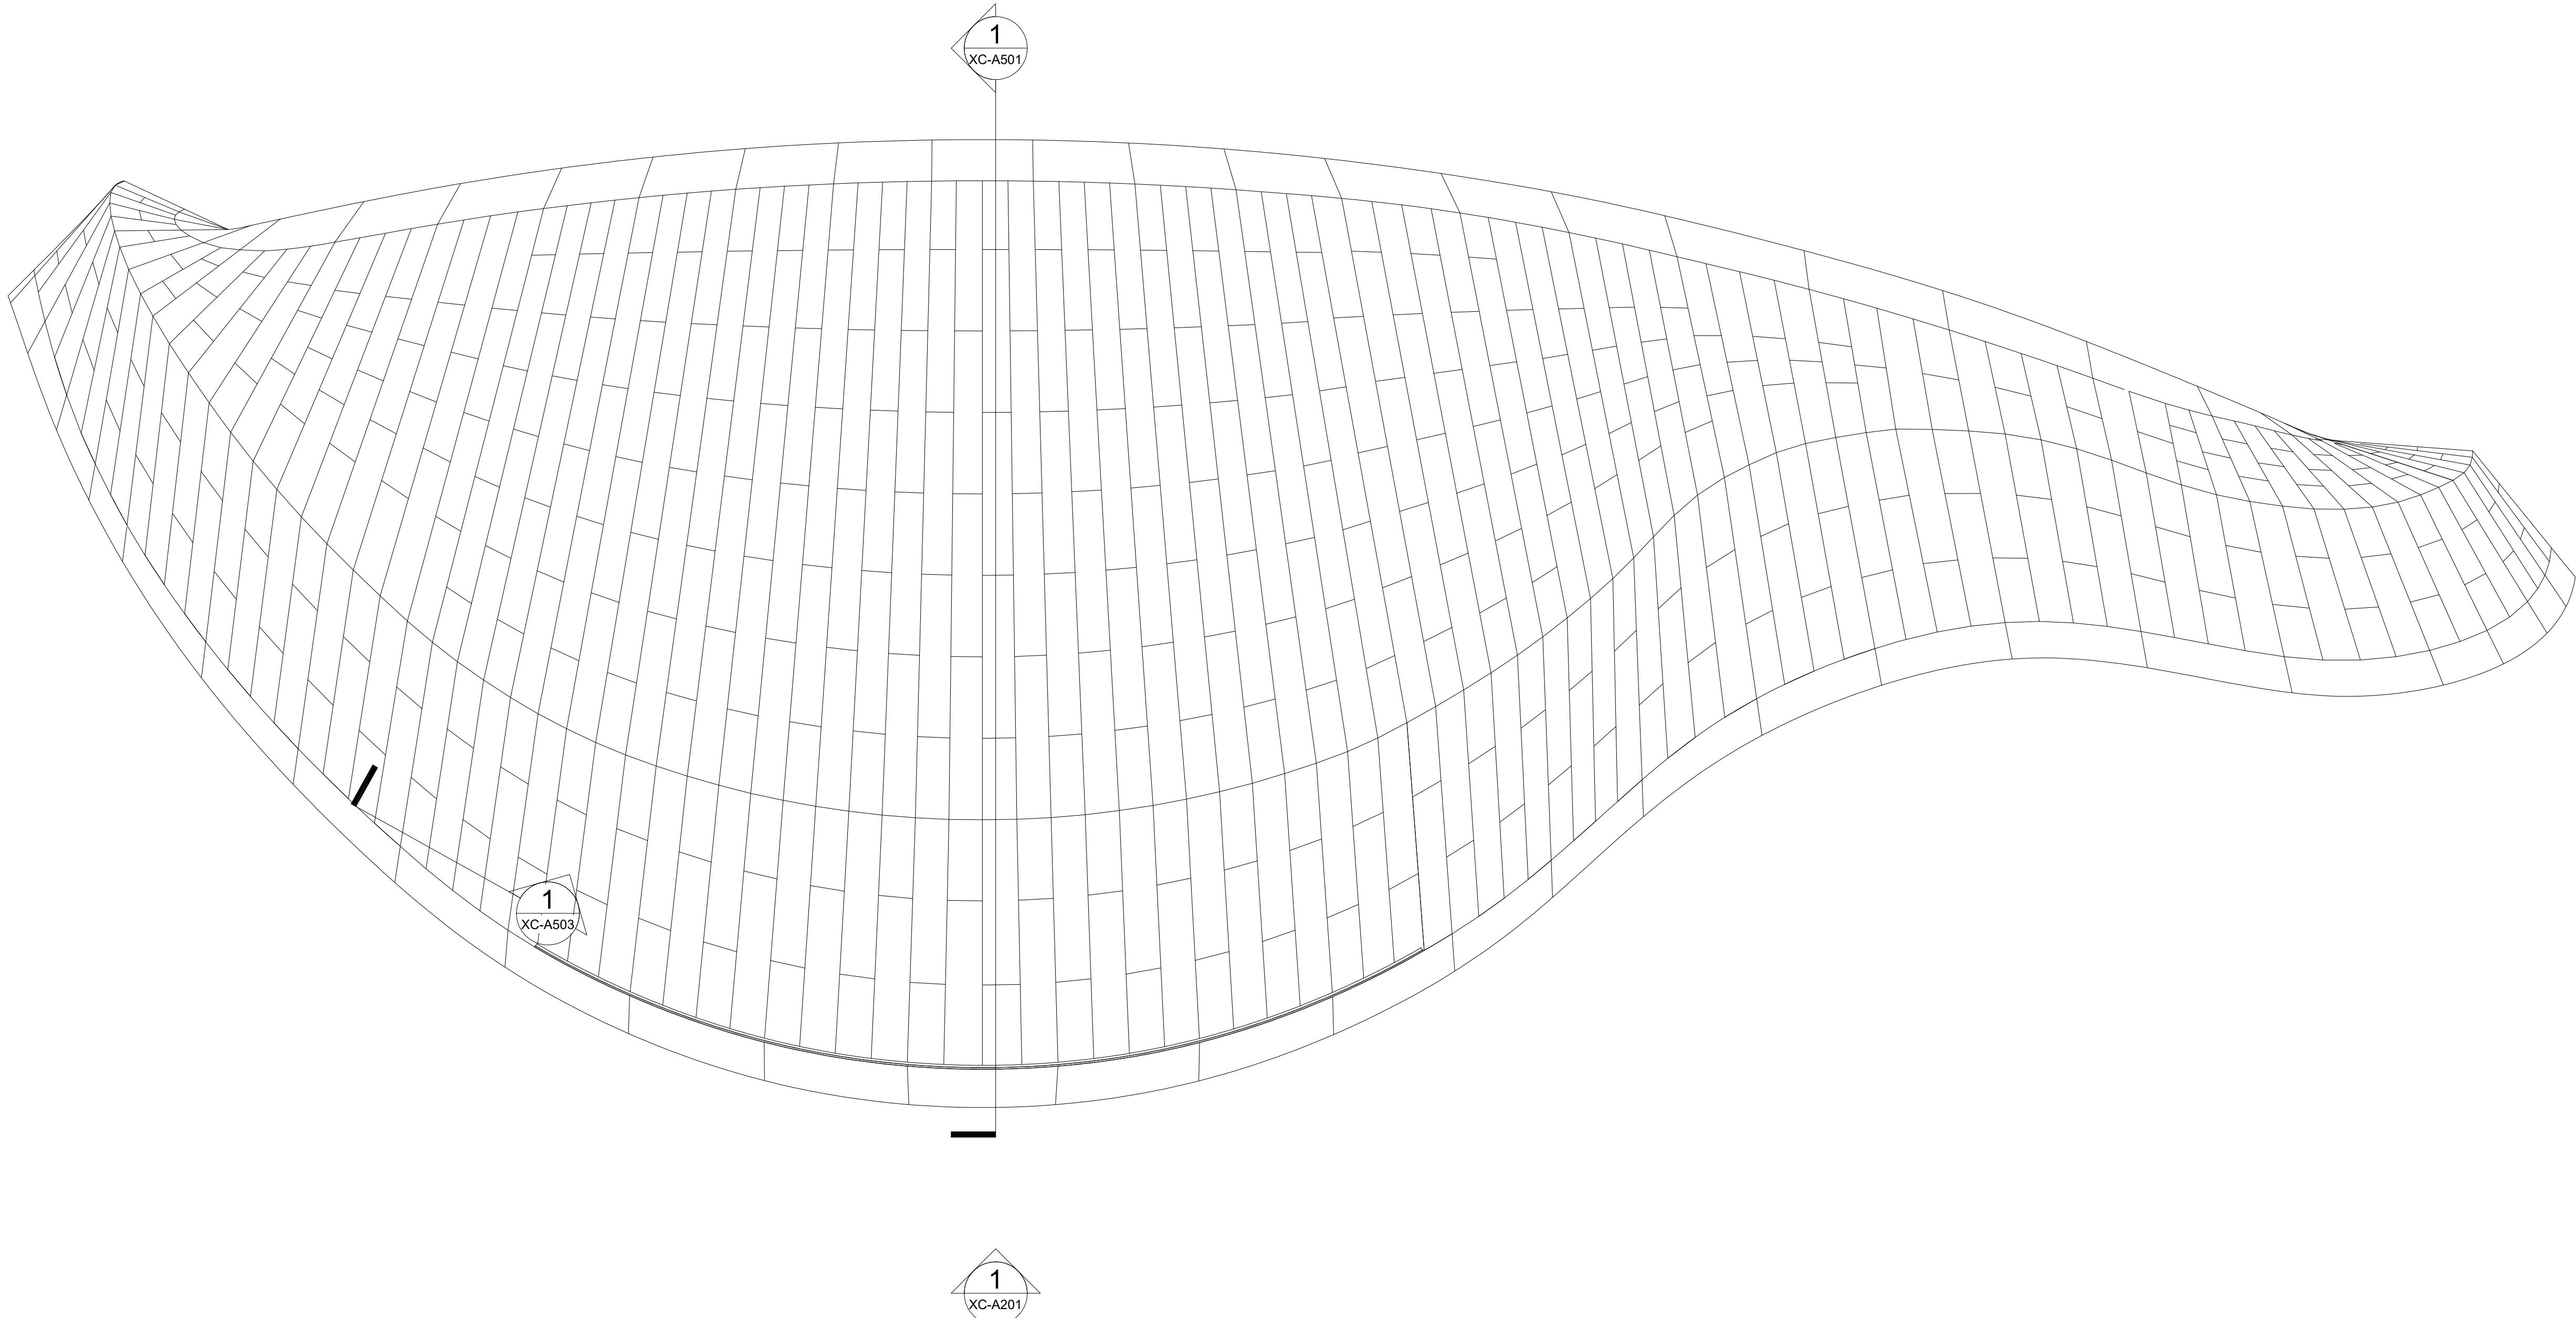


EAST BOWL PLAN VIEW

SCALE: 3/16" = 1'-0"

ZAHNER REF: N/A
ARCH REF: N/A

SET ISSUE DATES		
DATE	ISSUE	
01/20/22 100% DRAWINGS		

REVISIONS		
NO.	DATE	DESCRIPTION

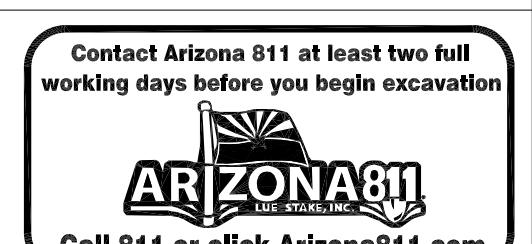


DATE: 01/20/2022		REVISION:	BY:
ENGINEER		PUBLIC WORKS	
		CAPITAL PROJECT MANAGEMENT	
		7447 E. INDIAN SCHOOL RD., SCOTTSDALE, ARIZONA 85251	
SHEET TITLE			

EAST BOWL PLAN

PROJECT TITLE		CITY OF SCOTTSDALE CIVIC CENTER PLAZA	
---------------	--	--	--

THIS SHEET SCALED FOR 24X36" BORDER	SCALE	DESIGNED	BID NO.	XC-A101
	DRAWN DS	AS-BUILT	COS PROJECT NO. DG04	

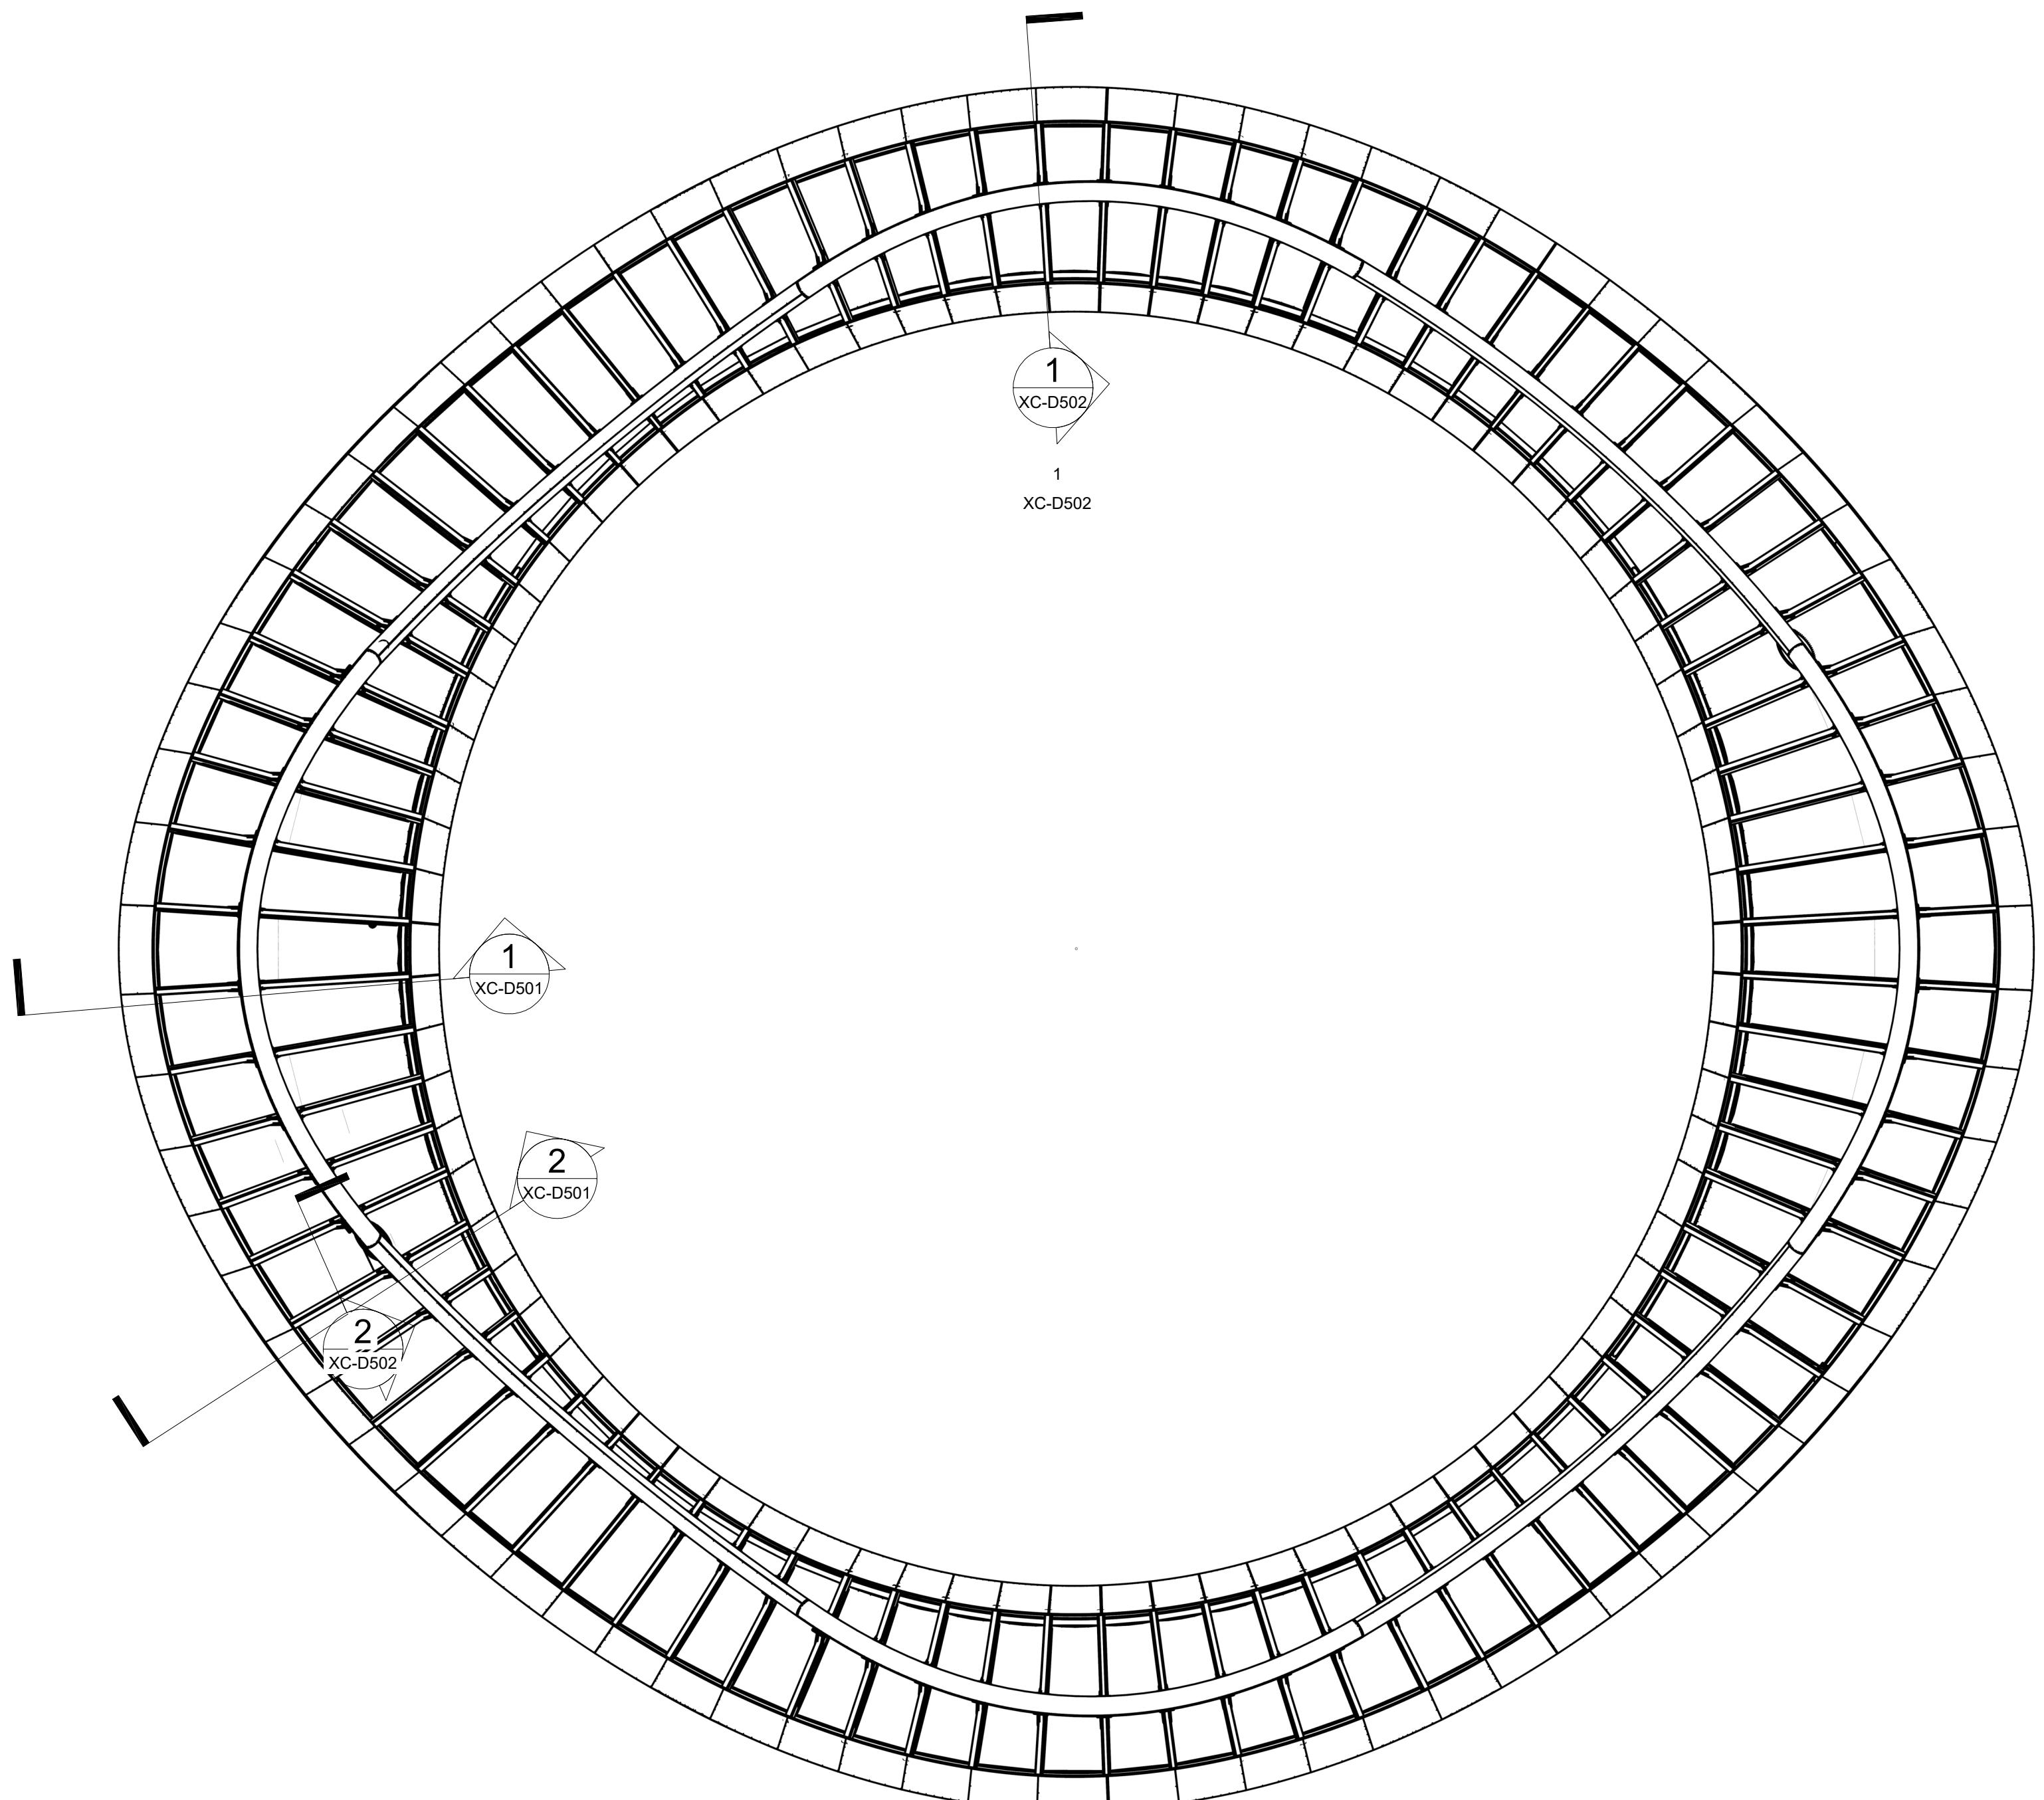

1 360 CANOPY - PLAN VIEW
SCALE: 1/8" = 1'-0" ZAH

SCALE: 1/8" = 1'-0"

ZAHNER REF: XX
ARCH REF: XX

The logo for RITOCH-POWELL & Associates. It features a stylized 'RPA' monogram on the left, composed of three letters with internal line patterns. To the right of the monogram, the company name 'RITOCH-POWELL' is written in a large, bold, sans-serif font. Below it, '& Associates' is written in a slightly smaller, bold, sans-serif font. At the bottom, the phone number '602-263-1177' and the website 'WWW.RPAENG.COM' are provided in a bold, sans-serif font.


L A K E | **F L A T O**
© 2021 Lake|Flato Architects, Inc.

311 THIRD STREET
SAN ANTONIO, TEXAS 78205
210.227.3335 F210.224.9515
www.lakeflato.com

ARCHITECTS INC.

ZAHNER

ARCHITECTURAL METAL

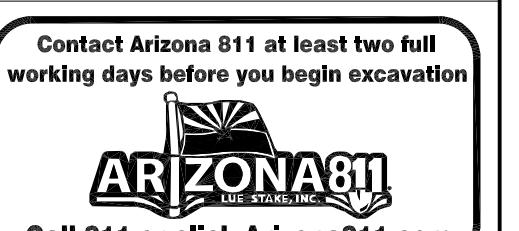


The logo for the City of Scottsdale, Arizona, Public Works Capital Project Management. It features a circular seal with a scalloped outer edge. The words "CITY OF SCOTTSDALE" are at the top and "ARIZONA" are at the bottom. In the center is a illustration of a person riding a horse, with the text "THE WEST'S MOST WESTERN TOWN" below it. To the right of the seal, the words "PUBLIC WORKS" are stacked vertically, followed by "CAPITAL PROJECT MANAGEMENT". Below the seal, the address "7447 E. INDIAN SCHOOL RD. SCOTTSDALE, ARIZONA 85251" is written.

360 CANOPY PLAN


PROJECT TITLE CITY OF SCOTTSDALE
CIVIC CENTER PLAZA

THIS SHEET SCALED FOR 24X36" BORDER	SCALE	DESIGNED		BID NO.	XC-D101
		DRAWN DS	AS-BUILT	COS PROJECT NO. DG04	

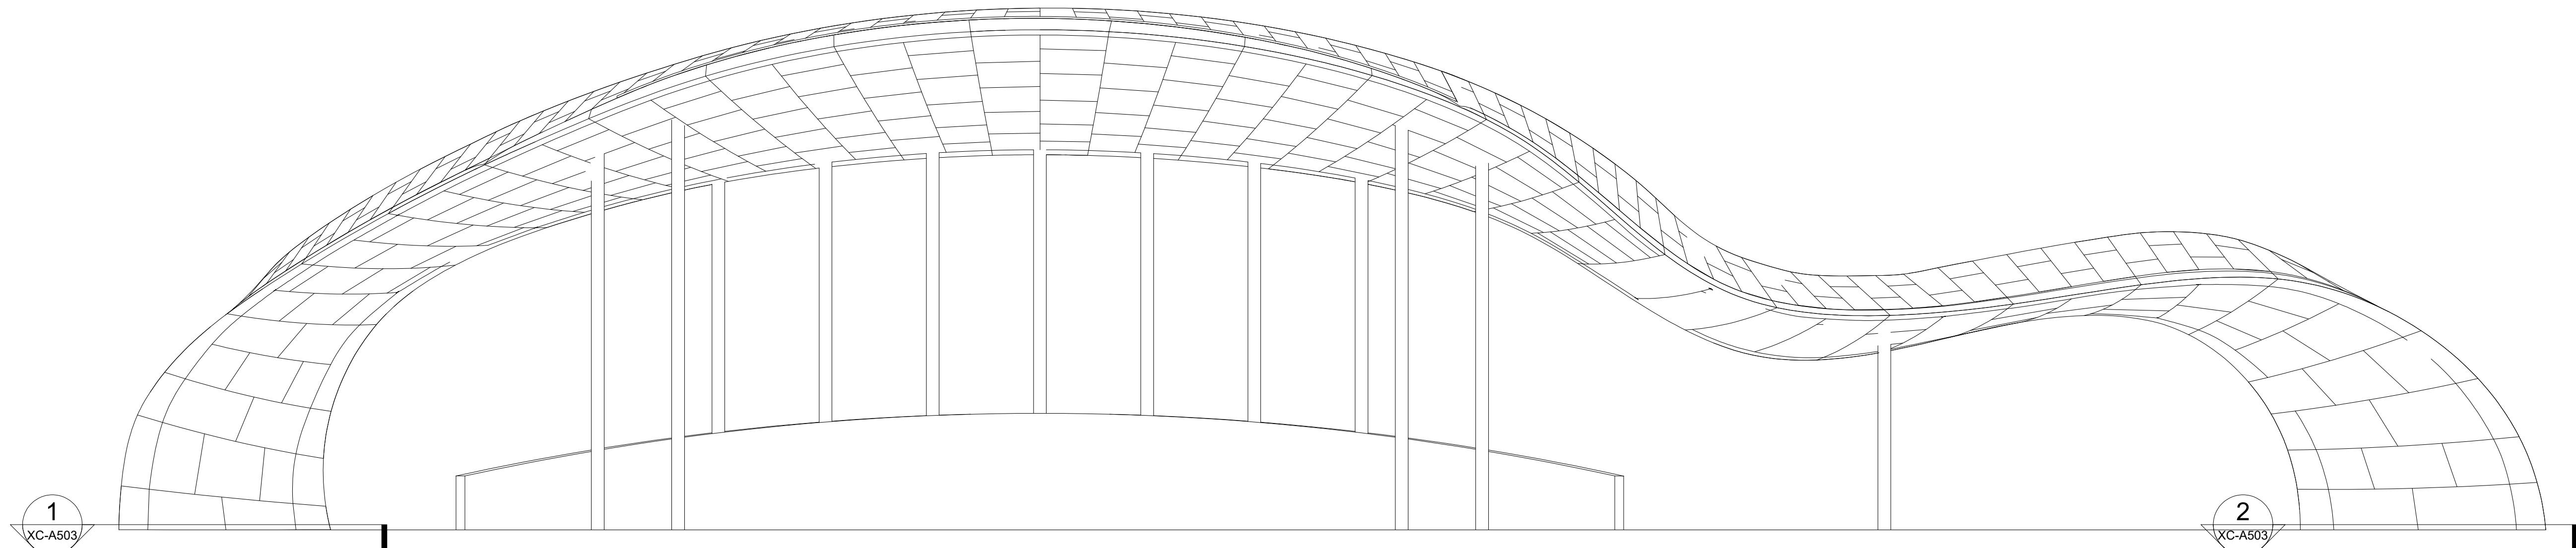

① EAST BOWL WEST ELEVATION
SCALE: 3/16" = 1'-0"
ZAHNER REF: N/A
ARCH REF: N/A

SET ISSUE DATES		
DATE	ISSUE	BY:
01/20/22 100% DRAWINGS		
REVISIONS		
NO.	DATE	DESCRIPTION

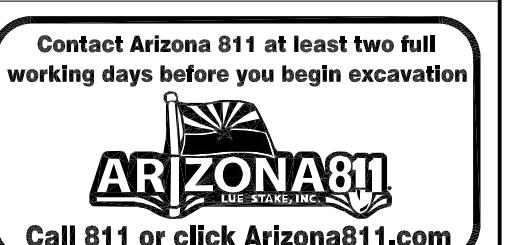


DATE: 01/20/2022	REVISION:	BY:
ENGINEER		PUBLIC WORKS
		CAPITAL PROJECT MANAGEMENT
SHEET TITLE CITY OF SCOTTSDALE CIVIC CENTER PLAZA		

EAST BOWL WEST ELEVATION

PROJECT TITLE		CITY OF SCOTTSDALE CIVIC CENTER PLAZA	
DESIGNED	BID NO.	SCALE	XC-A201
DRAWN DS	AS-BUILT	COS PROJECT NO.	DG04

THIS SHEET SCALED
FOR 24X36" BORDER

BY:
PROTECTED
BY:

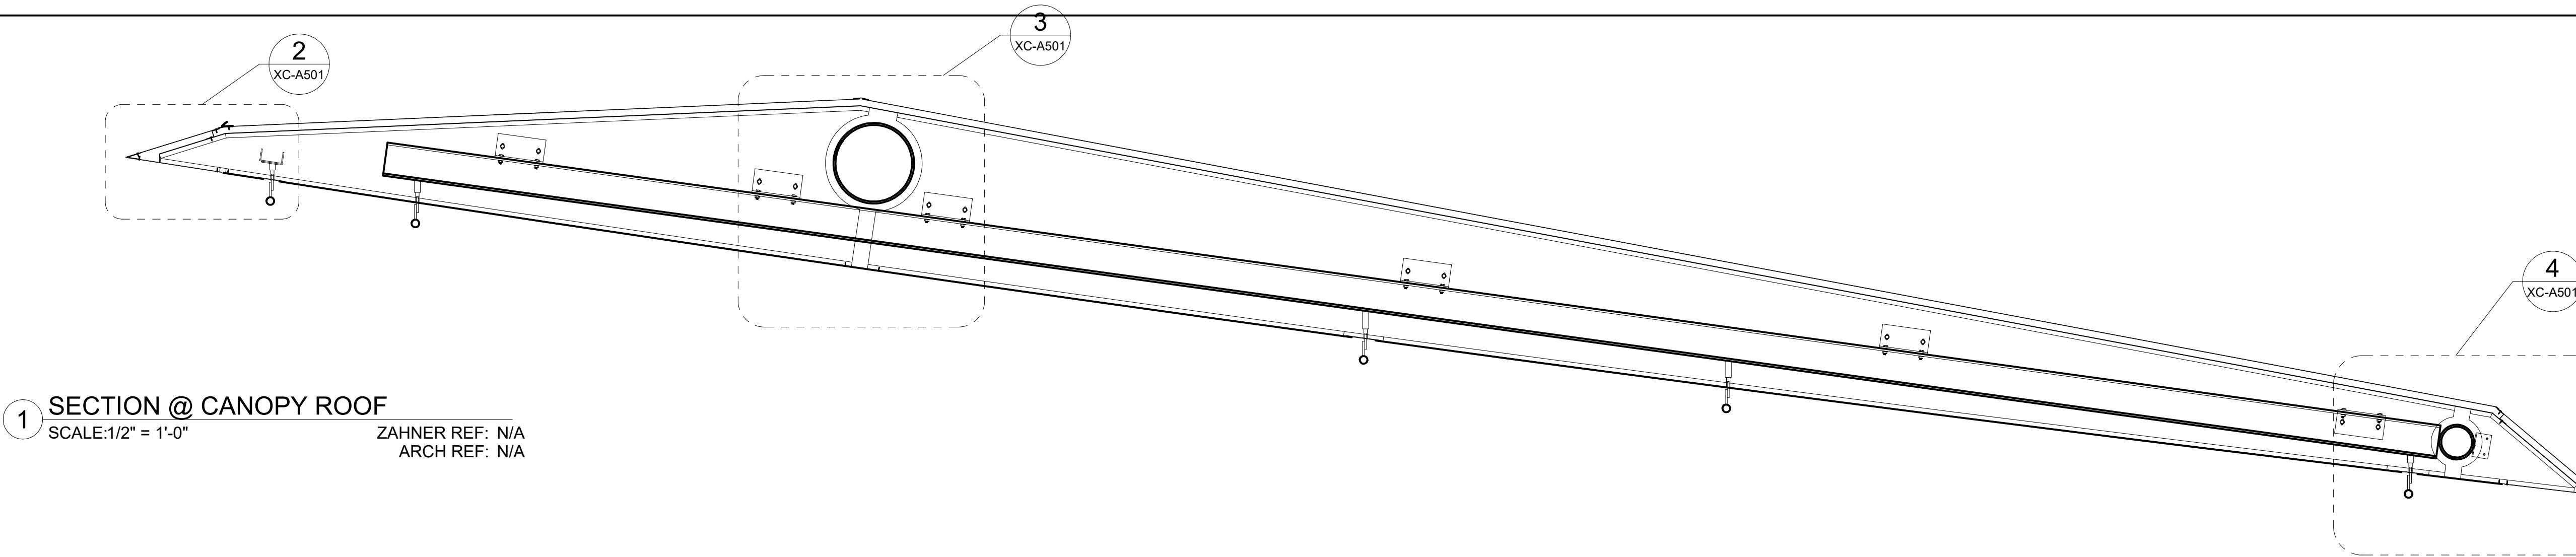


1 SECTION @ CANOPY ROOF

SCALE: 1/2" = 1'-0"
 ZAHNER REF: N/A
 ARCH REF: N/A


2 SECTION DETAIL @ DOWNSTAGE CANOPY

SCALE: 1 1/2" = 1'-0"
 ZAHNER REF: N/A
 ARCH REF: N/A

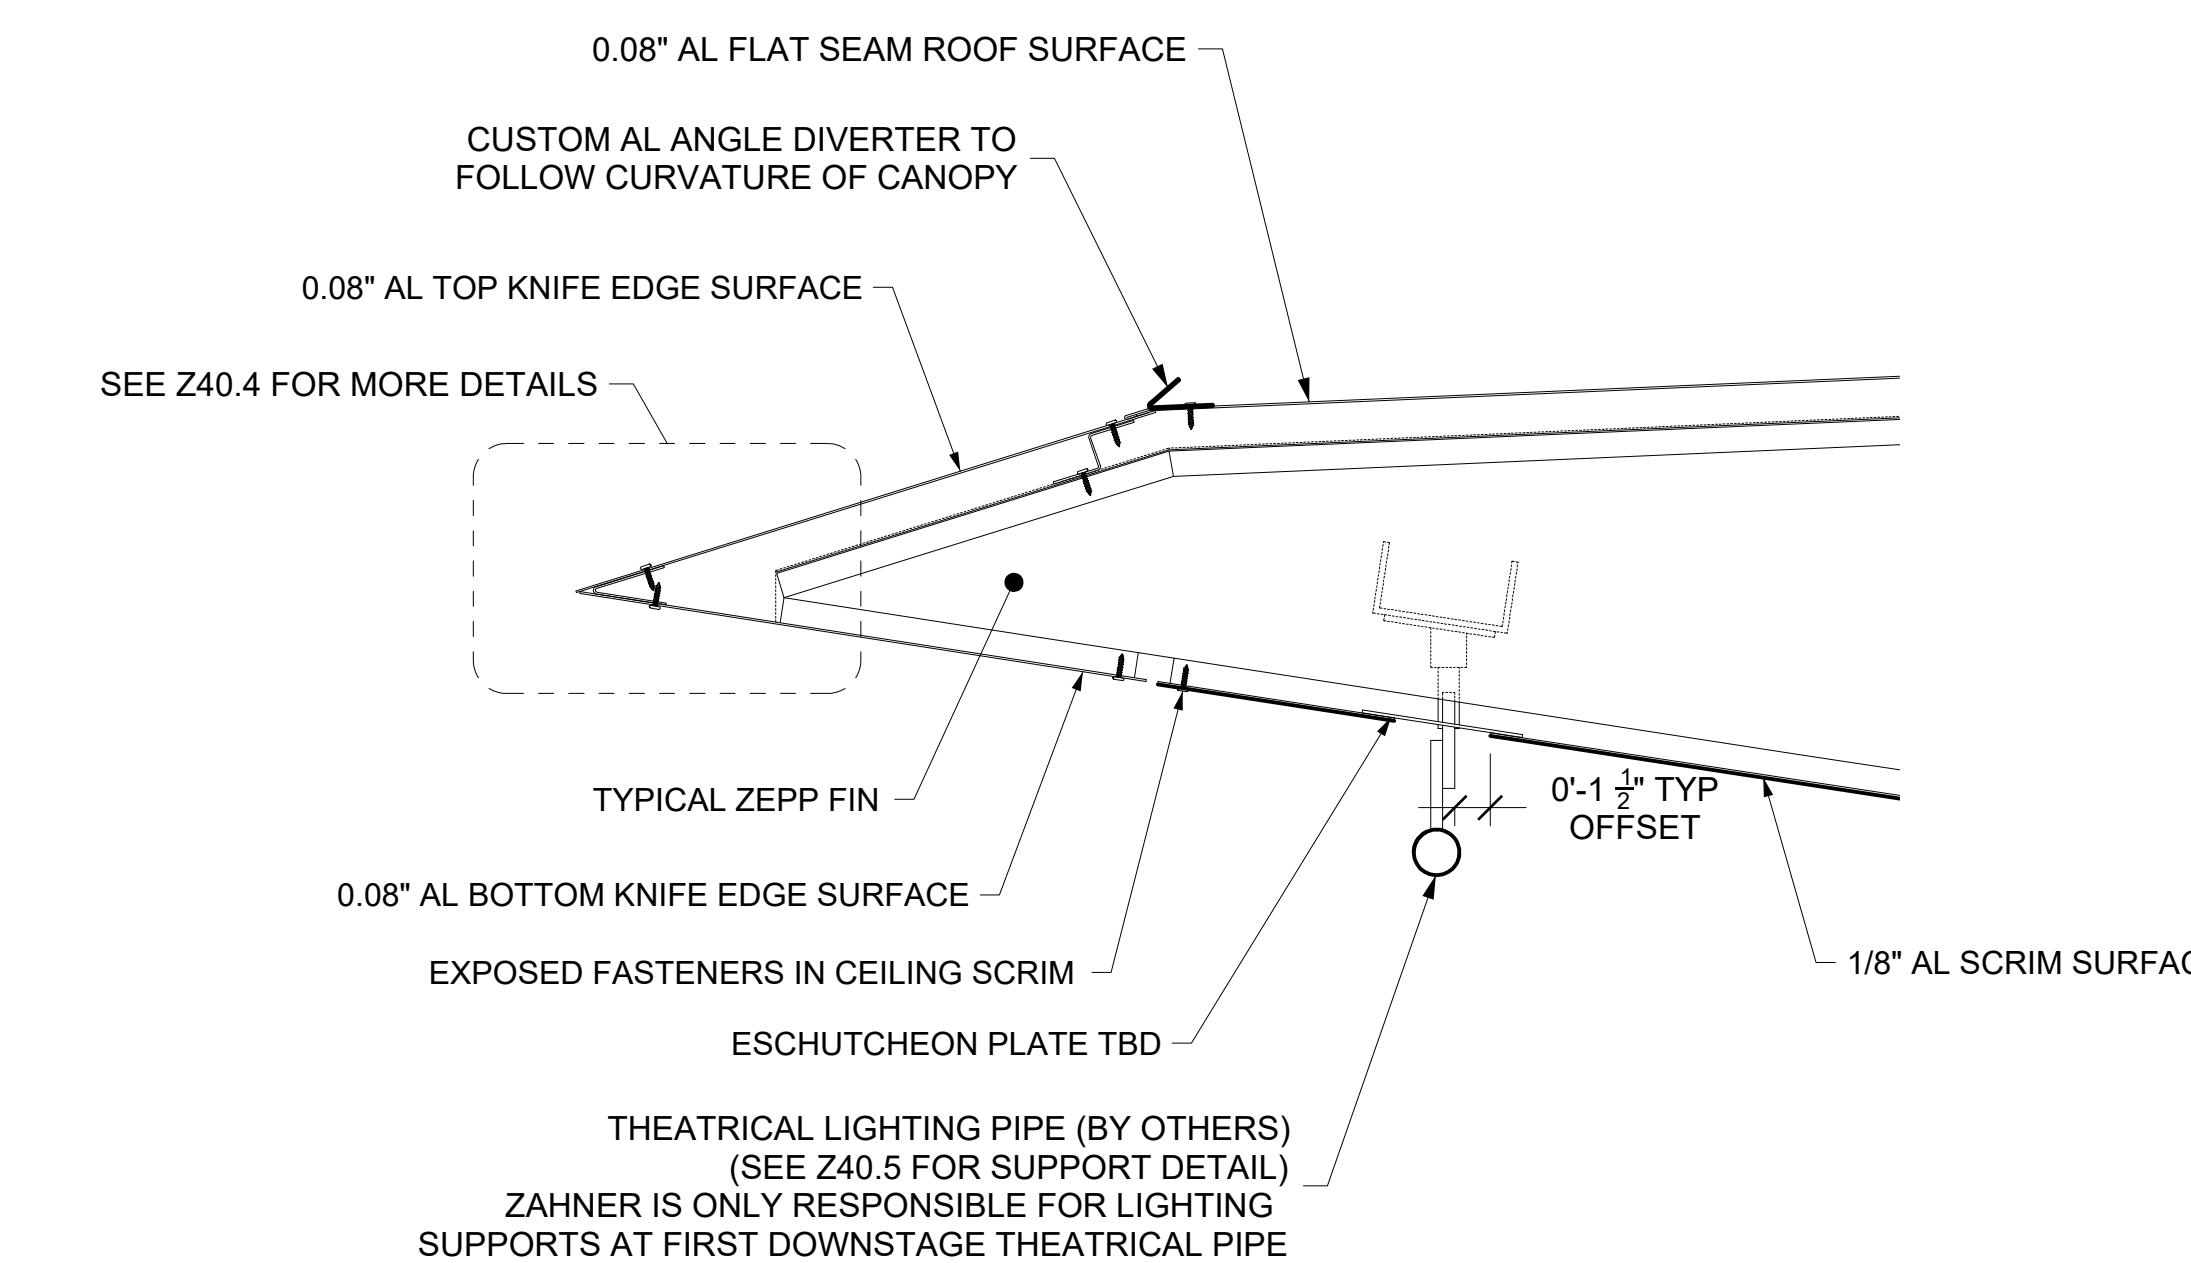


3 SECTION DETAIL @ DOWNSTAGE CANOPY

SCALE: 1 1/2" = 1'-0"
 ZAHNER REF: N/A
 ARCH REF: N/A

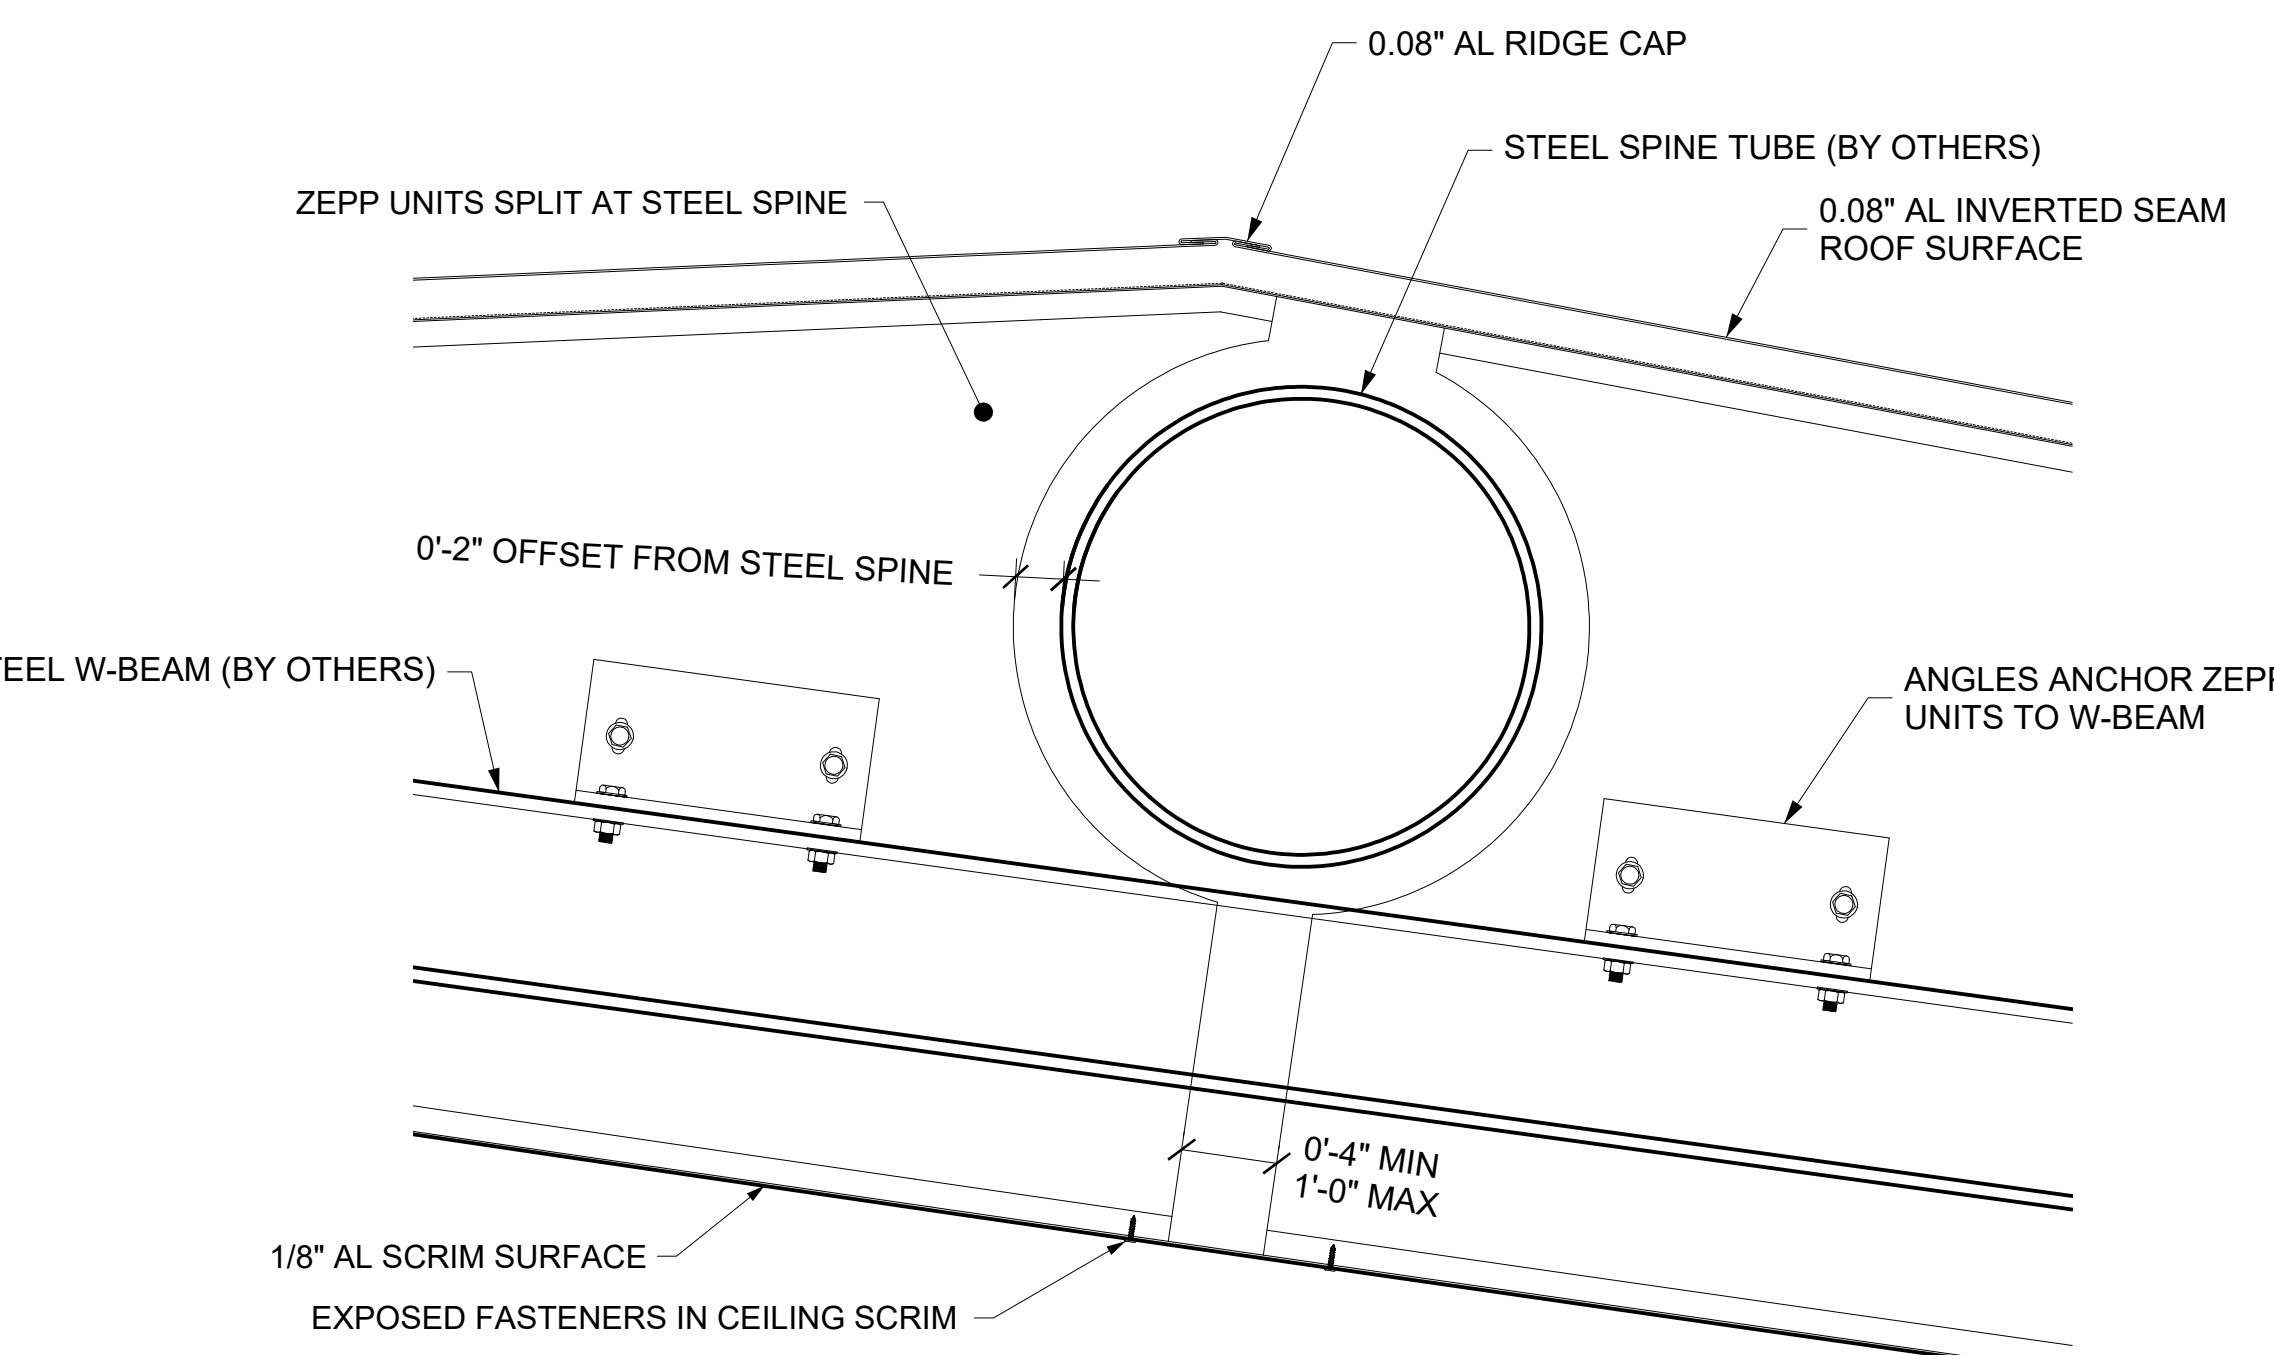

3 SECTION DETAIL @ DOWNSTAGE CANOPY

SCALE: 1 1/2" = 1'-0"
 ZAHNER REF: N/A
 ARCH REF: N/A

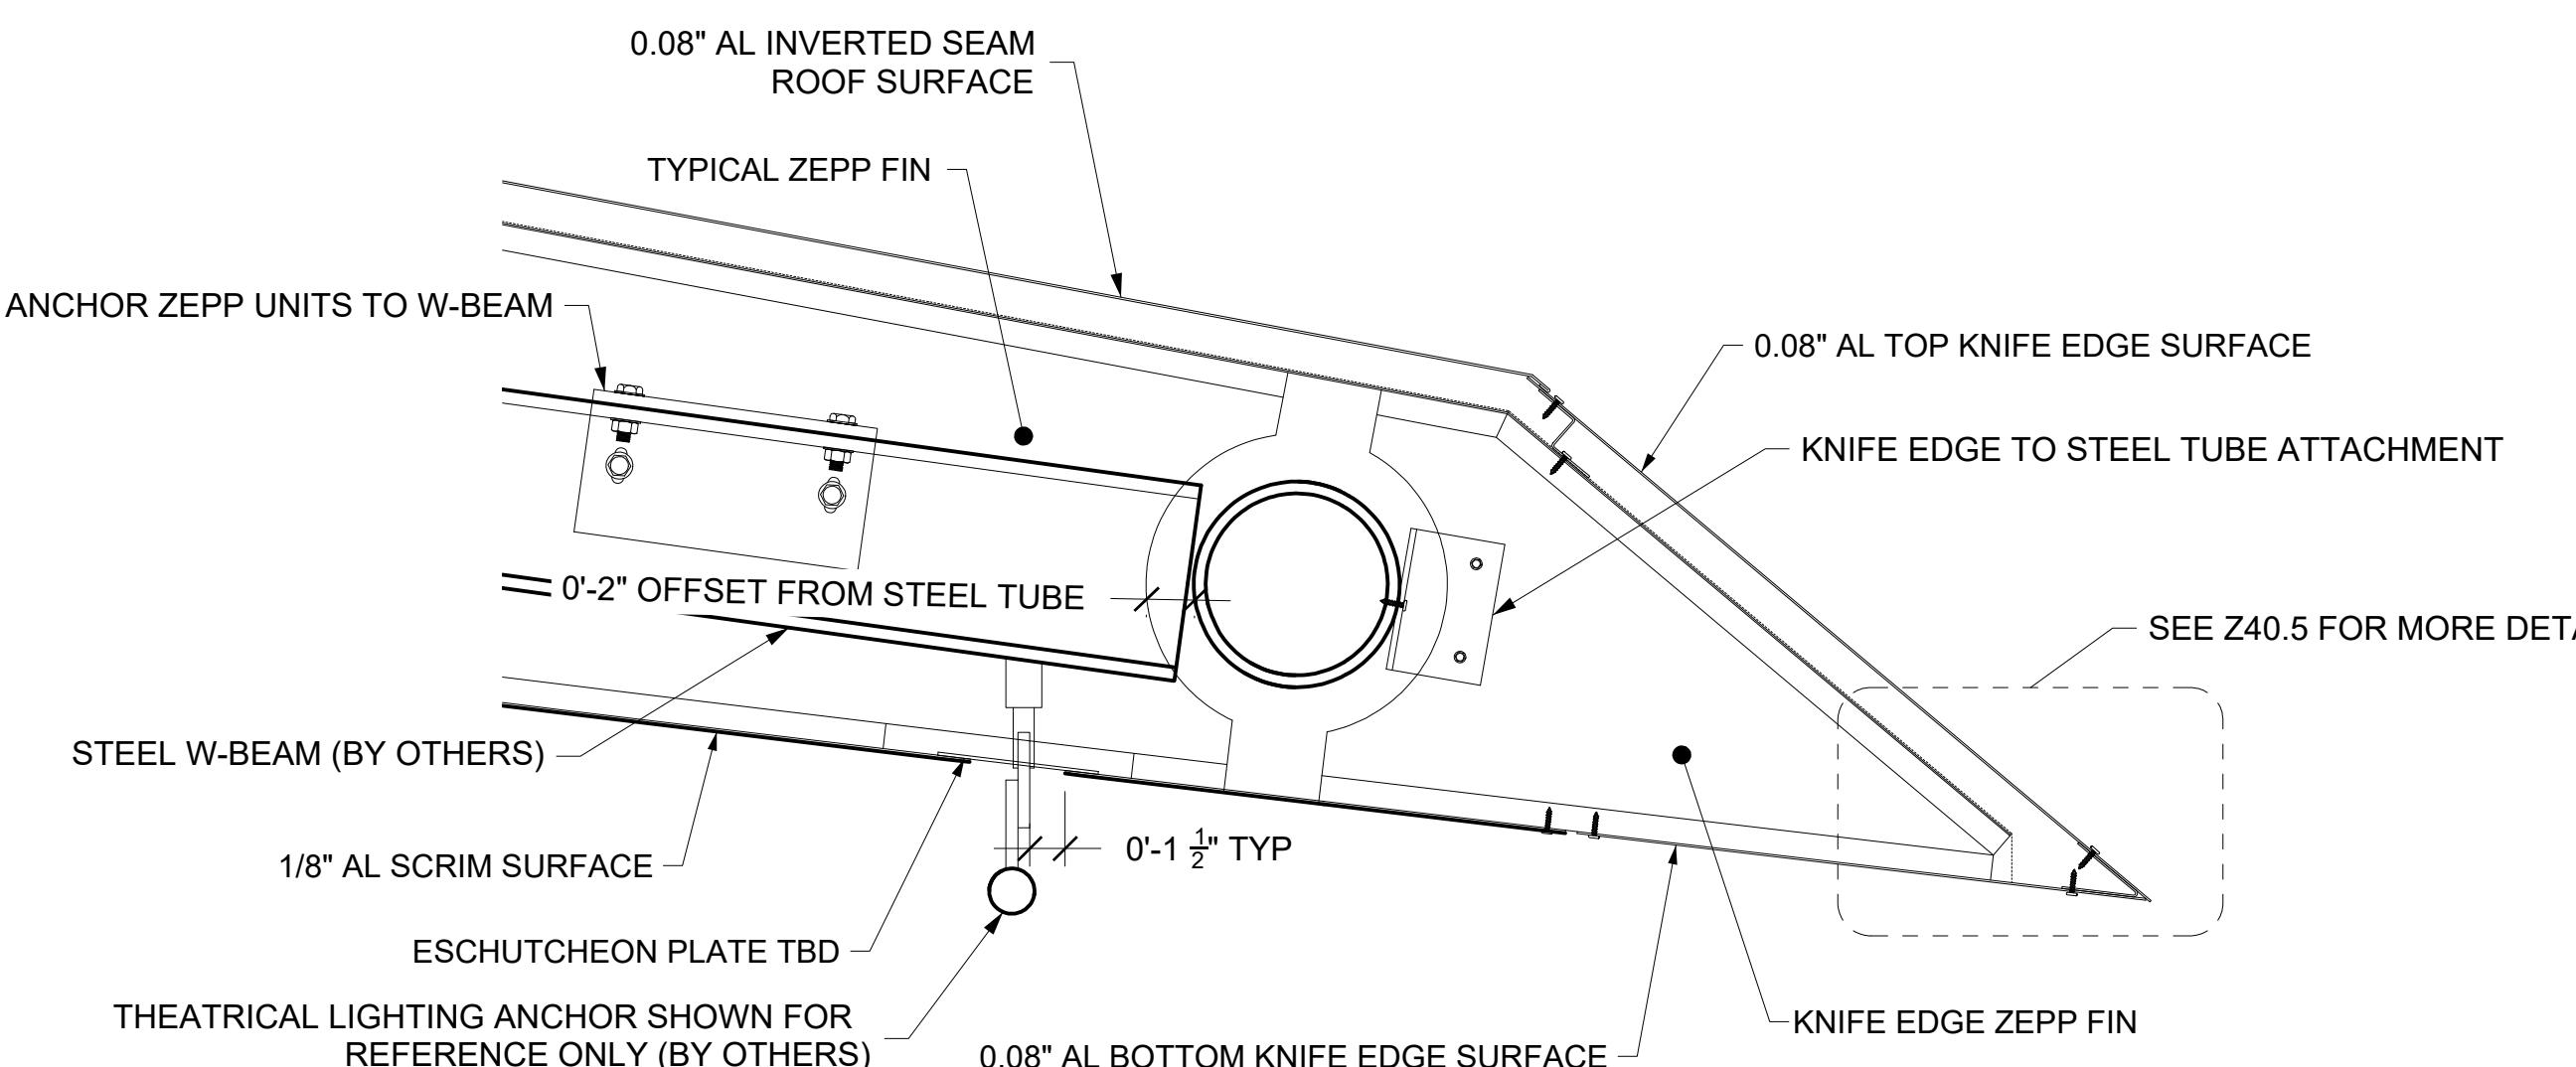

4 SECTION DETAIL @ UPSTAGE CANOPY

SCALE: 1 1/2" = 1'-0"
 ZAHNER REF: N/A
 ARCH REF: N/A

SET ISSUE DATES		
DATE	ISSUE	
01/20/22 100% DRAWINGS		


REVISIONS		
NO.	DATE	DESCRIPTION

Contact Arizona 811 at least two full working days before you begin excavation		
ARIZONA811		
Call 811 or click Arizona811.com		


DATE: 01/20/2022	REVISION:	BY:
ENGINEER		
		PUBLIC WORKS
		CAPITAL PROJECT MANAGEMENT
		7447 E. INDIAN SCHOOL RD., SCOTTSDALE, ARIZONA 85251
SHEET TITLE		

EAST BOWL - SECTION & DETAILS


PROJECT TITLE		CITY OF SCOTTSDALE CIVIC CENTER PLAZA		
SCALE	DESIGNED		BID NO.	XC-A501
DRAWN DS	AS-BUILT		COS PROJECT NO.	DG04
THIS SHEET SCALED FOR 24X36" BORDER				

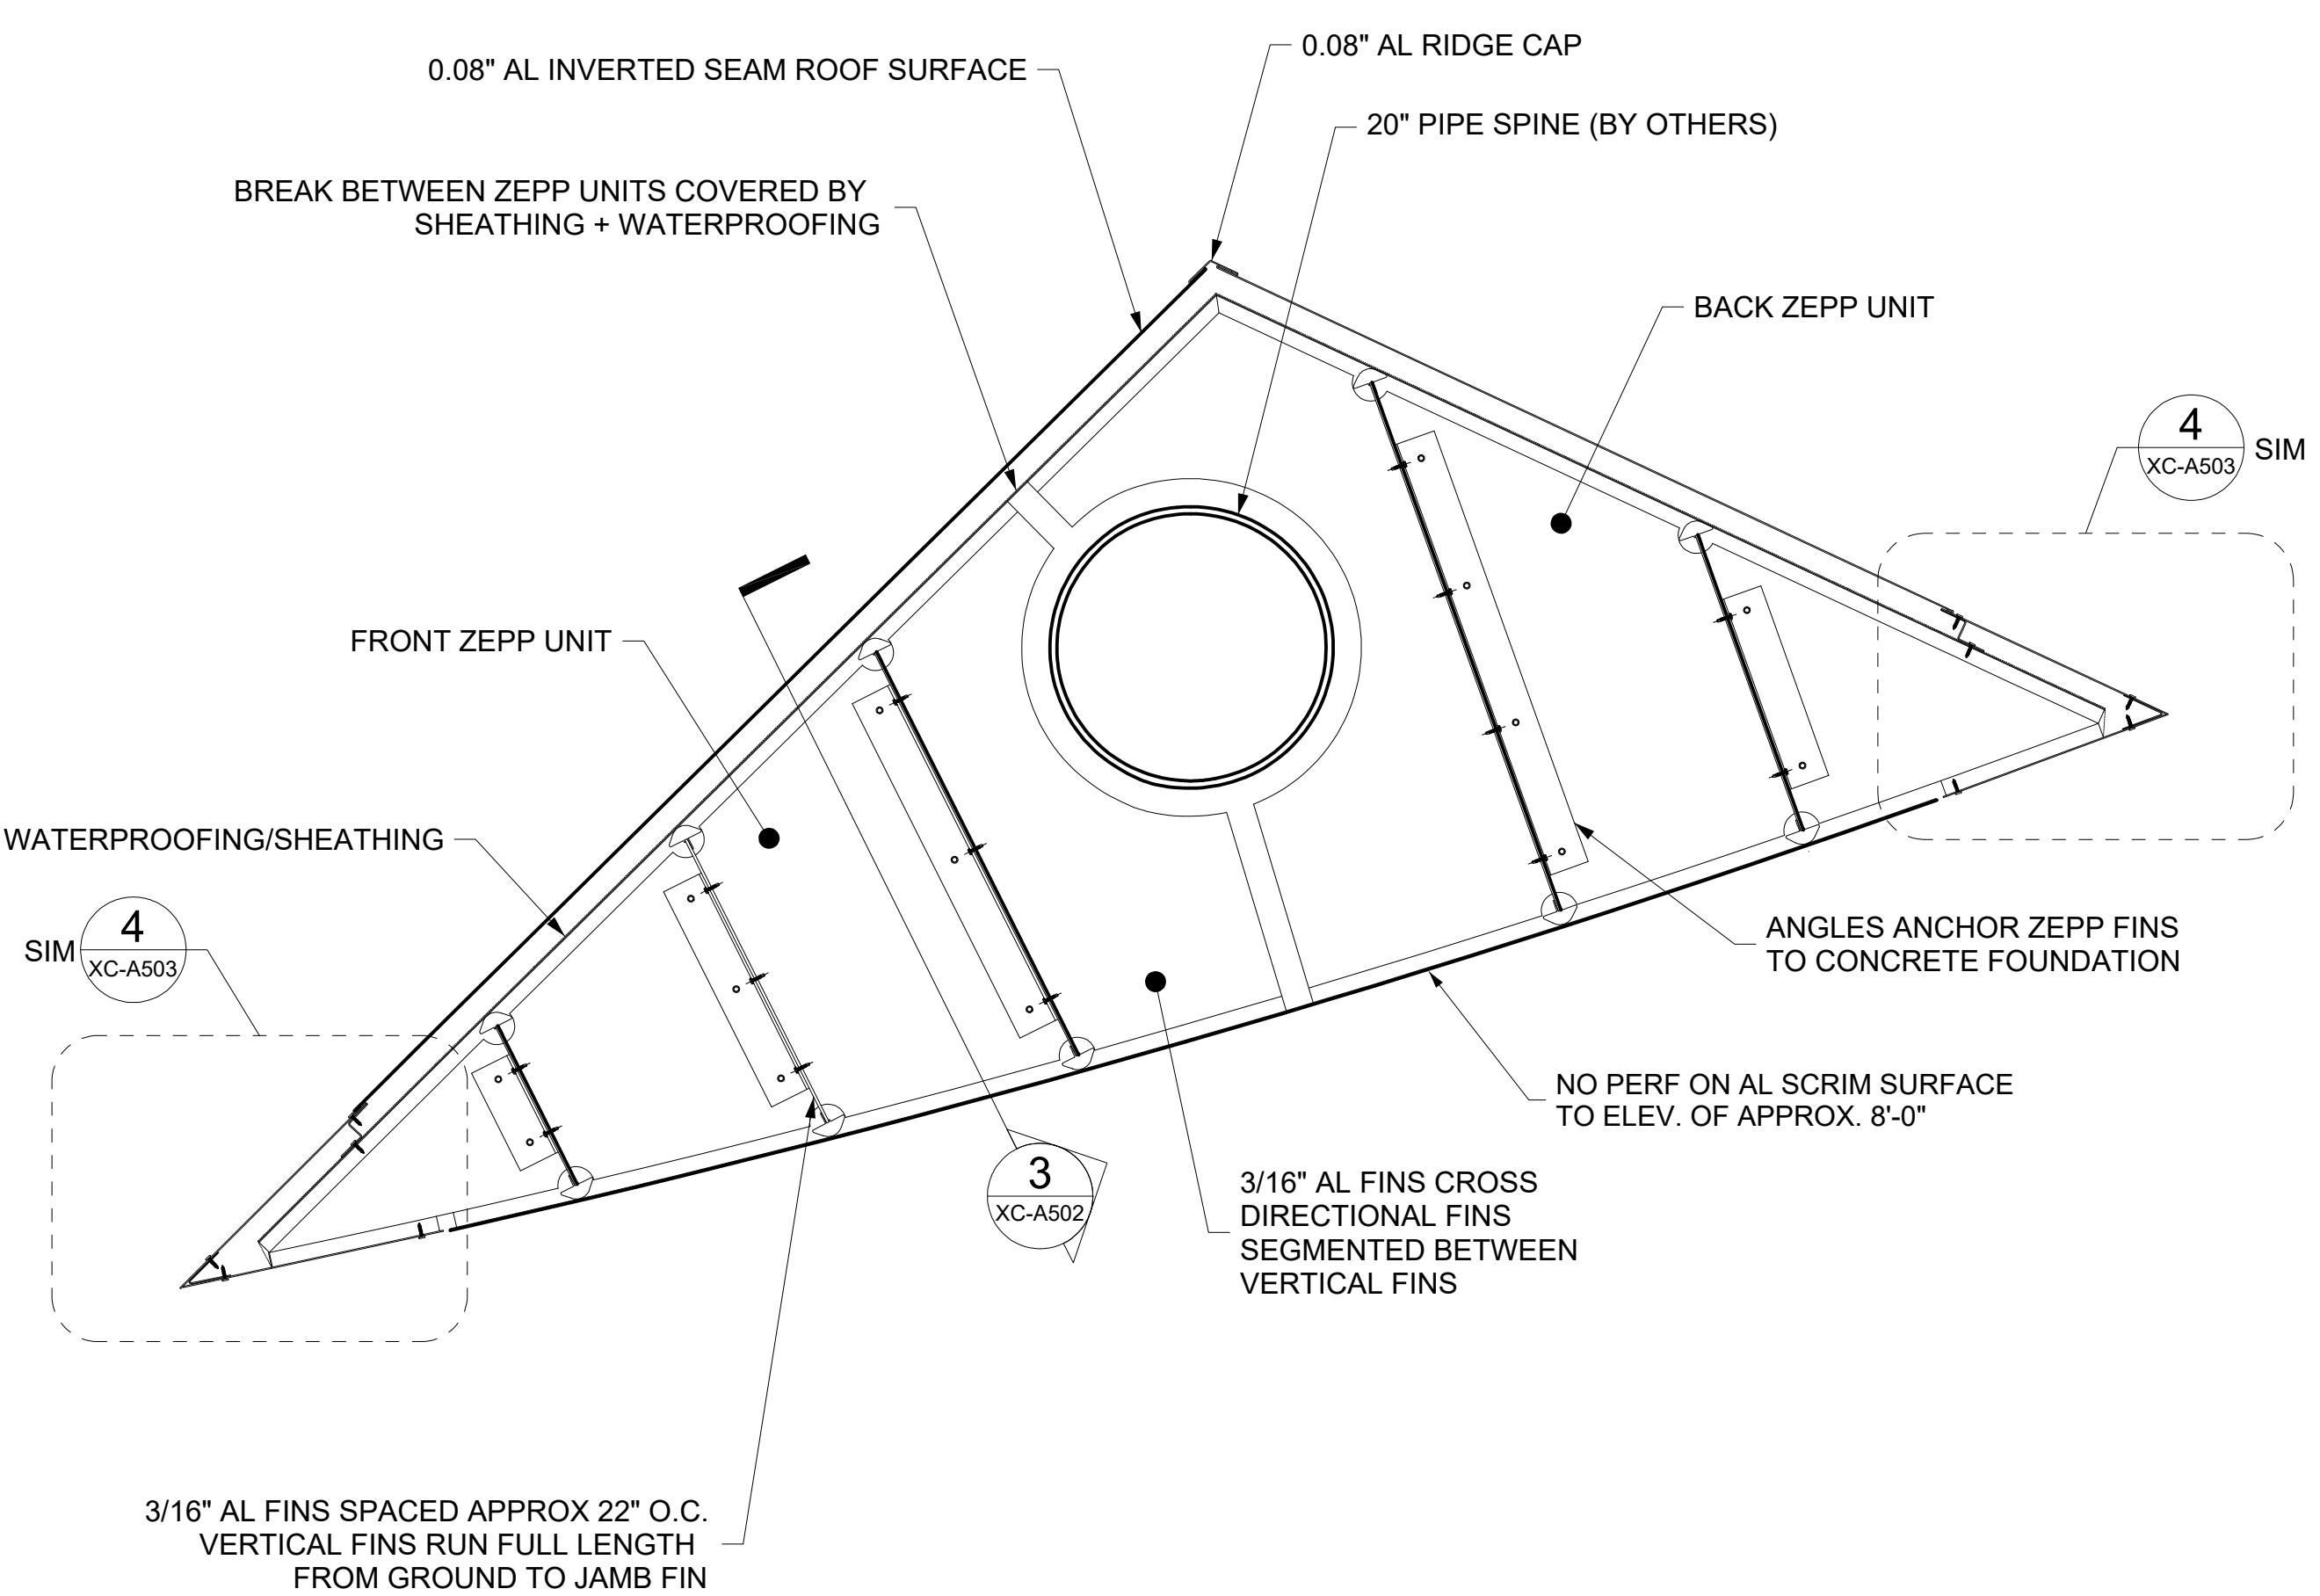

1 PLAN DETAIL @ NORTH WING WALL
SCALE: 1" = 1'-0"
ZAHNER REF: N/A
ARCH REF: N/A

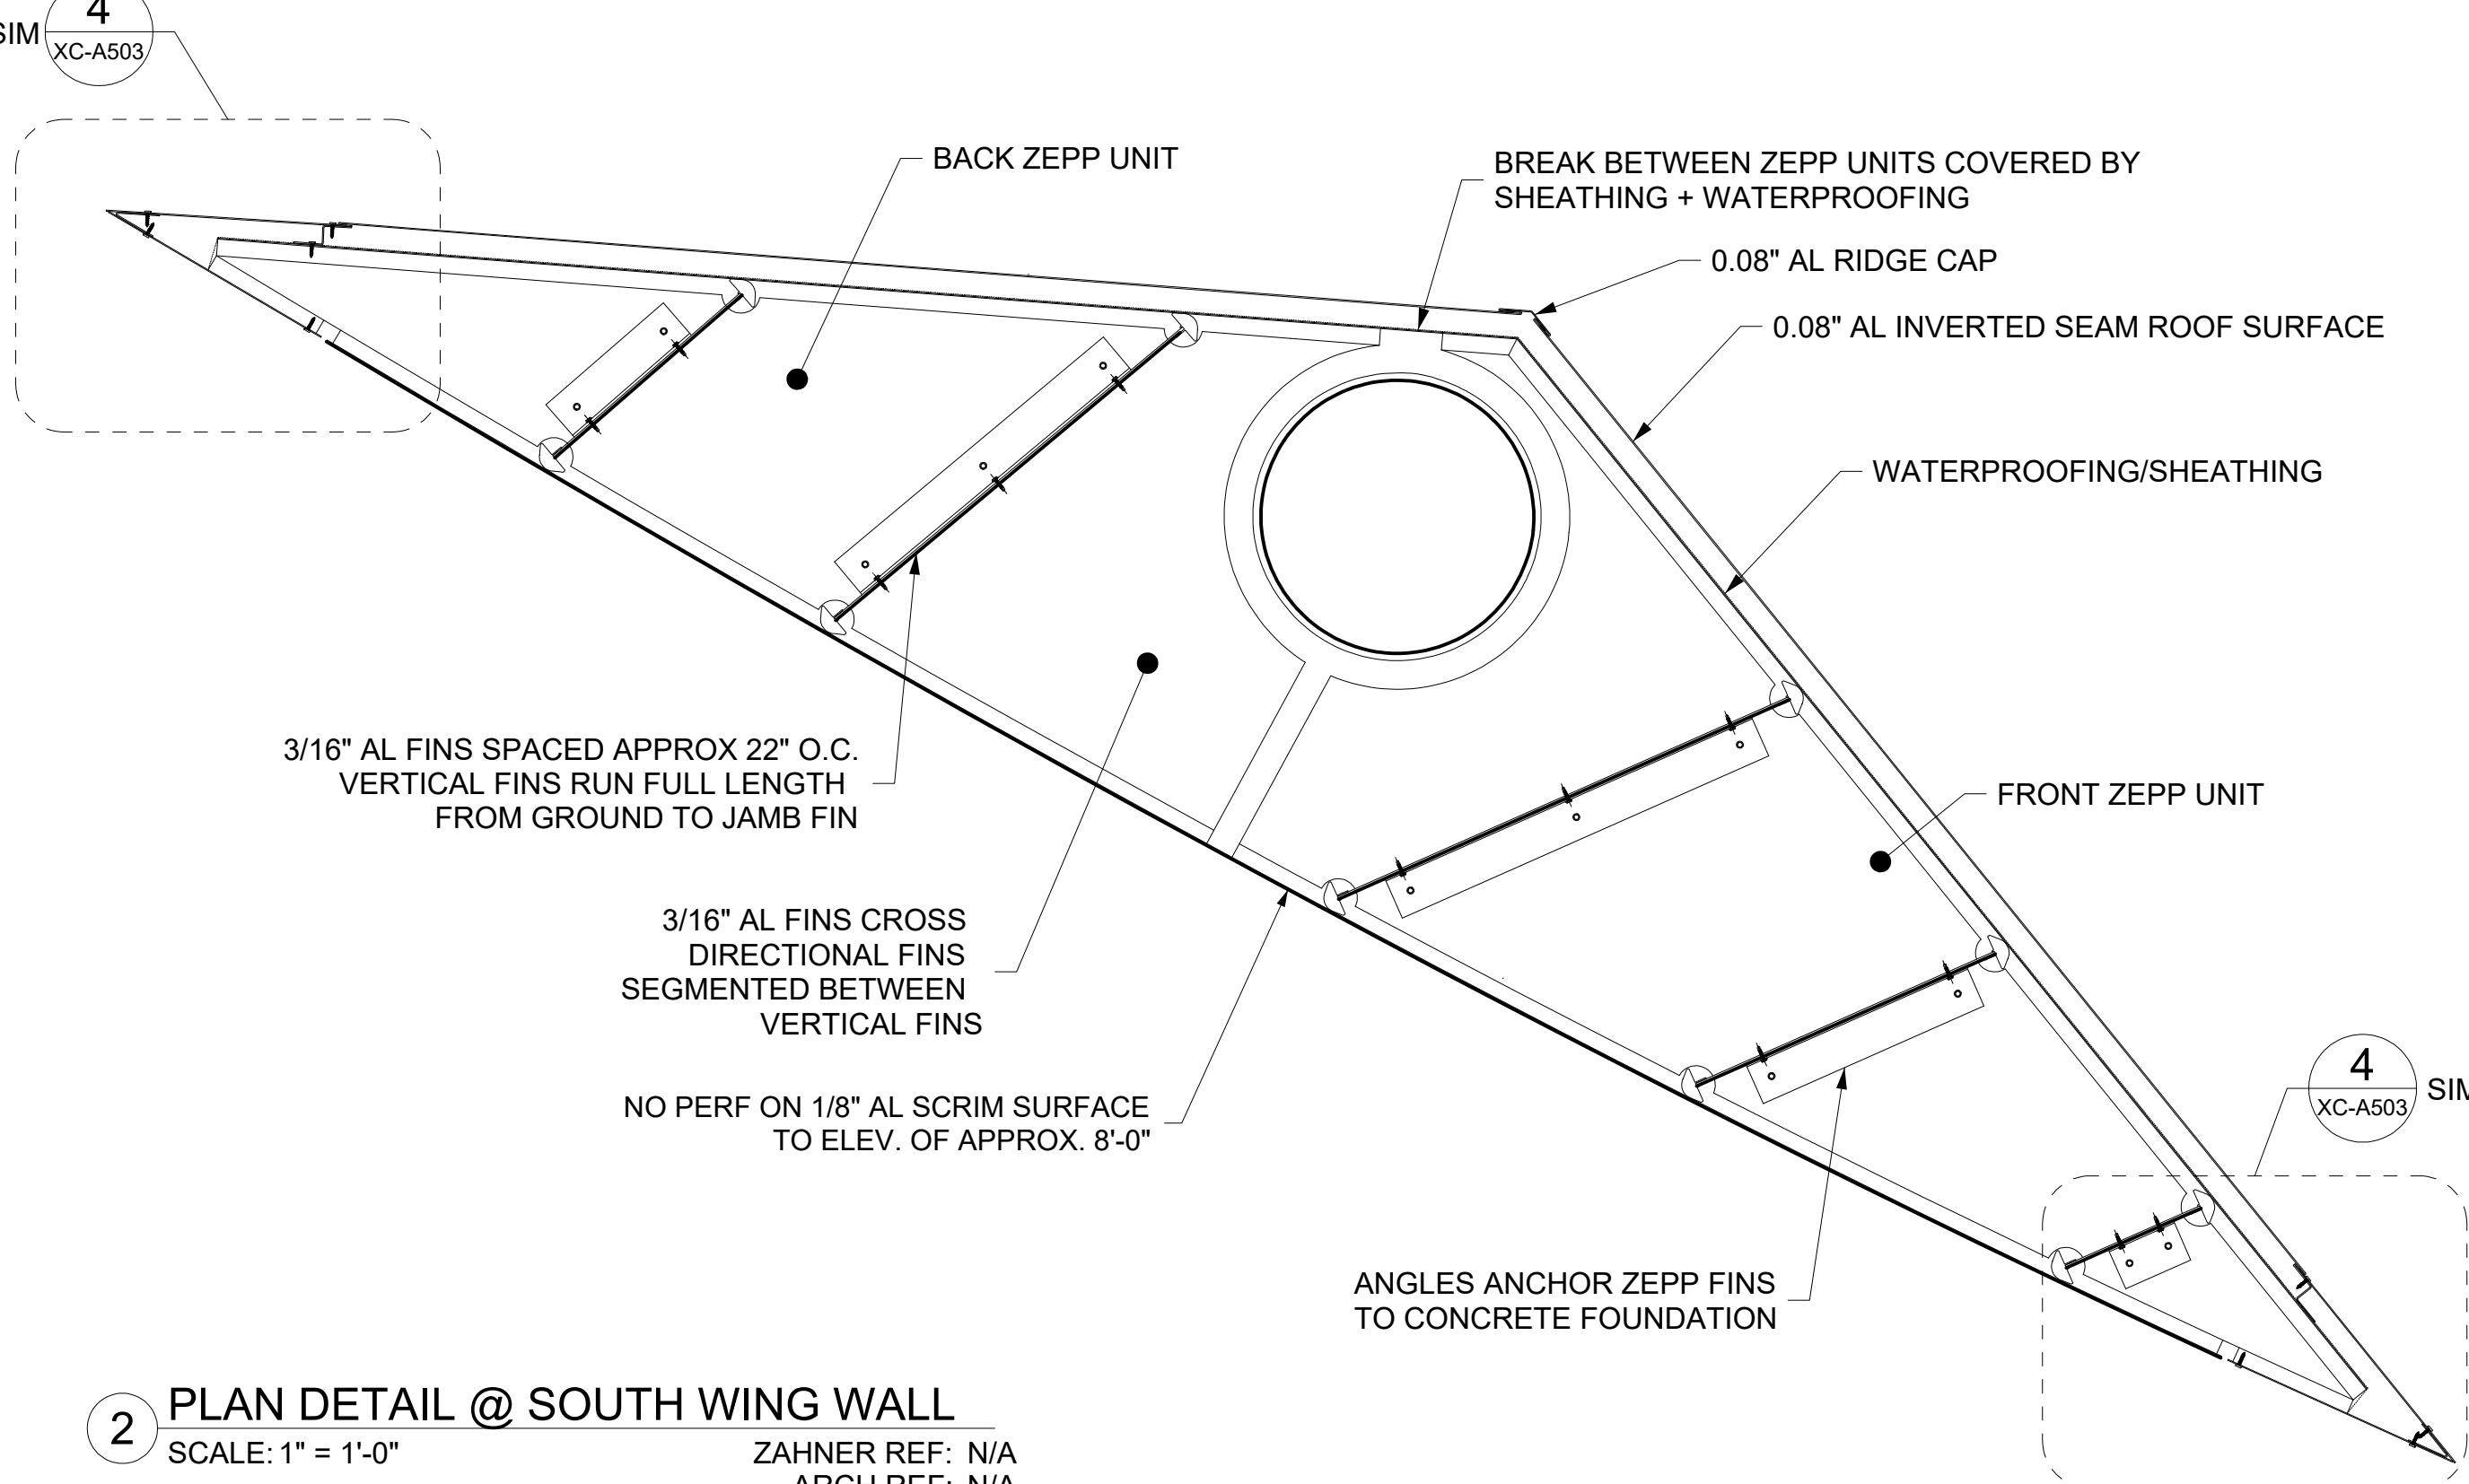


2 PLAN DETAIL @ SOUTH WING WALL
SCALE: 1" = 1'-0"
ZAHNER REF: N/A
ARCH REF: N/A

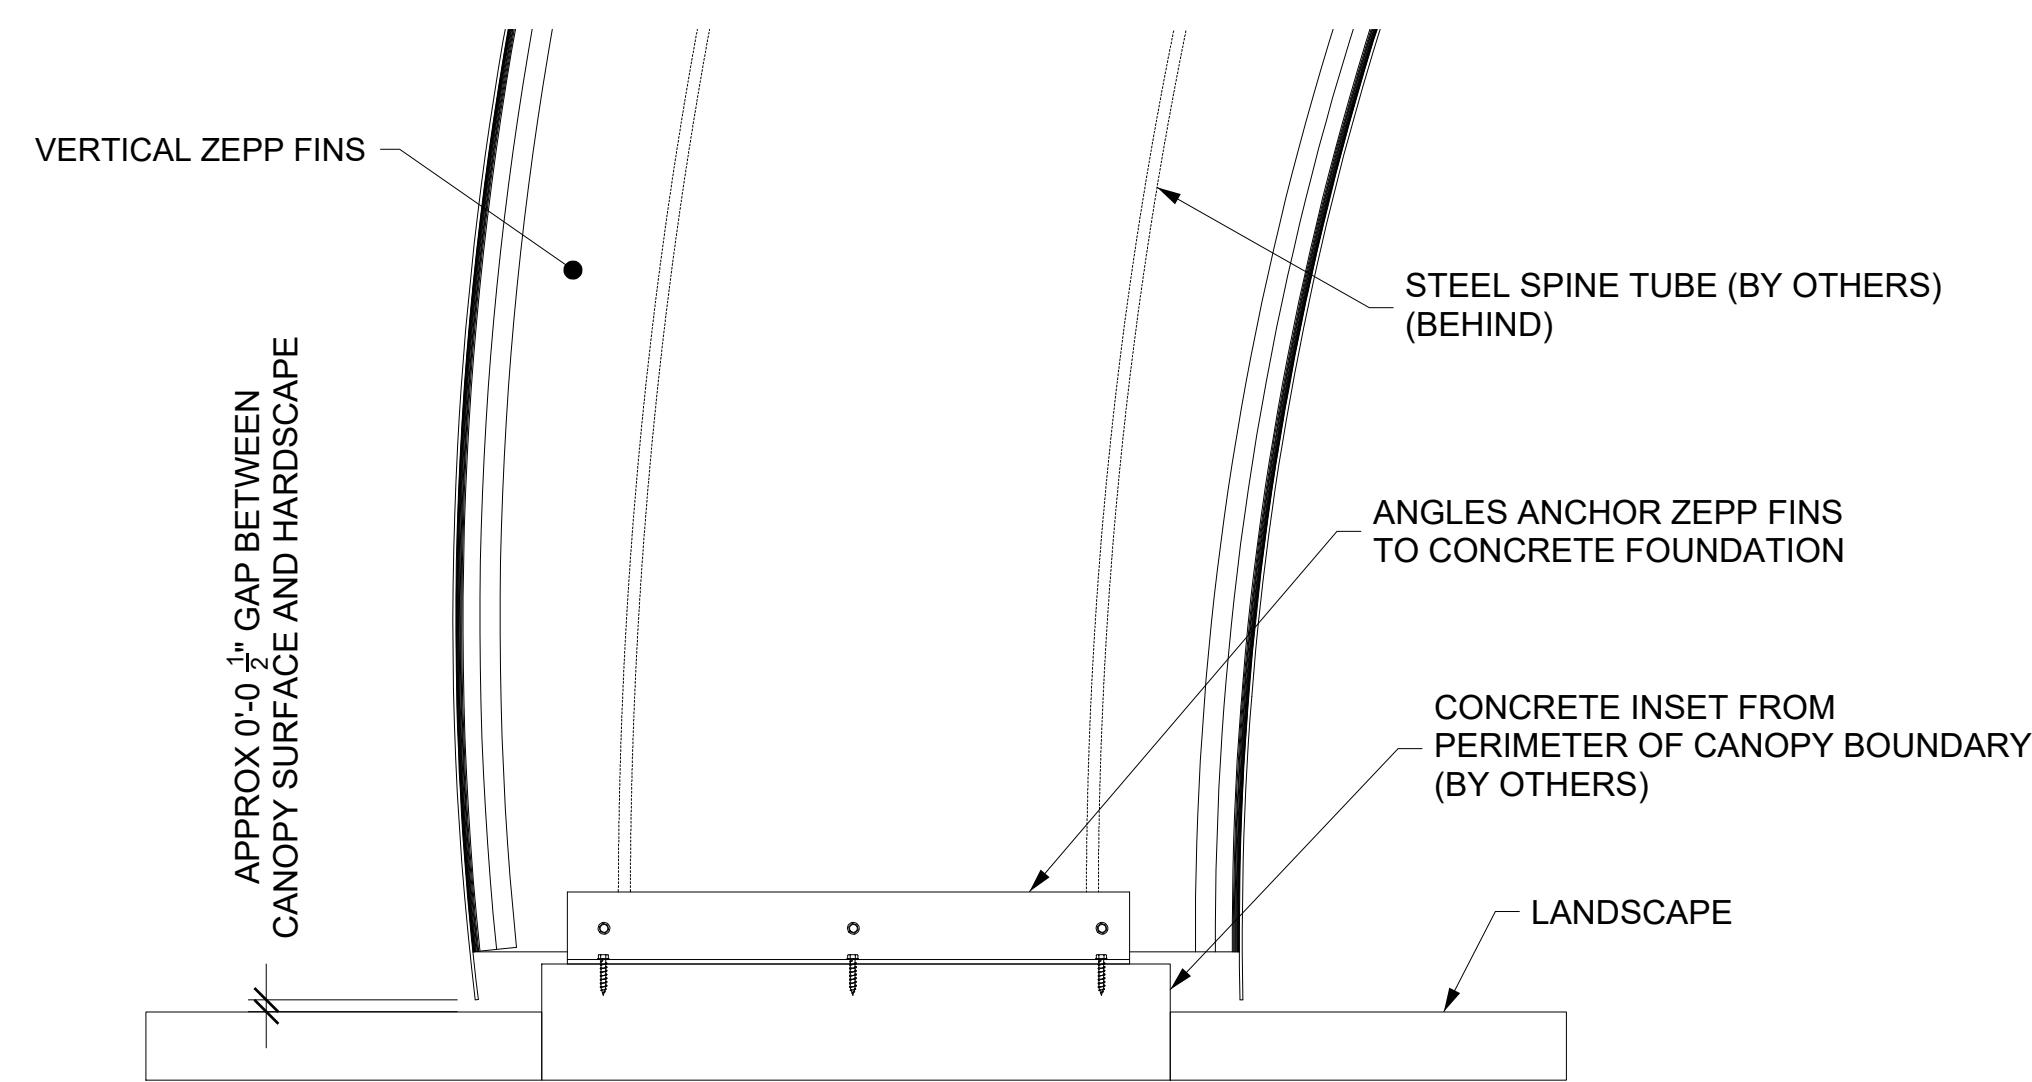

3 SECTION DETAIL @ NORTH WING WALL
SCALE: 1 1/2" = 1'-0"
ZAHNER REF: N/A
ARCH REF: N/A

SET ISSUE DATES		
DATE	ISSUE	
01/20/22 100% DRAWINGS		
REVISIONS		
NO.	DATE	DESCRIPTION

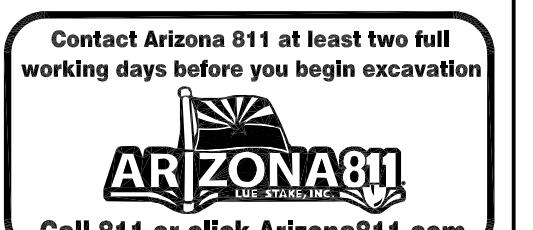


DATE: 01/20/2022	REVISION:	BY:
ENGINEER		PUBLIC WORKS
		CAPITAL PROJECT MANAGEMENT
7447 E. INDIAN SCHOOL RD., SCOTTSDALE, ARIZONA 85251		


EAST BOWL - WING WALL PLAN DETAILS

PROJECT TITLE: CITY OF SCOTTSDALE CIVIC CENTER PLAZA


THIS SHEET SCALED FOR 24X36" BORDER	SCALE	DESIGNED	BID NO.	XC-A502
	DRAWN DS	AS-BUILT	COS PROJECT NO. DG04	

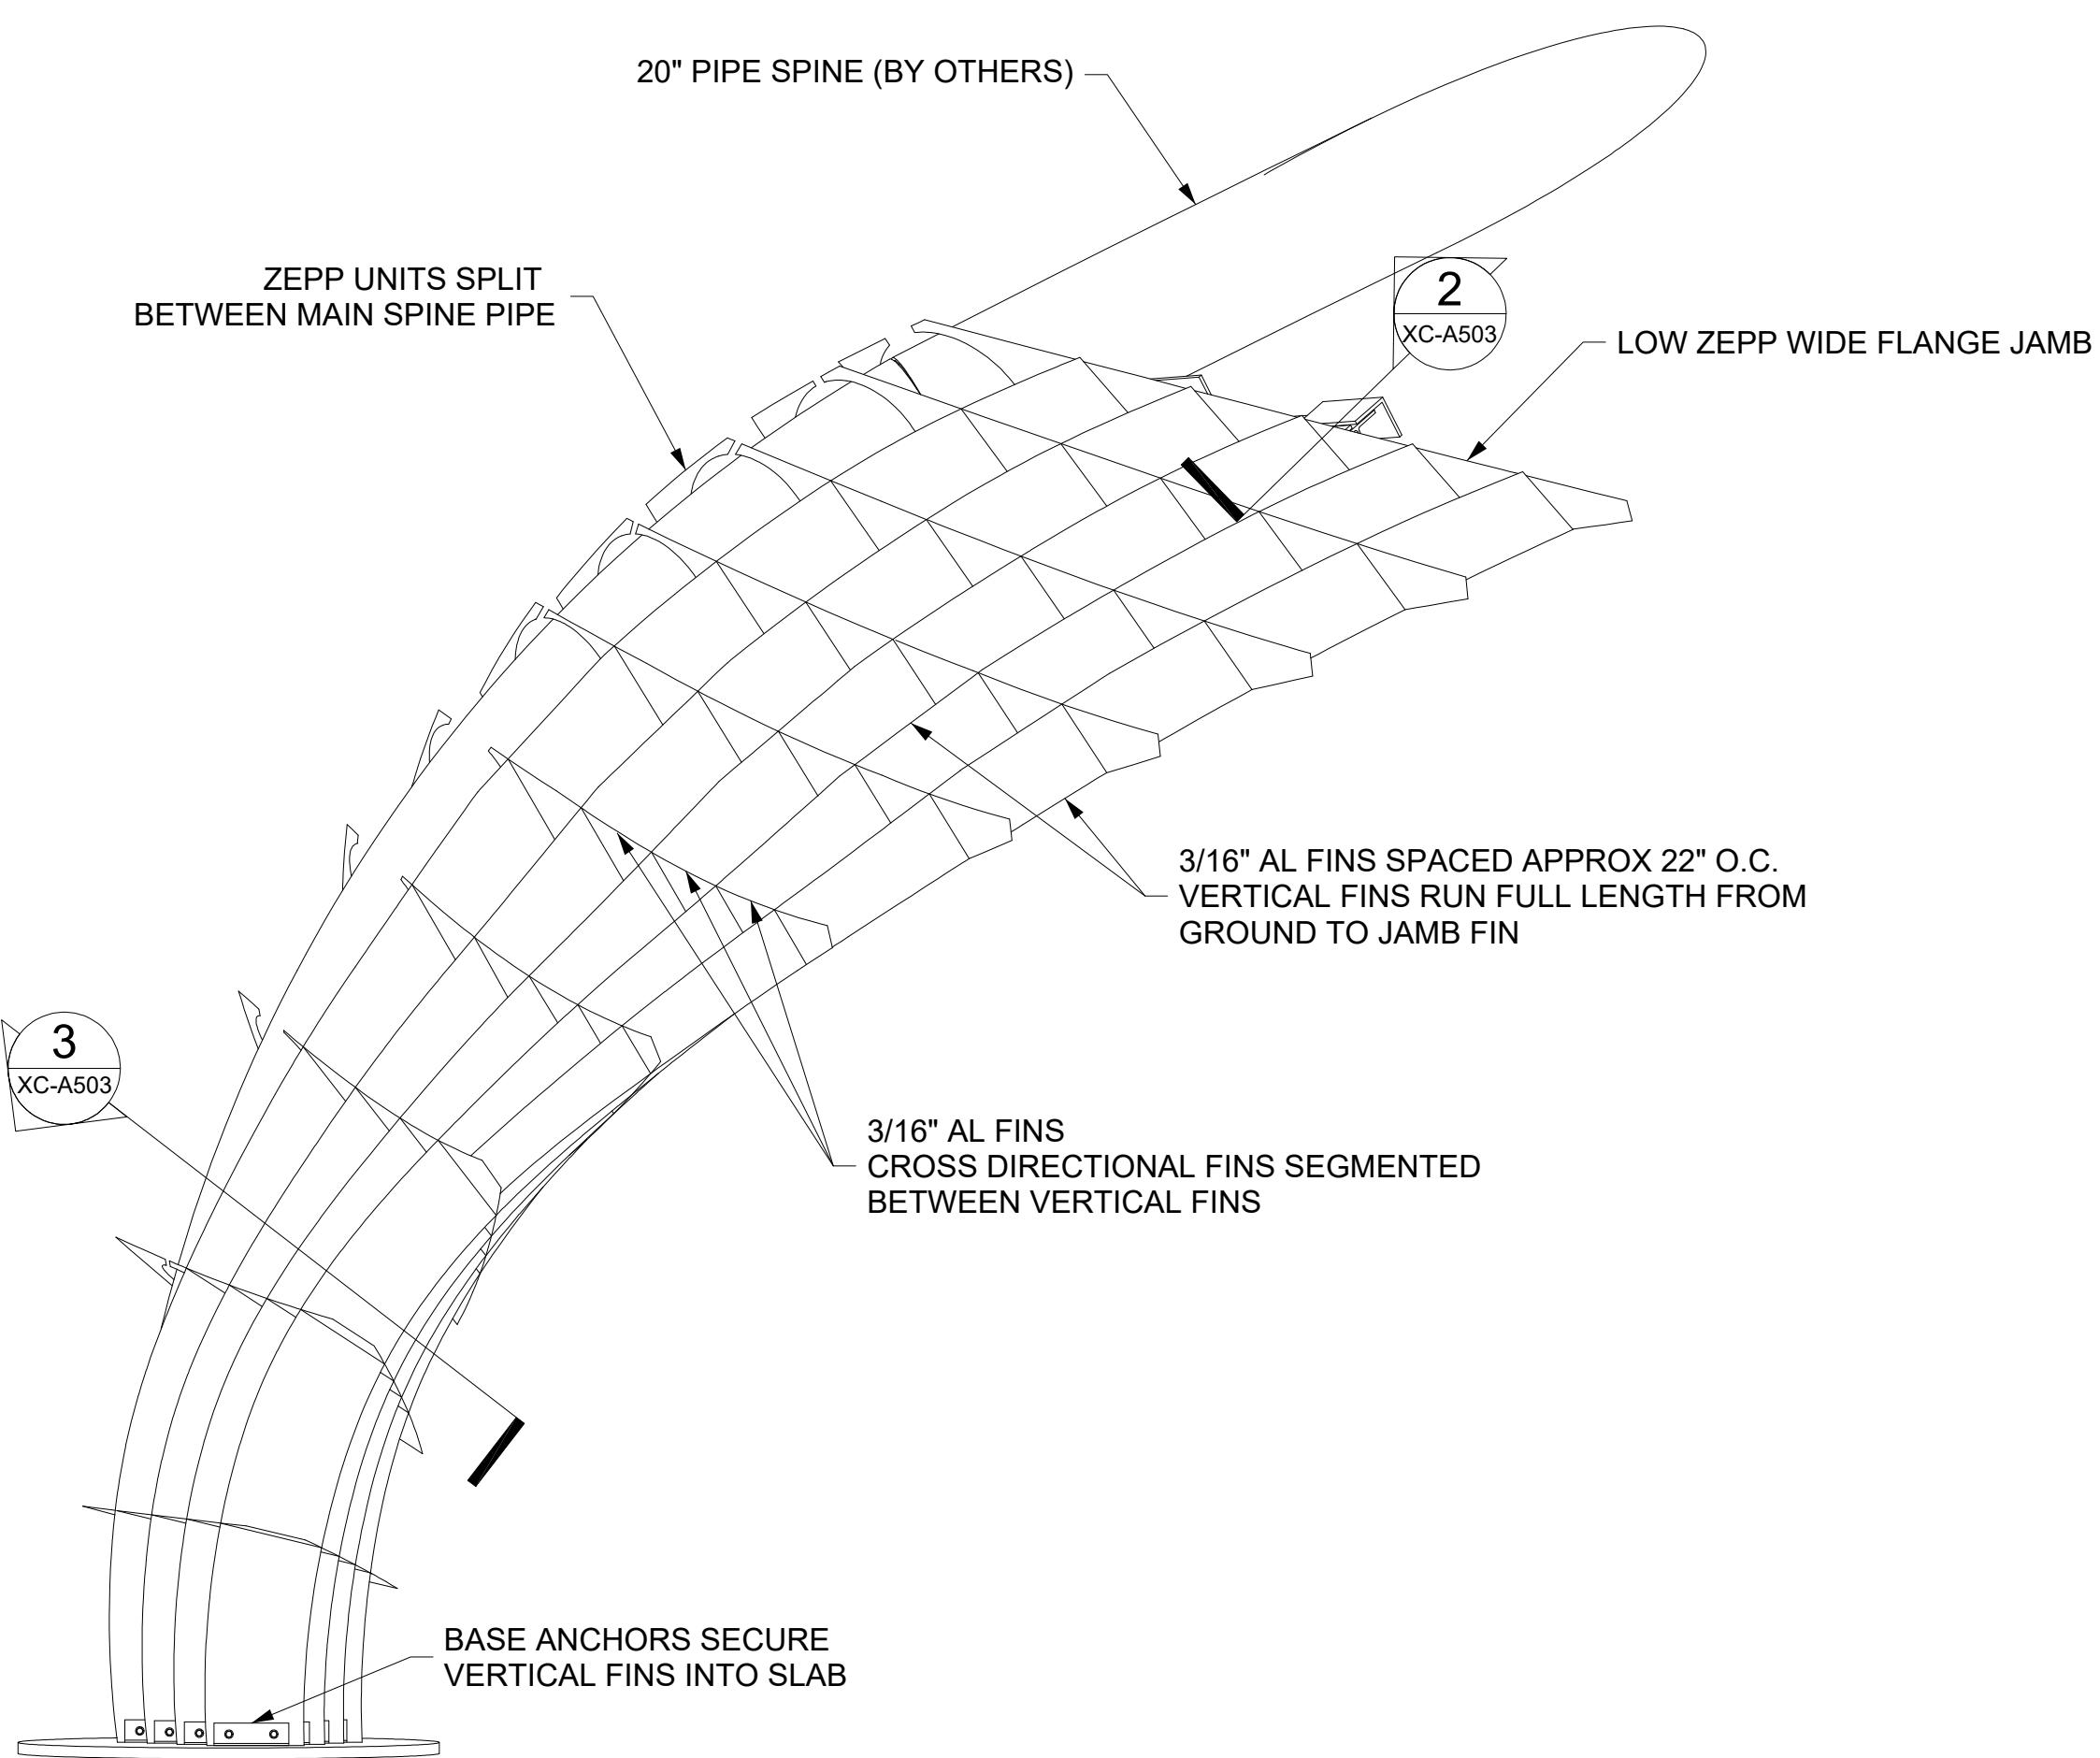


① WING WALL ZEPP SUB STRUCTURE
 SCALE: 1/2" = 1'-0"
 ZAHNER REF: N/A
 ARCH REF: N/A

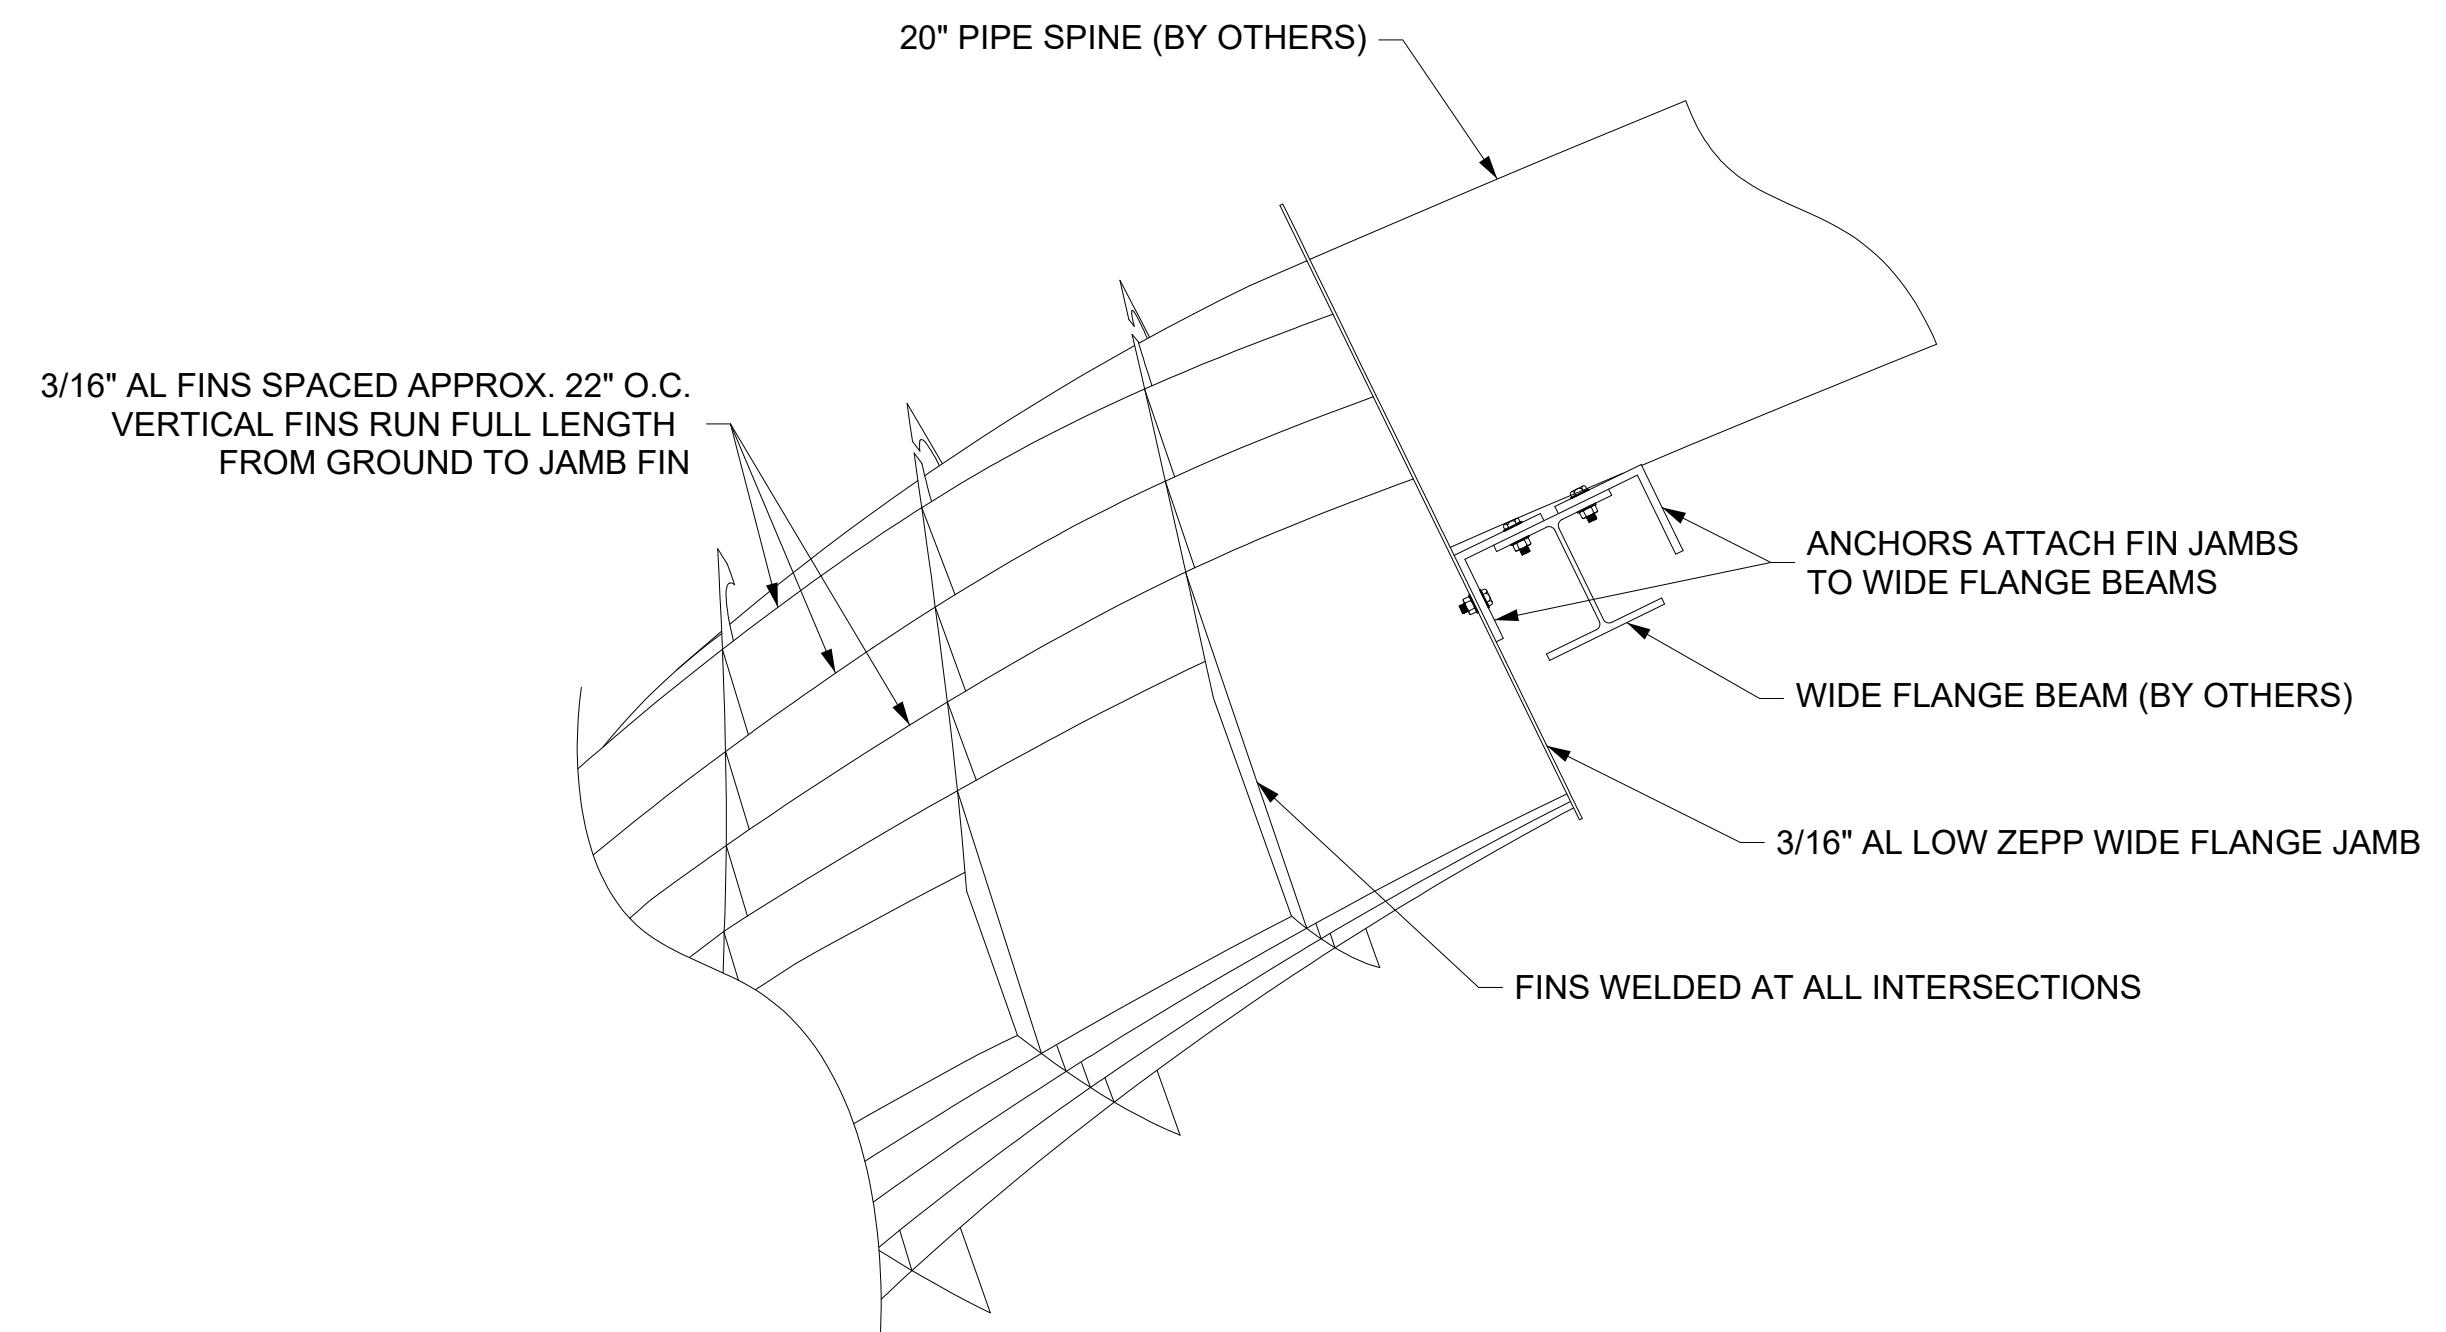

② WING WALL ZEPP UNIT ATTACHMENT TO STEEL
 SCALE: 1" = 1'-0"
 ZAHNER REF: N/A
 ARCH REF: N/A

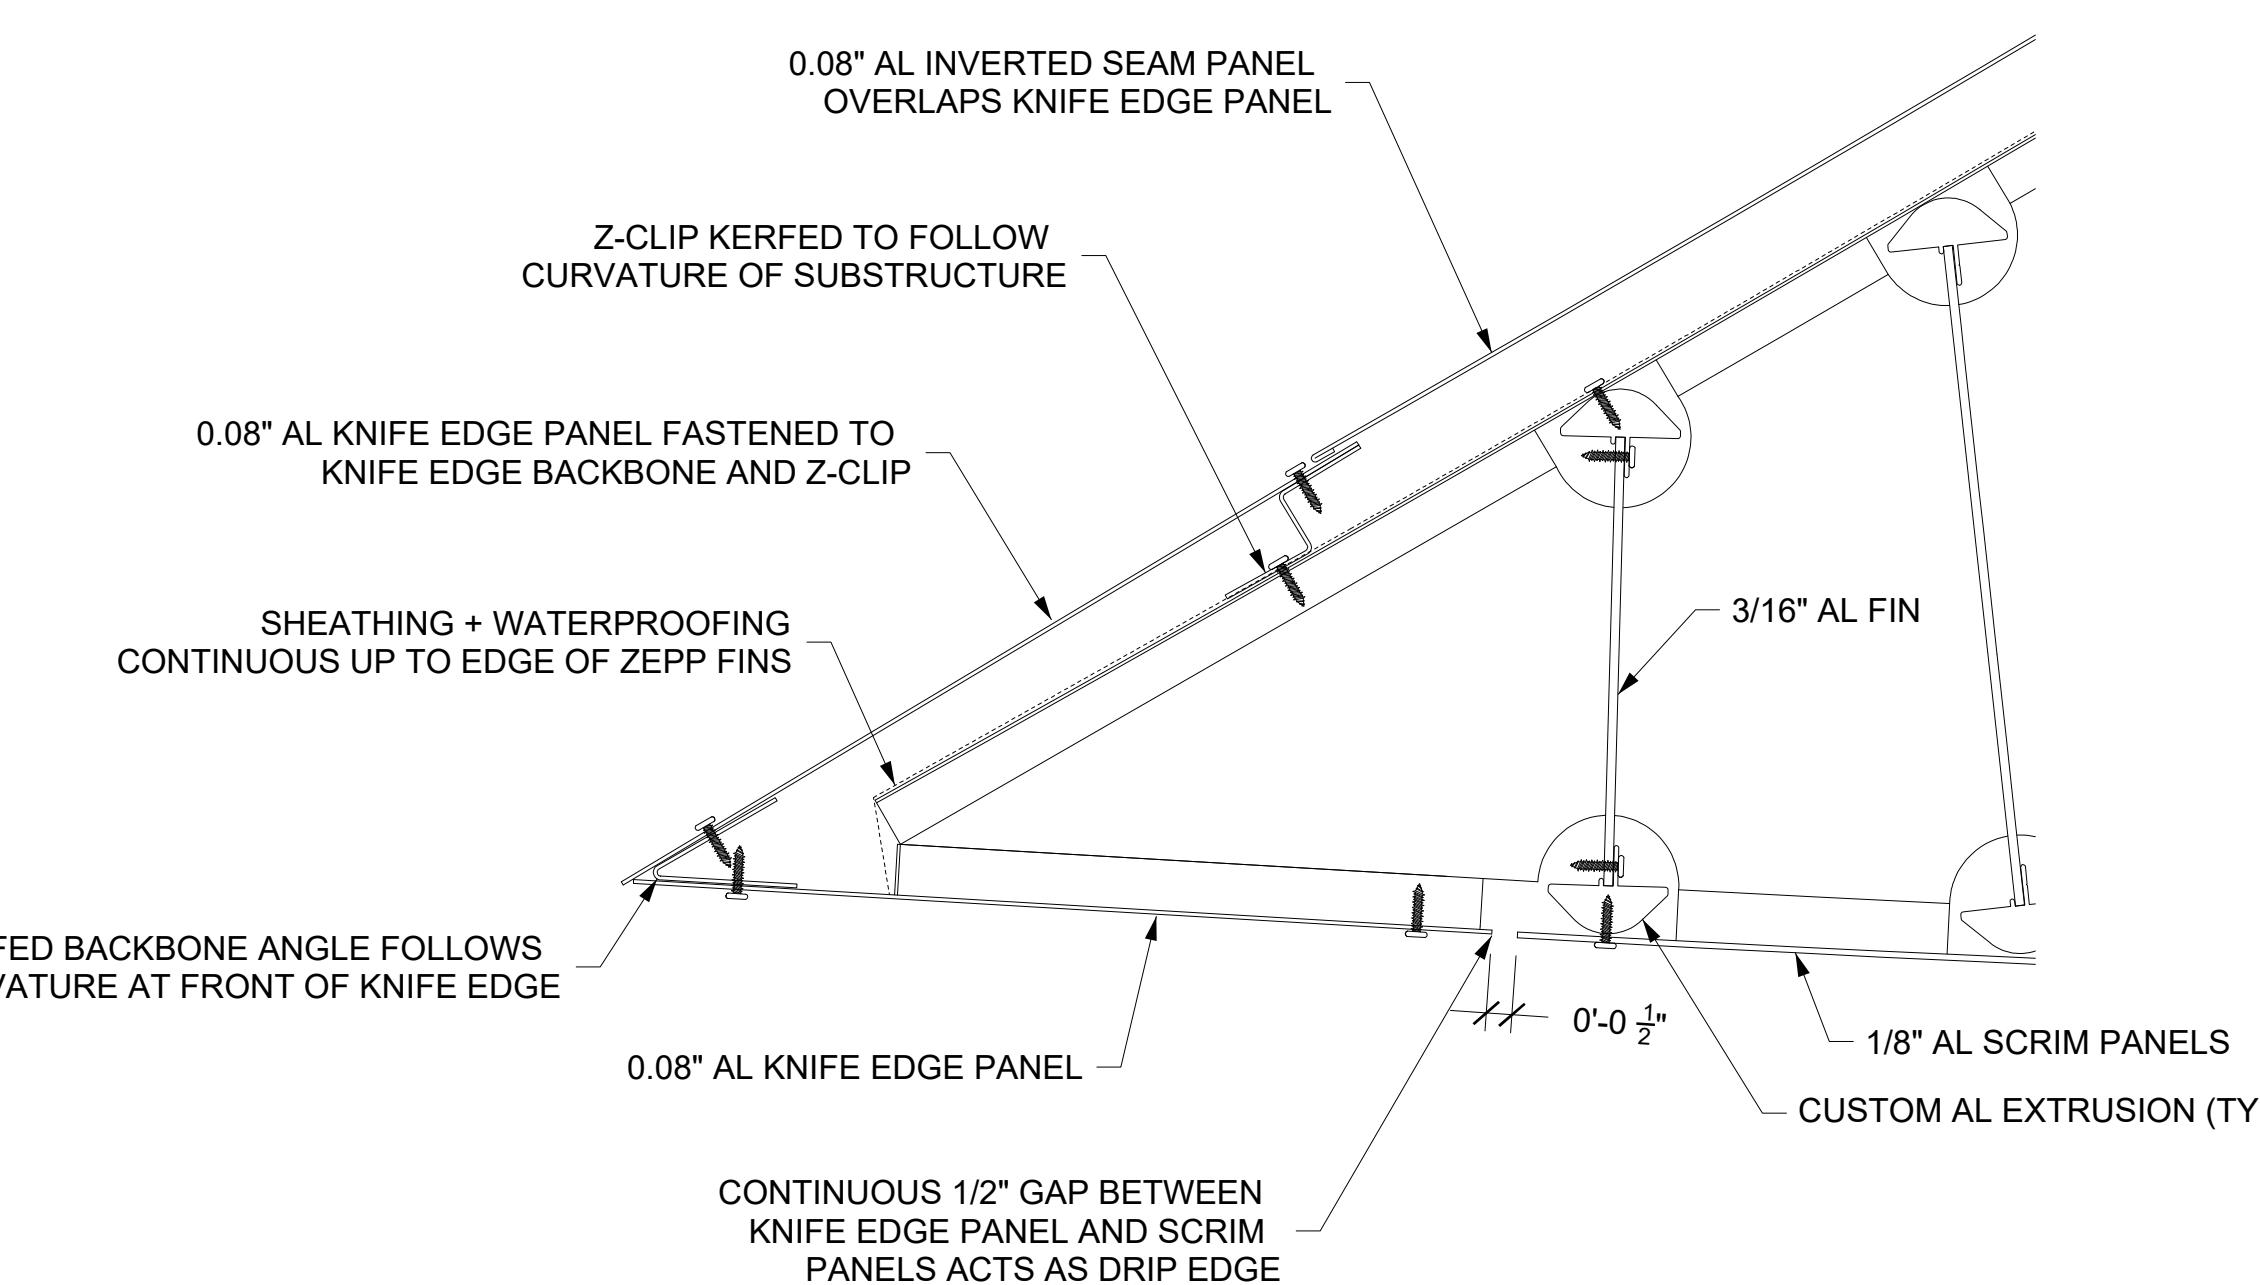


④ KNIFE EDGE DETAILS
 SCALE: 3" = 1'-0"
 ZAHNER REF: N/A
 ARCH REF: N/A

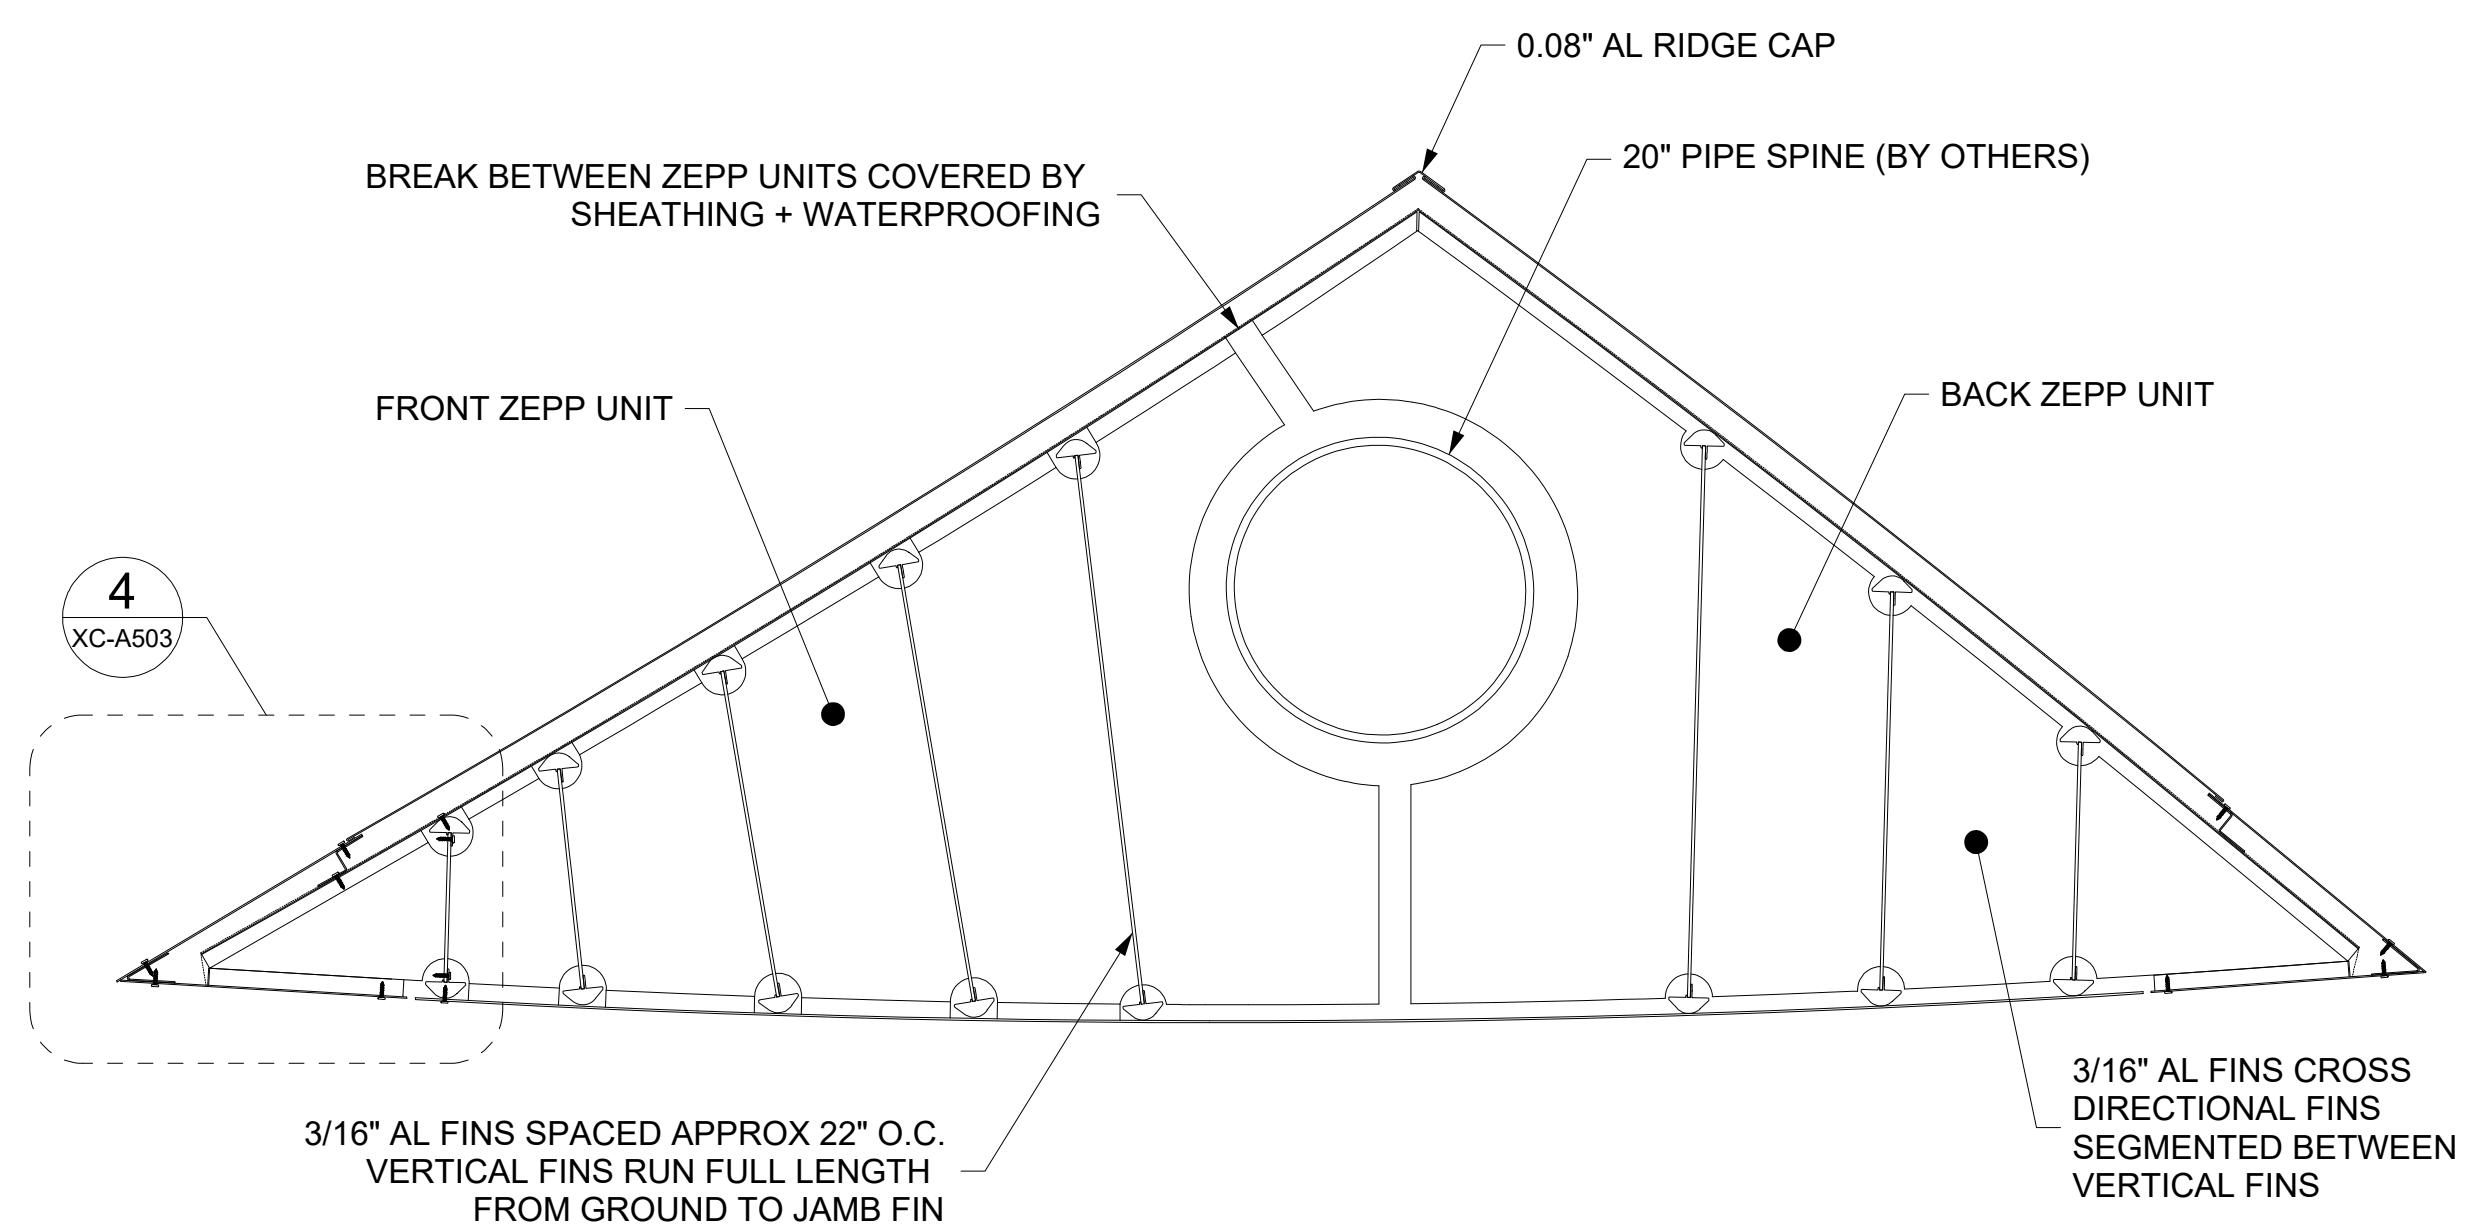

SECTION B-B
 WING WALL ZEPP TYPICAL CROSS SECTION
 SCALE: ---
 ZAHNER REF: N/A
 ARCH REF: N/A




SET ISSUE DATES		
DATE	ISSUE	
01/20/22 100% DRAWINGS		
REVISIONS		
NO.	DATE	DESCRIPTION

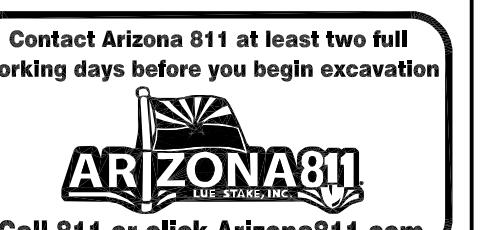


DATE: 01/20/2022	REVISION:	BY:
ENGINEER		
CITY OF SCOTTSDALE		PUBLIC WORKS
CAPITAL PROJECT MANAGEMENT		
7447 E. INDIAN SCHOOL RD. SCOTTSDALE, ARIZONA 85251		

SHEET TITLE
 CITY OF SCOTTSDALE
 CIVIC CENTER PLAZA

THIS SHEET SCALED FOR 24X36" BORDER	SCALE	DESIGNED	BID NO.	XC-A503
	DRAWN DS	AS-BUILT	COS PROJECT NO. DG04	

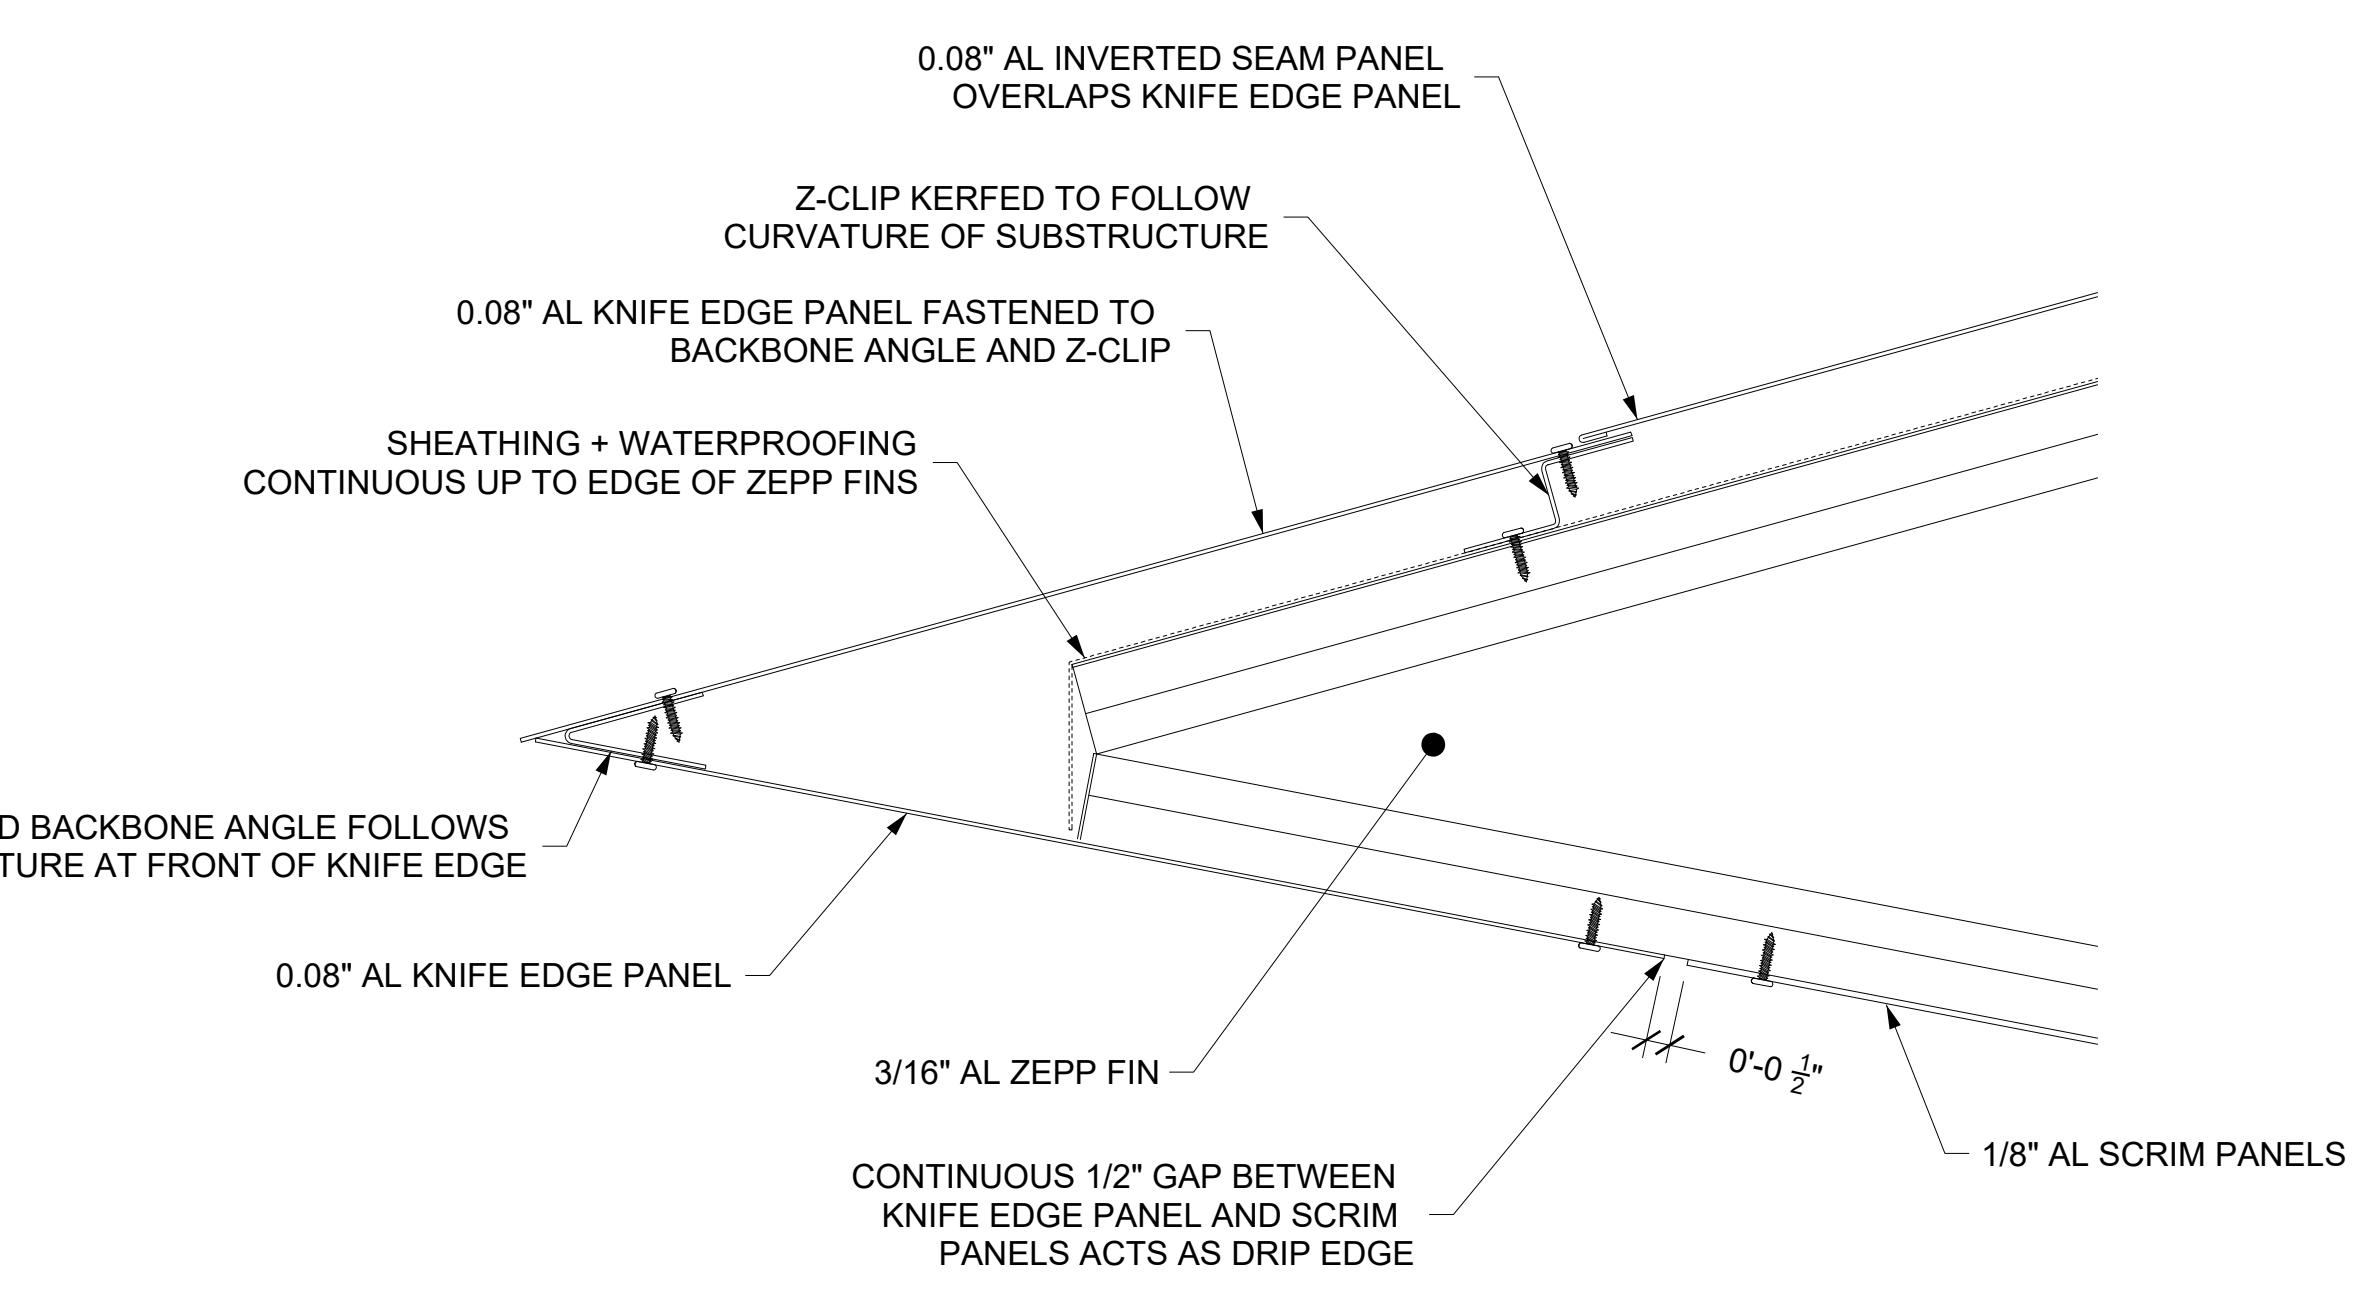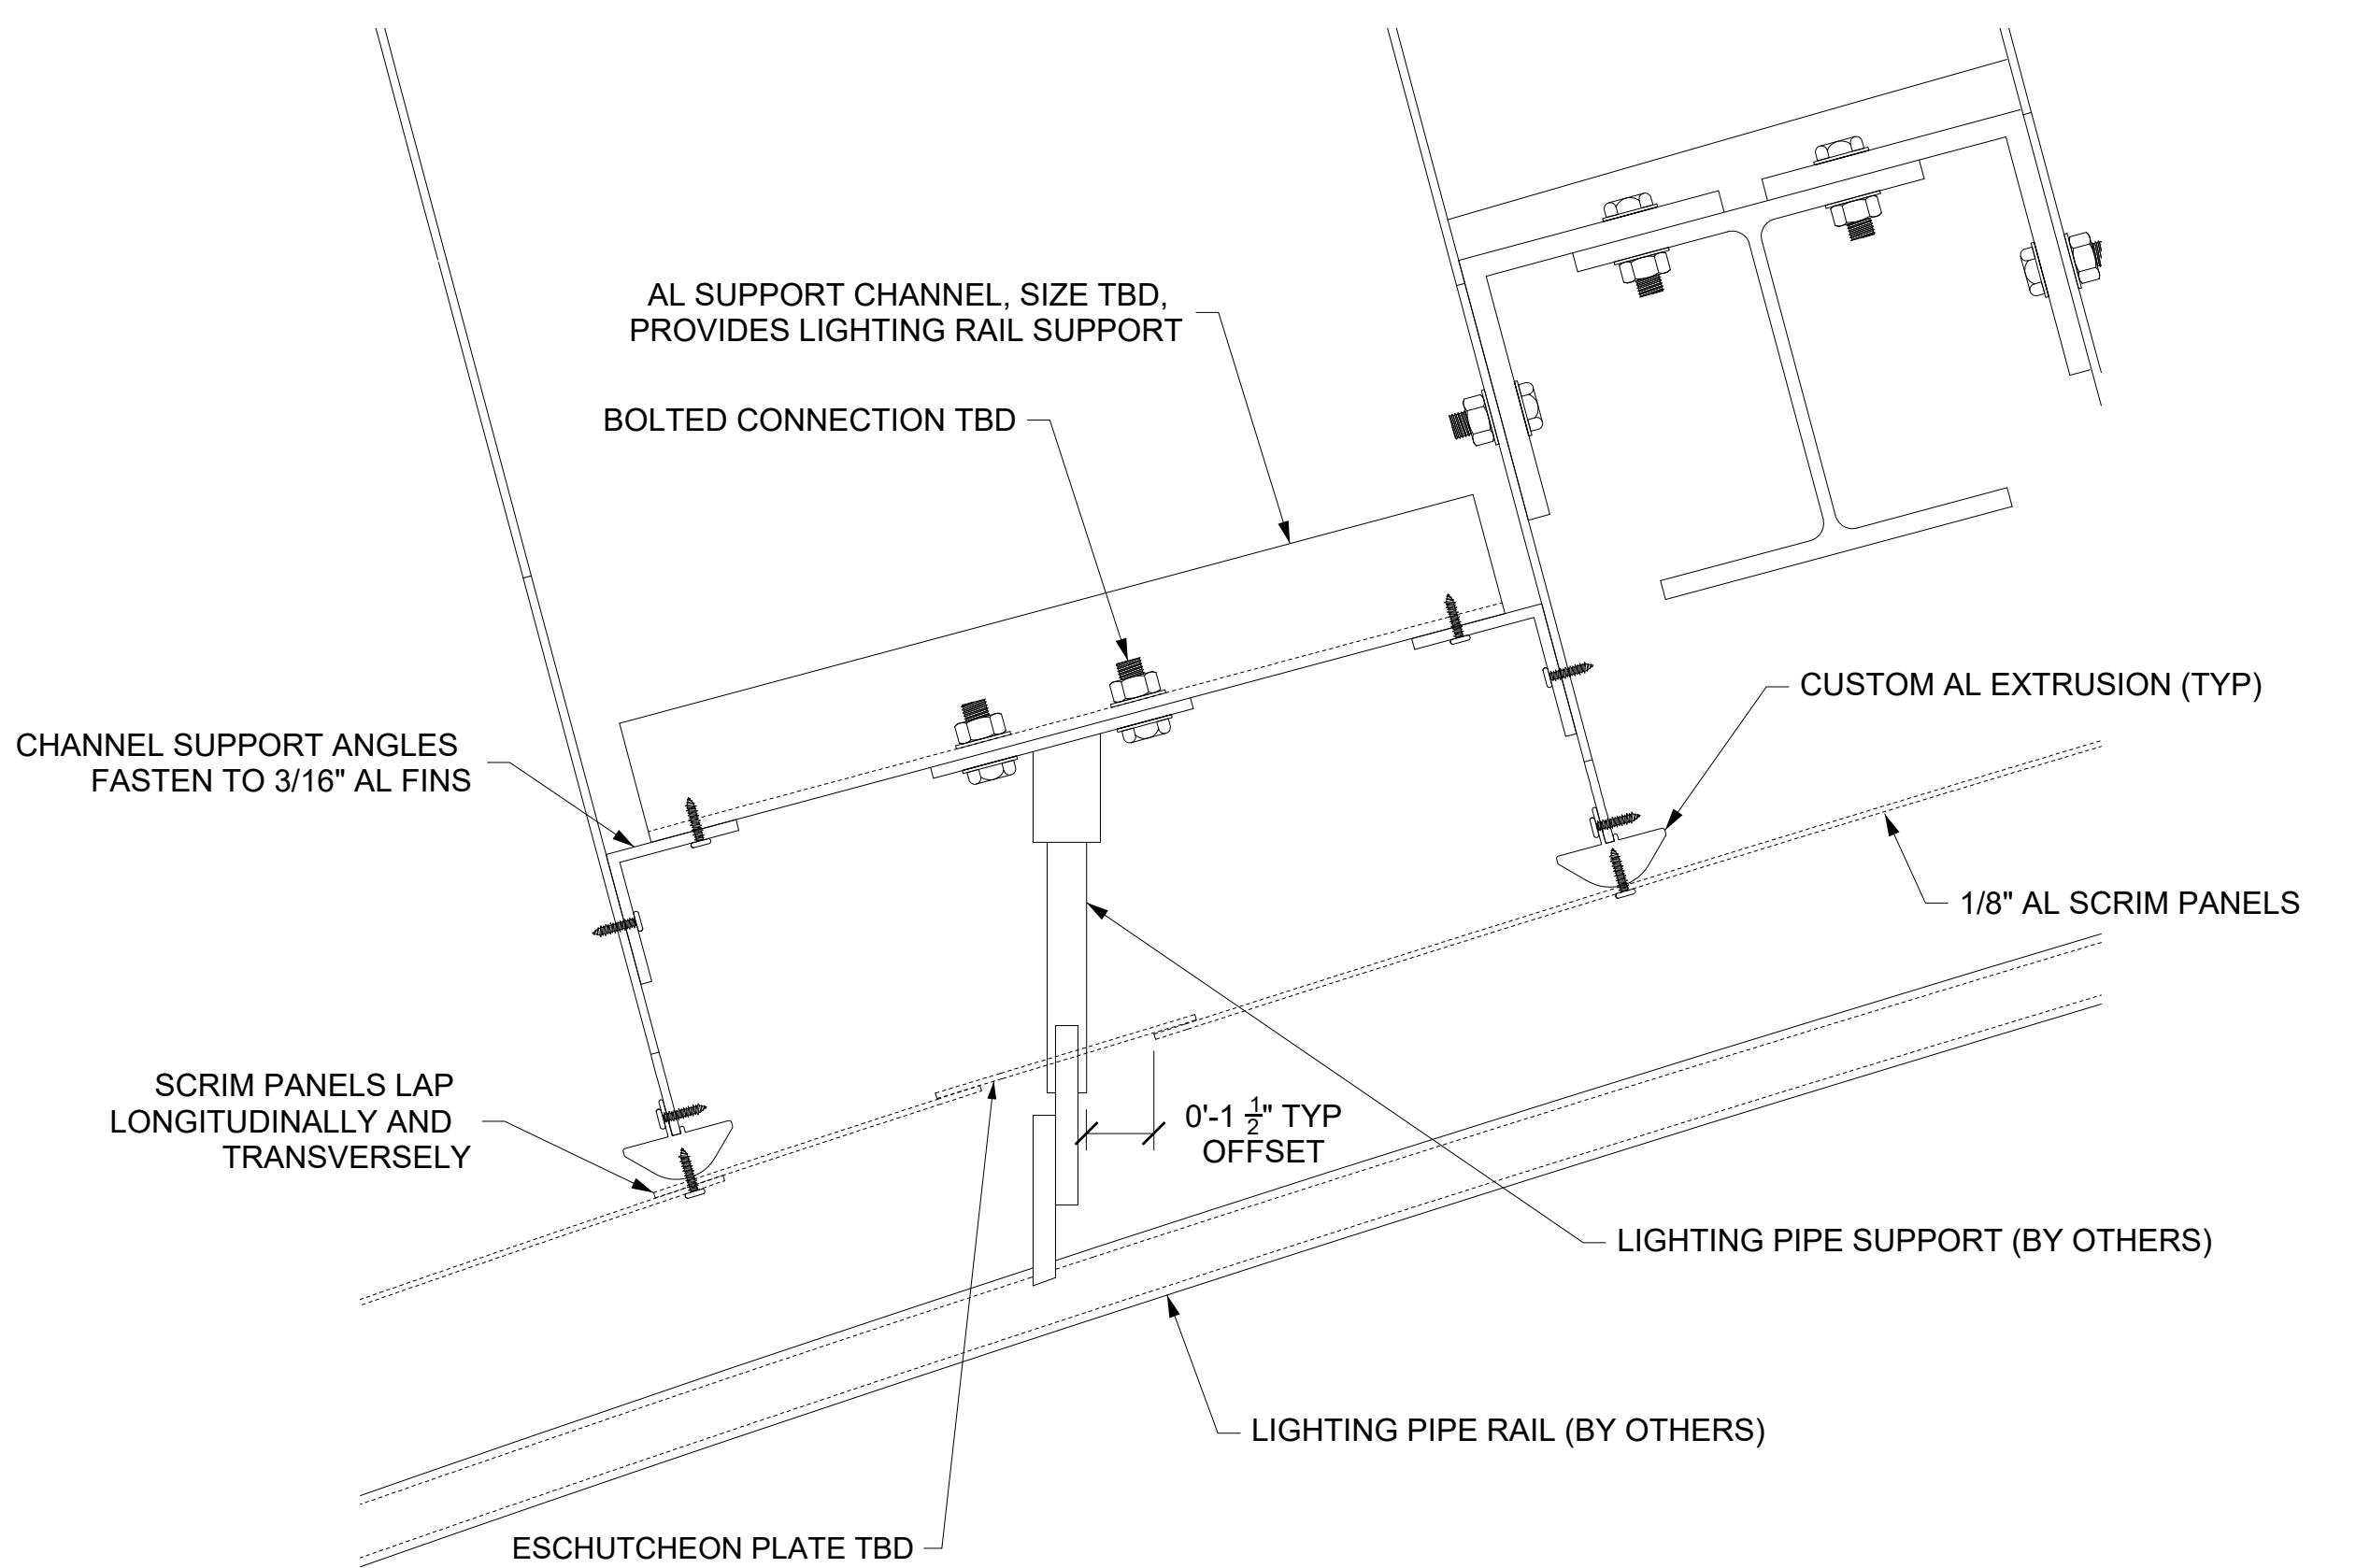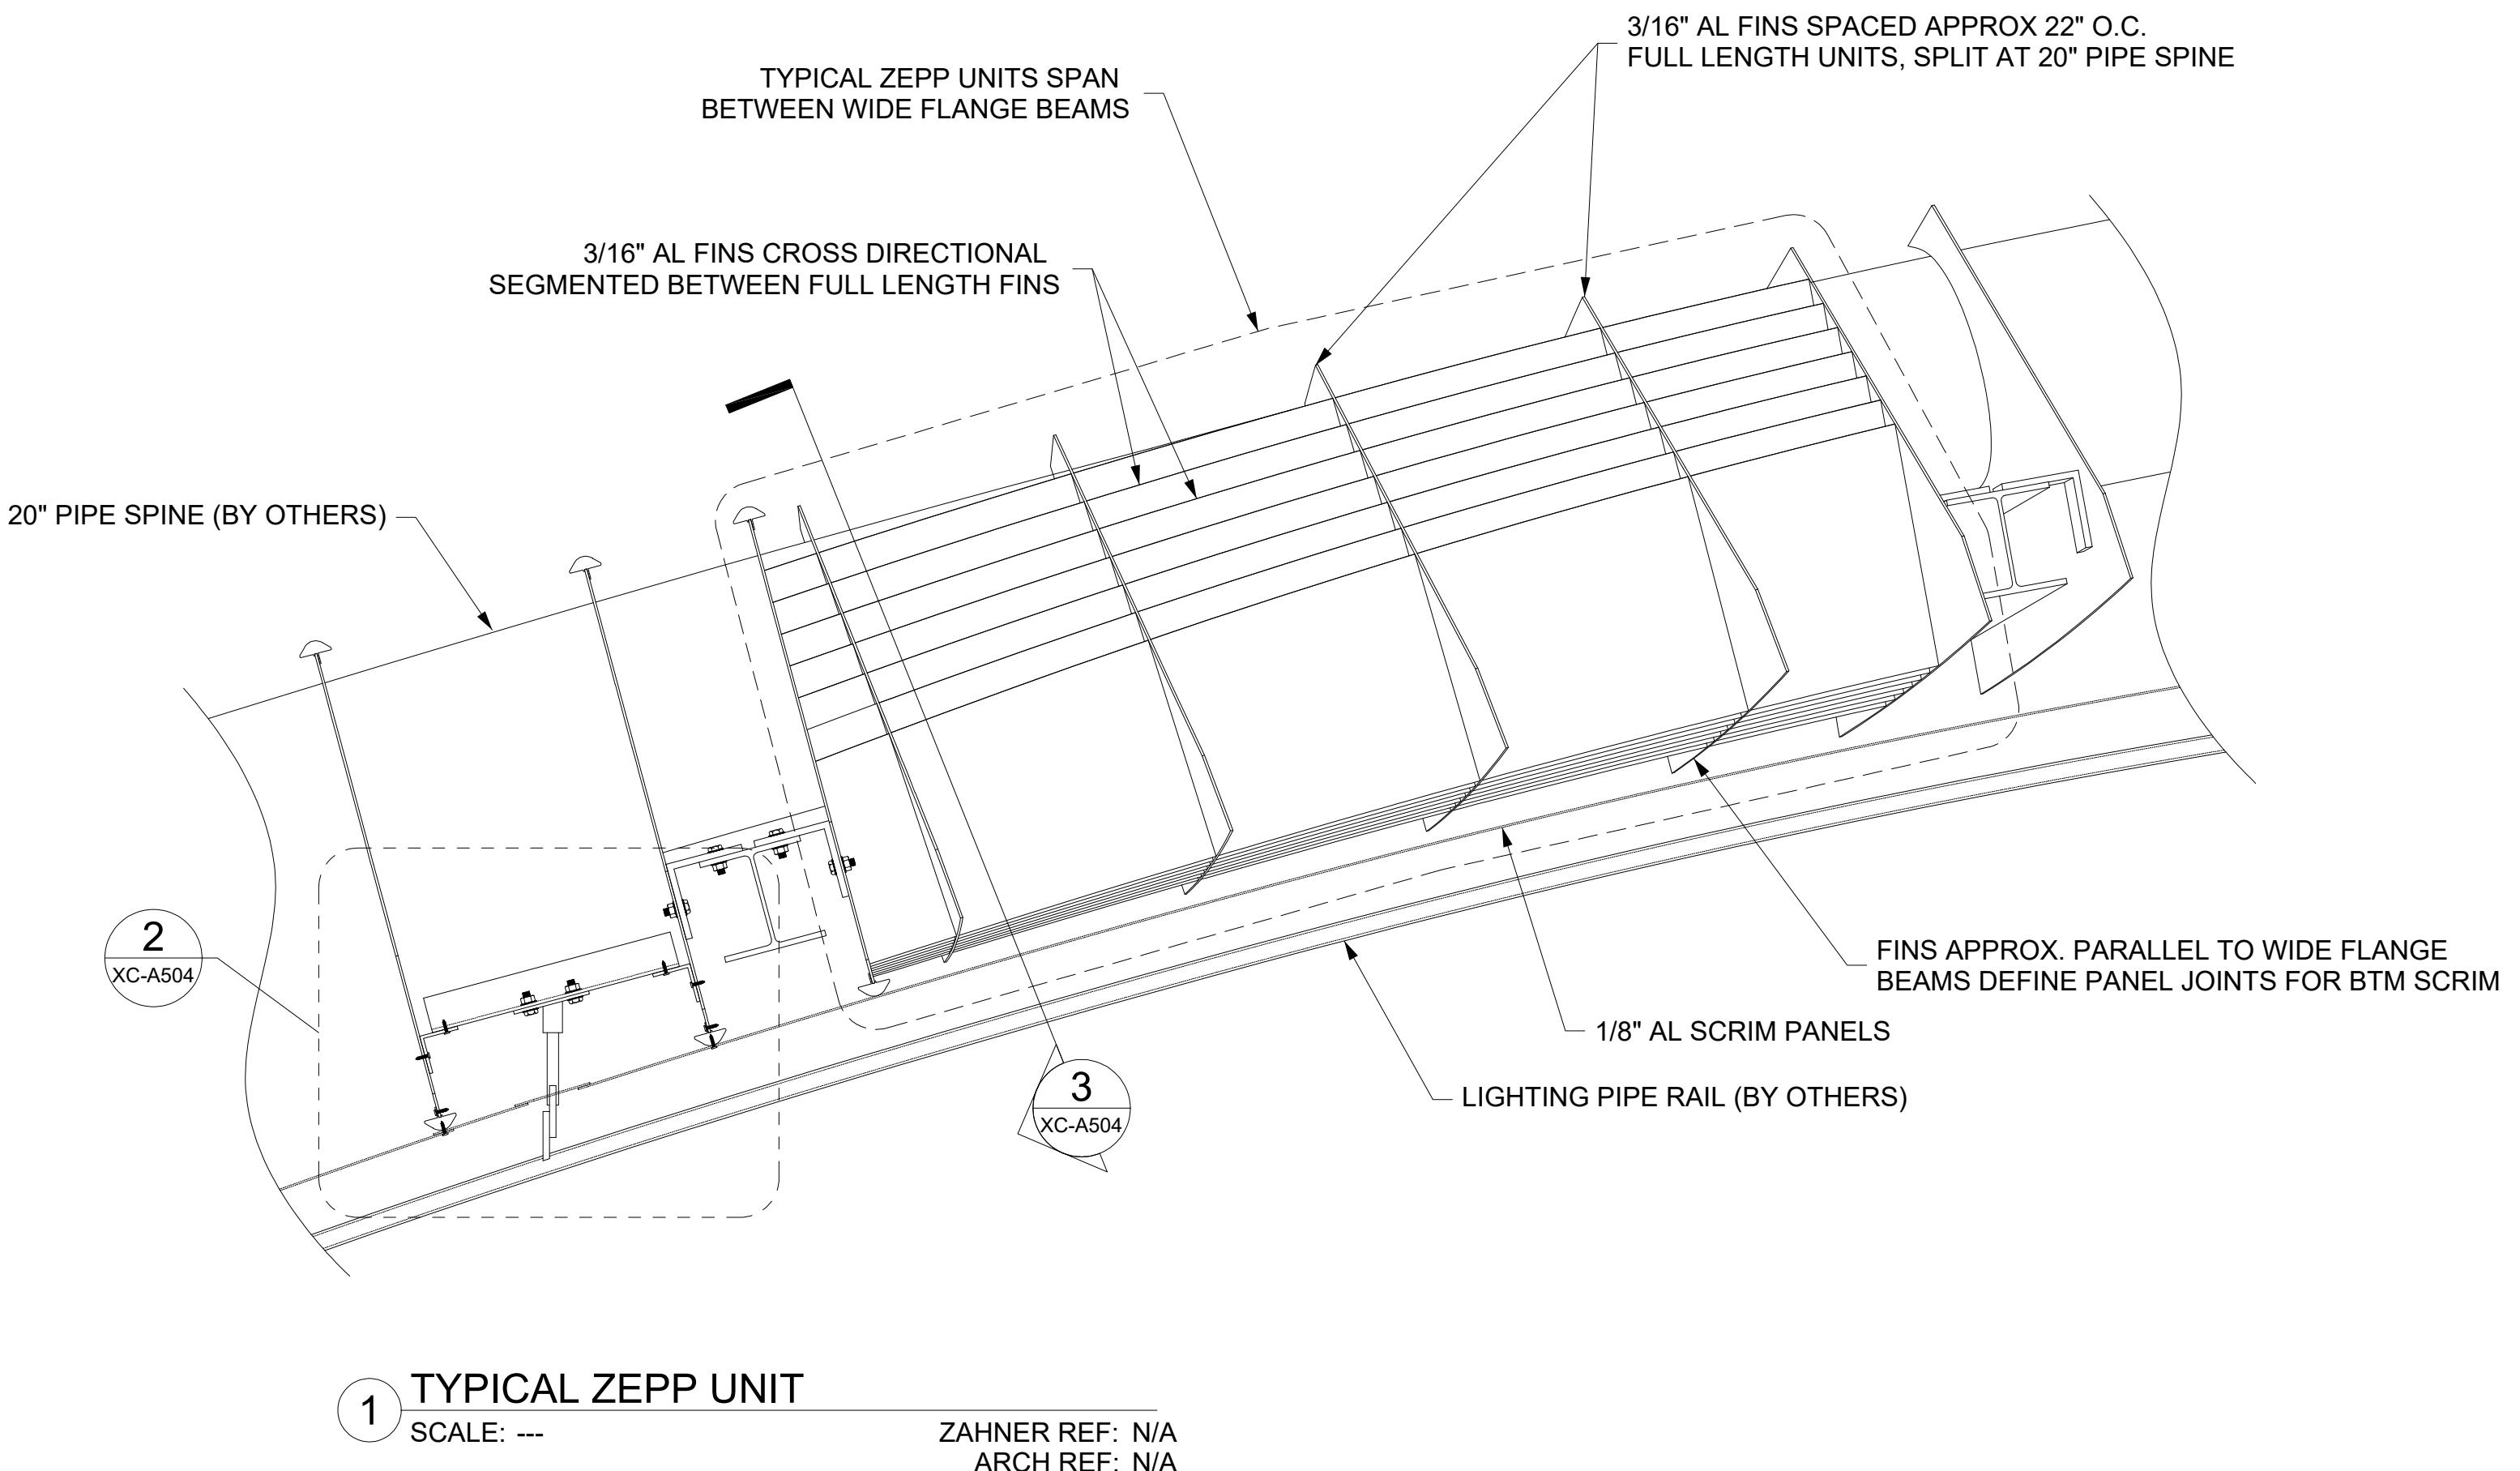


SET ISSUE DATES		
DATE	ISSUE	
01/20/22 100% DRAWINGS		
REVISIONS		
NO.	DATE	DESCRIPTION

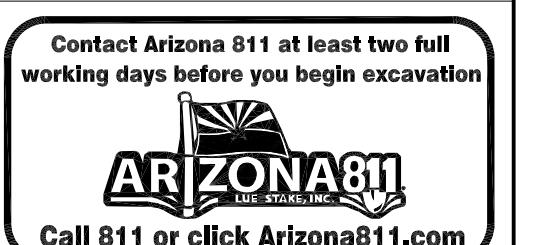

DATE: 01/20/2022 / REVISION: BY:	
ENGINEER	PUBLIC WORKS
CAPITAL PROJECT MANAGEMENT	
7447 E. INDIAN SCHOOL RD. SCOTTSDALE, ARIZONA 85251	
SHEET TITLE	

EAST BOWL - TYP ZEPP DETAILS

PROJECT TITLE		CITY OF SCOTTSDALE CIVIC CENTER PLAZA		
SCALE	DESIGNED	BID NO.	XC-A504	
DRAWN DS	AS-BUILT	COS PROJECT NO. DG04		

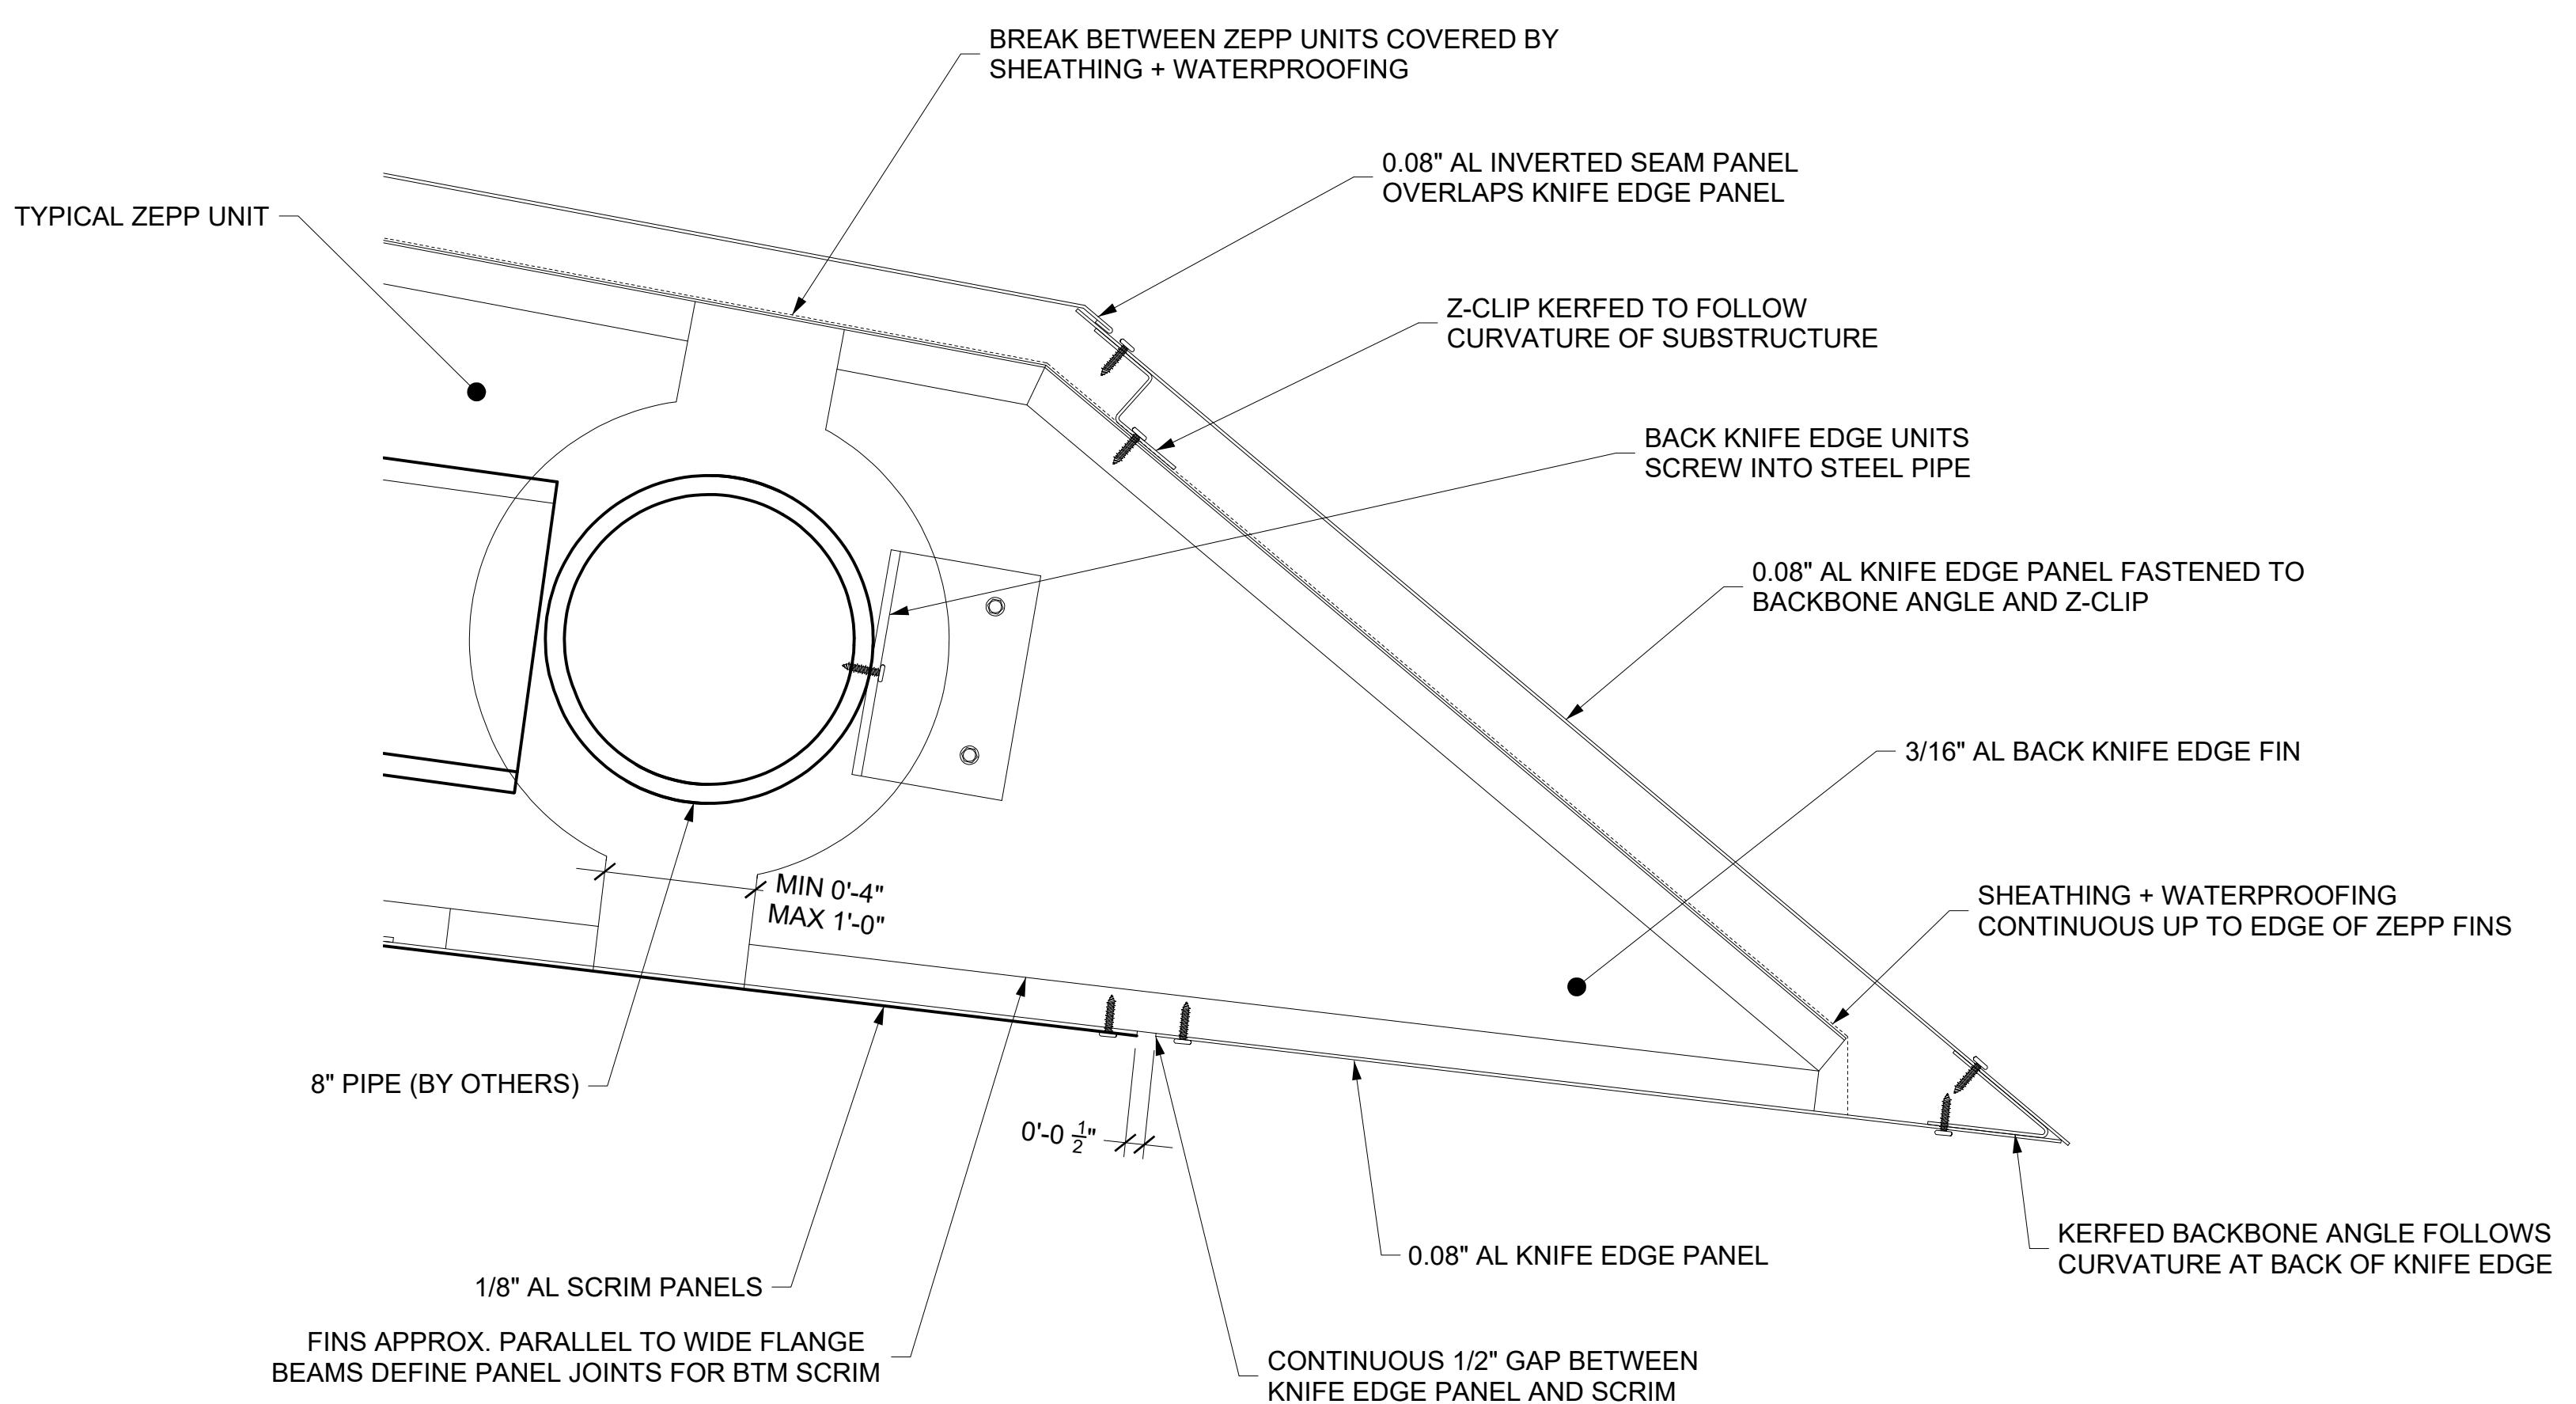


① BACK KNIFE EDGE DETAIL

SCALE: 3' = 1'-0"

ZAHNER REF: N/A
ARCH REF: N/A

SET ISSUE DATES		
DATE	ISSUE	
01/20/22 100% DRAWINGS		


REVISIONS		
NO.	DATE	DESCRIPTION

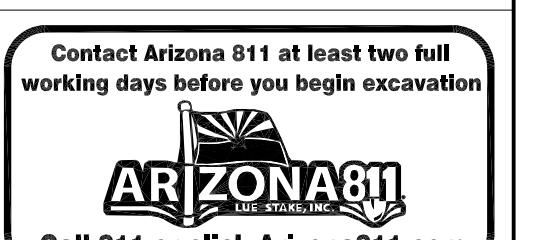

DATE: 01/20/2022	REVISION:	BY:
ENGINEER		PUBLIC WORKS
		CAPITAL PROJECT MANAGEMENT
		74447 E. INDIAN SCHOOL RD. SCOTTSDALE, ARIZONA 85251
SHEET TITLE		

PROJECT TITLE		
CITY OF SCOTTSDALE CIVIC CENTER PLAZA		


THIS SHEET SCALED FOR 24X36" BORDER	SCALE	DESIGNED	BID NO.	XC-A505
	DRAWN DS	AS-BUILT	COS PROJECT NO. DG04	

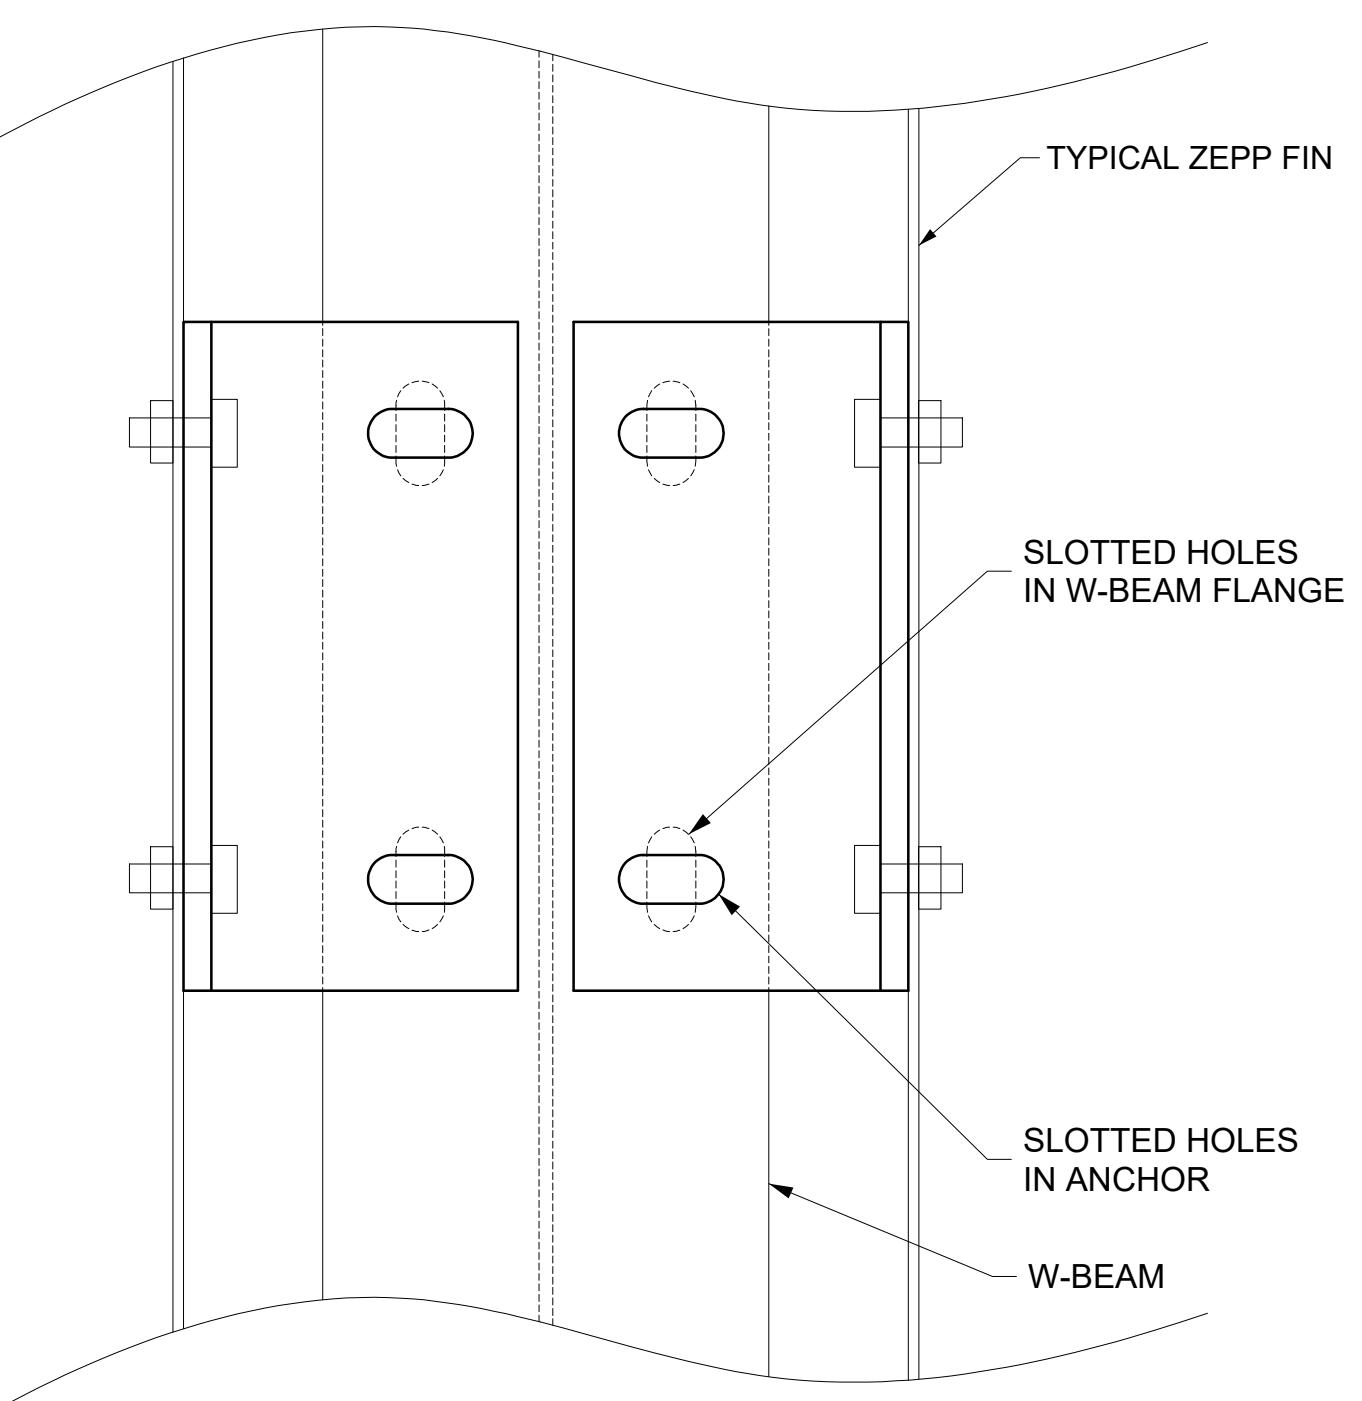

SECTION A-A

SCALE: --


ZAHNER REF: N/A
ARCH REF: N/A

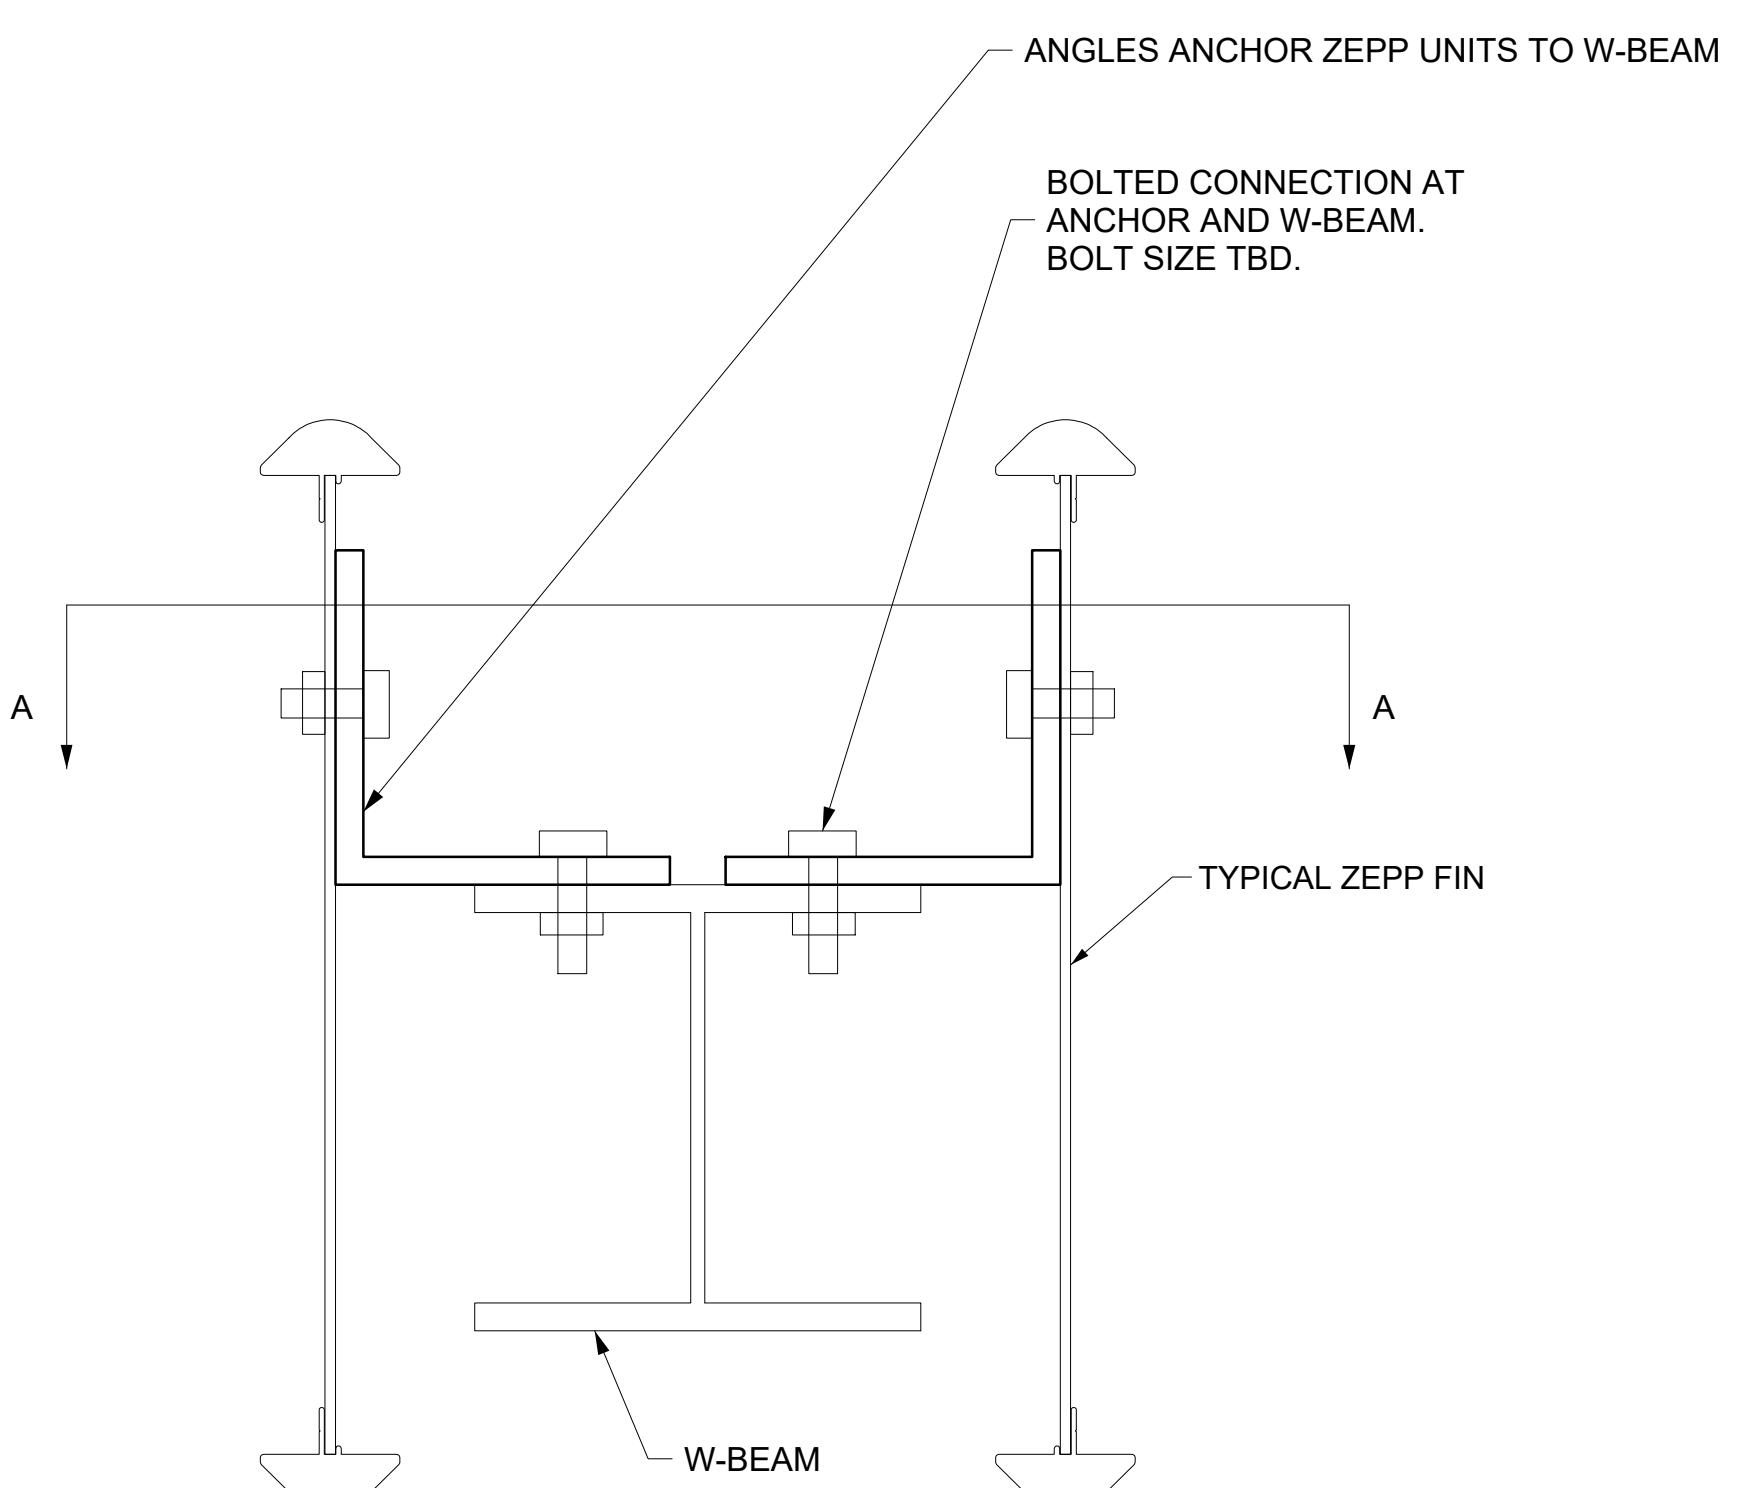


2 ANCHOR DETAIL

2 SCALE =


ZAHNER REF: N/A
ARCH REF: N/A

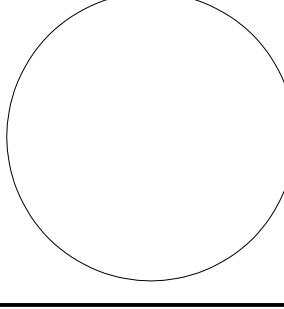SET ISSUE DATES				
DATE	ISSUE			
01/20/22 100% DRAWINGS				
<hr/> <hr/> <hr/> <hr/> <hr/>				
REVISIONS				
NO.	DATE	DESCRIPTION		
		<hr/> <hr/> <hr/> <hr/> <hr/>		
<div style="text-align: right; padding: 10px;"> <p>Contact Arizona 811 at least two full working days before you begin excavation</p>  <p>Call 811 or click Arizona811.com</p> </div>				
DATE: 01/20/2022		REVISION:		BY:
ENGINEER 		<div style="text-align: center;">  <p>PUBLIC WORKS</p> <p>CAPITAL PROJECT MANAGEMENT</p> <p>7447 E. INDIAN SCHOOL RD. SCOTTSDALE, ARIZONA 85251</p> </div>		
SHEET TITLE				
<h1>EAST BOWL - ANCHOR DETAILS</h1>				
PROJECT TITLE		CITY OF SCOTTSDALE CIVIC CENTER PLAZA		
D R	SCALE	DESIGNED	BID NO.	
	DRAWN DS	AS-BUILT	COS PROJECT NO. DG04	
				XC-A506

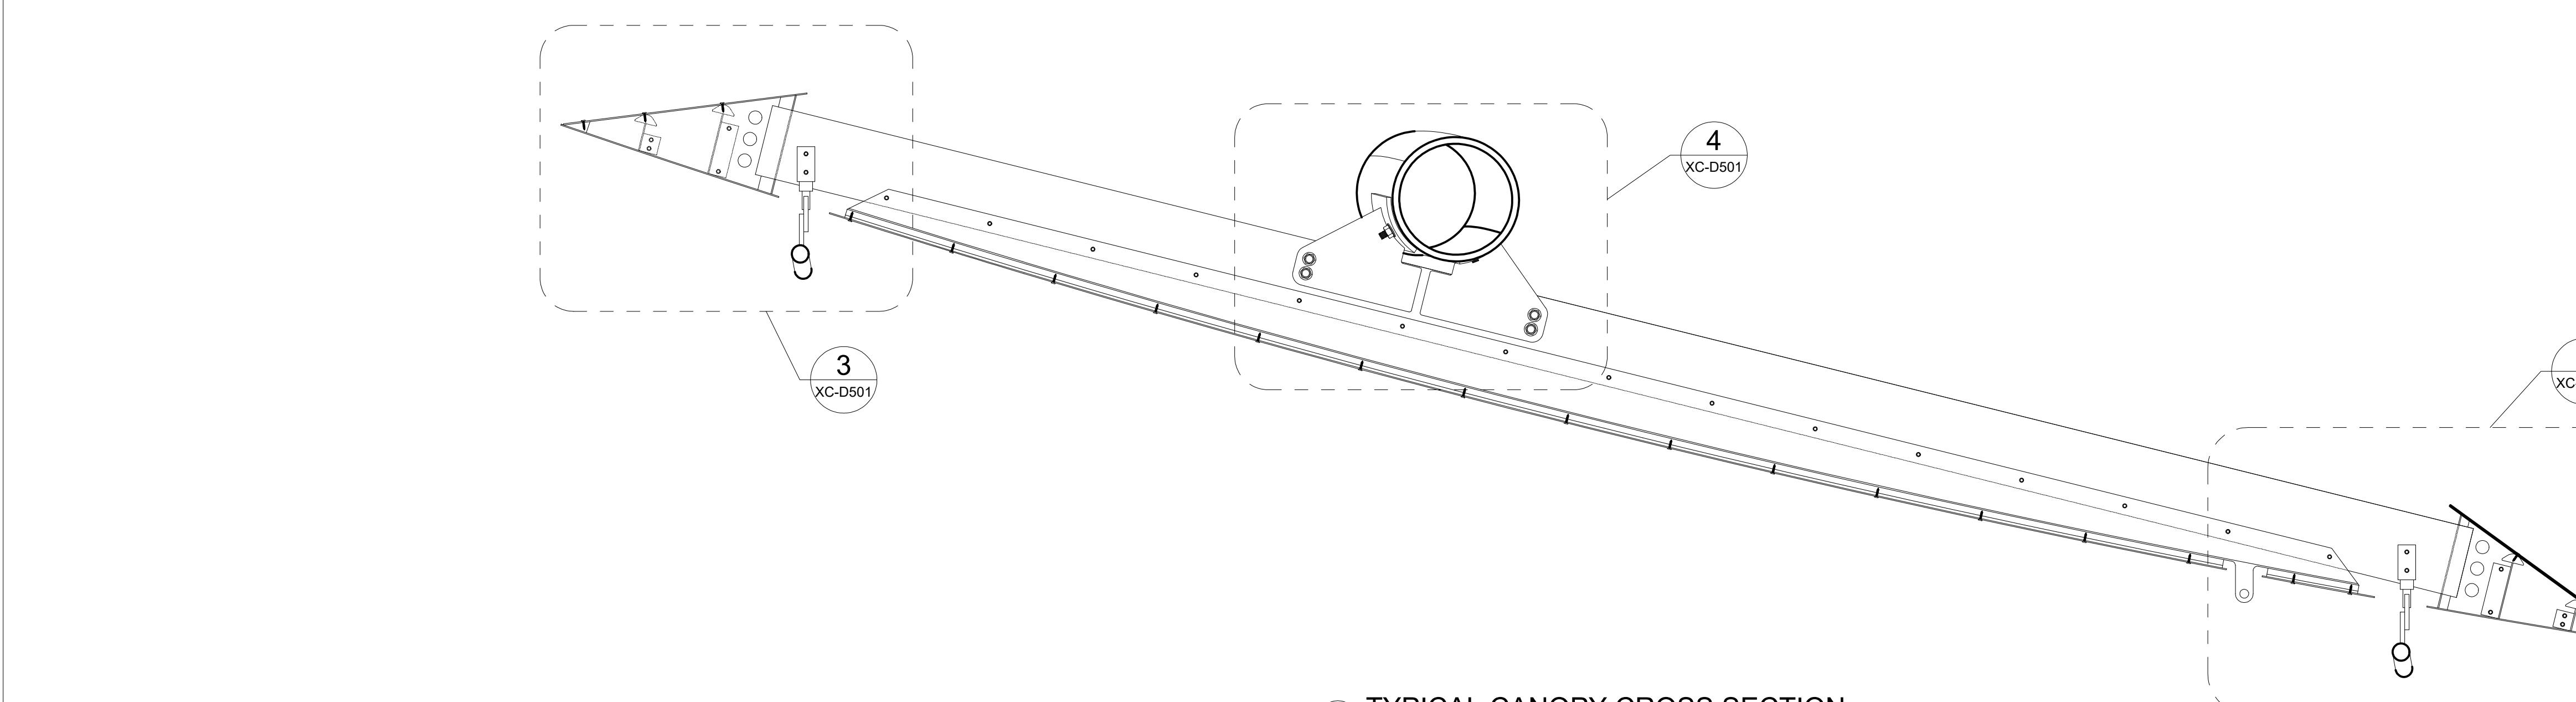


1 TYPICAL CANOPY CROSS SECTION

SCALE: 1" = 1'-0"
ZAHNER REF: N/A
ARCH REF: N/A

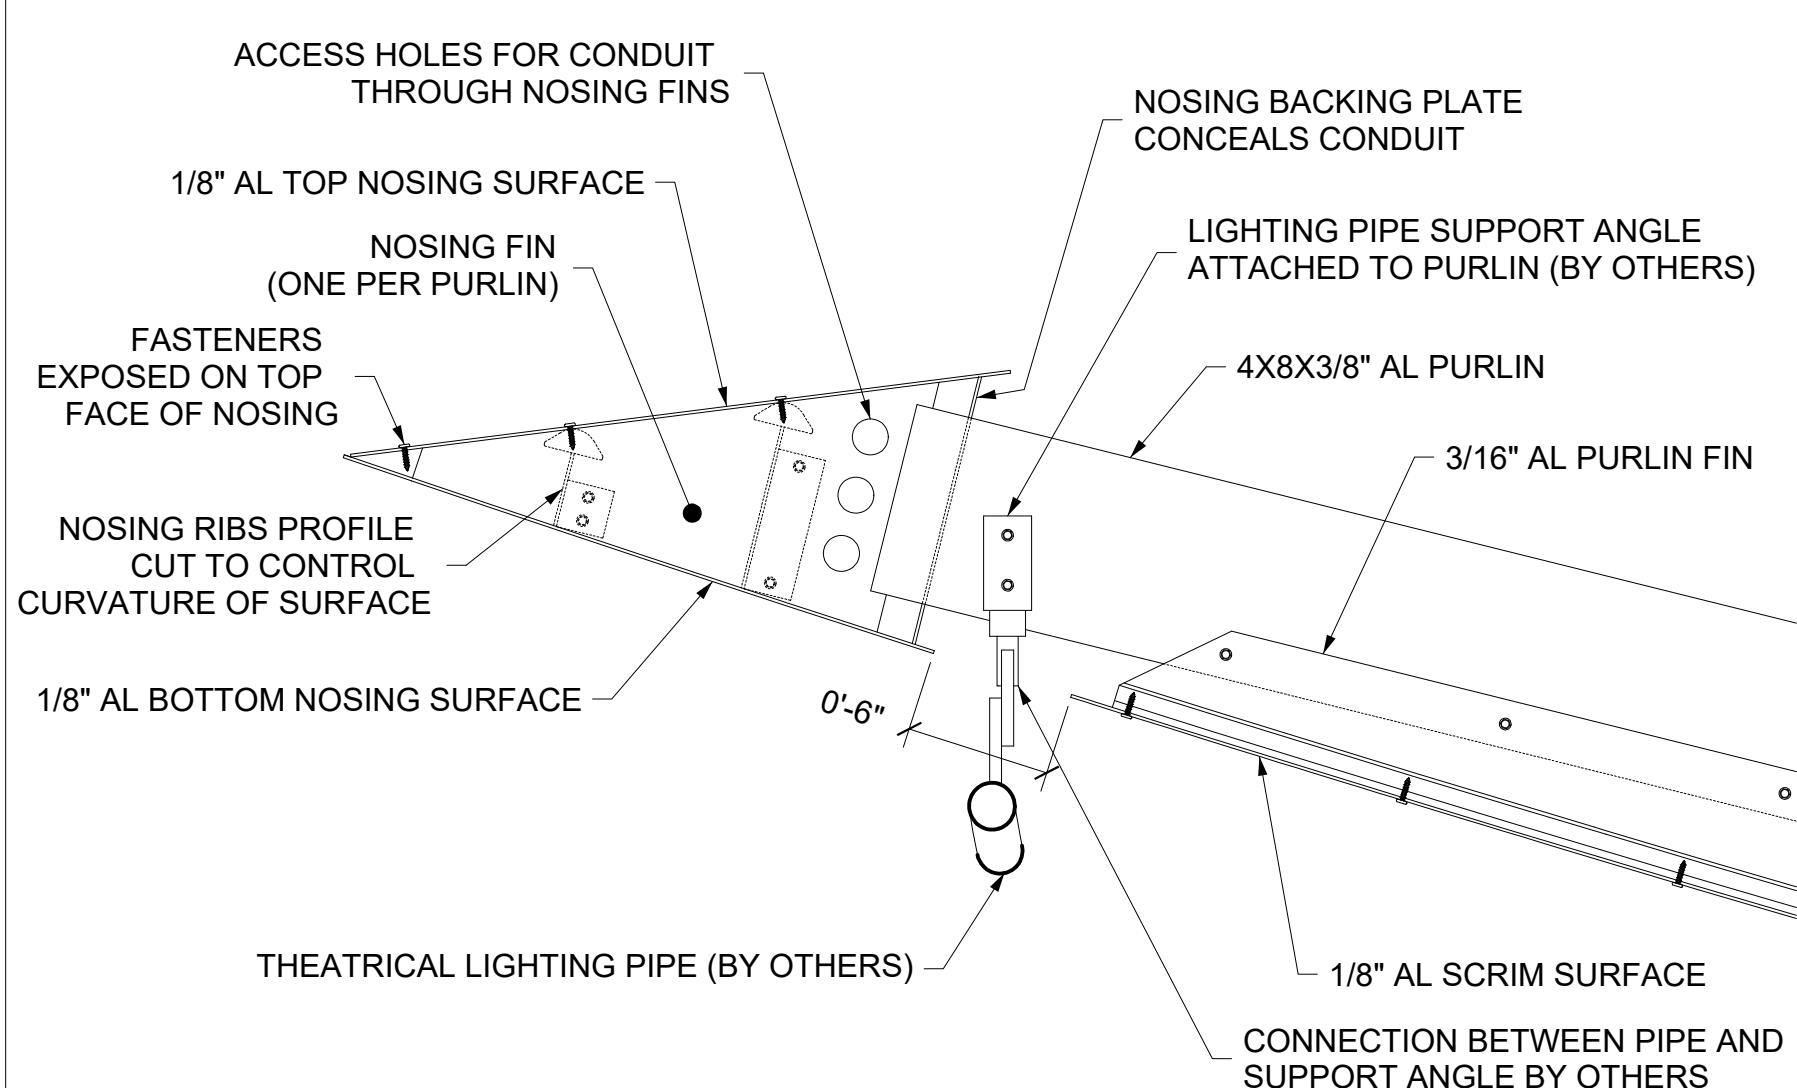


3 OUTSIDE NOSING DETAIL

SCALE: 1" = 1'-0"
ZAHNER REF: N/A
ARCH REF: N/A

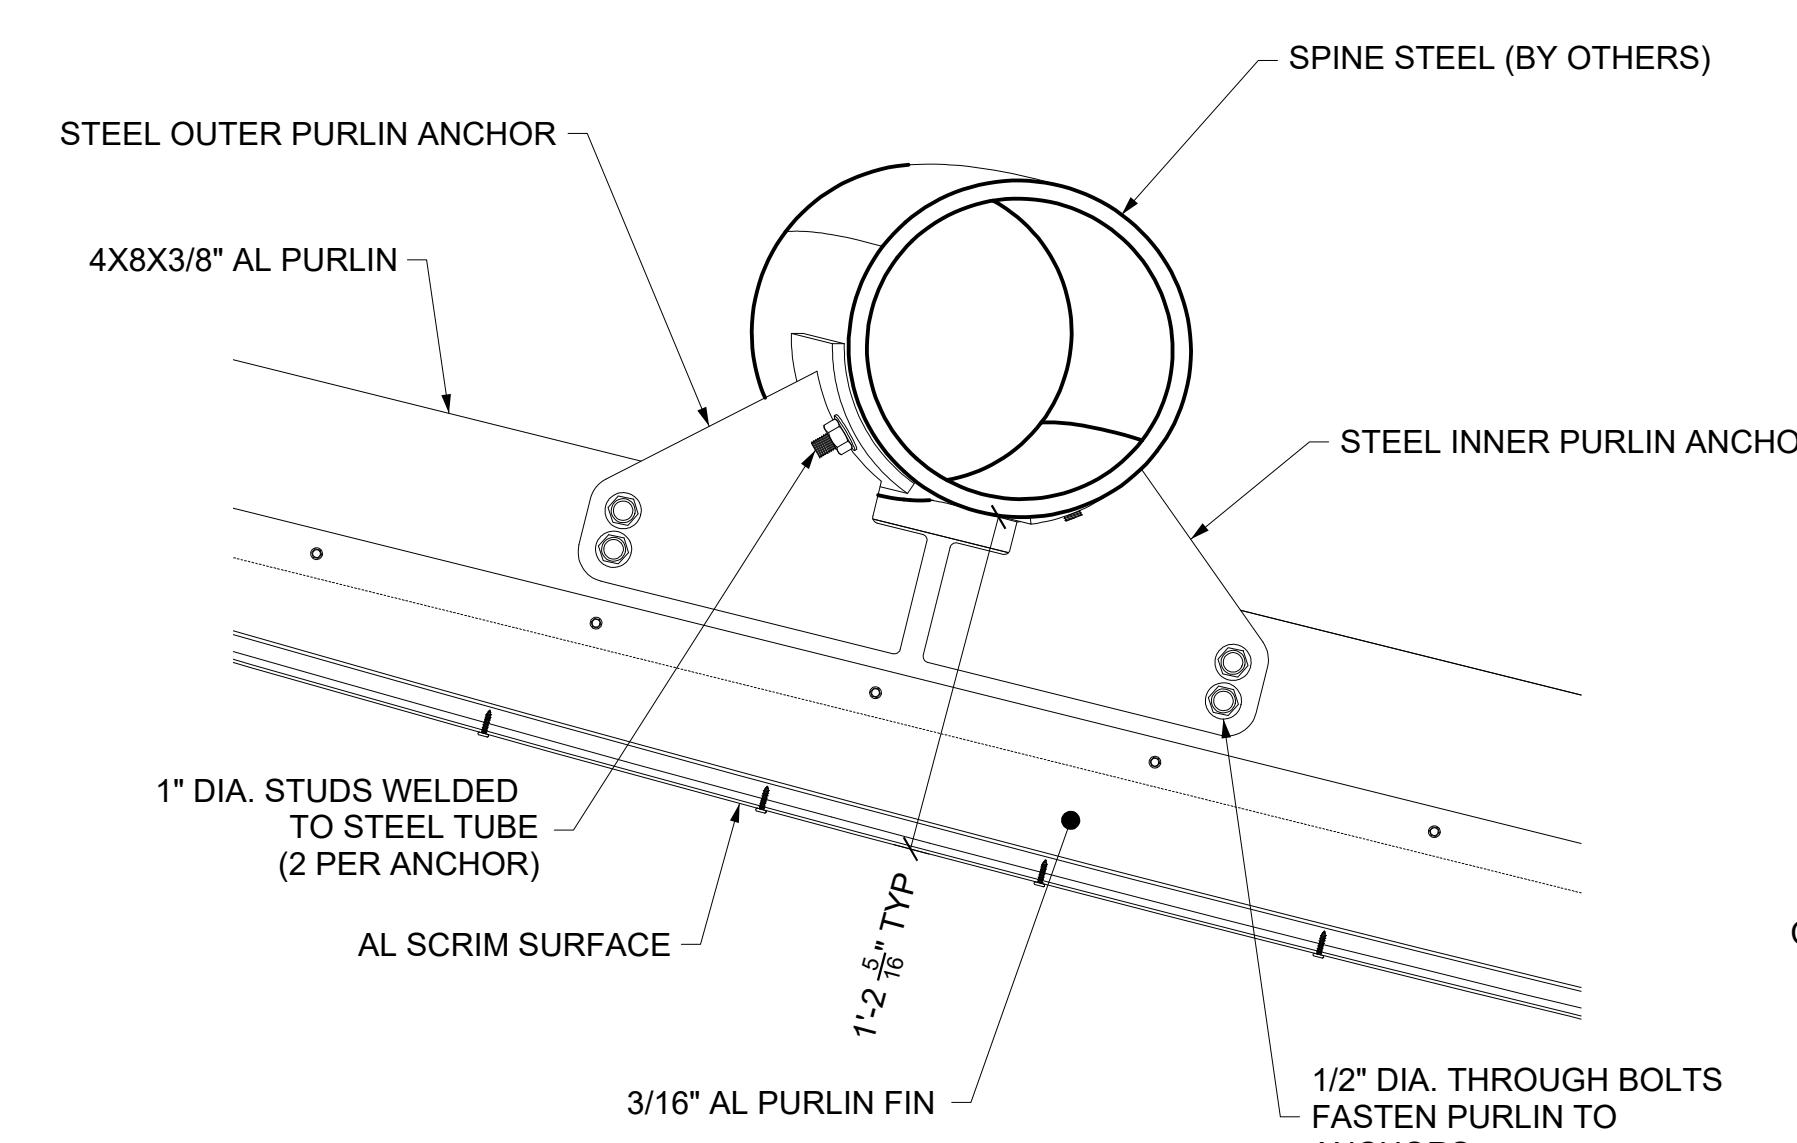


4 ANCHOR DETAIL

SCALE: 1" = 1'-0"
ZAHNER REF: N/A
ARCH REF: N/A

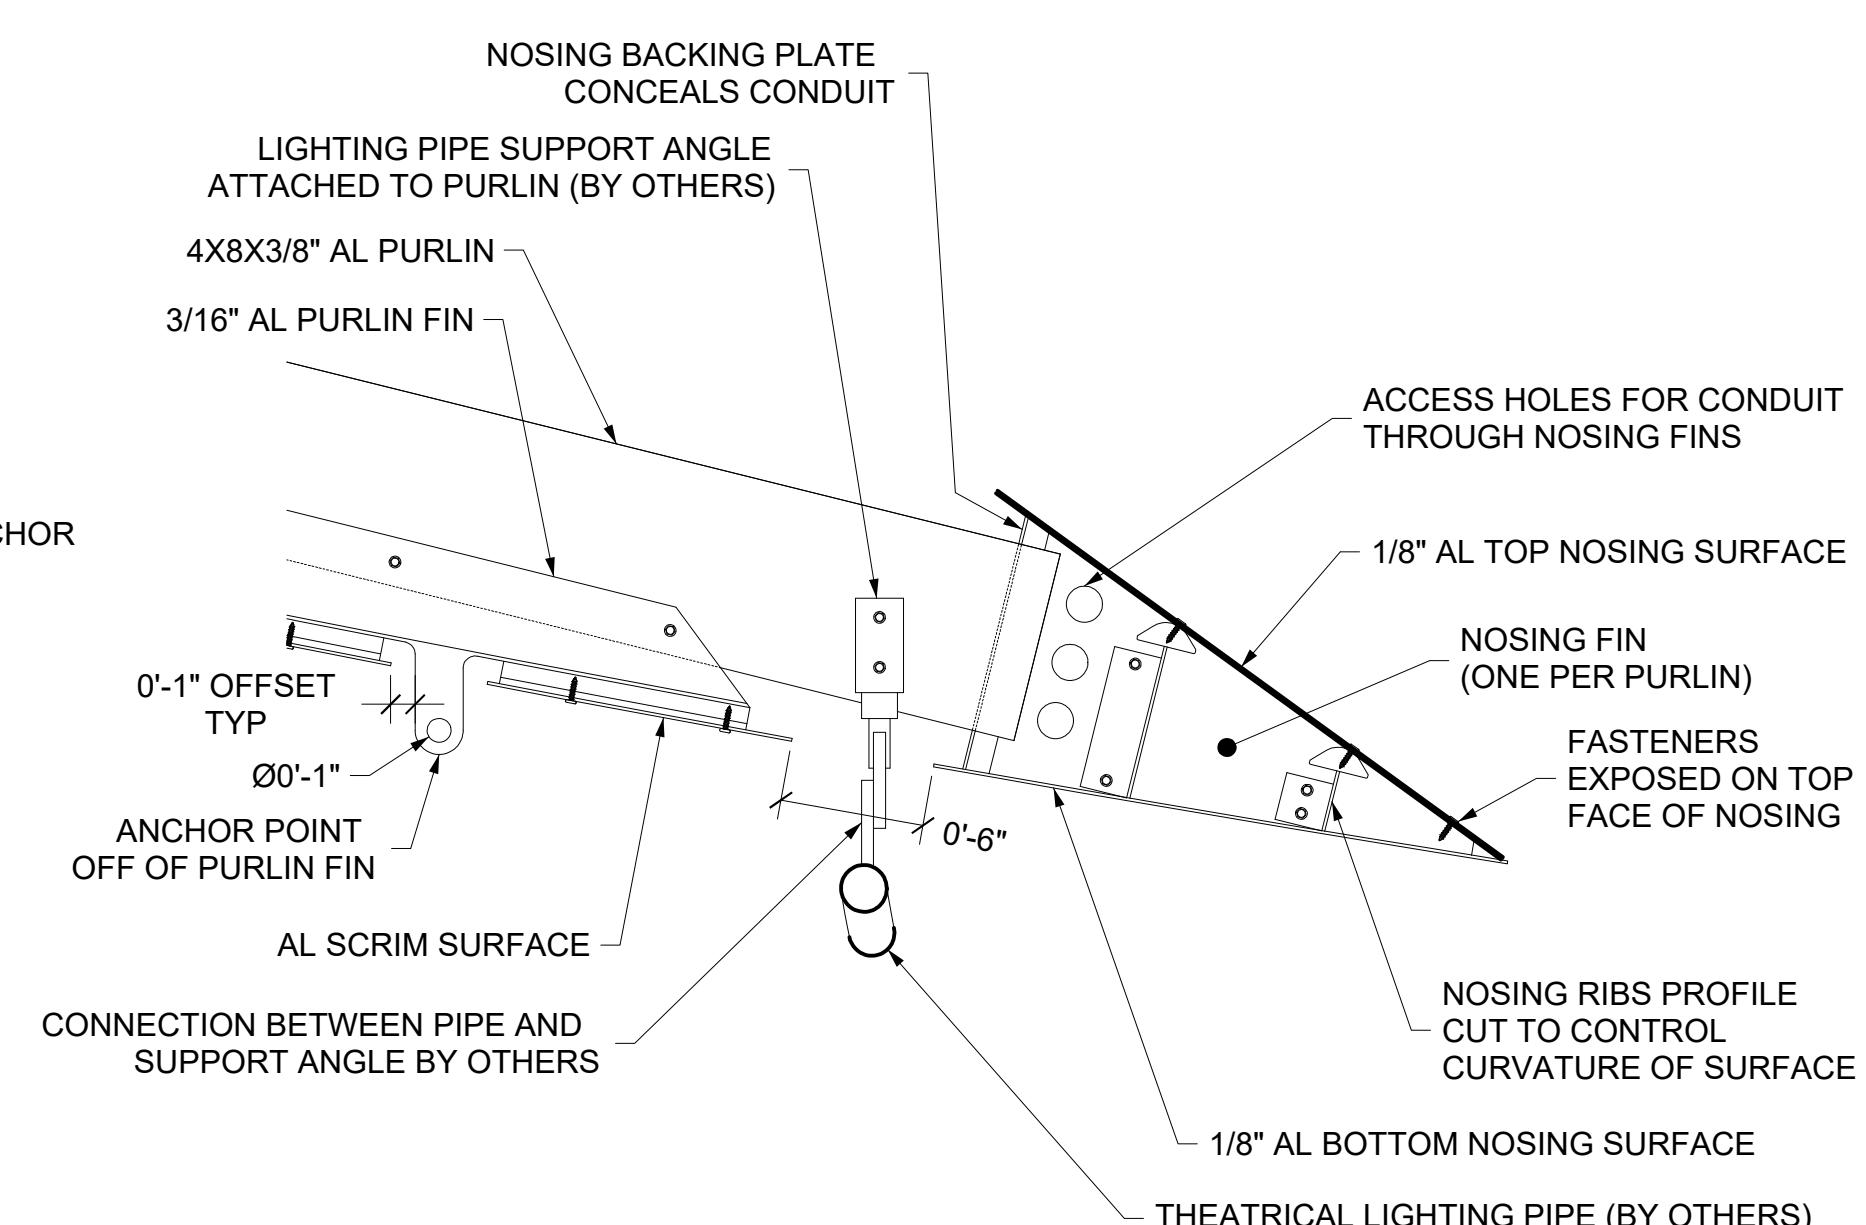


5 INSIDE NOSING DETAIL

SCALE: 1" = 1'-0"
ZAHNER REF: N/A
ARCH REF: N/A

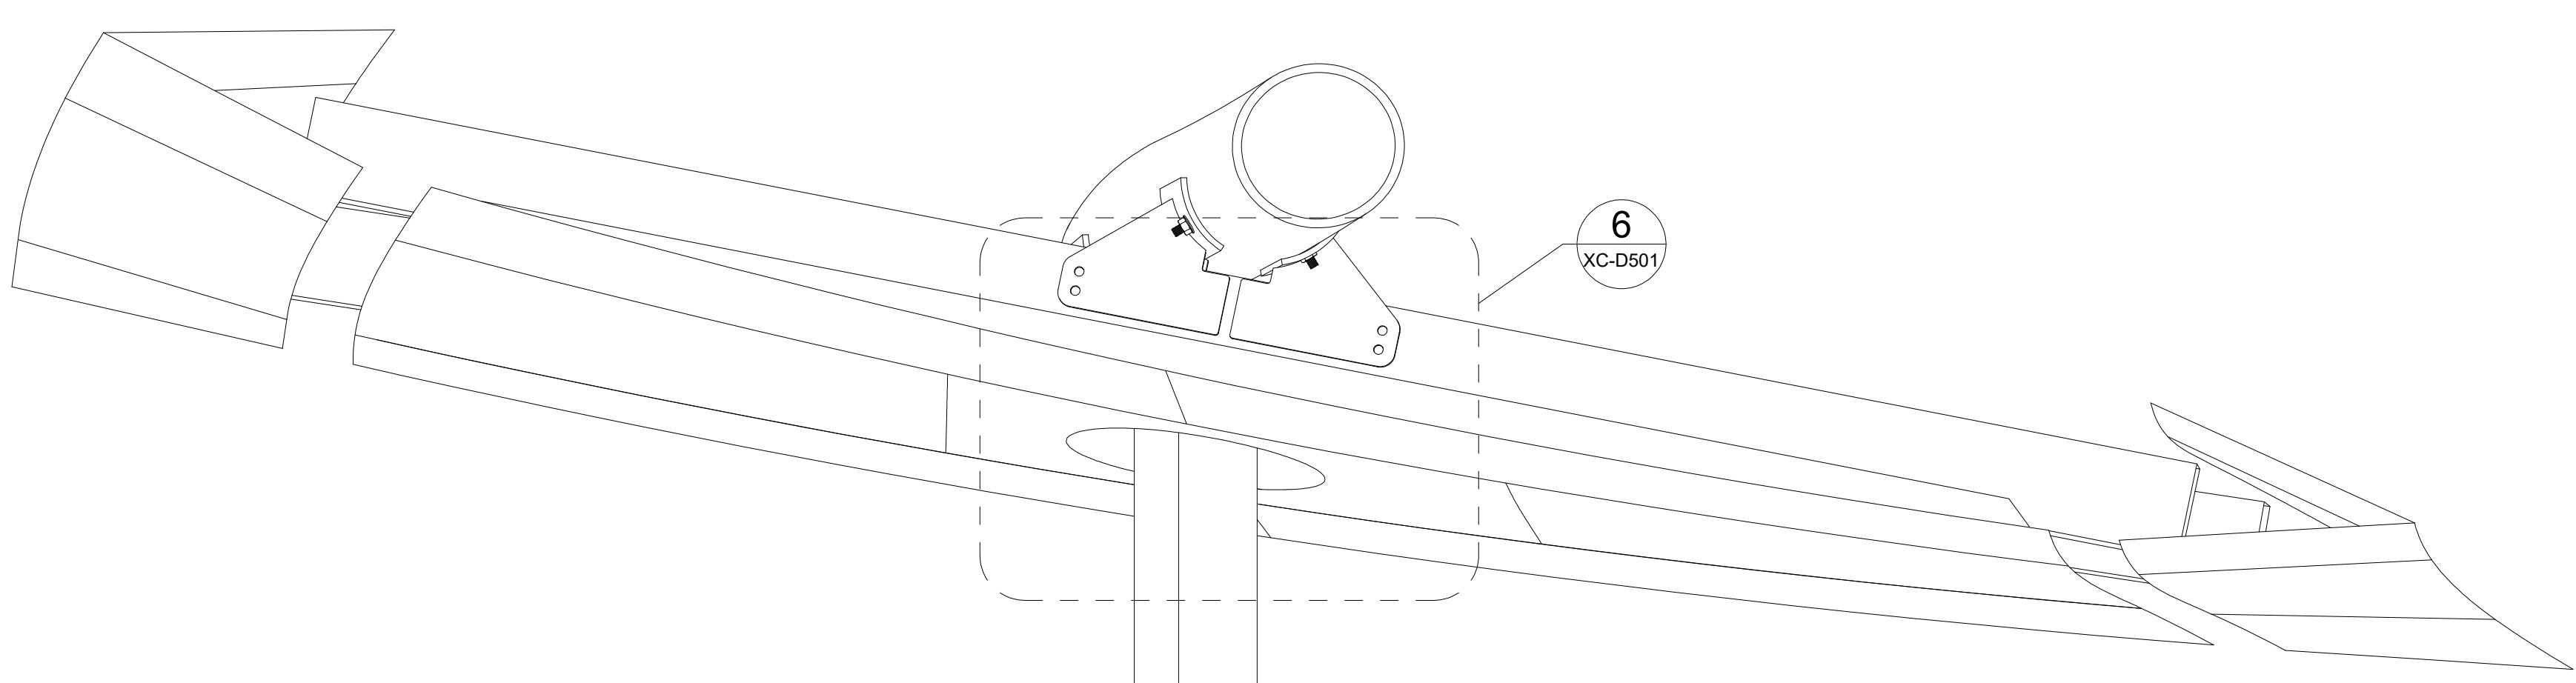

2 CANOPY CROSS SECTION AT COLUMNS

SCALE: 1" = 1'-0"
ZAHNER REF: N/A
ARCH REF: N/A

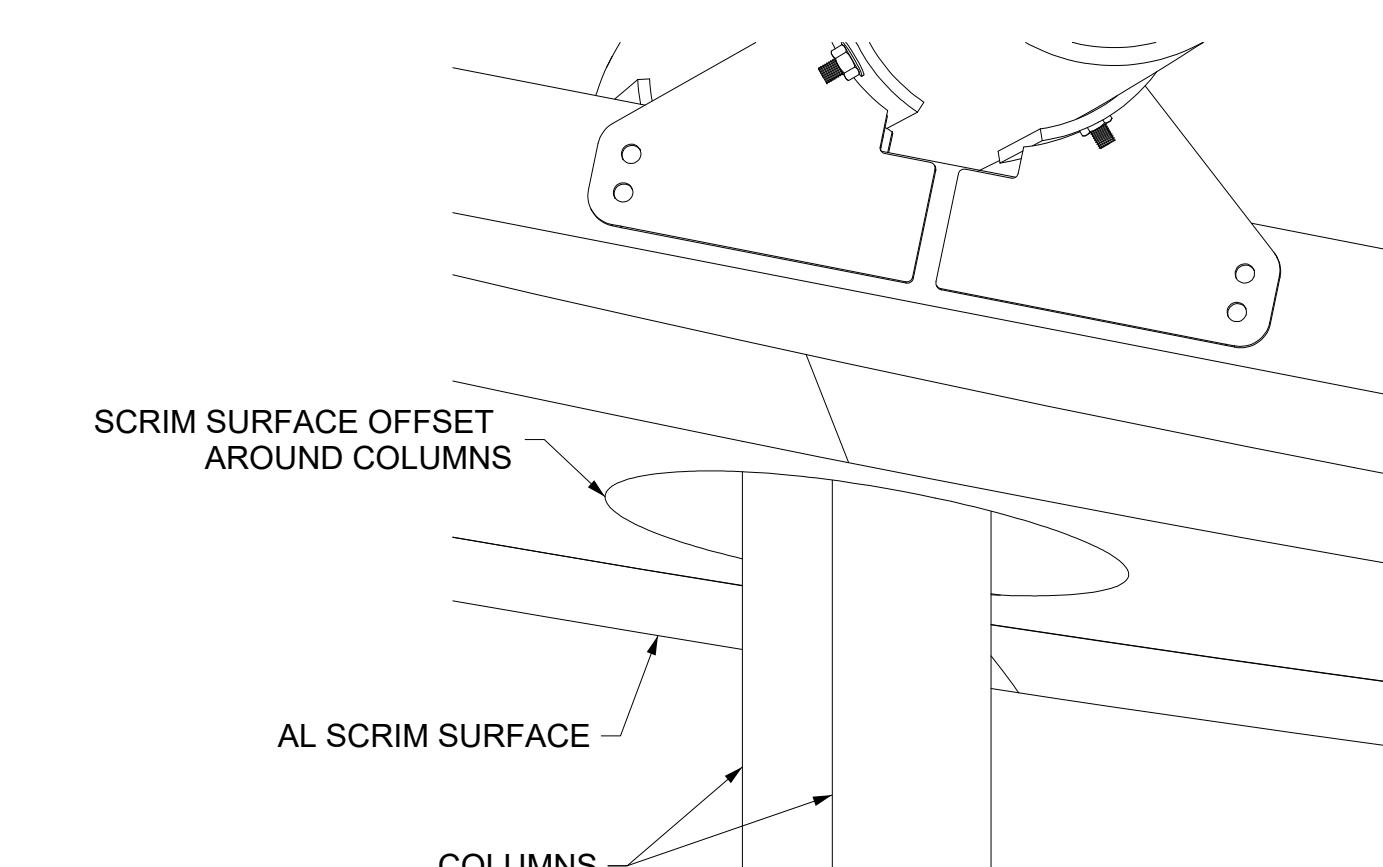

6 SCRIM DETAIL AT COLUMN


SCALE: 1" = 1'-0"
ZAHNER REF: N/A
ARCH REF: N/A

THIS SHEET SCALED
FOR 24X36" BORDER

SCALE	DESIGNED	BID NO.	XC-D501
DRAWN DS	AS-BUILT	COS PROJECT NO.	DG04

SET ISSUE DATES	
DATE	ISSUE
01/20/22 100% DRAWINGS	


REVISIONS		
NO.	DATE	DESCRIPTION

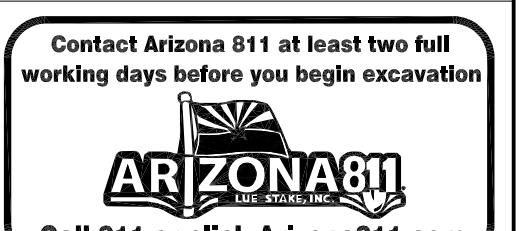

DATE: 01/20/2022	REVISION:	BY:
ENGINEER		
PUBLIC WORKS		
CAPITAL PROJECT MANAGEMENT		
7447 E. INDIAN SCHOOL RD., SCOTTSDALE, ARIZONA 85251		


SHEET TITLE	360 CANOPY - TYPICAL CANOPY SECTION DETAILS		
PROJECT TITLE	CITY OF SCOTTSDALE CIVIC CENTER PLAZA		

SCALE	DESIGNED	BID NO.	XC-D501
DRAWN DS	AS-BUILT	COS PROJECT NO.	DG04

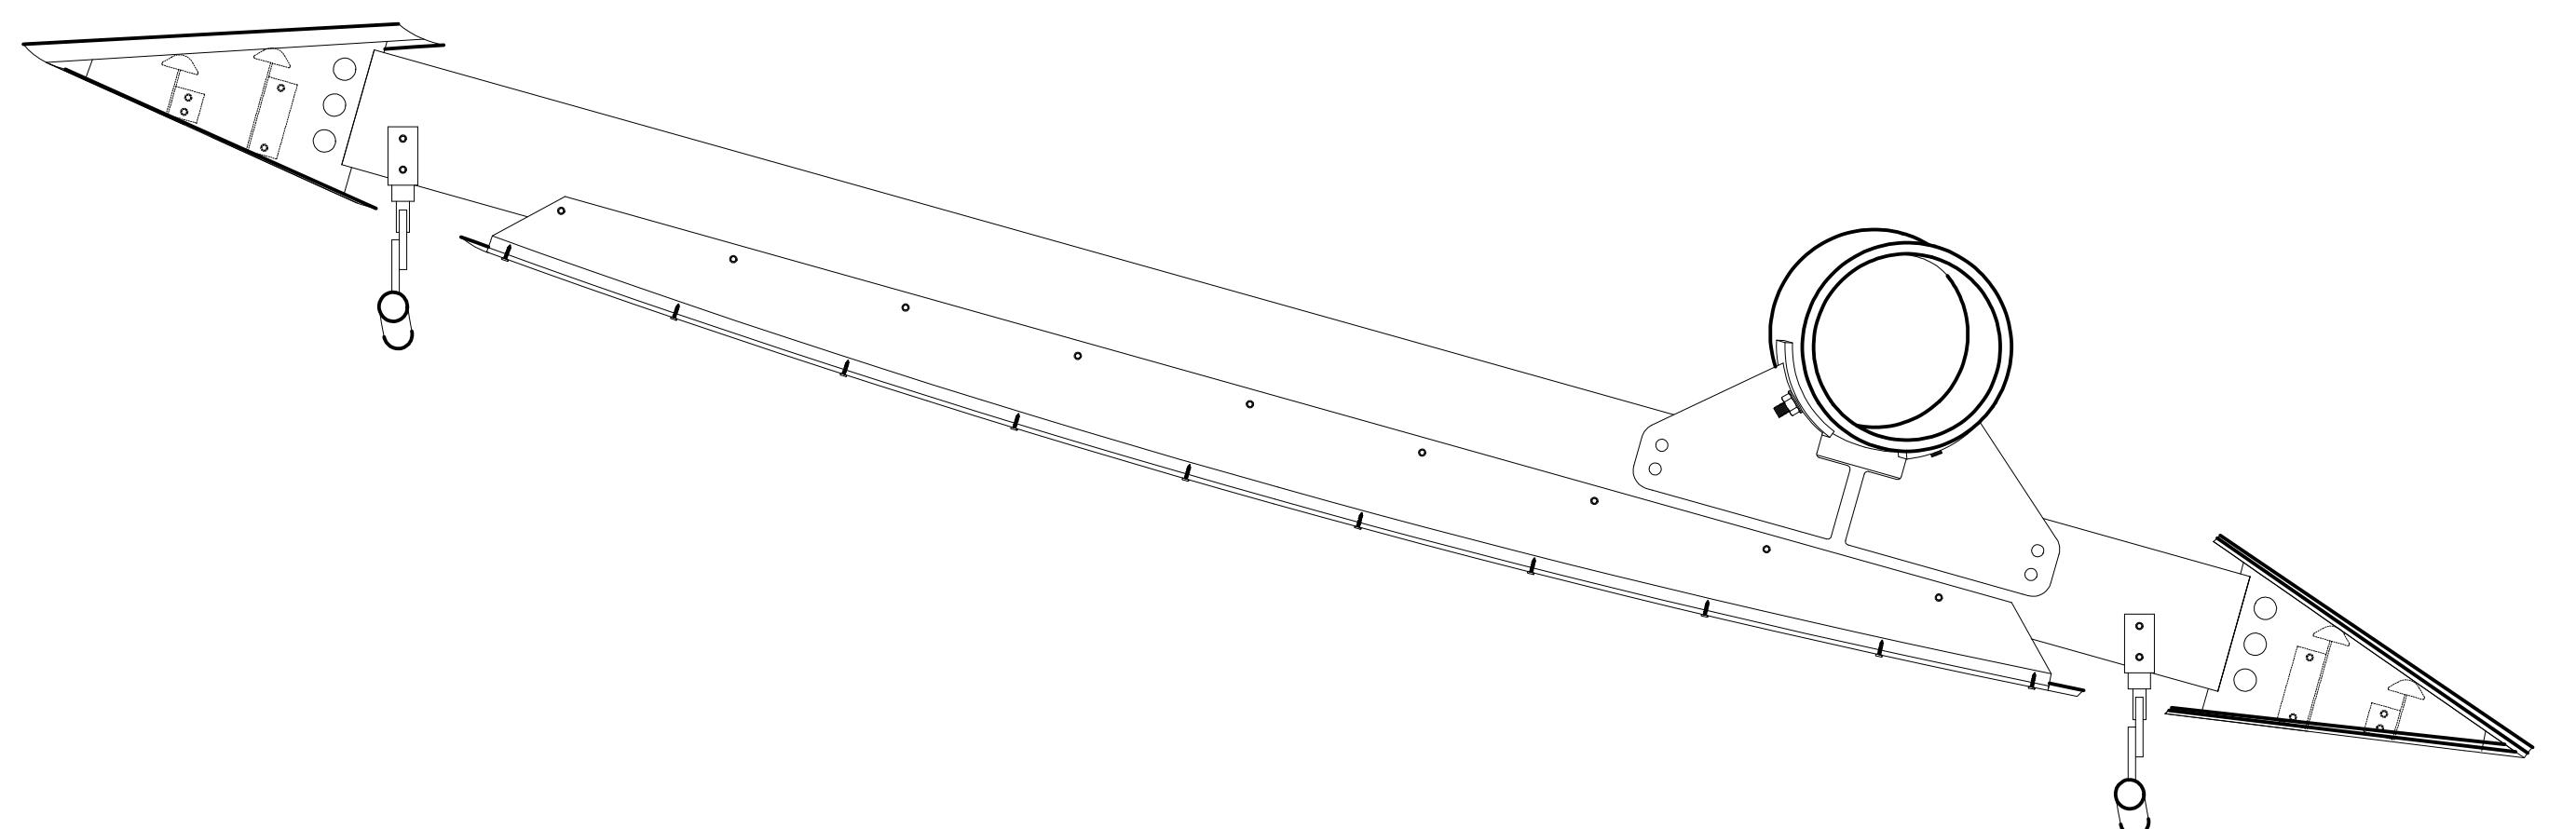

① CANOPY CROSS SECTION AT WALKING PATH


SCALE: 1" = 1'-0"
ZAHNER REF: N/A
ARCH REF: N/A

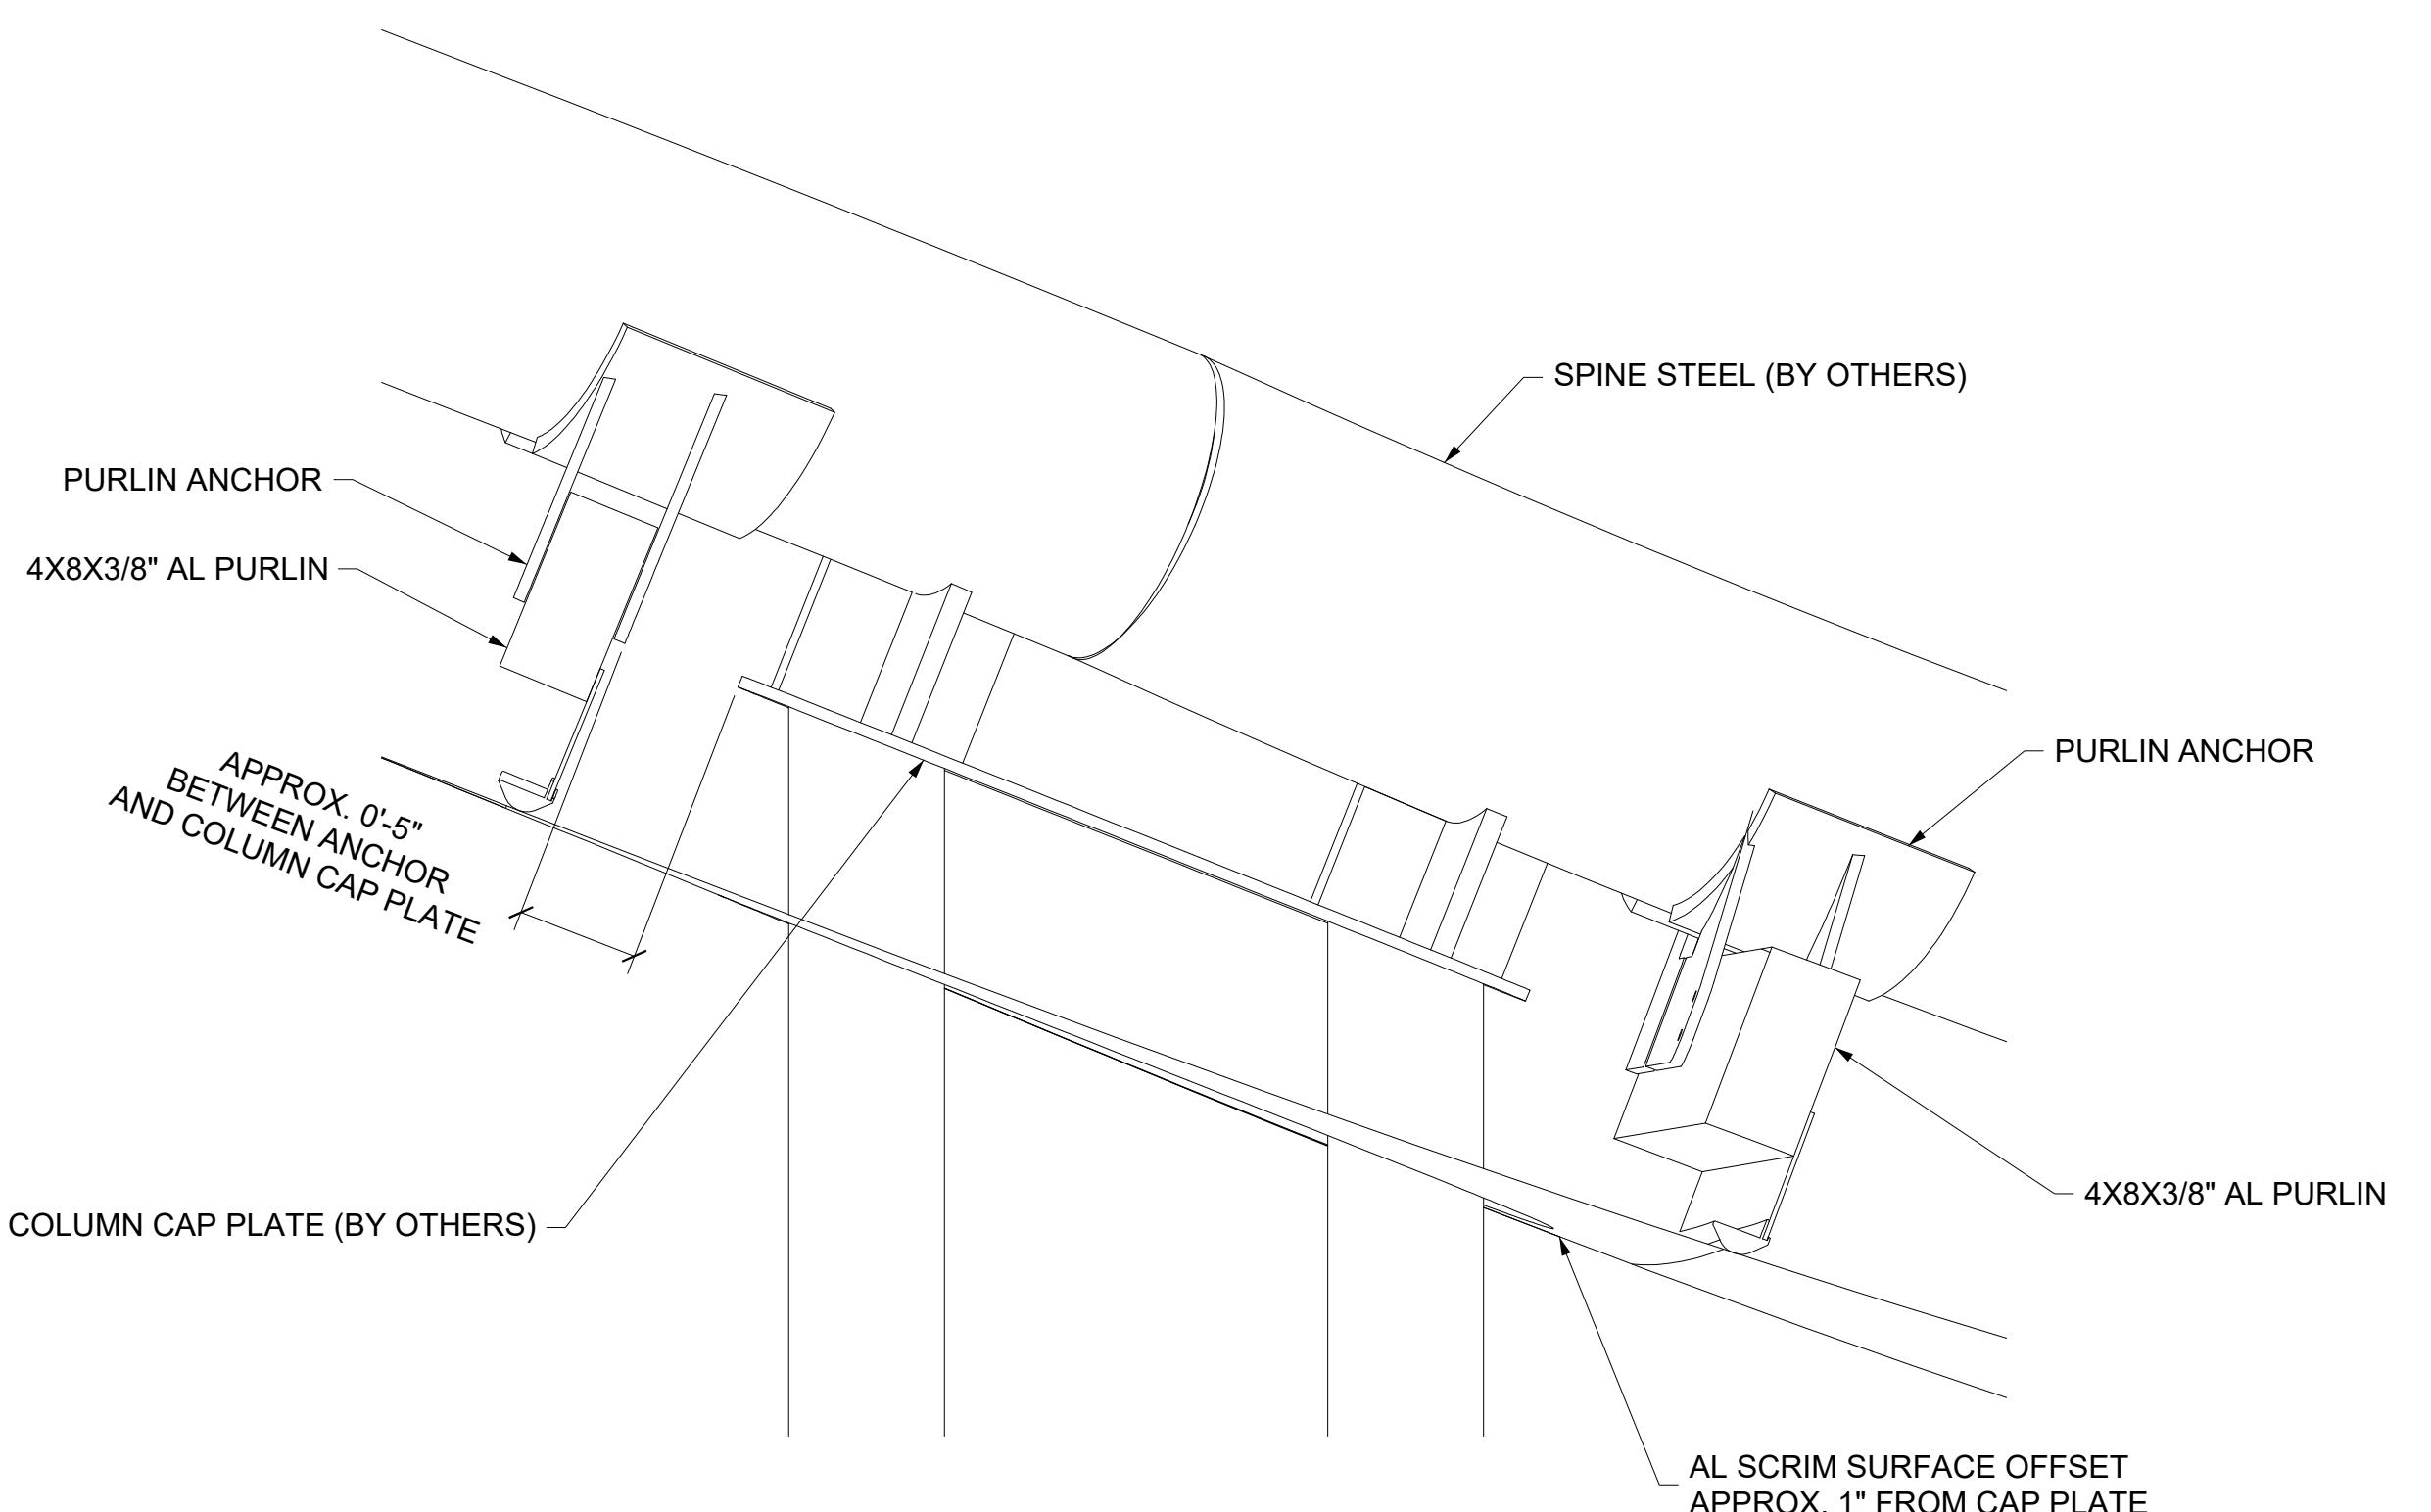

② CANOPY CROSS SECTION AT COLUMNS

SCALE: 1 1/2" = 1'-0"
ZAHNER REF: N/A
ARCH REF: N/A

SET ISSUE DATES		
DATE	ISSUE	
01/20/22 100% DRAWINGS		
REVISIONS		
NO.	DATE	DESCRIPTION

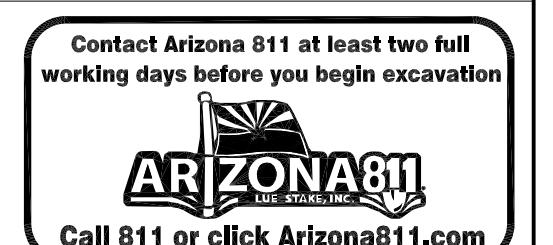

DATE: 01/20/2022		REVISION:	BY:
ENGINEER		PUBLIC WORKS	
		CITY OF SCOTTSDALE CAPITAL PROJECT MANAGEMENT	
		7447 E. INDIAN SCHOOL RD. SCOTTSDALE, ARIZONA 85251	
SHEET TITLE		SCOTTSDALE, ARIZONA	

360 CANOPY - CROSS SECTION AT WALKING PATH

PROJECT TITLE CITY OF SCOTTSDALE
CIVIC CENTER PLAZA

THIS SHEET SCALED FOR 24X36" BORDER	SCALE	DESIGNED	BID NO.	XC-D502
	DRAWN DS	AS-BUILT	COS PROJECT NO. DG04	