

DRAWING INDEX	
GENERAL DRAWINGS	
XC-001	COVER SHEET AND DRAWING INDEX
PLAN DRAWINGS	
XC-A101	EAST BOWL PLAN
XC-D101	360 PLAN VIEW
ELEVATIONS	
XC-A201	EAST BOWL WEST ELEVATION
DETAILS	
XC-A501	EAST BOWL - SECTION & DETAILS @ CANOPY ROOF
XC-A502	EAST BOWL - WING WALL PLAN DETAILS
XC-A503	EAST BOWL - WING WALL ZEPP DETAILS
XC-A504	EAST BOWL - TYP ZEPP DETAILS
XC-A505	EAST BOWL - BACK KNIFE EDGE DETAIL
XC-A506	EAST BOWL - ANCHOR DETAILS
XC-D501	360 - TYPICAL CANOPY CROSS SECTION & DETAILS
XC-D502	360 - CANOPY CROSS SECTION AT WALKING PATH

RITOCH-POWELL
RPA & Associates
602-263-1177
WWW.RPAENG.COM


LAKE | FLATO
© 2021 Lake|Flato Architects, Inc.
311 THIRD STREET
SAN ANTONIO, TEXAS 78205
P 210.227.3335 F 210.224.9515
www.lakeflato.com

PROTECTED
BY
DRAFTING

ZAHNER
ARCHITECTURAL METAL
1400 EAST NINTH STREET
KANSAS CITY, MO 64106
TEL: (816) 474-8882
FAX: (816) 474-7994
WWW.AZAHNER.COM


CITY OF SCOTTSDALE CIVIC CENTER PLAZA

SET ISSUE DATES		
DATE	ISSUE	
01/20/22 100% DRAWINGS		

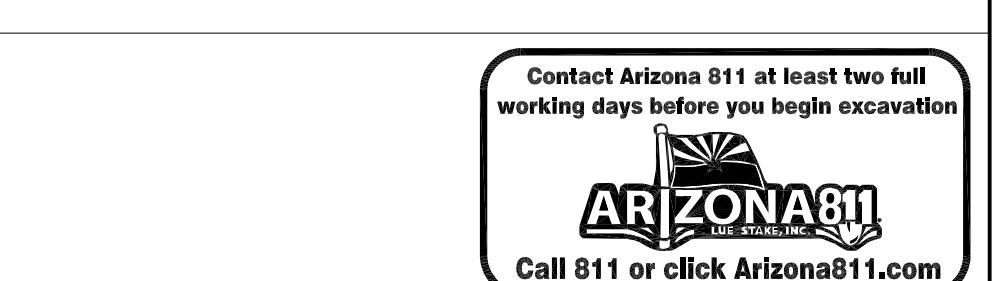

DATE: 01/20/2022	REVISION:	BY:
ENGINEER		PUBLIC WORKS
		CAPITAL PROJECT MANAGEMENT
		7447 E. INDIAN SCHOOL RD. SCOTTSDALE, ARIZONA 85251
SHEET TITLE		

COVER SHEET AND DRAWING INDEX				
PROJECT TITLE				
CITY OF SCOTTSDALE CIVIC CENTER PLAZA				
THIS SHEET SCALED FOR 24X36" BORDER	SCALE	DESIGNED	BID NO.	XC-001
	DRAWN DS	AS-BUILT	COS PROJECT NO. DG04	

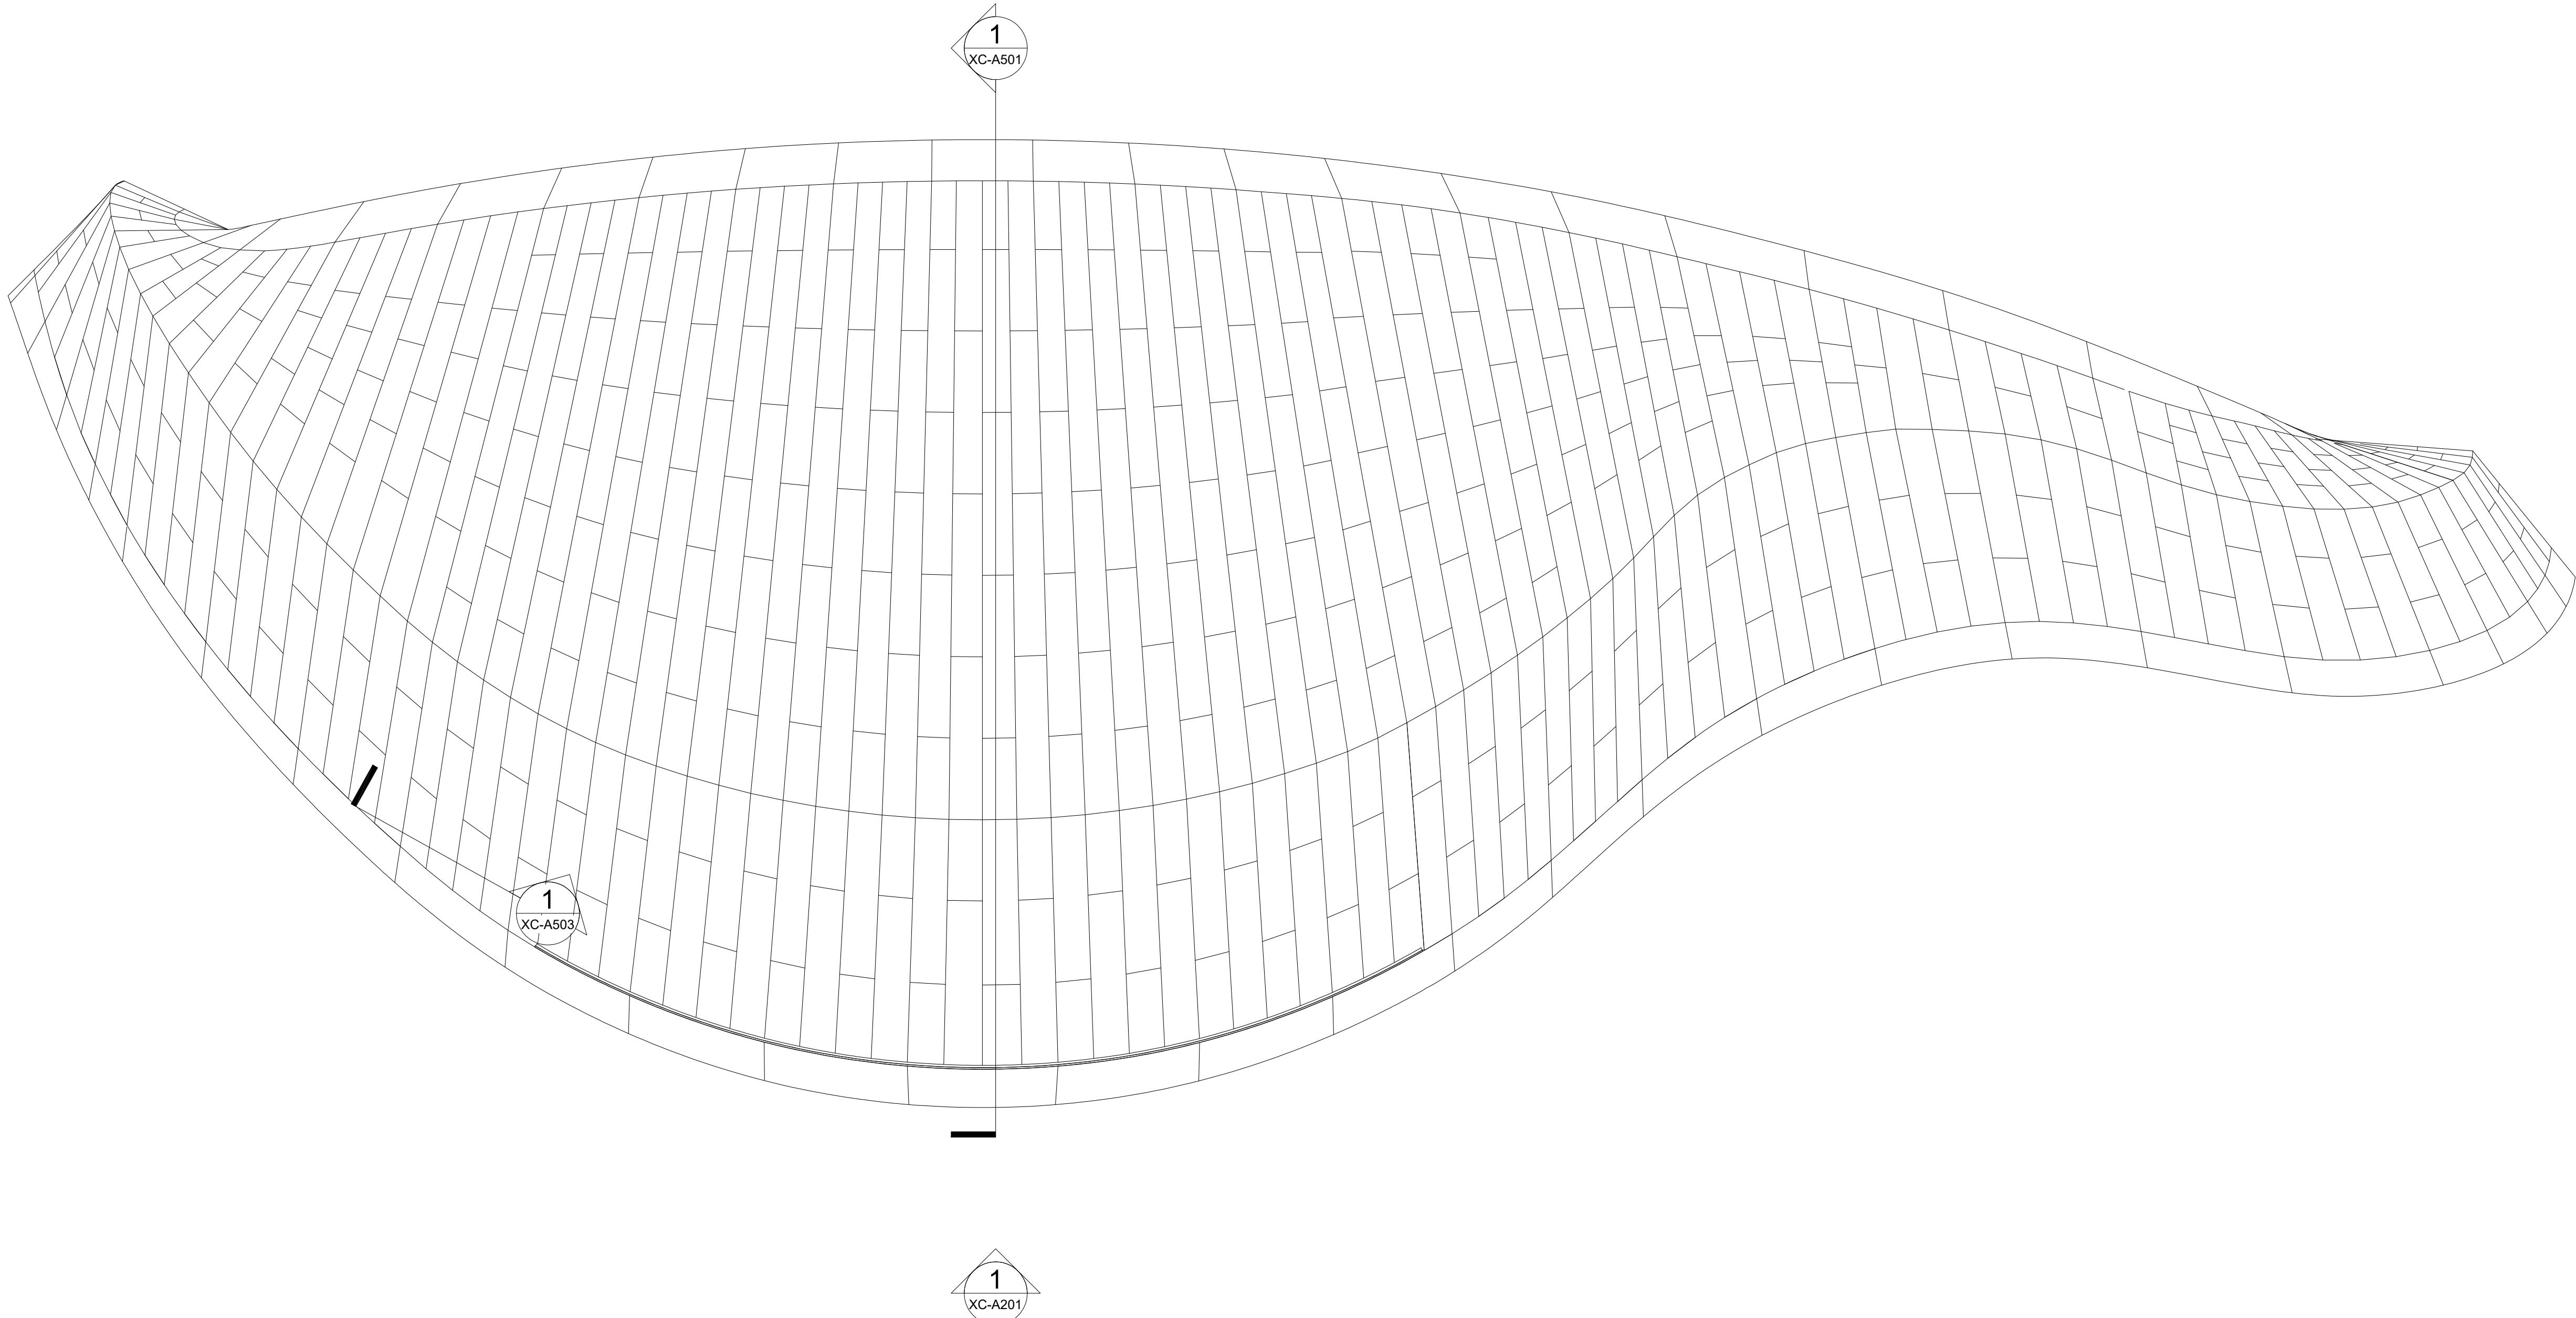


EAST BOWL PLAN VIEW

SCALE: 3/16" = 1'-0"

ZAHNER REF: N/A
ARCH REF: N/A

SET ISSUE DATES		
DATE	ISSUE	
01/20/22 100% DRAWINGS		
<hr/>		

REVISIONS		
NO.	DATE	DESCRIPTION
<hr/>	<hr/>	<hr/>

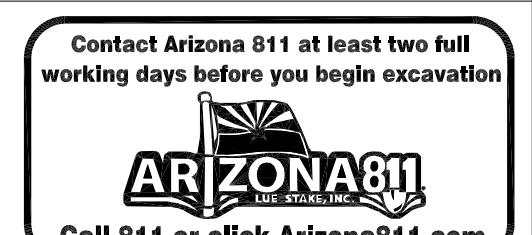

DATE: 01/20/2022		REVISION:	BY:
ENGINEER	PUBLIC WORKS		
	CITY OF SCOTTSDALE CAPITAL PROJECT MANAGEMENT		
SHEET TITLE		7447 E. INDIAN SCHOOL RD., SCOTTSDALE, ARIZONA 85251	

EAST BOWL PLAN

PROJECT TITLE		CITY OF SCOTTSDALE CIVIC CENTER PLAZA	
---------------	--	--	--


THIS SHEET SCALED FOR 24X36" BORDER	SCALE	DESIGNED	BID NO.	XC-A101
	DRAWN DS	AS-BUILT	COS PROJECT NO. DG04	



ARCHITECTS INC.




311 THIRD STREET
SAN ANTONIO, TEXAS 78205
P 210.227.3335 F 210.224.9515
www.lakeflato.com

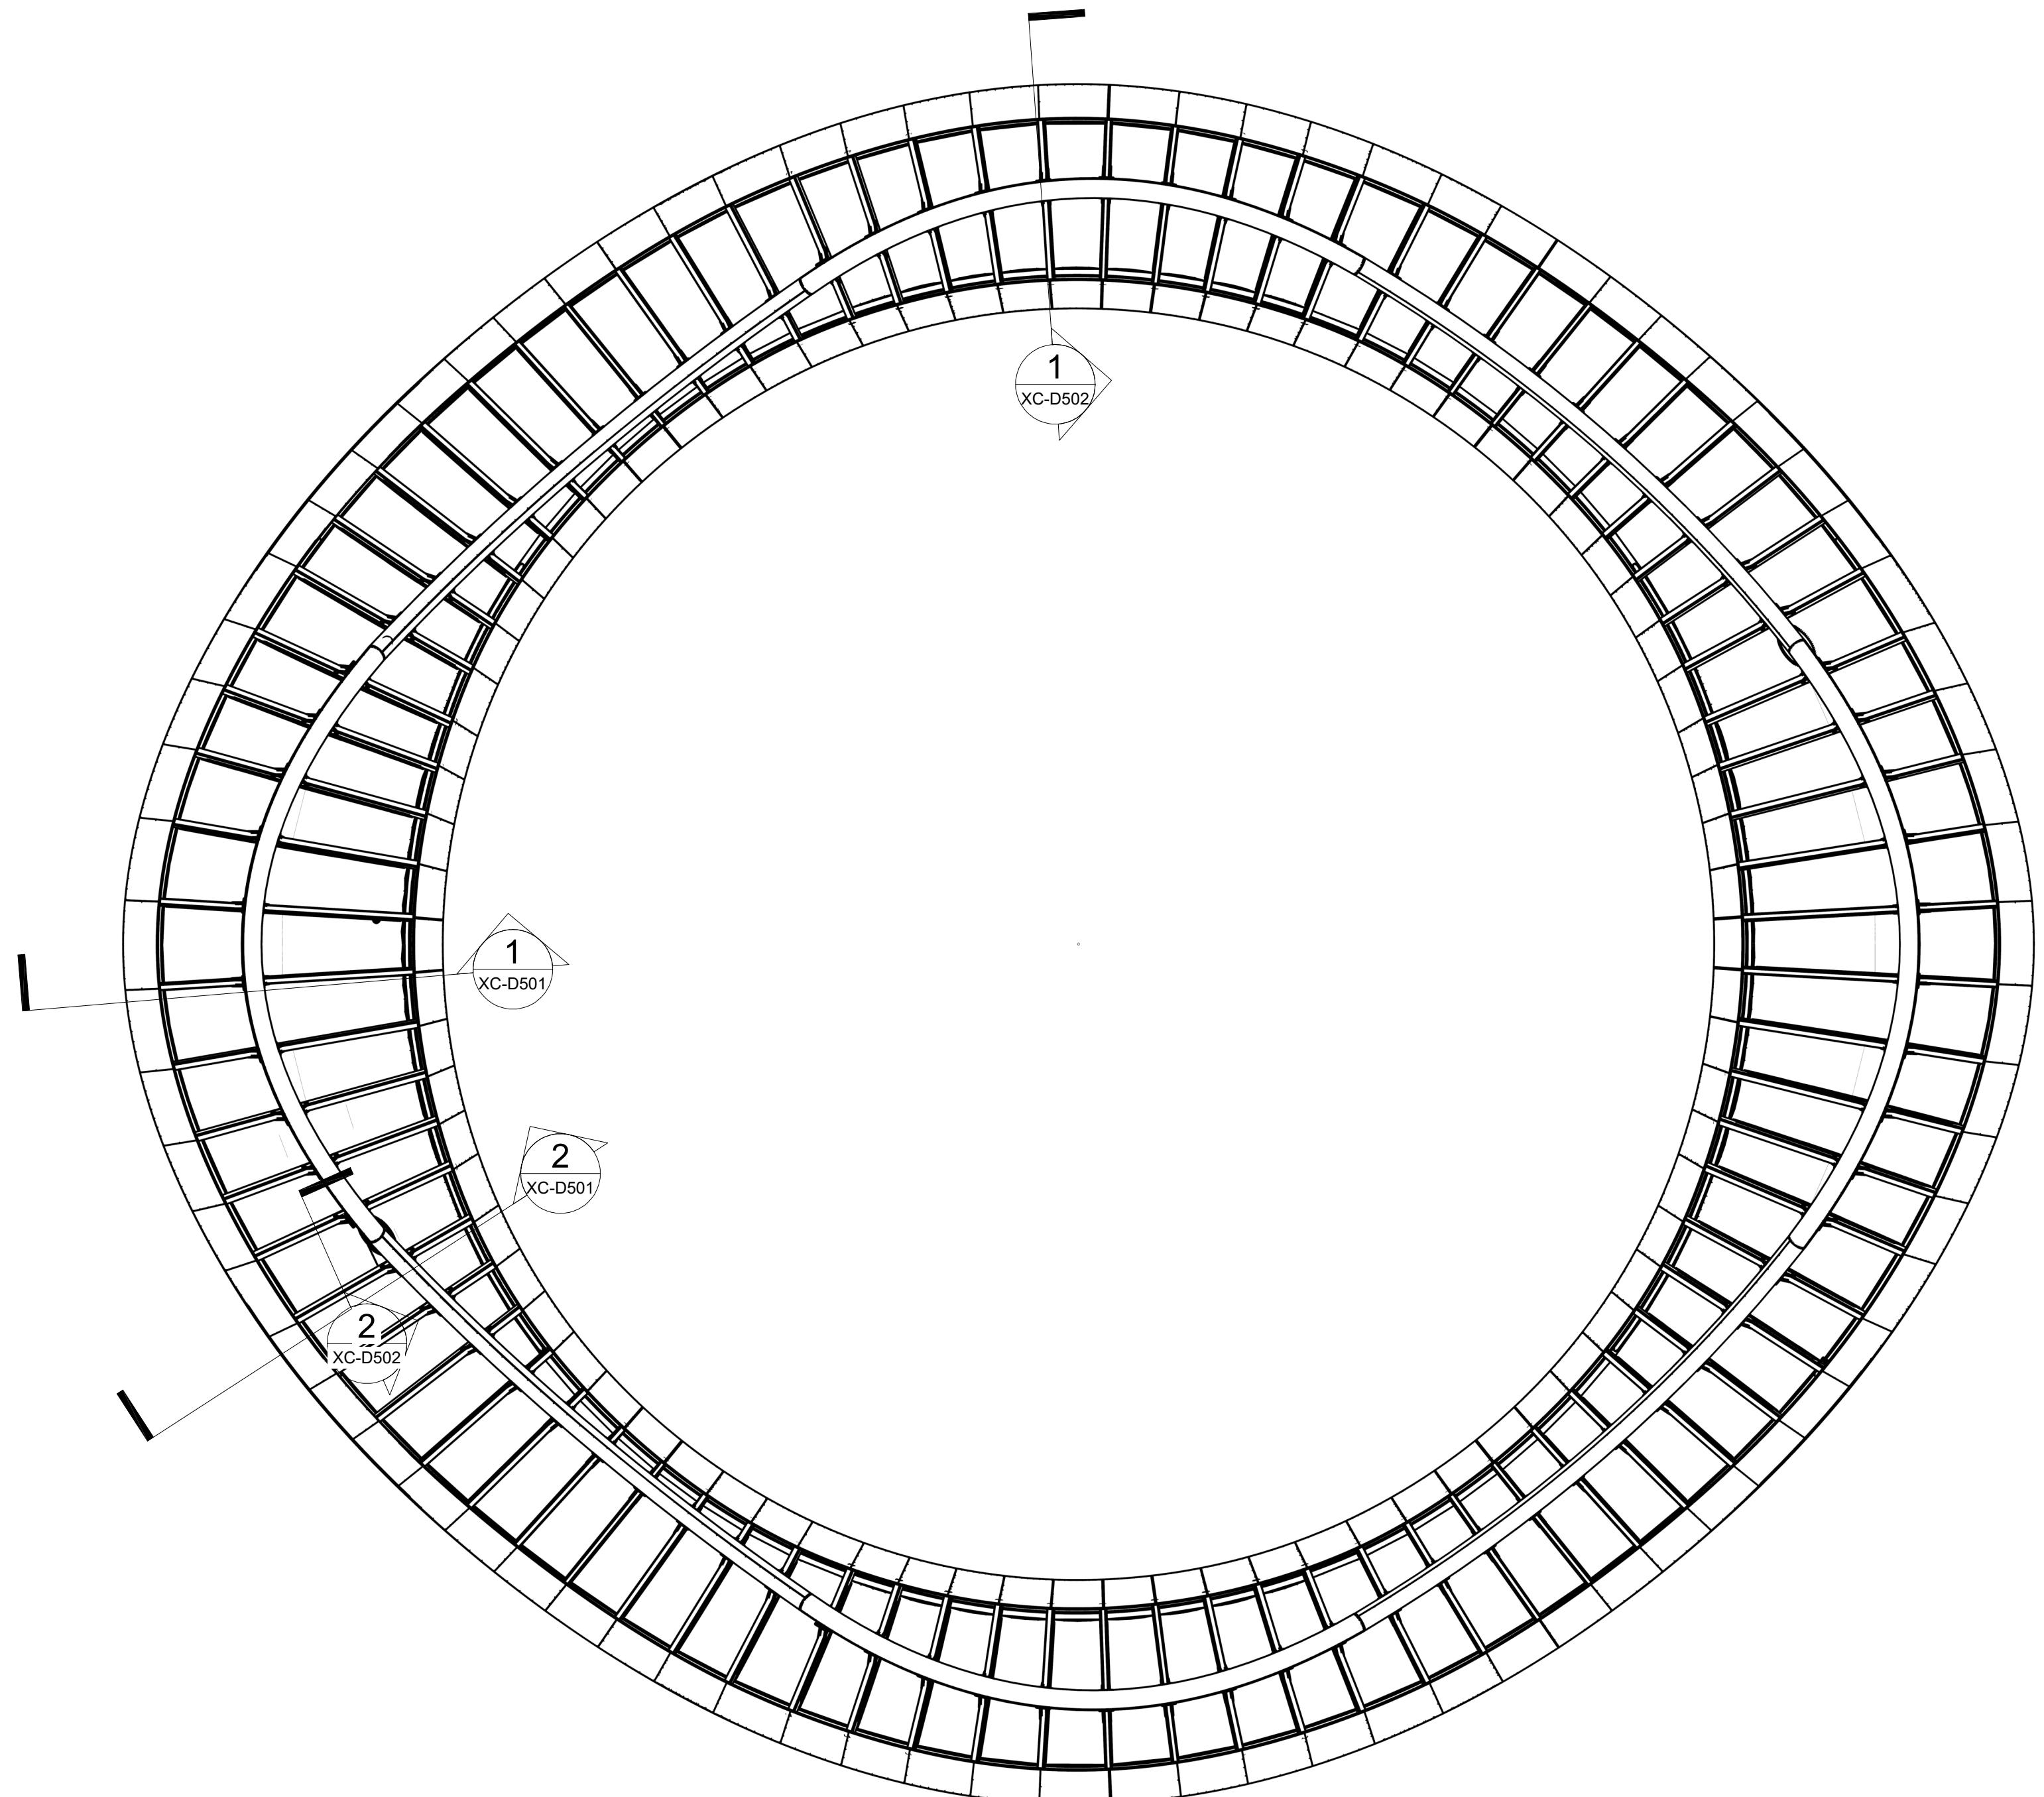

1 360 CANOPY - PLAN VIEW


SCALE: 1/8" = 1'-0" ZA

ZAHNER REF: XX
ARCH REF: XX

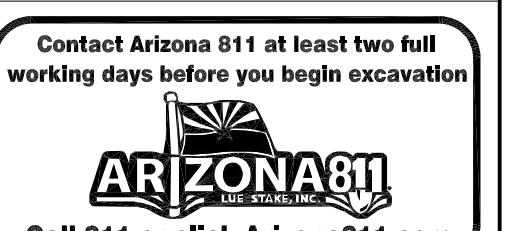

[View Details](#)

74

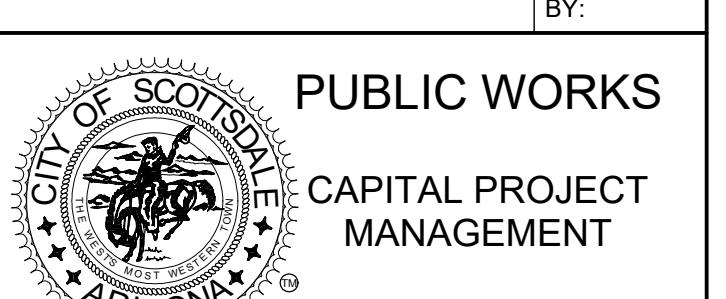

PUBLIC WORKS


CAPITAL PROJECT MANAGEMENT

447 E. INDIAN SCHOOL RD.
COTTSDALE, ARIZONA 85251

447 E. INDIAN SCHOOL RD.
COTTSDALE, ARIZONA 85251

360 CANOPY PLAN

PROJECT TITLE	CITY OF SCOTTSDALE CIVIC CENTER PLAZA			
D R	SCALE	DESIGNED		BID NO.
	DRAWN DS	AS-BUILT	COS PROJECT NO. DCM	

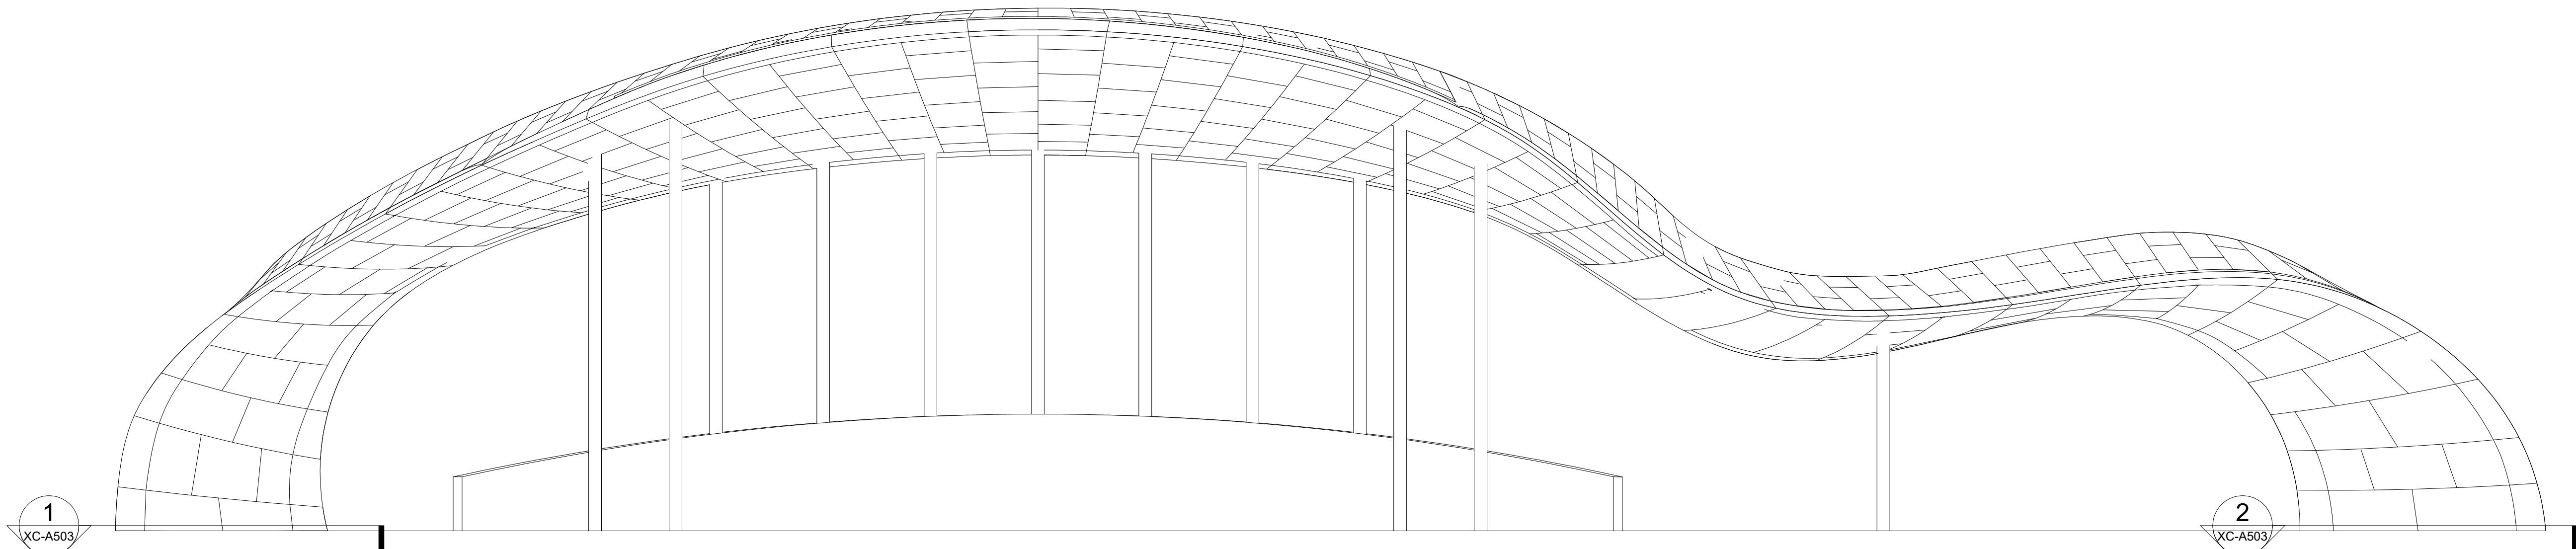


① EAST BOWL WEST ELEVATION
SCALE: 3/16" = 1'-0"
ZAHNER REF: N/A
ARCH REF: N/A

SET ISSUE DATES		
DATE	ISSUE	BY:
01/20/22 100% DRAWINGS		
REVISIONS		
NO.	DATE	DESCRIPTION
Contact Arizona 811 at least two full working days before you begin excavation		
 Call 811 or click Arizona811.com		

DATE: 01/20/2022	REVISION:	BY:
ENGINEER		PUBLIC WORKS
		CAPITAL PROJECT MANAGEMENT
SHEET TITLE		
CITY OF SCOTTSDALE CIVIC CENTER PLAZA		

PROJECT TITLE		CITY OF SCOTTSDALE CIVIC CENTER PLAZA	
THIS SHEET SCALED FOR 24X36" BORDER		SCALE	DESIGNED
		DRAWN DS	AS-BUILT
		COS PROJECT NO. DG04	

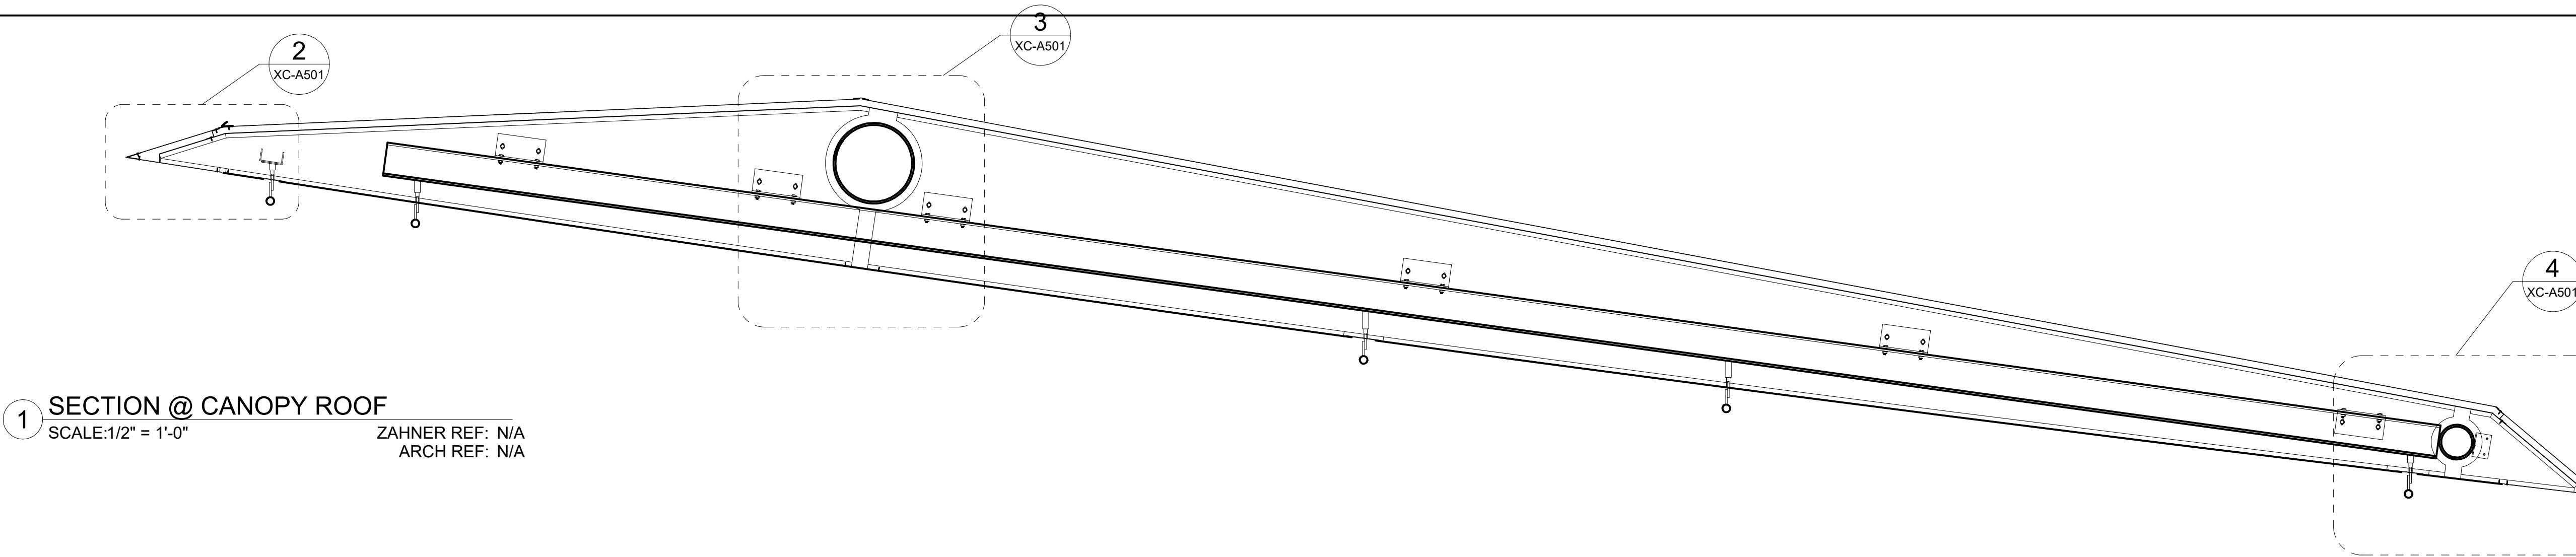


1 SECTION @ CANOPY ROOF

SCALE: 1/2" = 1'-0"
 ZAHNER REF: N/A
 ARCH REF: N/A


2 SECTION DETAIL @ DOWNSTAGE CANOPY

SCALE: 1 1/2" = 1'-0"
 ZAHNER REF: N/A
 ARCH REF: N/A

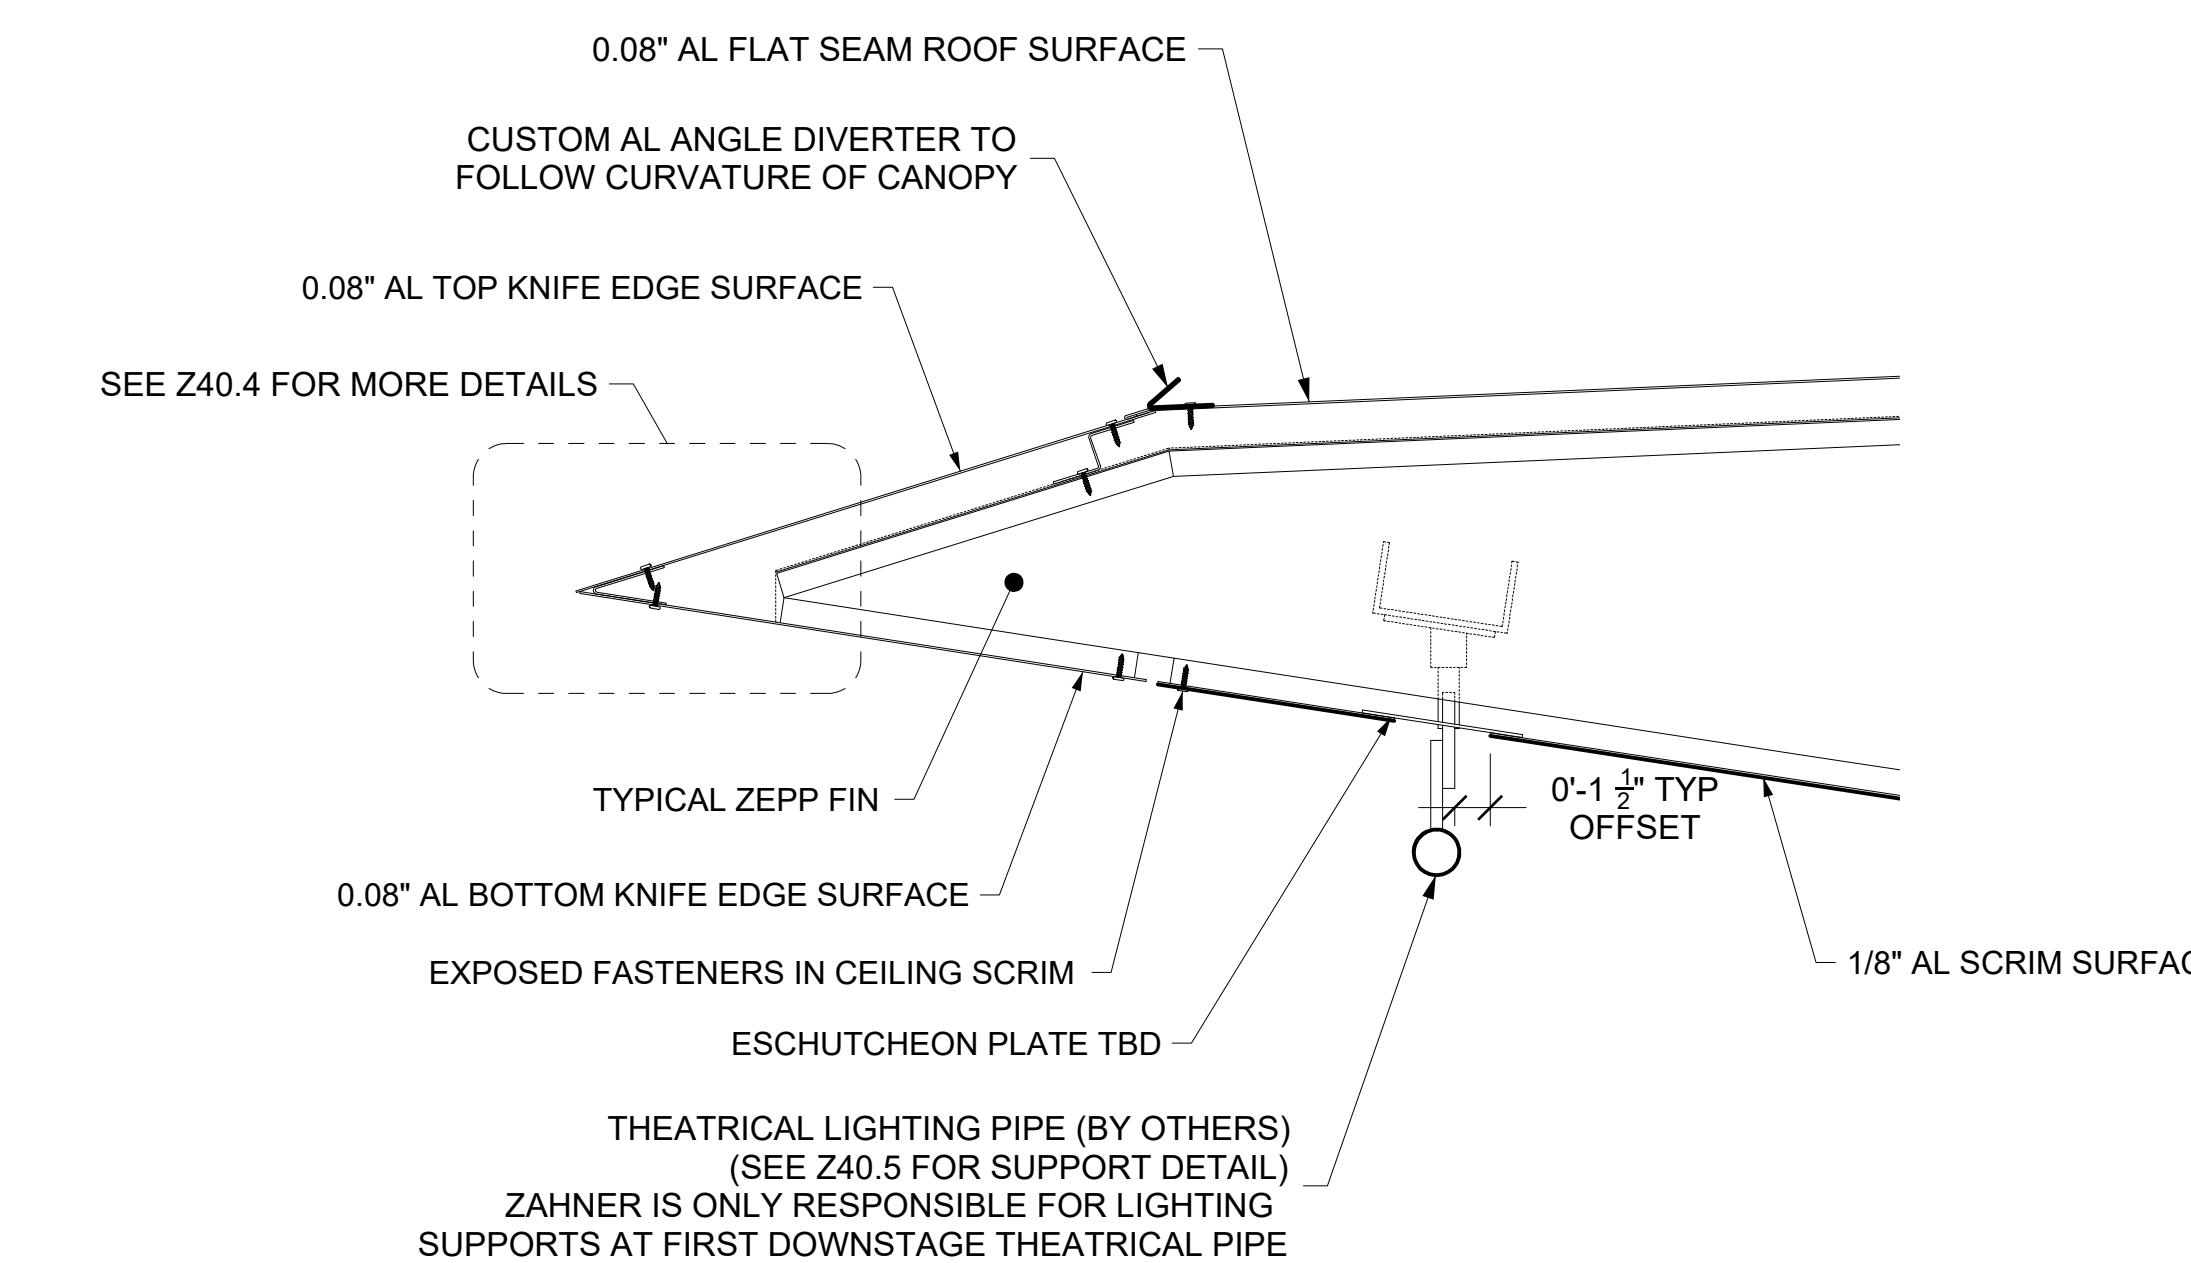


3 SECTION DETAIL @ DOWNSTAGE CANOPY

SCALE: 1 1/2" = 1'-0"
 ZAHNER REF: N/A
 ARCH REF: N/A

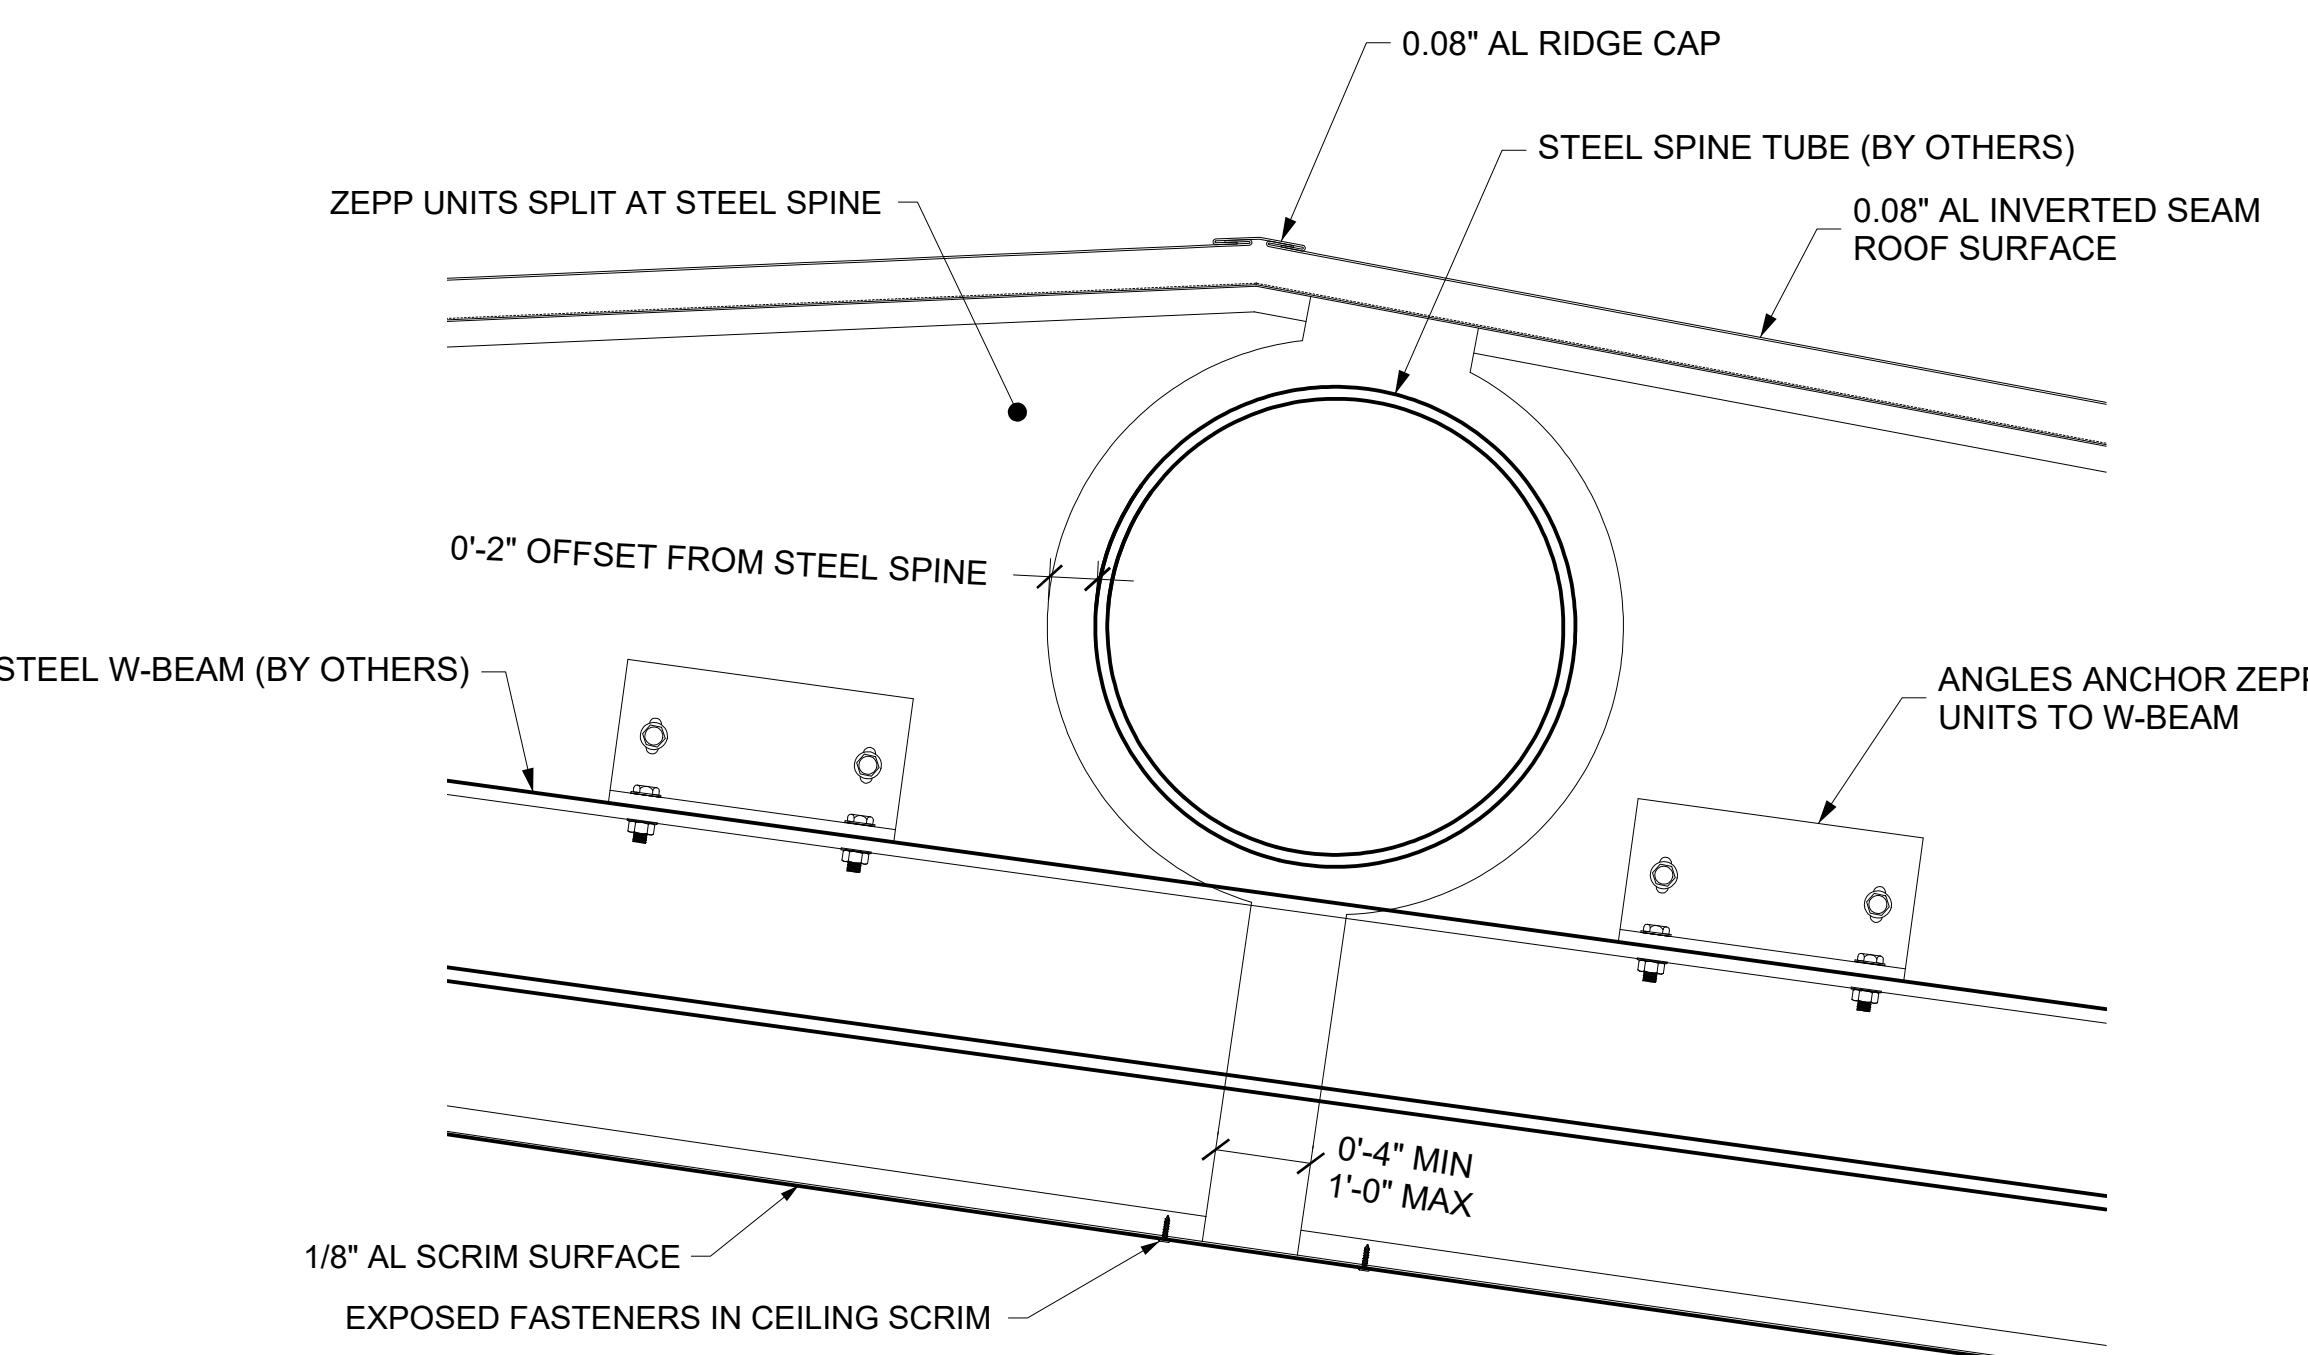

3 SECTION DETAIL @ DOWNSTAGE CANOPY

SCALE: 1 1/2" = 1'-0"
 ZAHNER REF: N/A
 ARCH REF: N/A

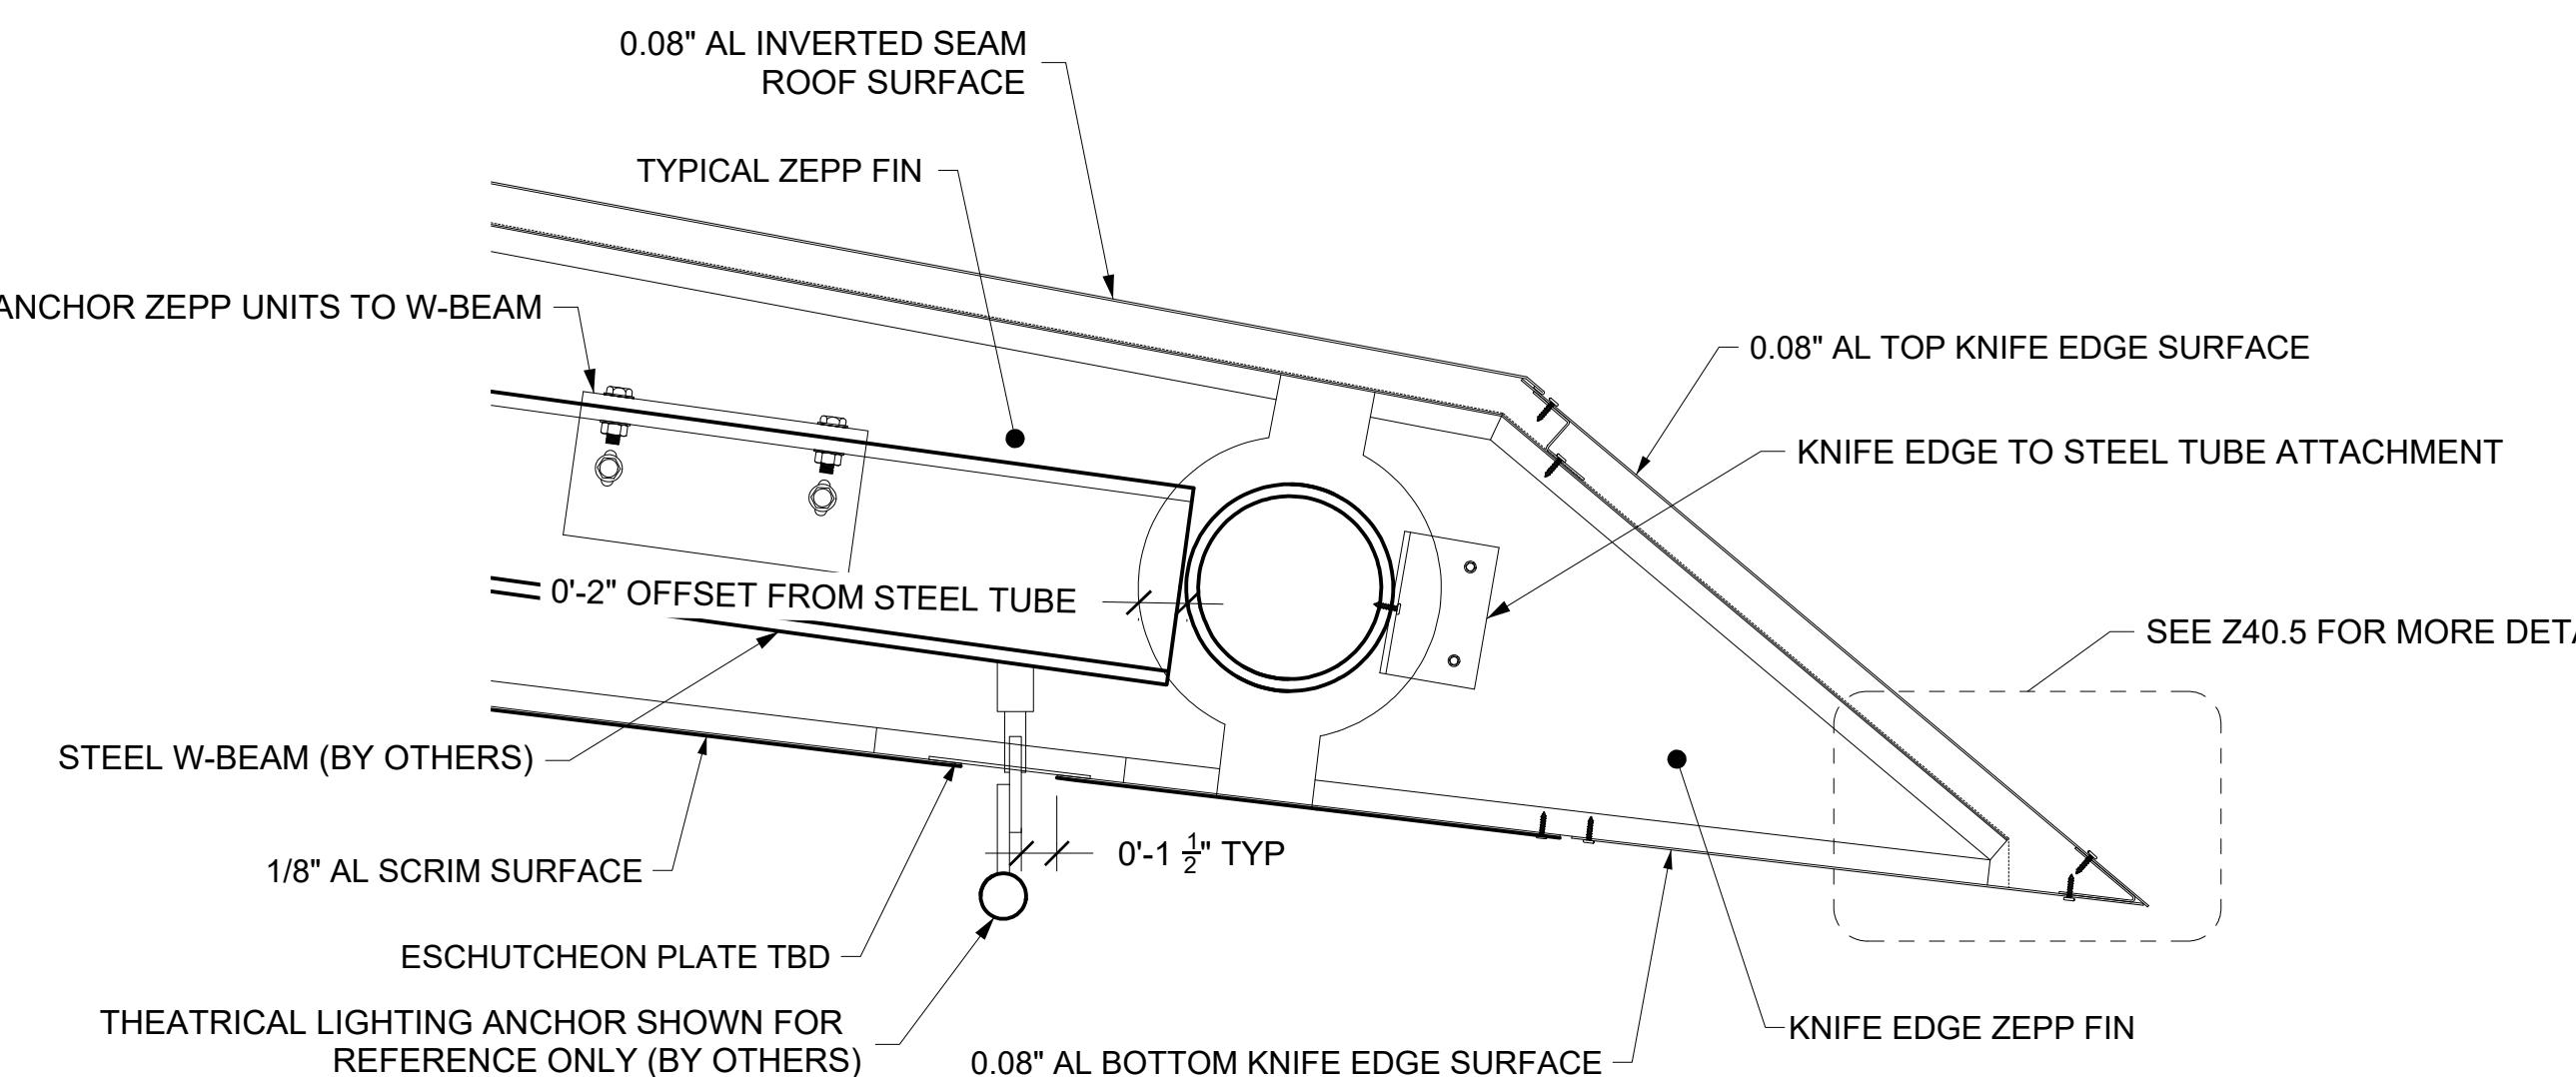

4 SECTION DETAIL @ UPSTAGE CANOPY

SCALE: 1 1/2" = 1'-0"
 ZAHNER REF: N/A
 ARCH REF: N/A

SET ISSUE DATES
 DATE: ISSUE:
 01/20/22 100% DRAWINGS

REVISIONS

NO.	DATE	DESCRIPTION




DATE: 01/20/2022	REVISION:	BY:
ENGINEER		PUBLIC WORKS
		CAPITAL PROJECT MANAGEMENT
7447 E. INDIAN SCHOOL RD., SCOTTSDALE, ARIZONA 85251		
SHEET TITLE		


EAST BOWL - SECTION & DETAILS

PROJECT TITLE: CITY OF SCOTTSDALE CIVIC CENTER PLAZA


THIS SHEET SCALED FOR 24X36" BORDER	SCALE	DESIGNED	BID NO.	XC-A501
	DRAWN DS	AS-BUILT	COS PROJECT NO. DG04	

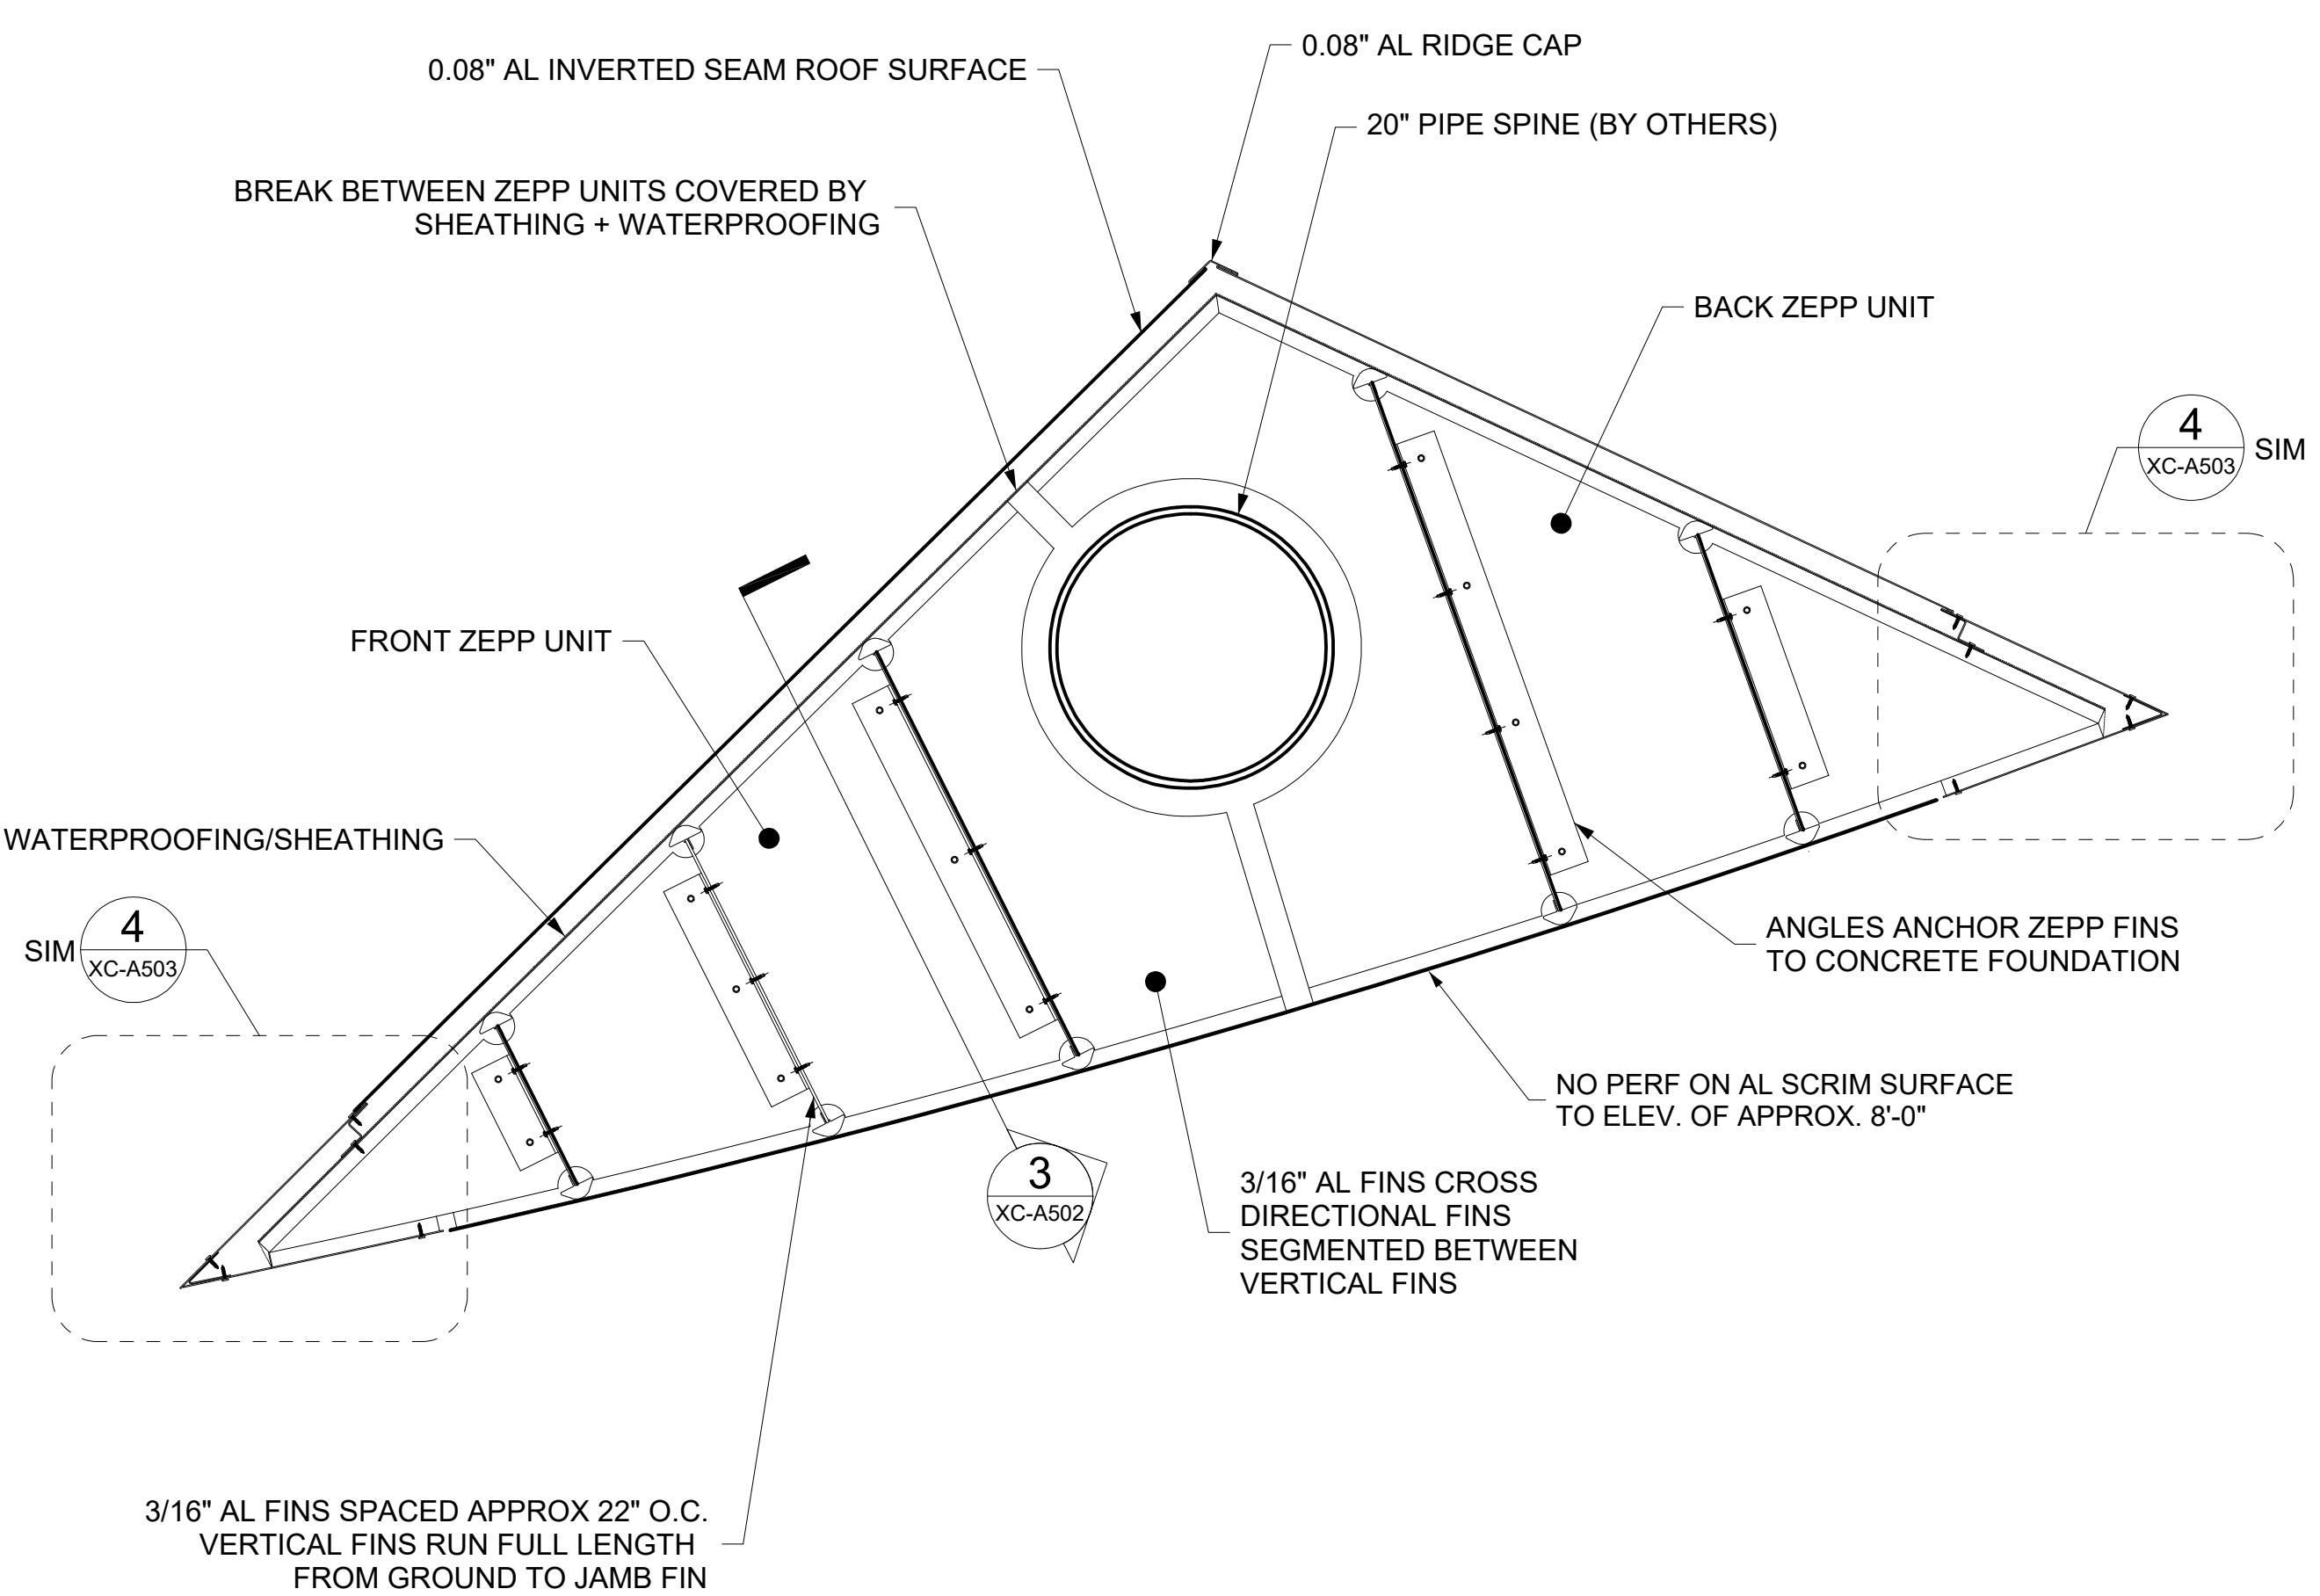

1 PLAN DETAIL @ NORTH WING WALL
SCALE: 1" = 1'-0"
ZAHNER REF: N/A
ARCH REF: N/A

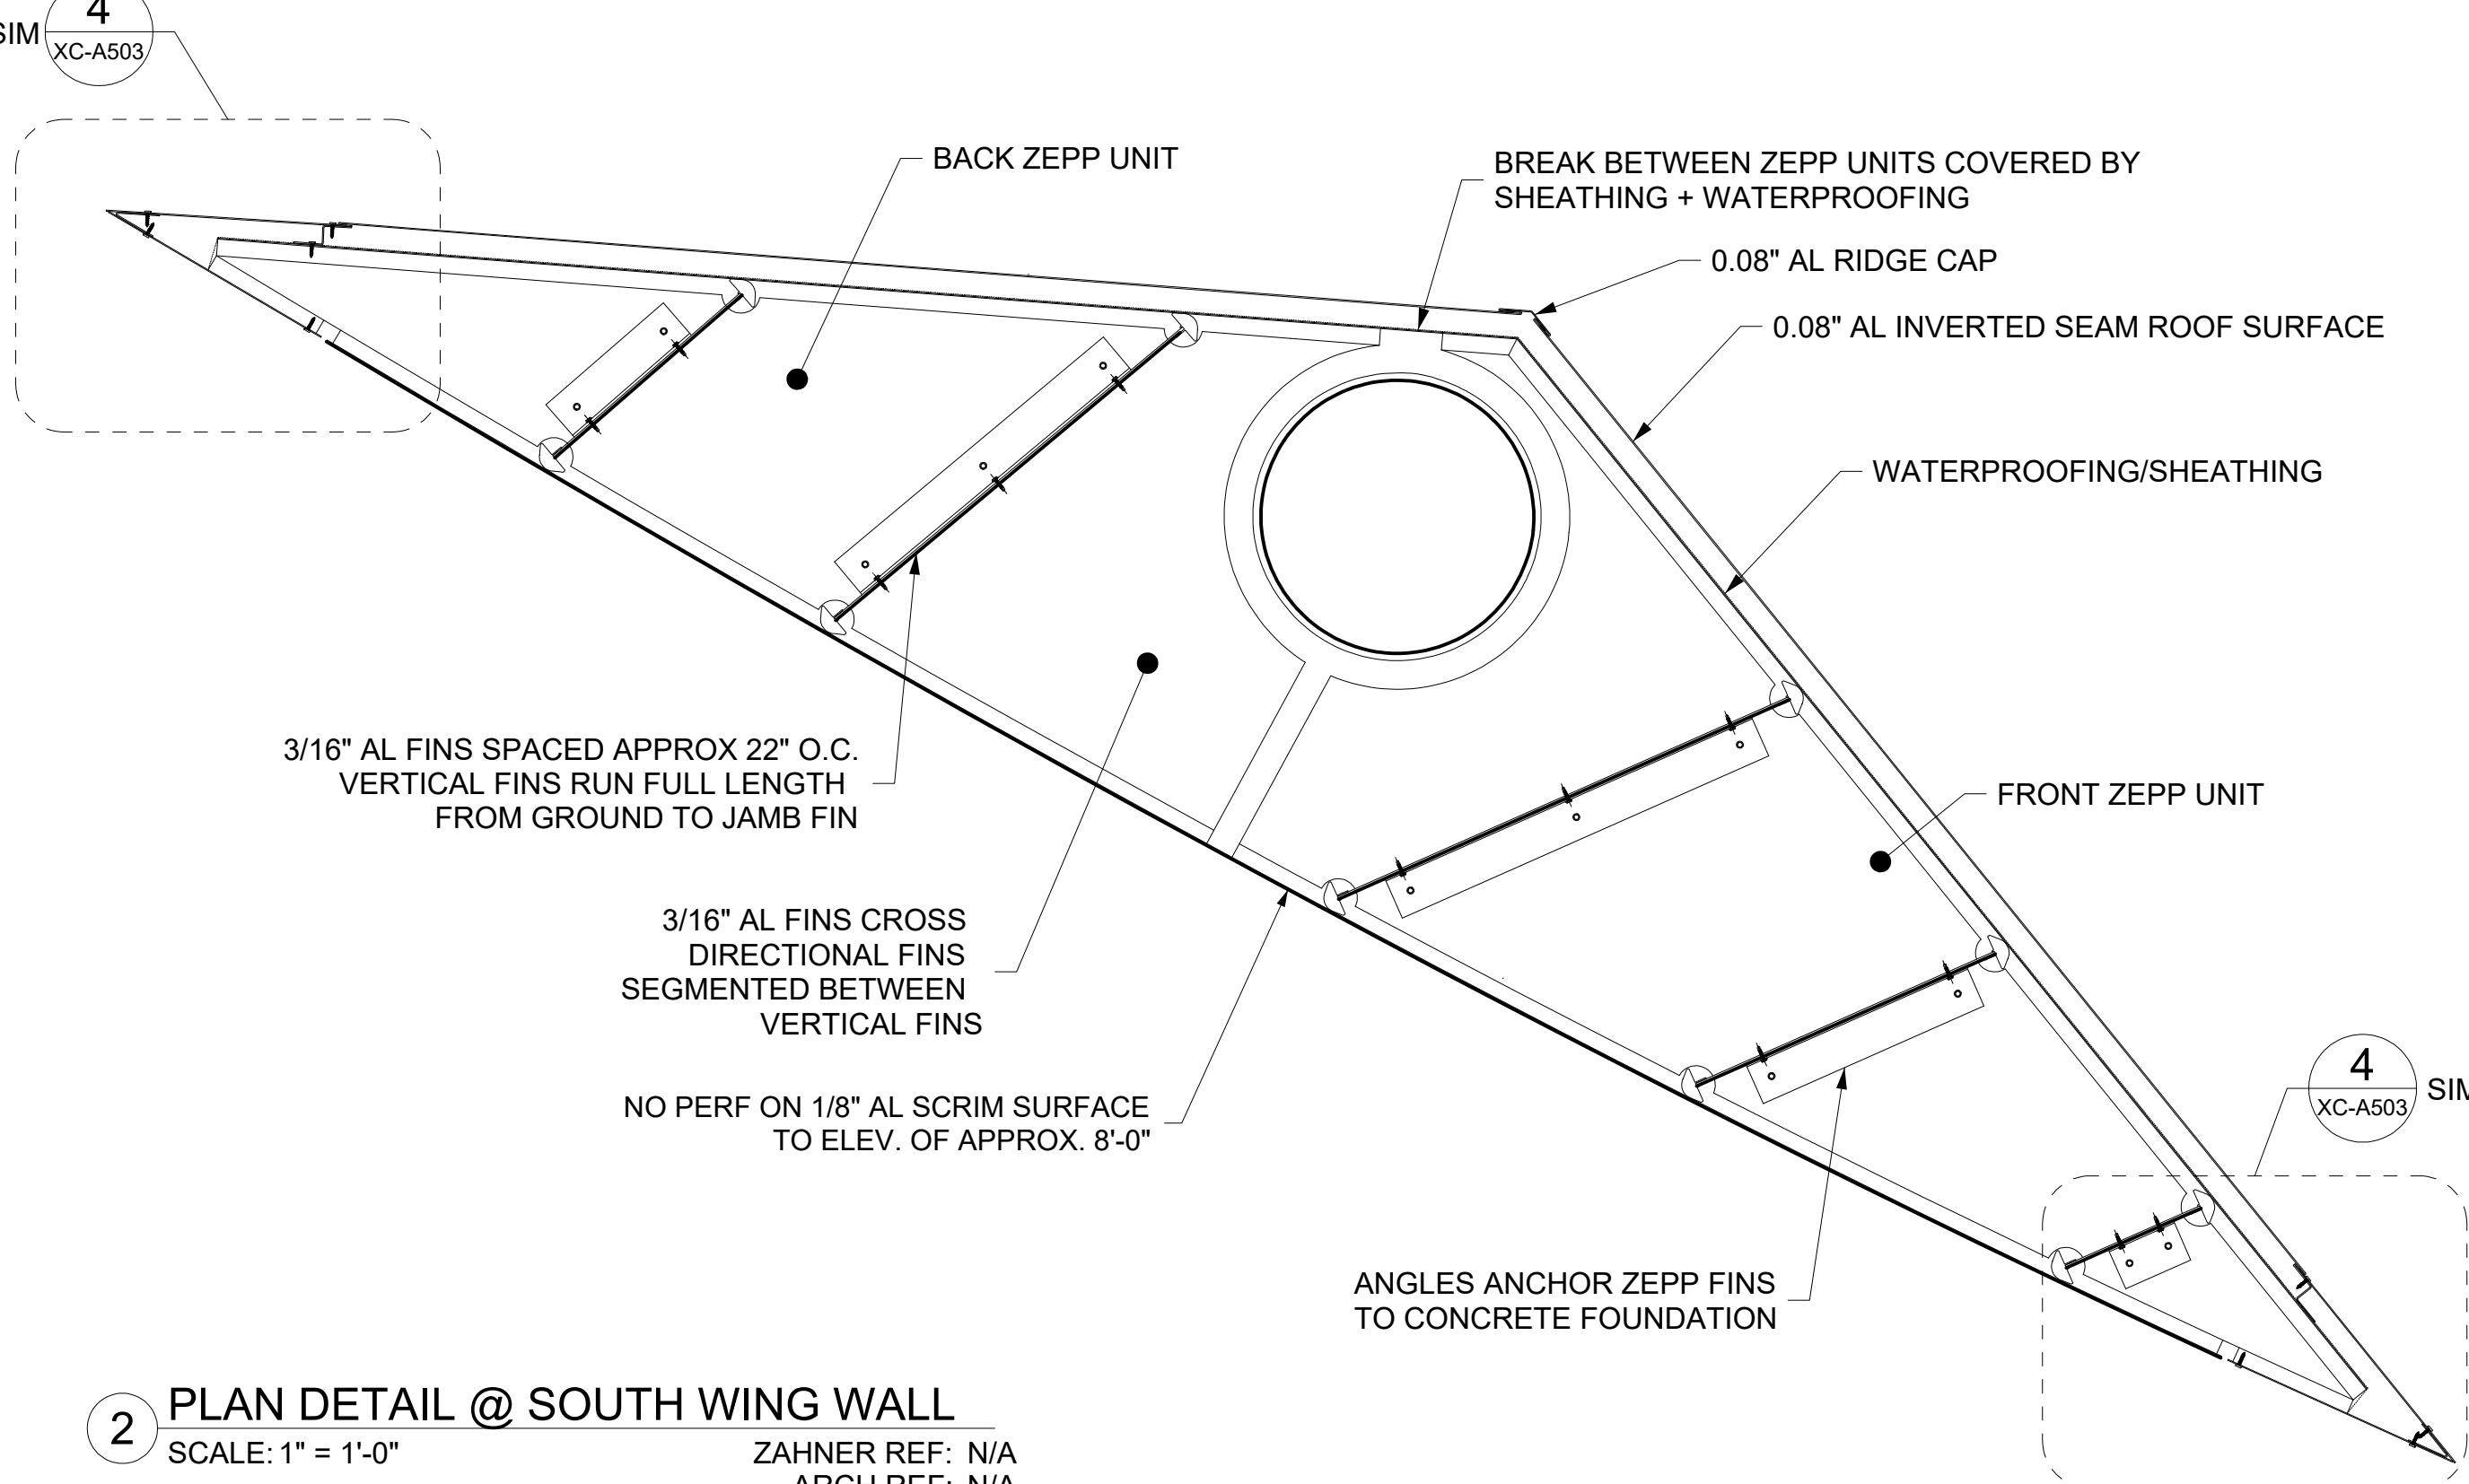


2 PLAN DETAIL @ SOUTH WING WALL
SCALE: 1" = 1'-0"
ZAHNER REF: N/A
ARCH REF: N/A

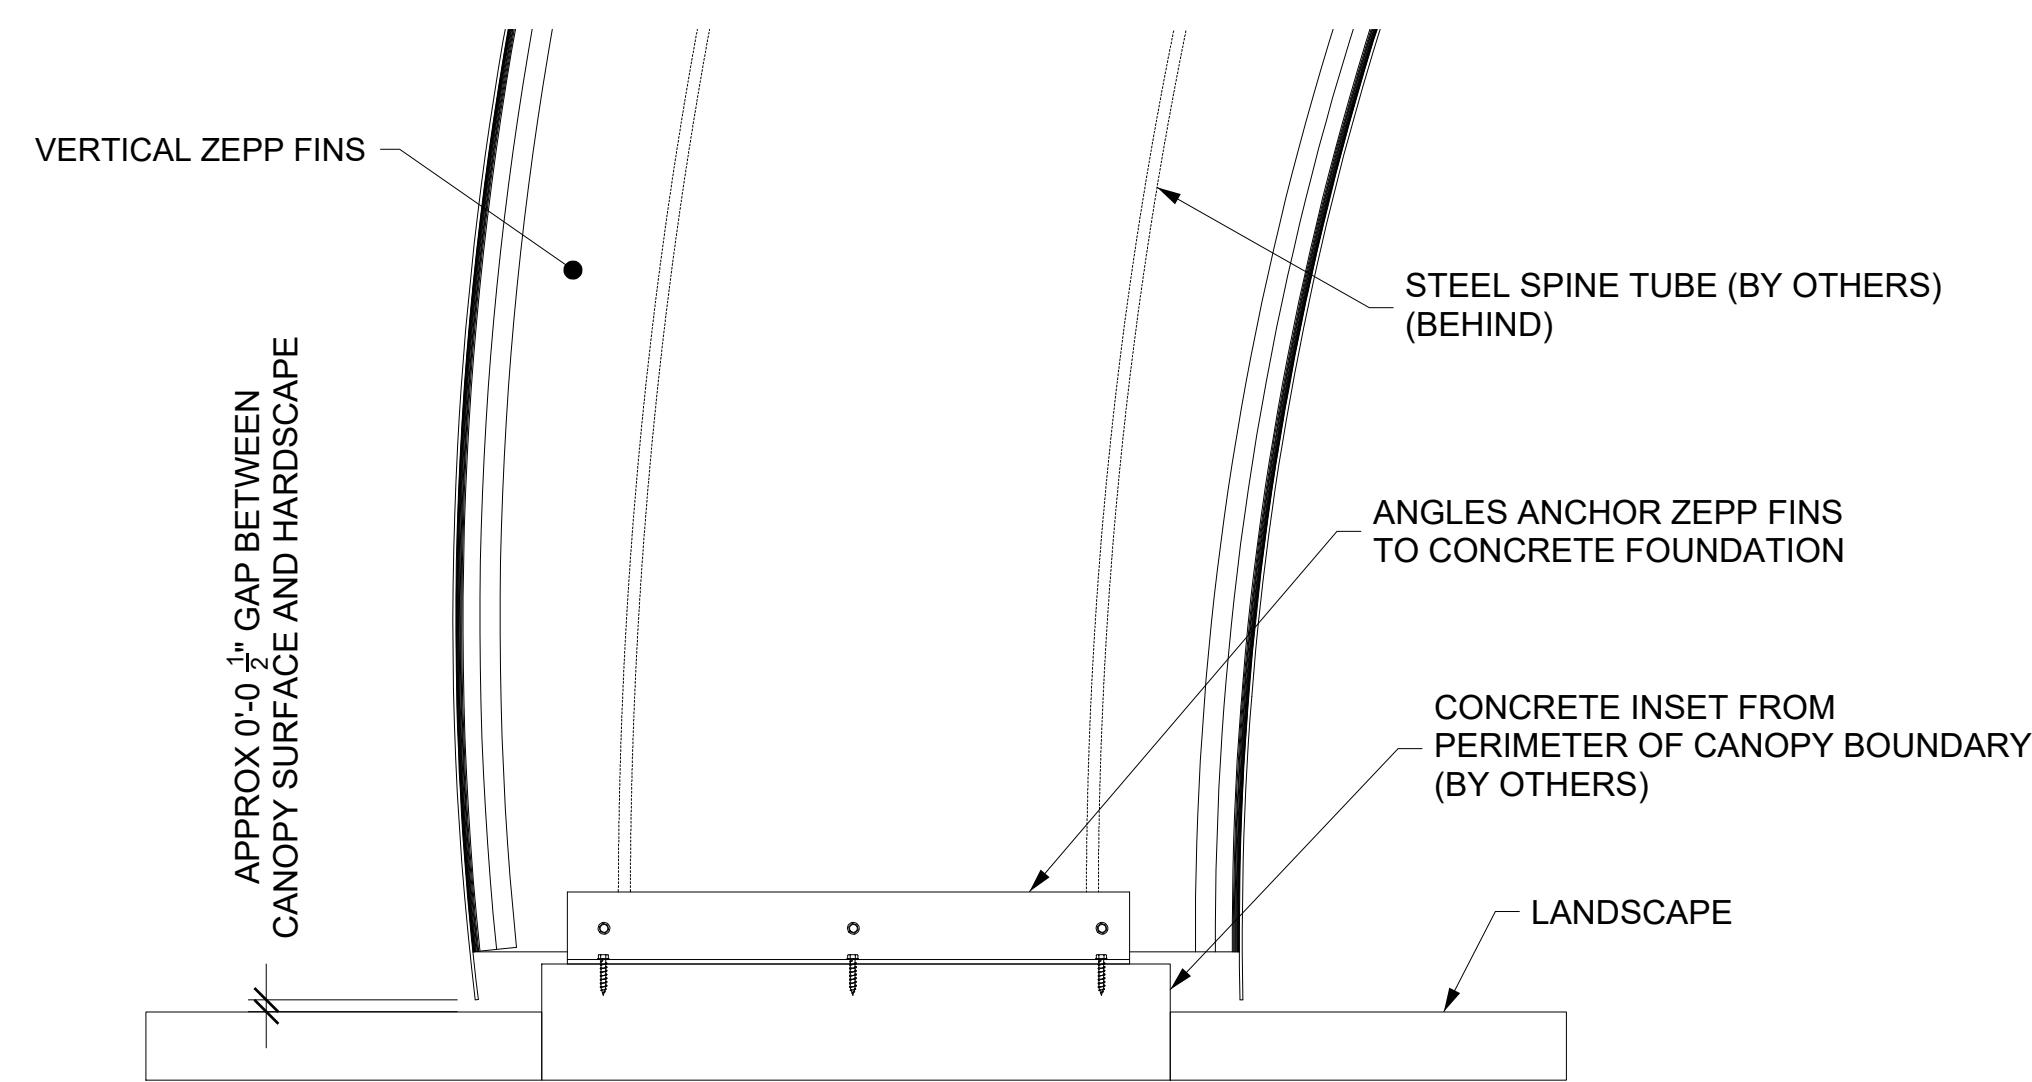

3 SECTION DETAIL @ NORTH WING WALL
SCALE: 1 1/2" = 1'-0"
ZAHNER REF: N/A
ARCH REF: N/A

SET ISSUE DATES		
DATE	ISSUE	
01/20/22 100% DRAWINGS		
REVISIONS		
NO.	DATE	DESCRIPTION

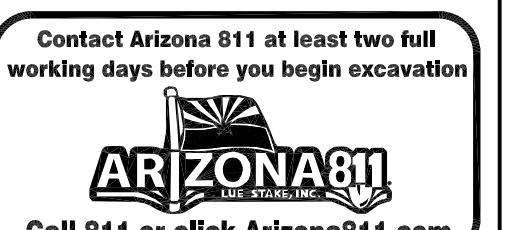


DATE: 01/20/2022	REVISION:	BY:
ENGINEER		PUBLIC WORKS
		CAPITAL PROJECT MANAGEMENT
7447 E. INDIAN SCHOOL RD., SCOTTSDALE, ARIZONA 85251		


EAST BOWL - WING WALL PLAN DETAILS

PROJECT TITLE: CITY OF SCOTTSDALE CIVIC CENTER PLAZA


THIS SHEET SCALED FOR 24X36" BORDER	SCALE	DESIGNED	BID NO.	XC-A502
	DRAWN DS	AS-BUILT	COS PROJECT NO. DG04	

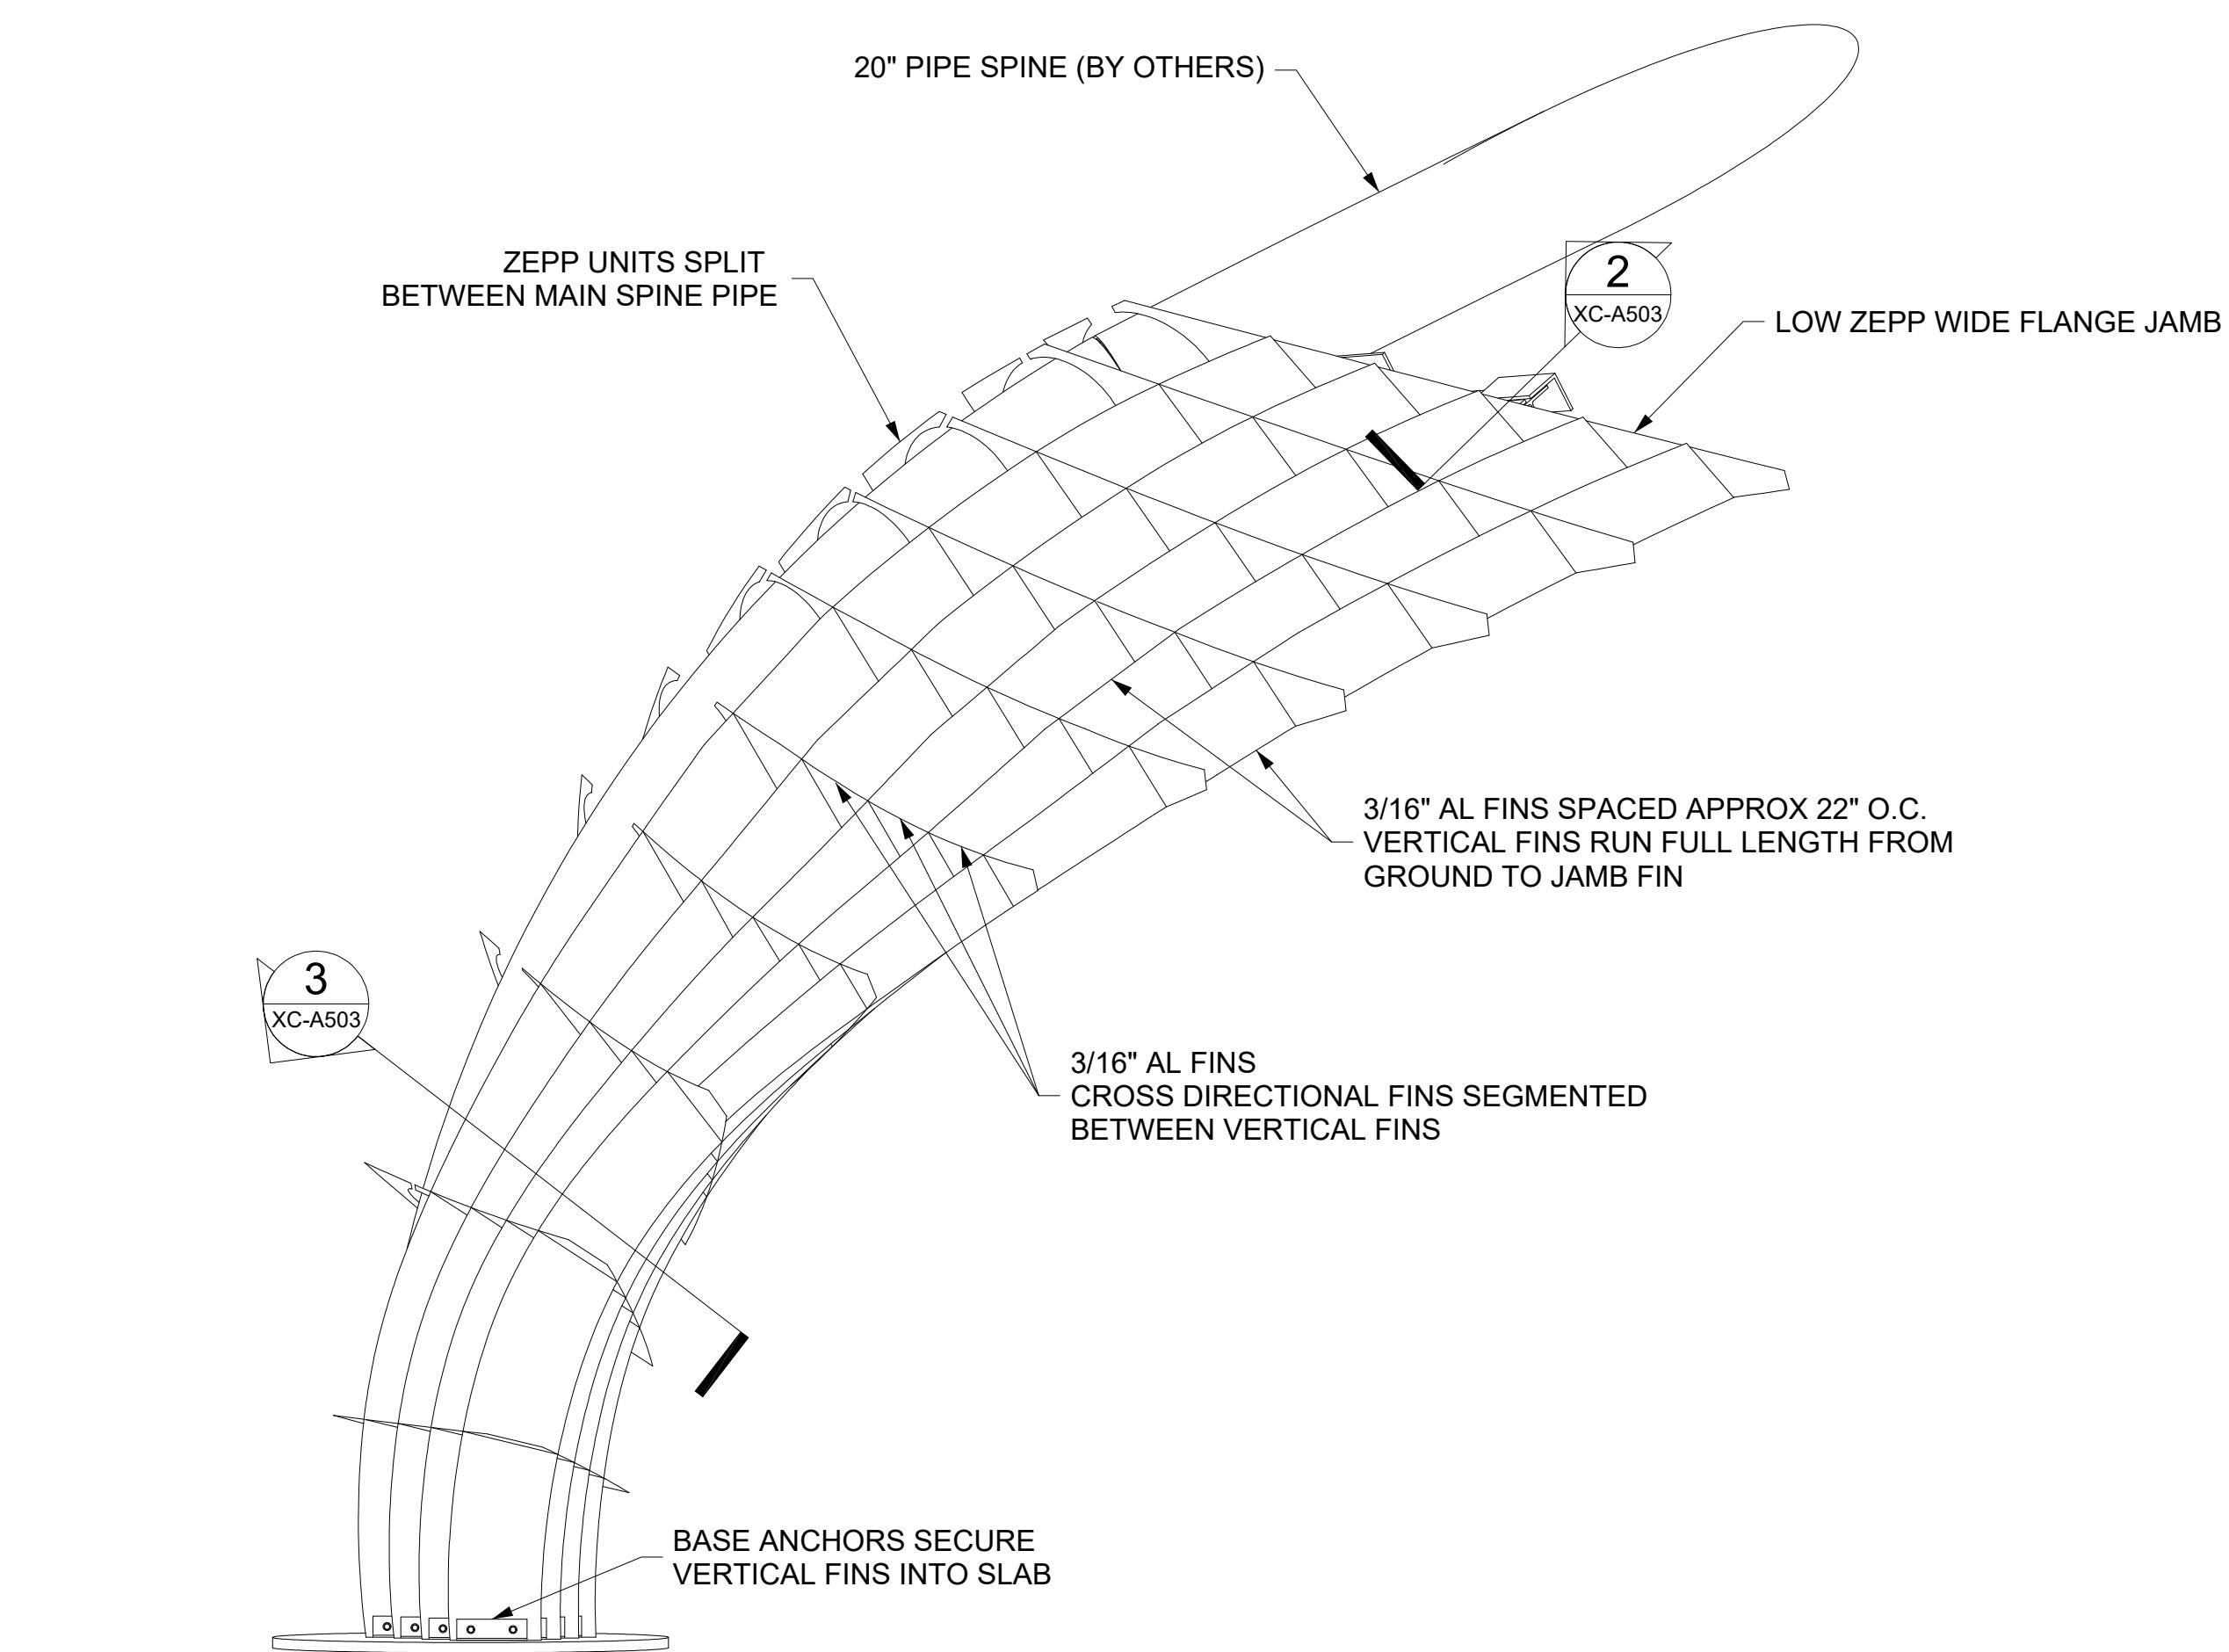


1 WING WALL ZEPP SUB STRUCTURE
 SCALE: 1/2" = 1'-0"
 ZAHNER REF: N/A
 ARCH REF: N/A

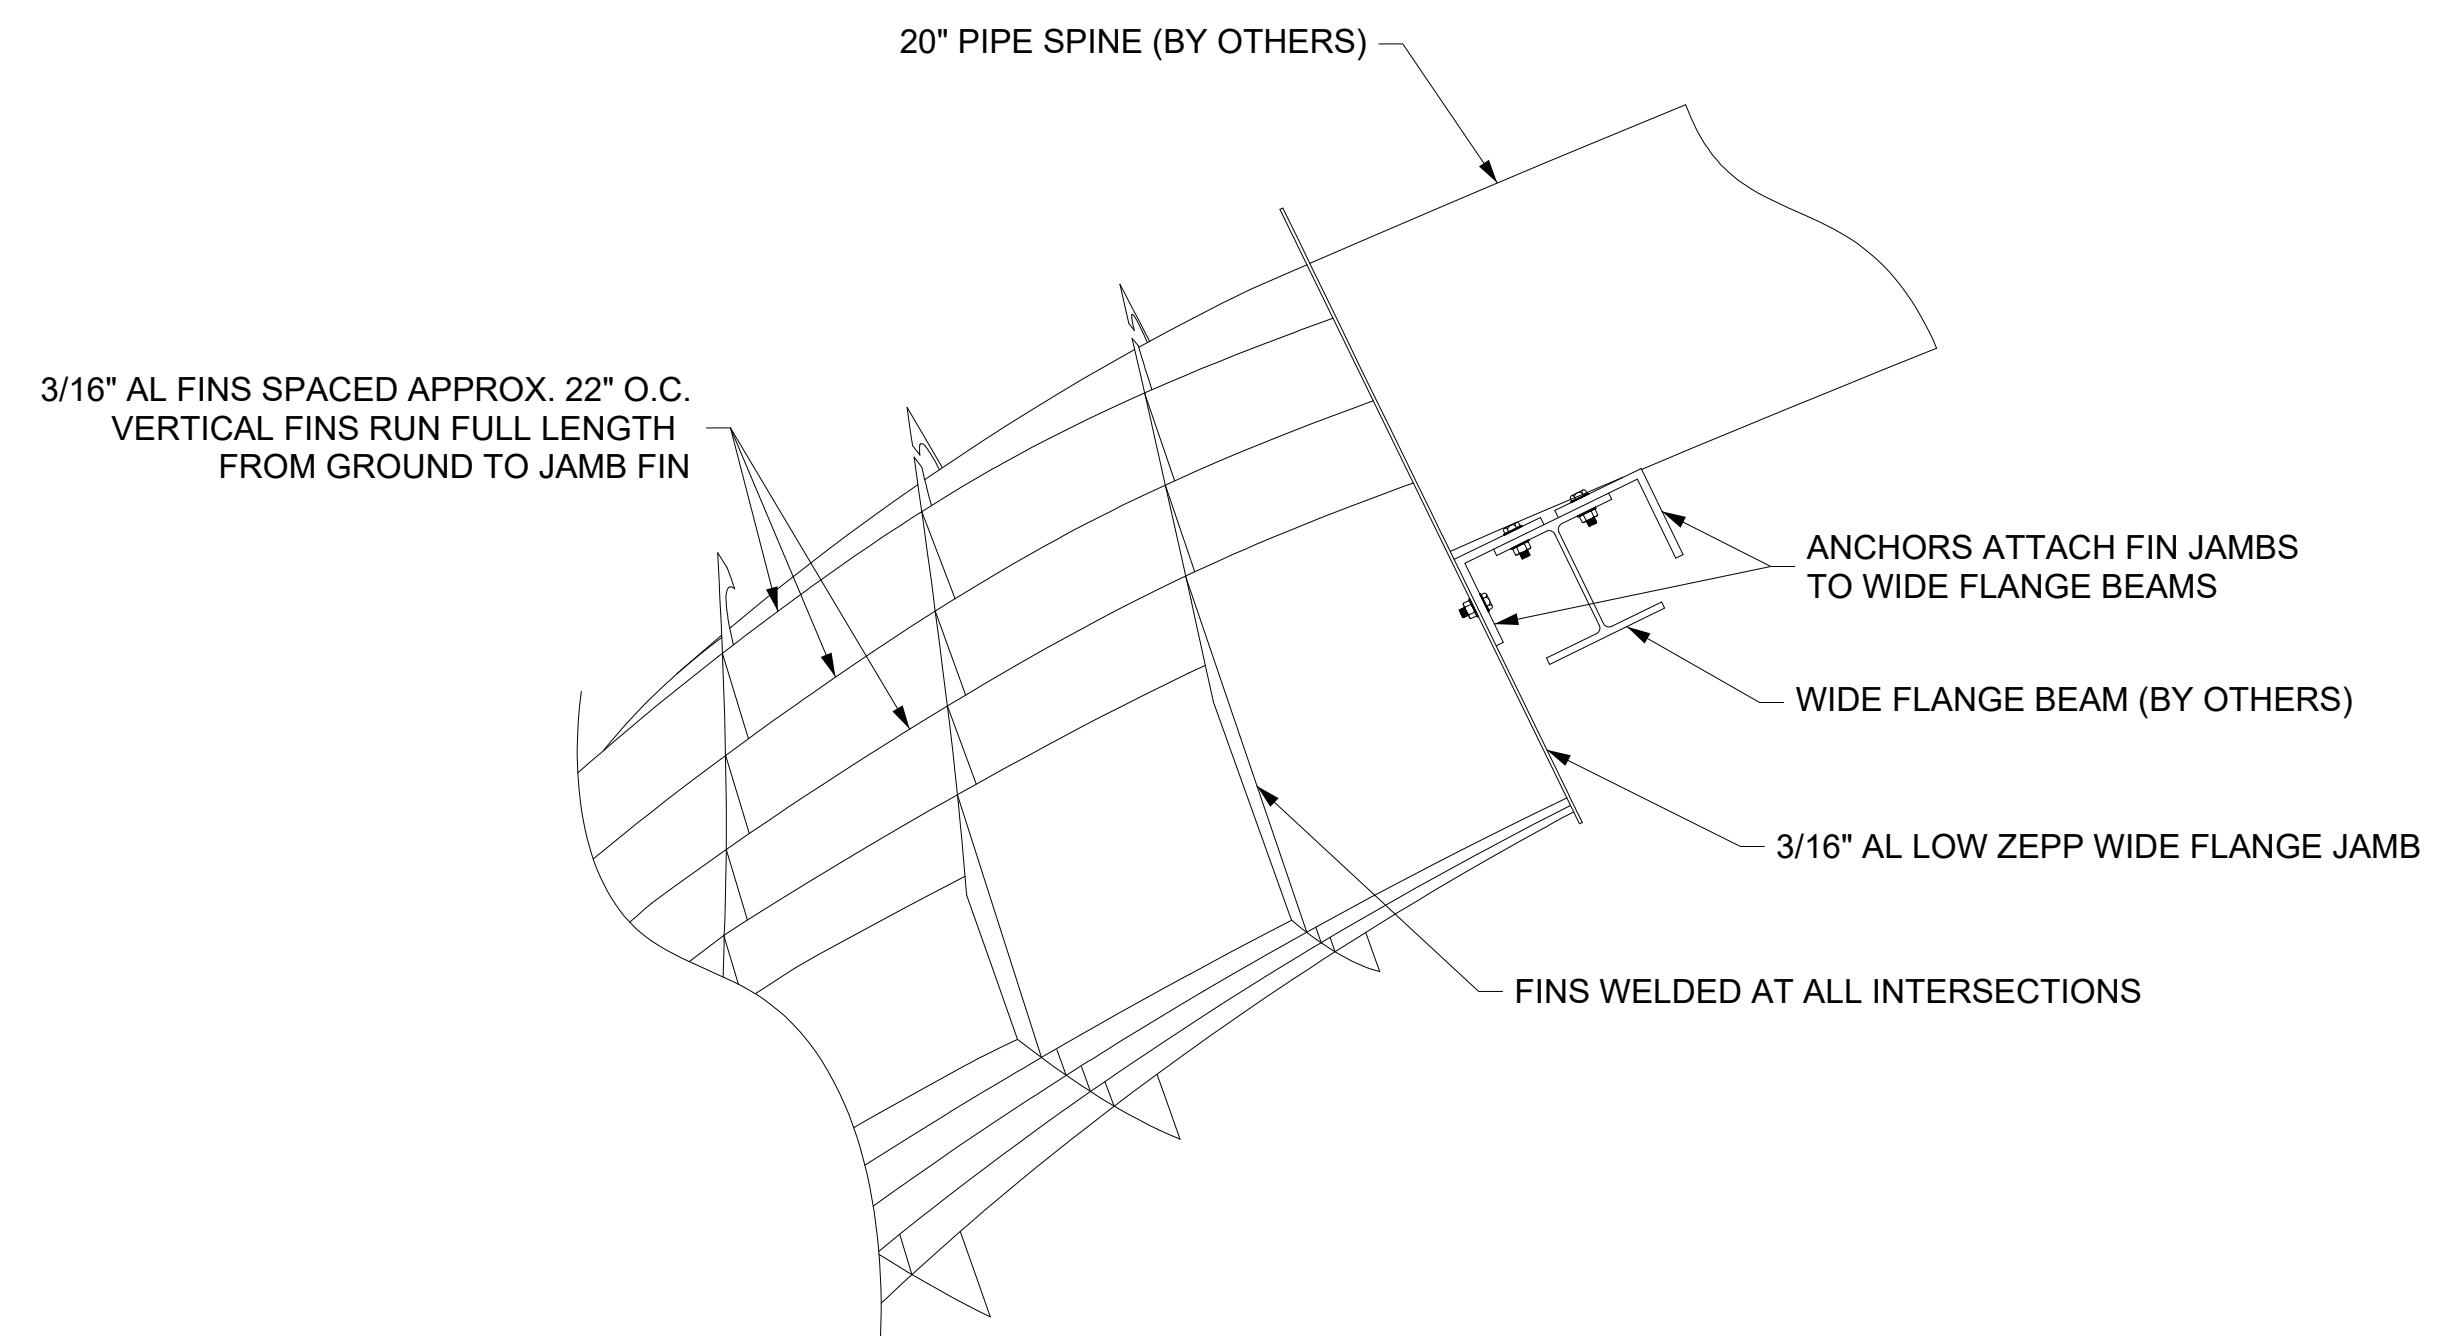

2 WING WALL ZEPP UNIT ATTACHMENT TO STEEL
 SCALE: 1" = 1'-0"
 ZAHNER REF: N/A
 ARCH REF: N/A

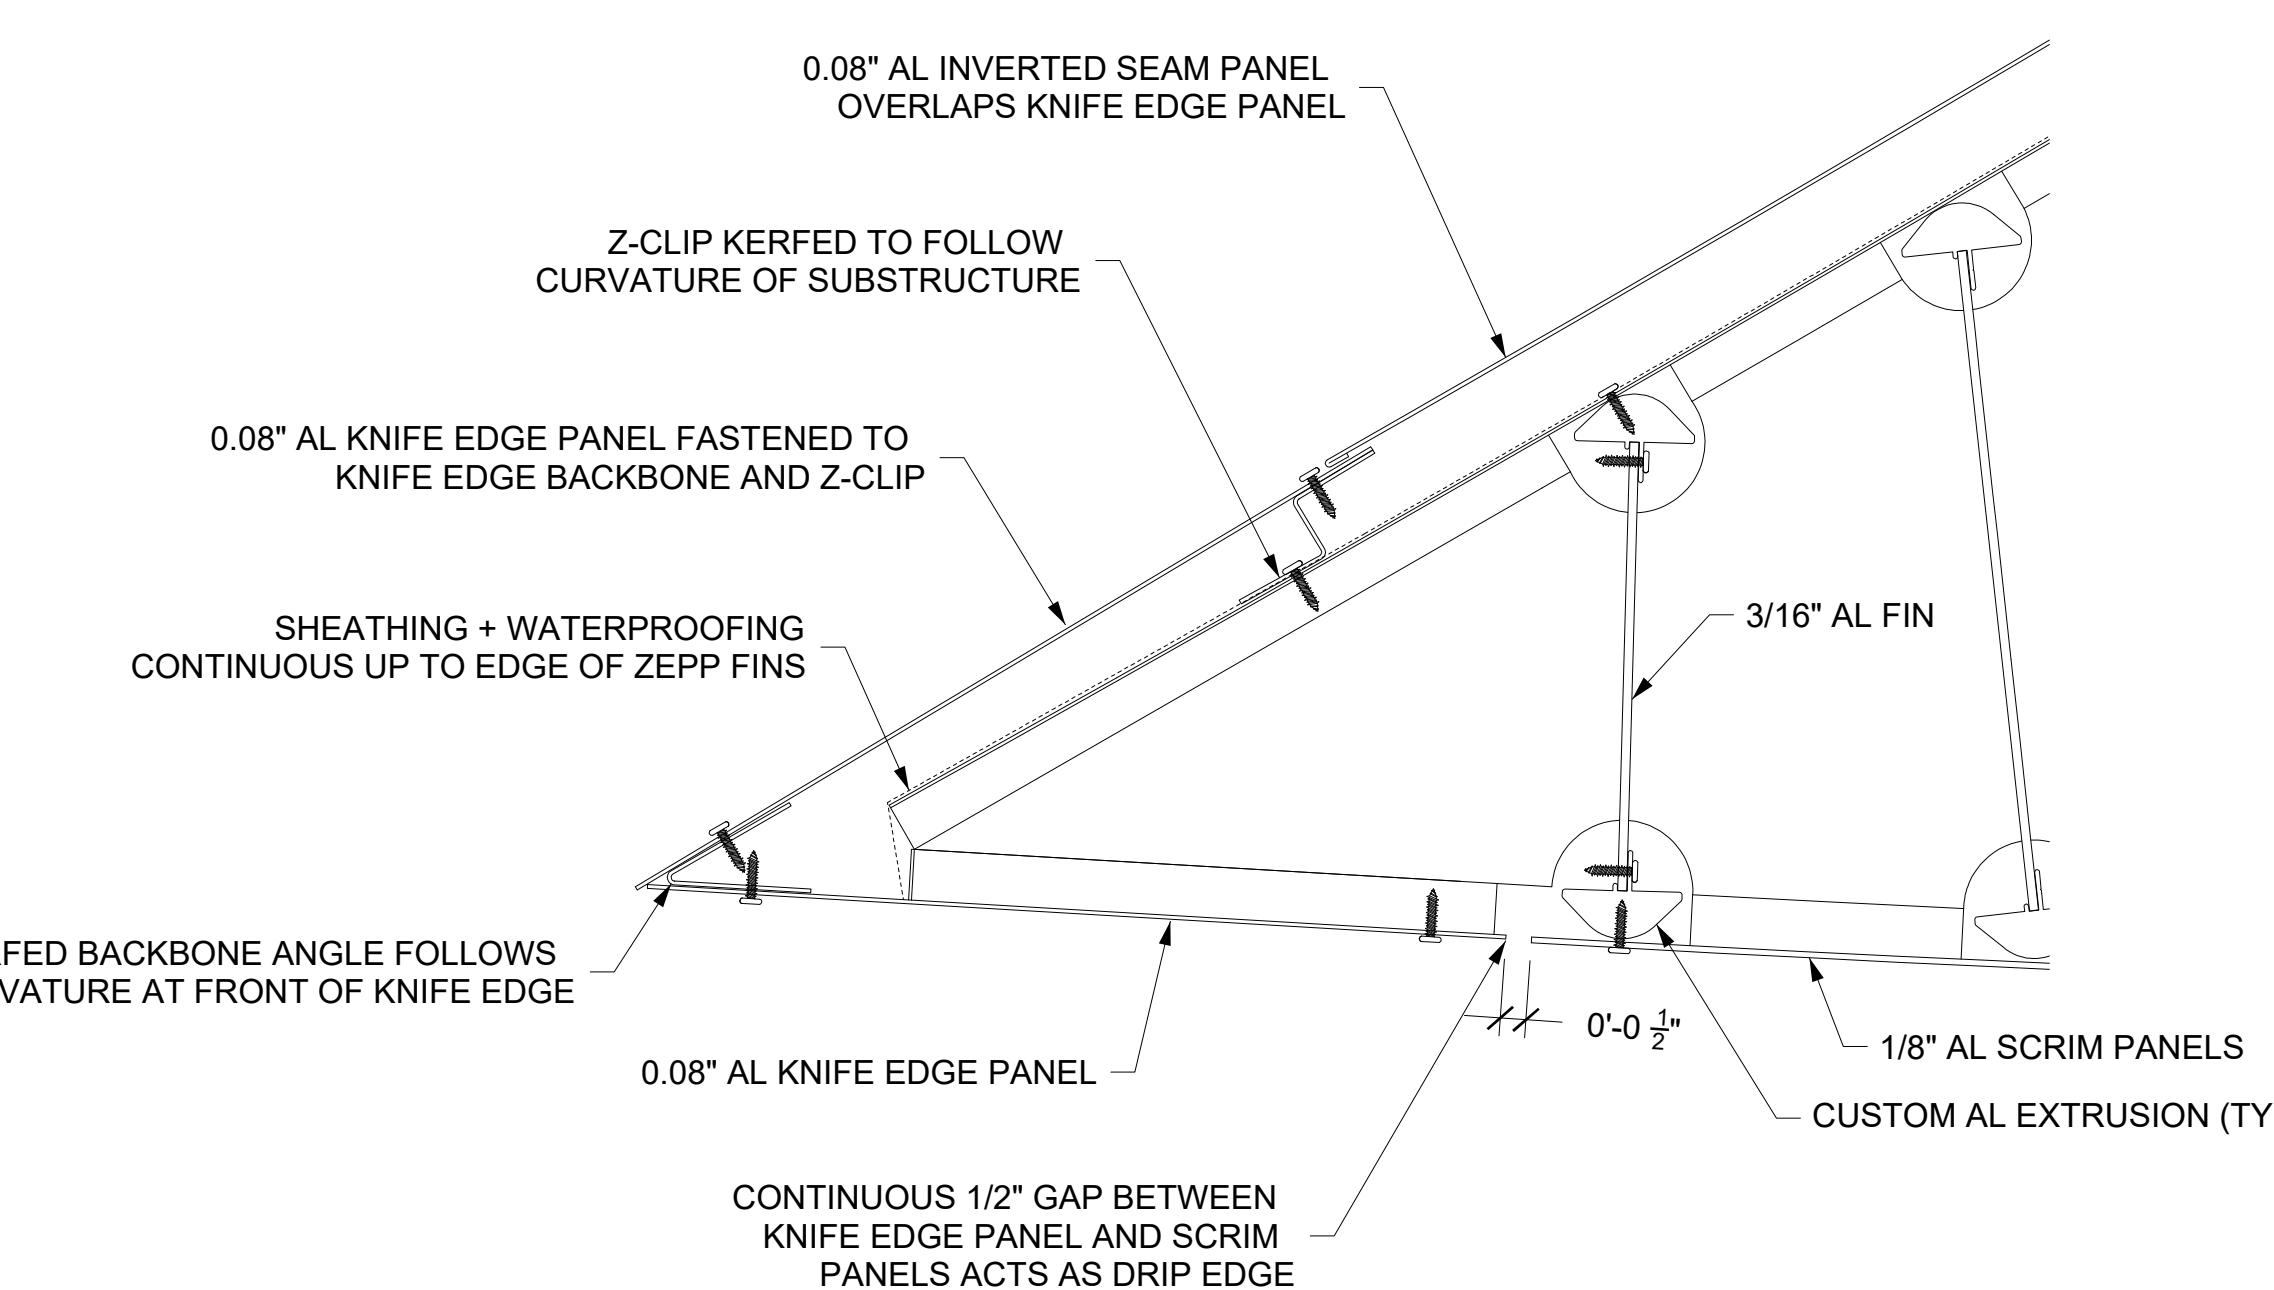


4 KNIFE EDGE DETAILS
 SCALE: 3" = 1'-0"
 ZAHNER REF: N/A
 ARCH REF: N/A

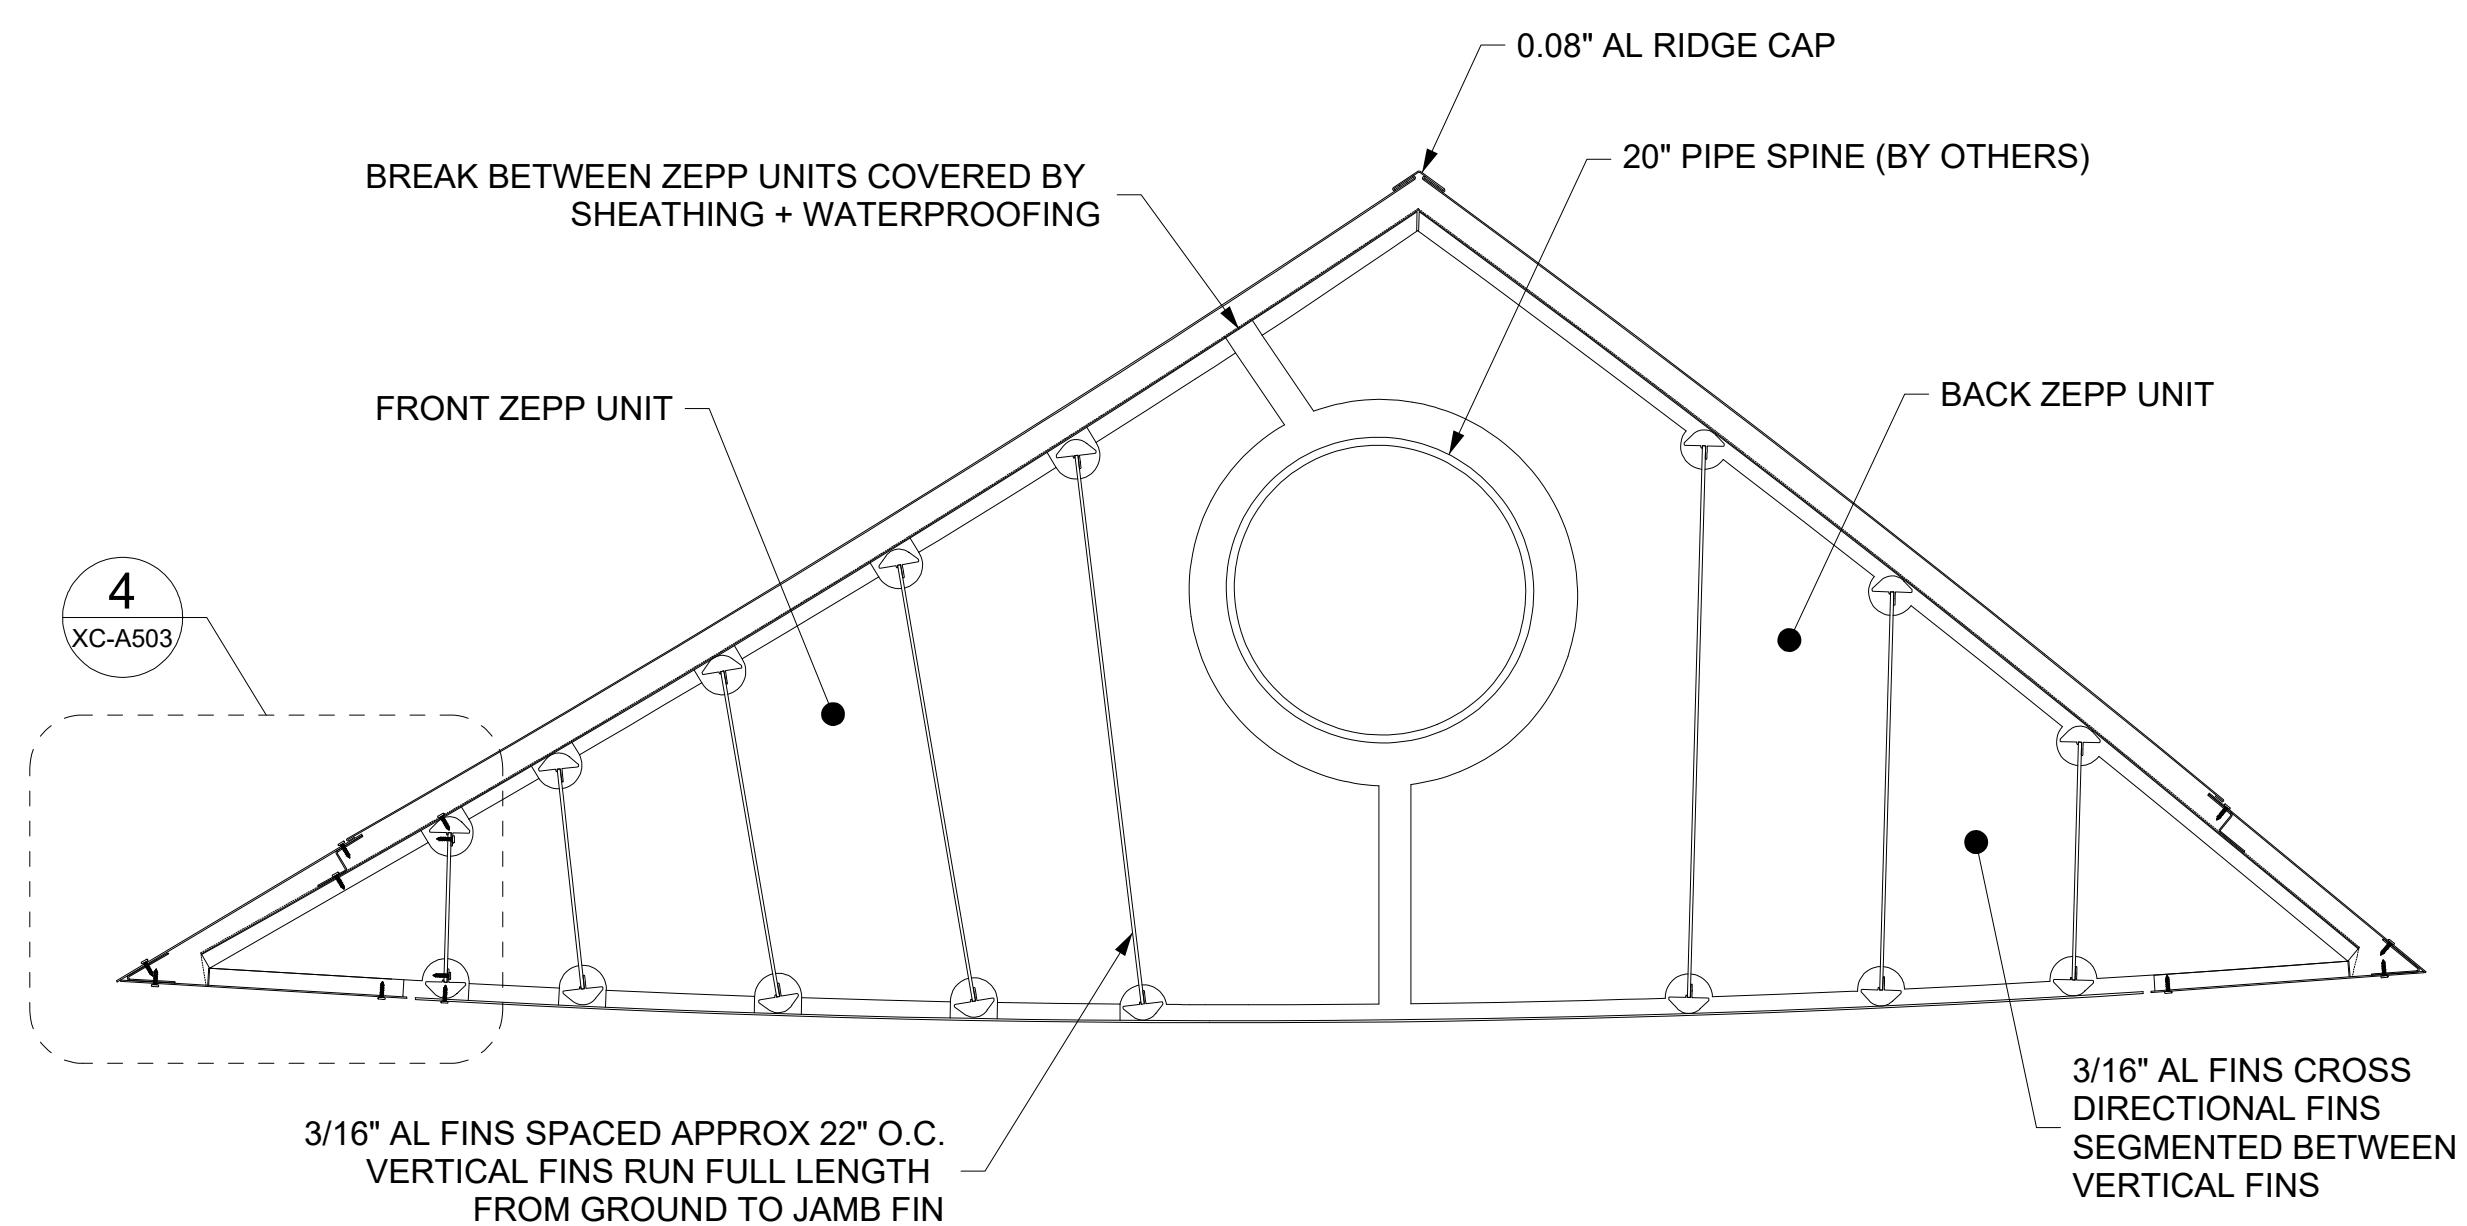




SECTION B-B
WING WALL ZEPP TYPICAL CROSS SECTION
 SCALE: ---
 ZAHNER REF: N/A
 ARCH REF: N/A

SET ISSUE DATES		
DATE	ISSUE	
01/20/22 100% DRAWINGS		
REVISIONS		
NO.	DATE	DESCRIPTION

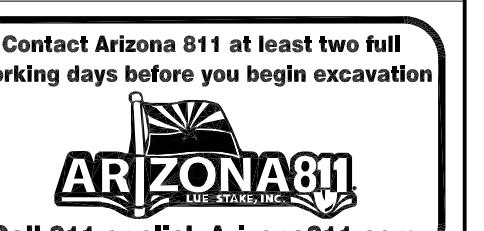


DATE: 01/20/2022	REVISION:	BY:
ENGINEER		
PUBLIC WORKS		
CAPITAL PROJECT MANAGEMENT		
7447 E. INDIAN SCHOOL RD. SCOTTSDALE, ARIZONA 85251		

SHEET TITLE		
CITY OF SCOTTSDALE CIVIC CENTER PLAZA		
THIS SHEET SCALED FOR 24X36" BORDER	SCALE	DESIGNED
	DRAWN DS	AS-BUILT
	COS PROJECT NO. DG04	BID NO. XC-A503

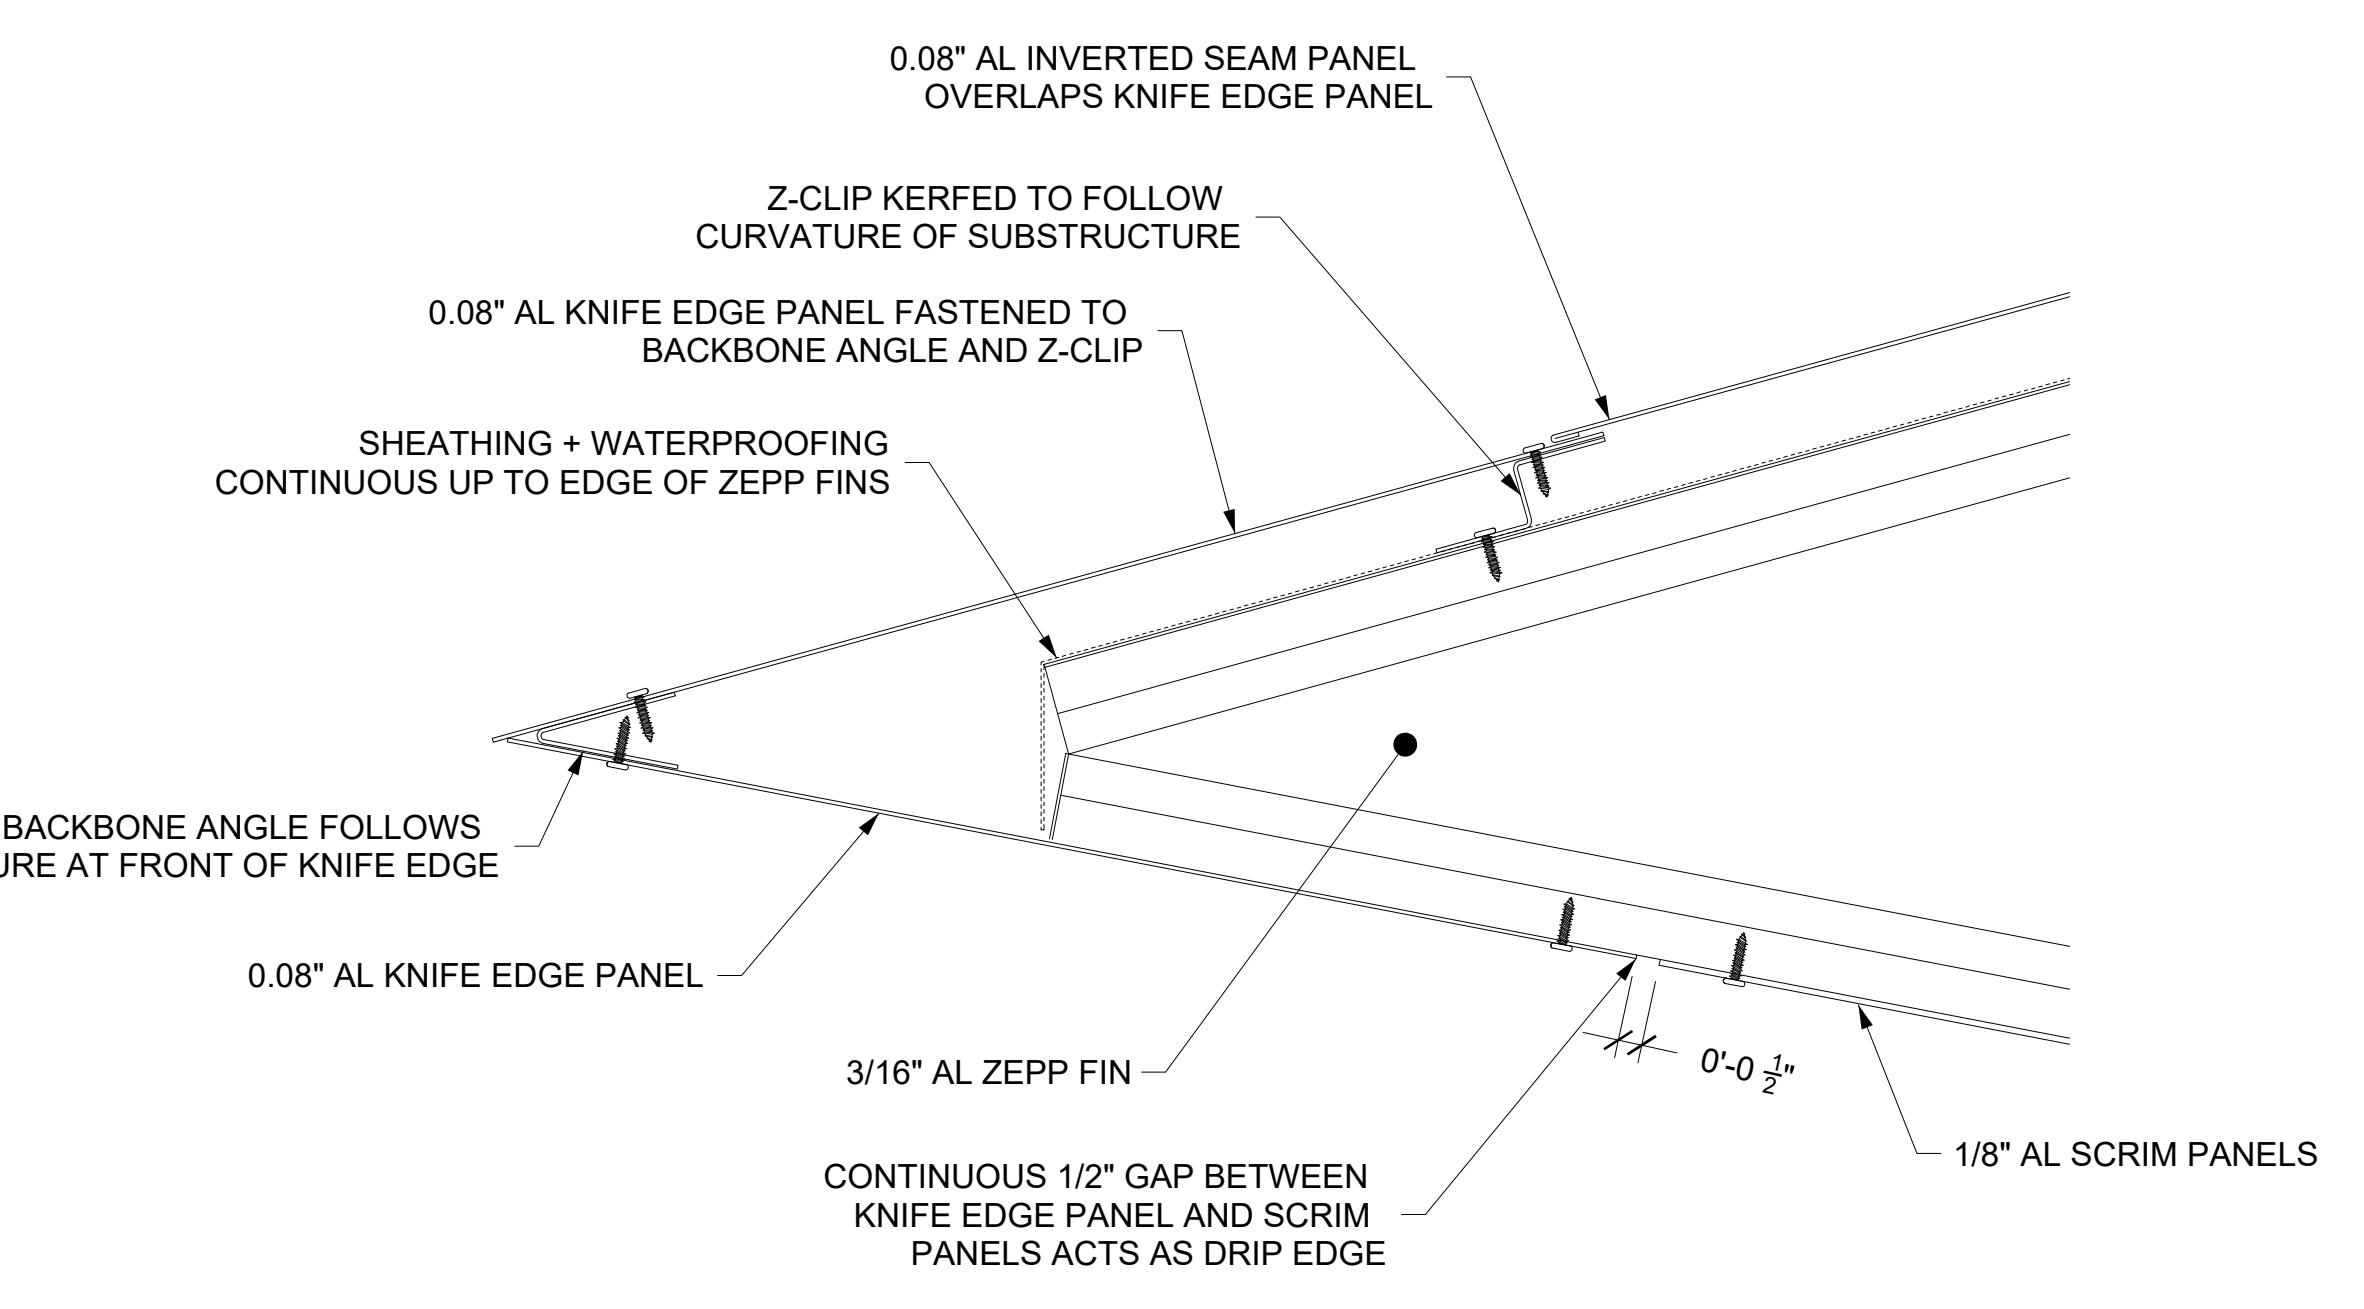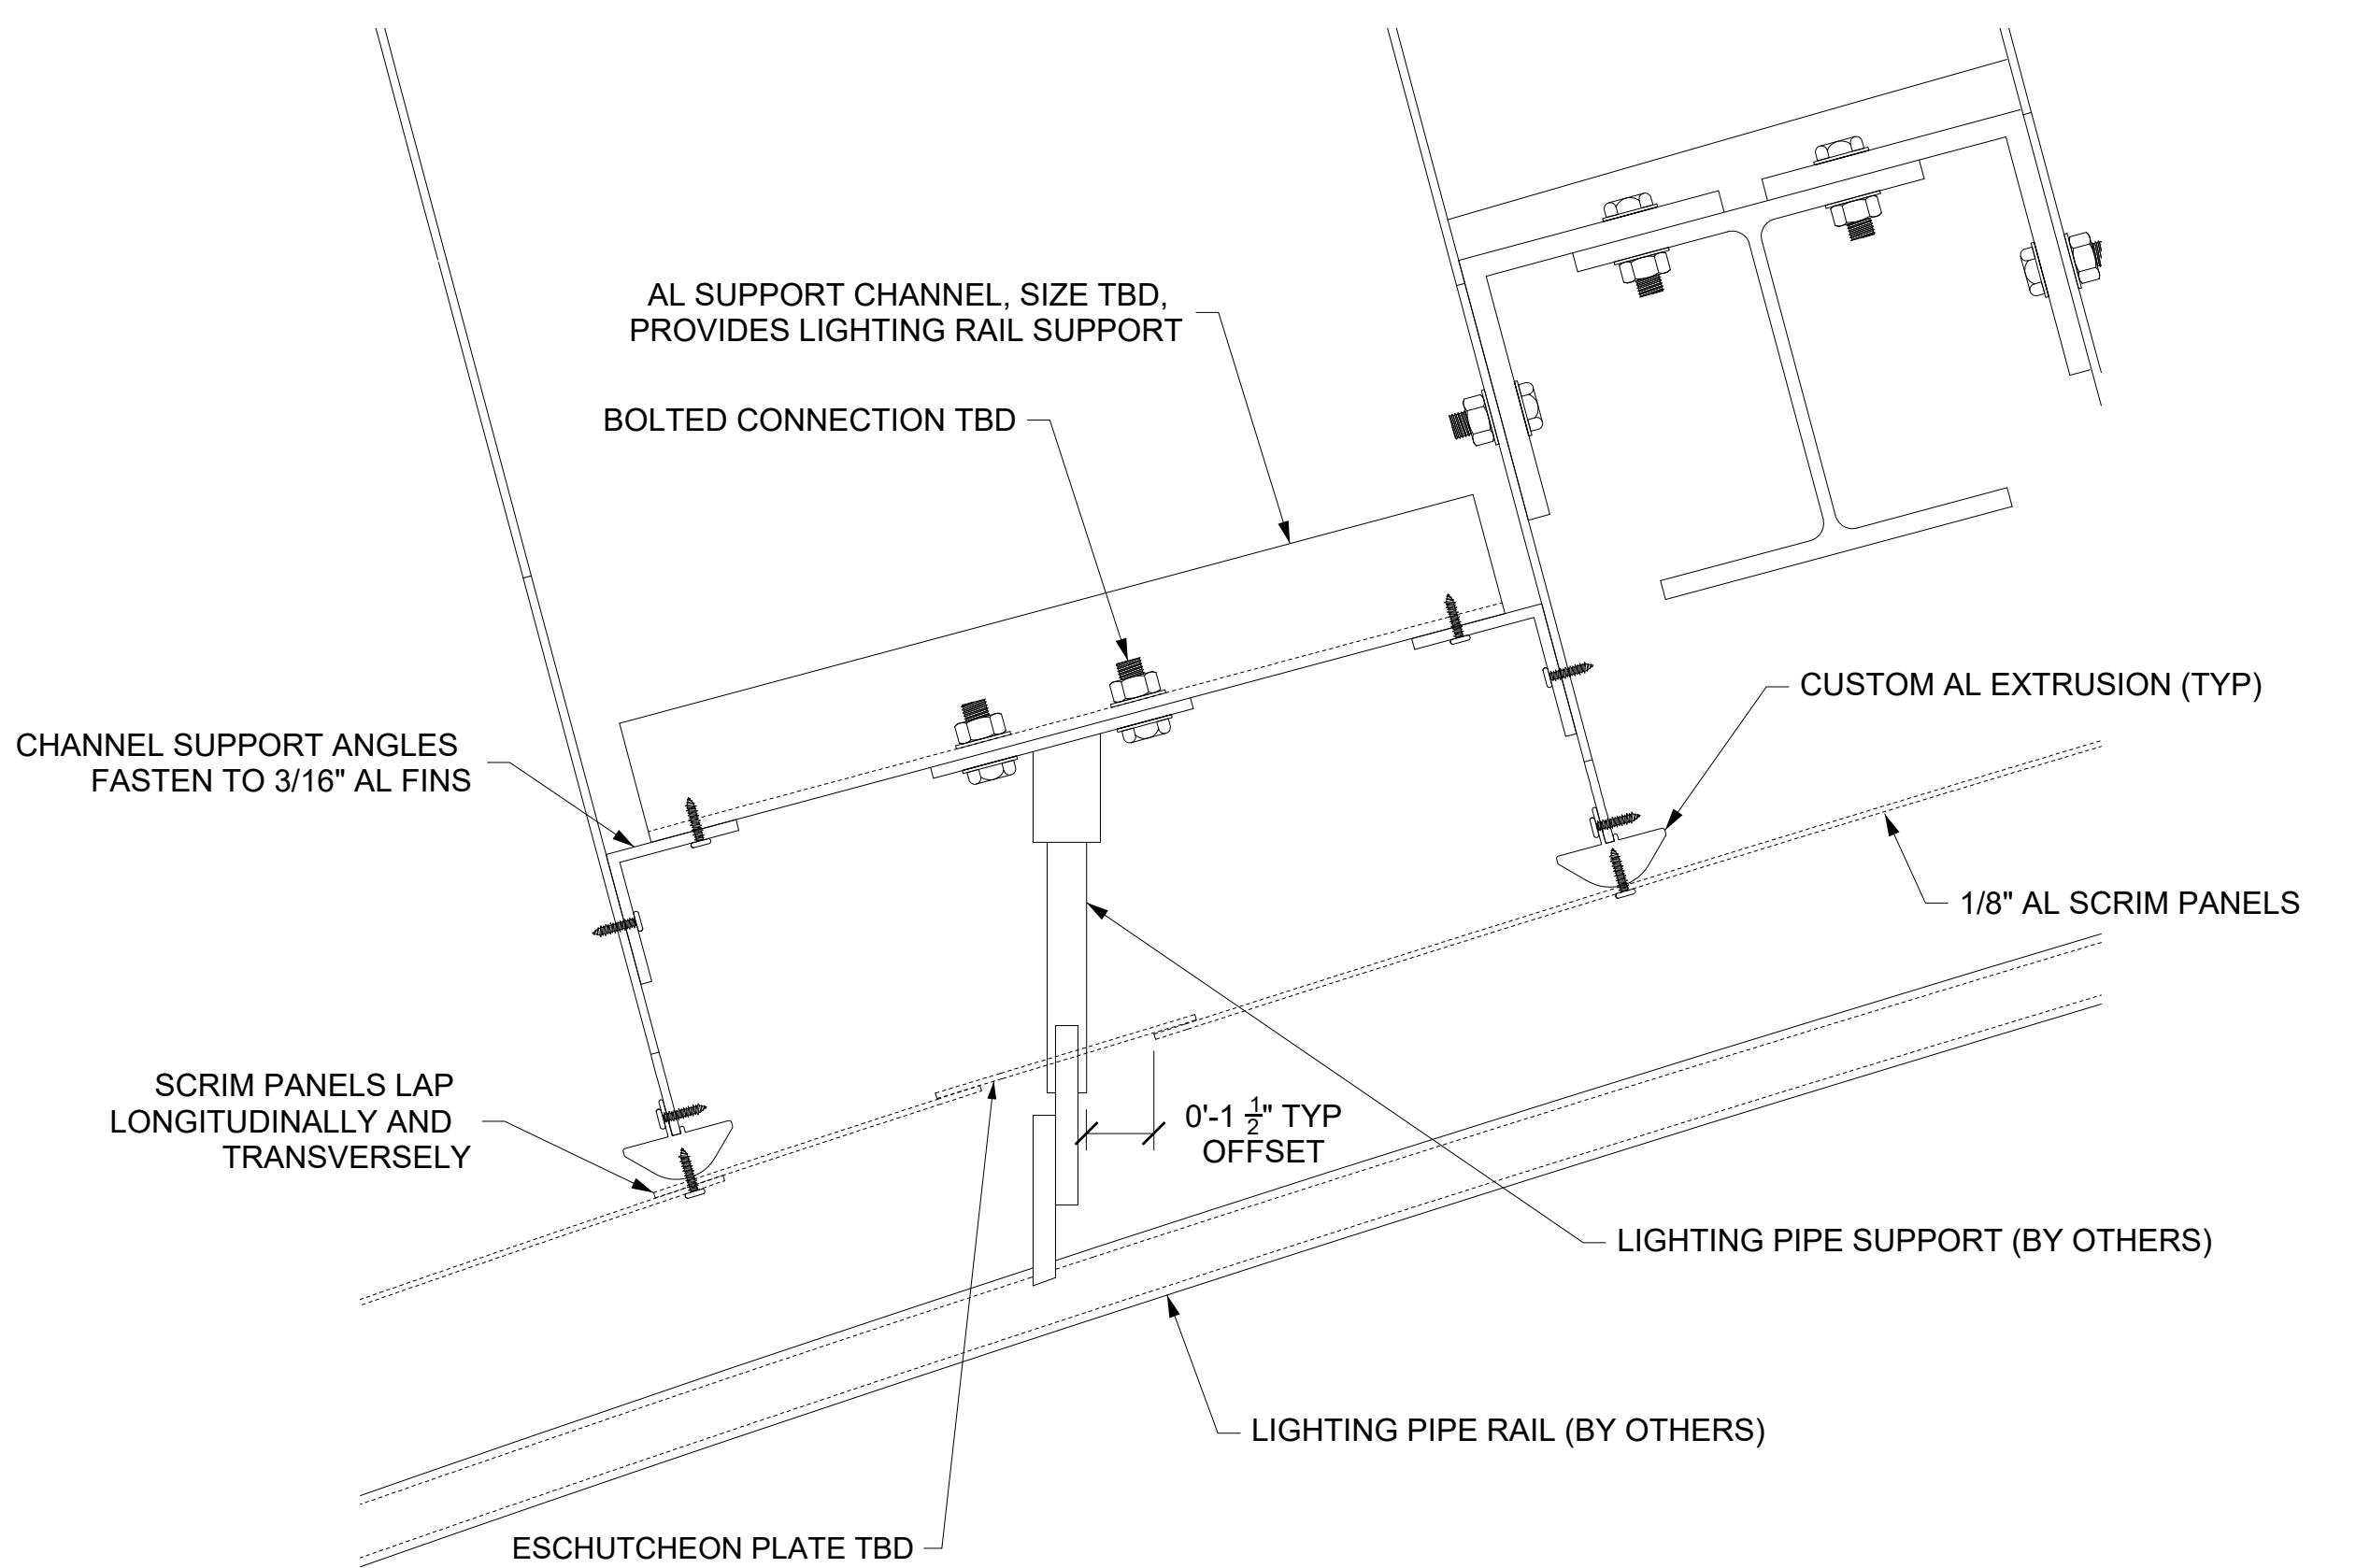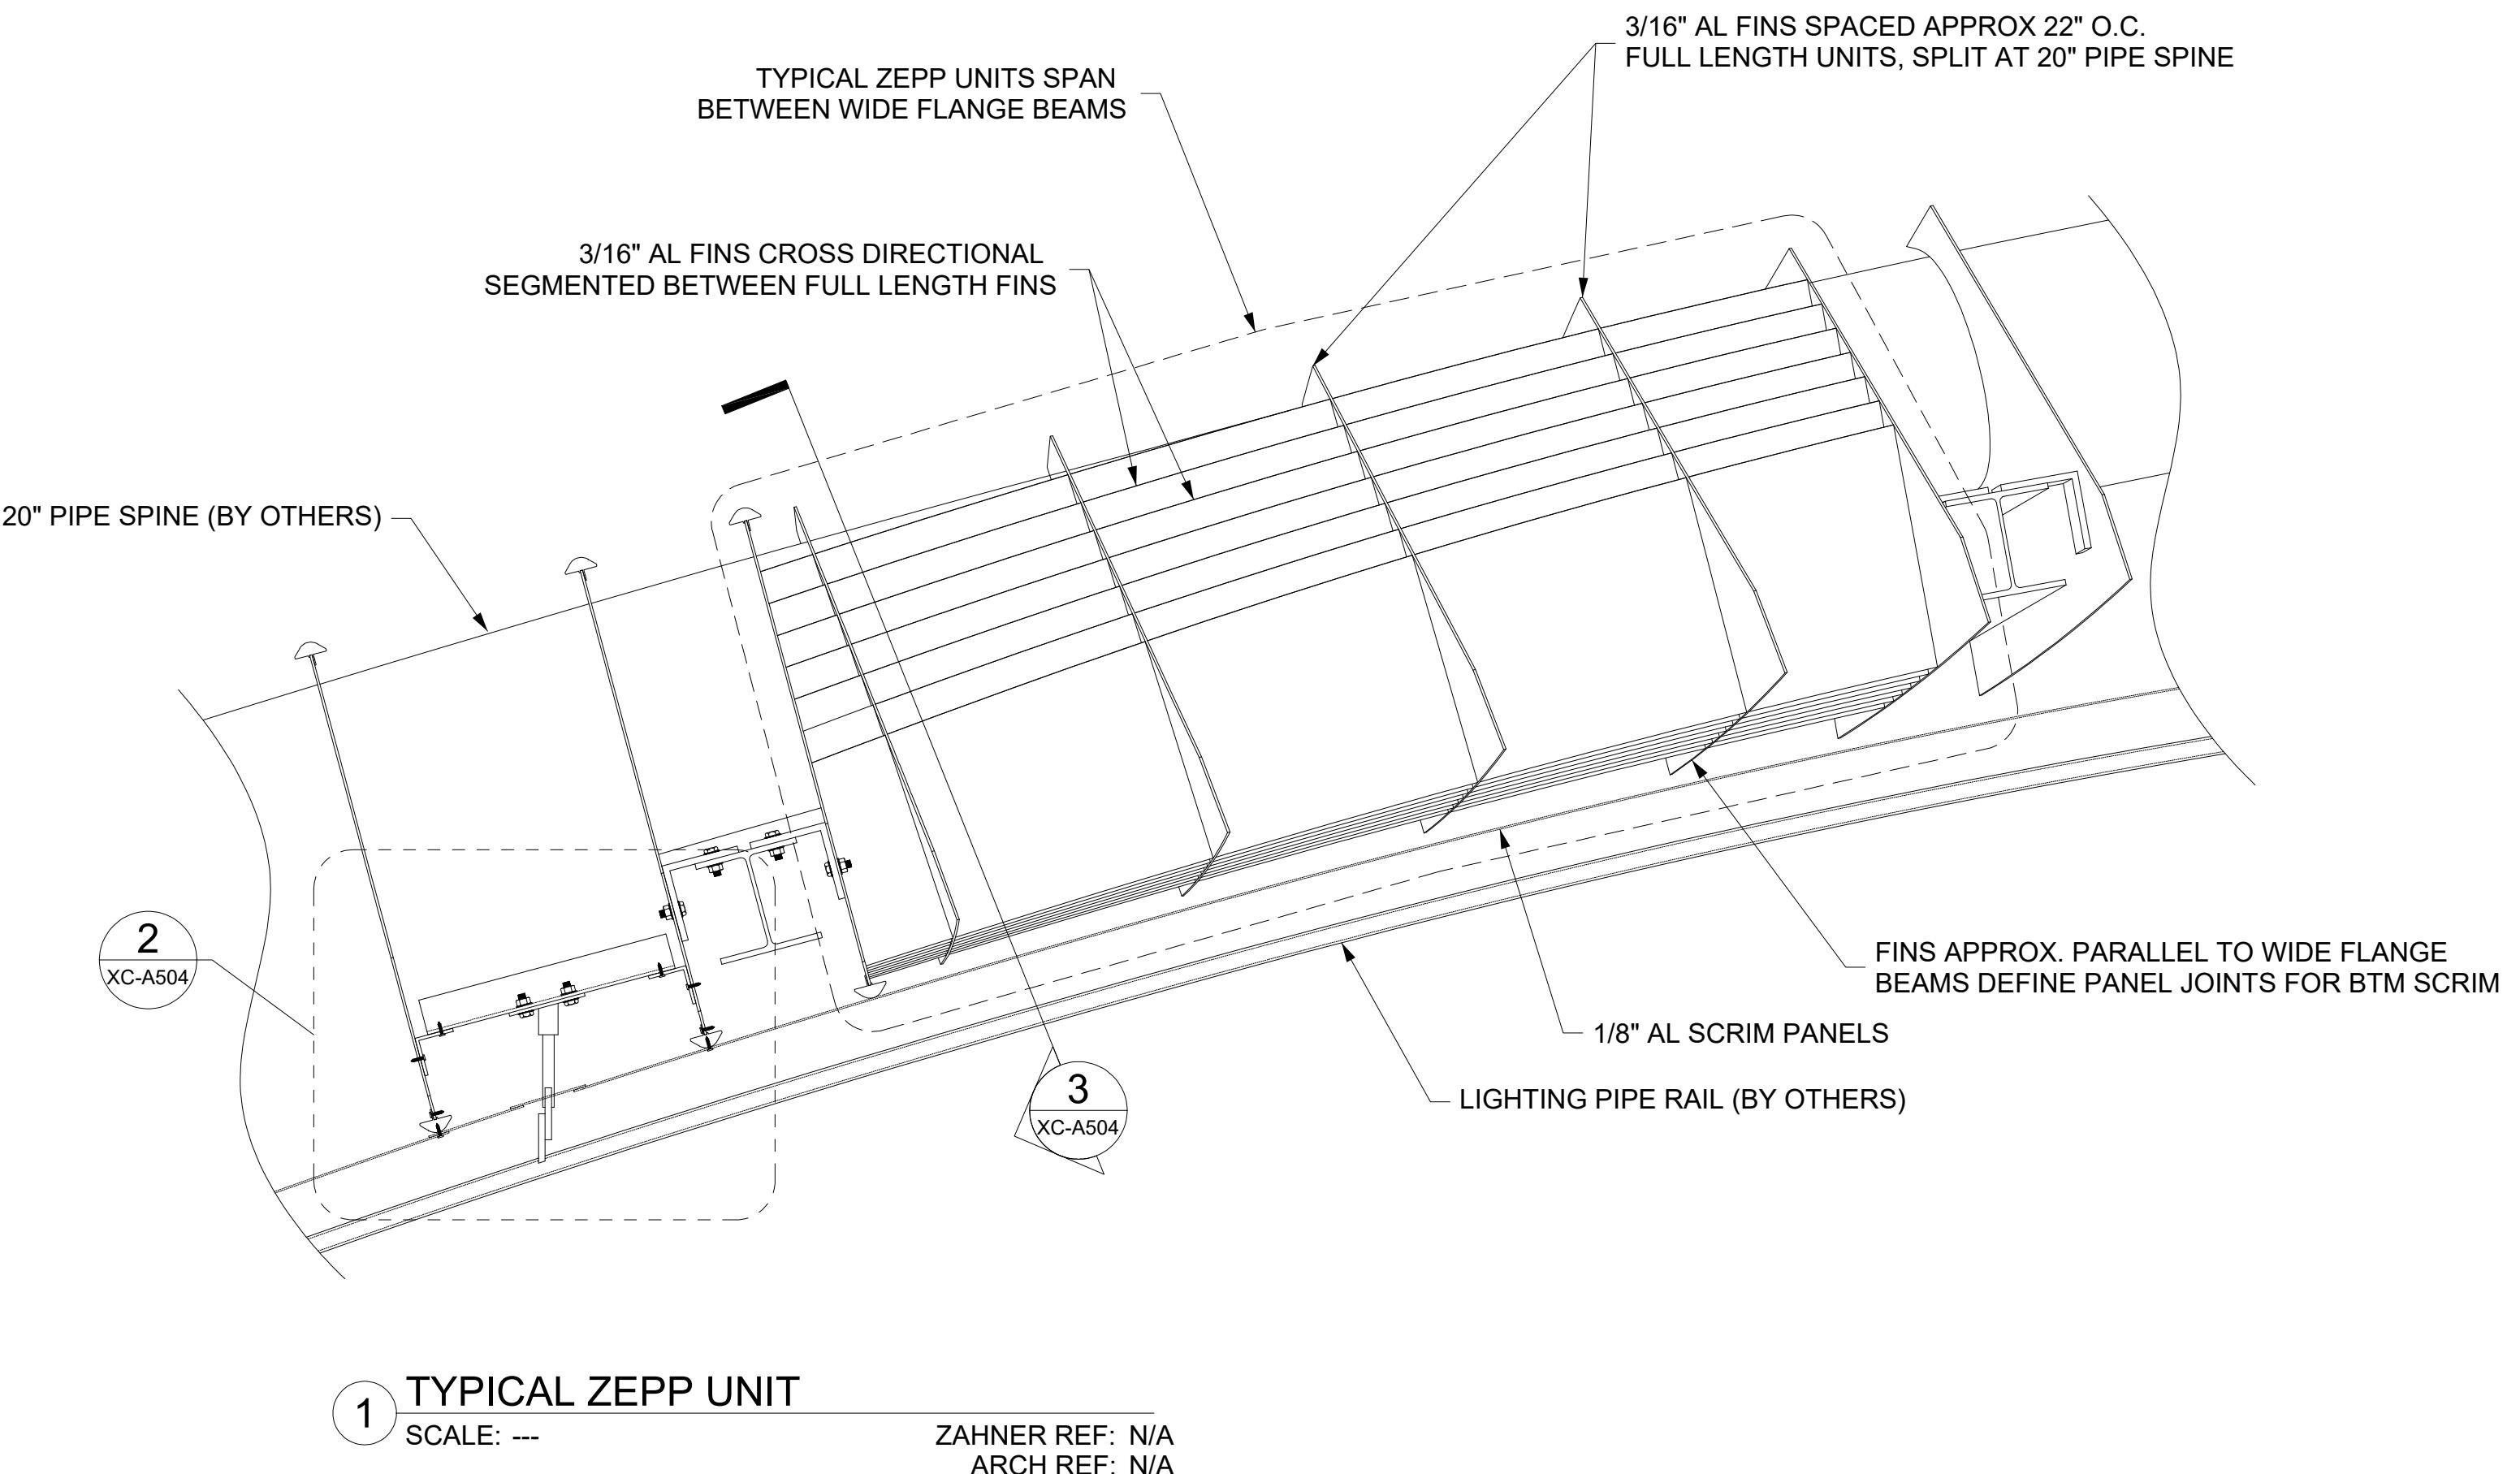


SET ISSUE DATES		
DATE	ISSUE	
01/20/22 100% DRAWINGS		
REVISIONS		
NO.	DATE	DESCRIPTION

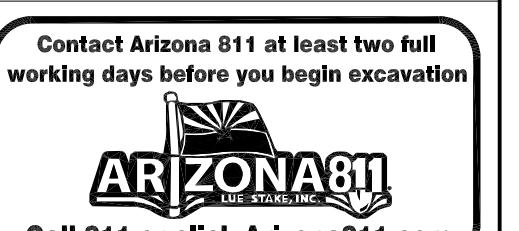

DATE: 01/20/2022 / REVISION: BY:	
ENGINEER	PUBLIC WORKS
CAPITAL PROJECT MANAGEMENT	
7447 E. INDIAN SCHOOL RD. SCOTTSDALE, ARIZONA 85251	
SHEET TITLE	

EAST BOWL - TYP ZEPP DETAILS

PROJECT TITLE		CITY OF SCOTTSDALE CIVIC CENTER PLAZA		
SCALE	DESIGNED	BID NO.	XC-A504	
DRAWN DS	AS-BUILT	COS PROJECT NO. DG04		

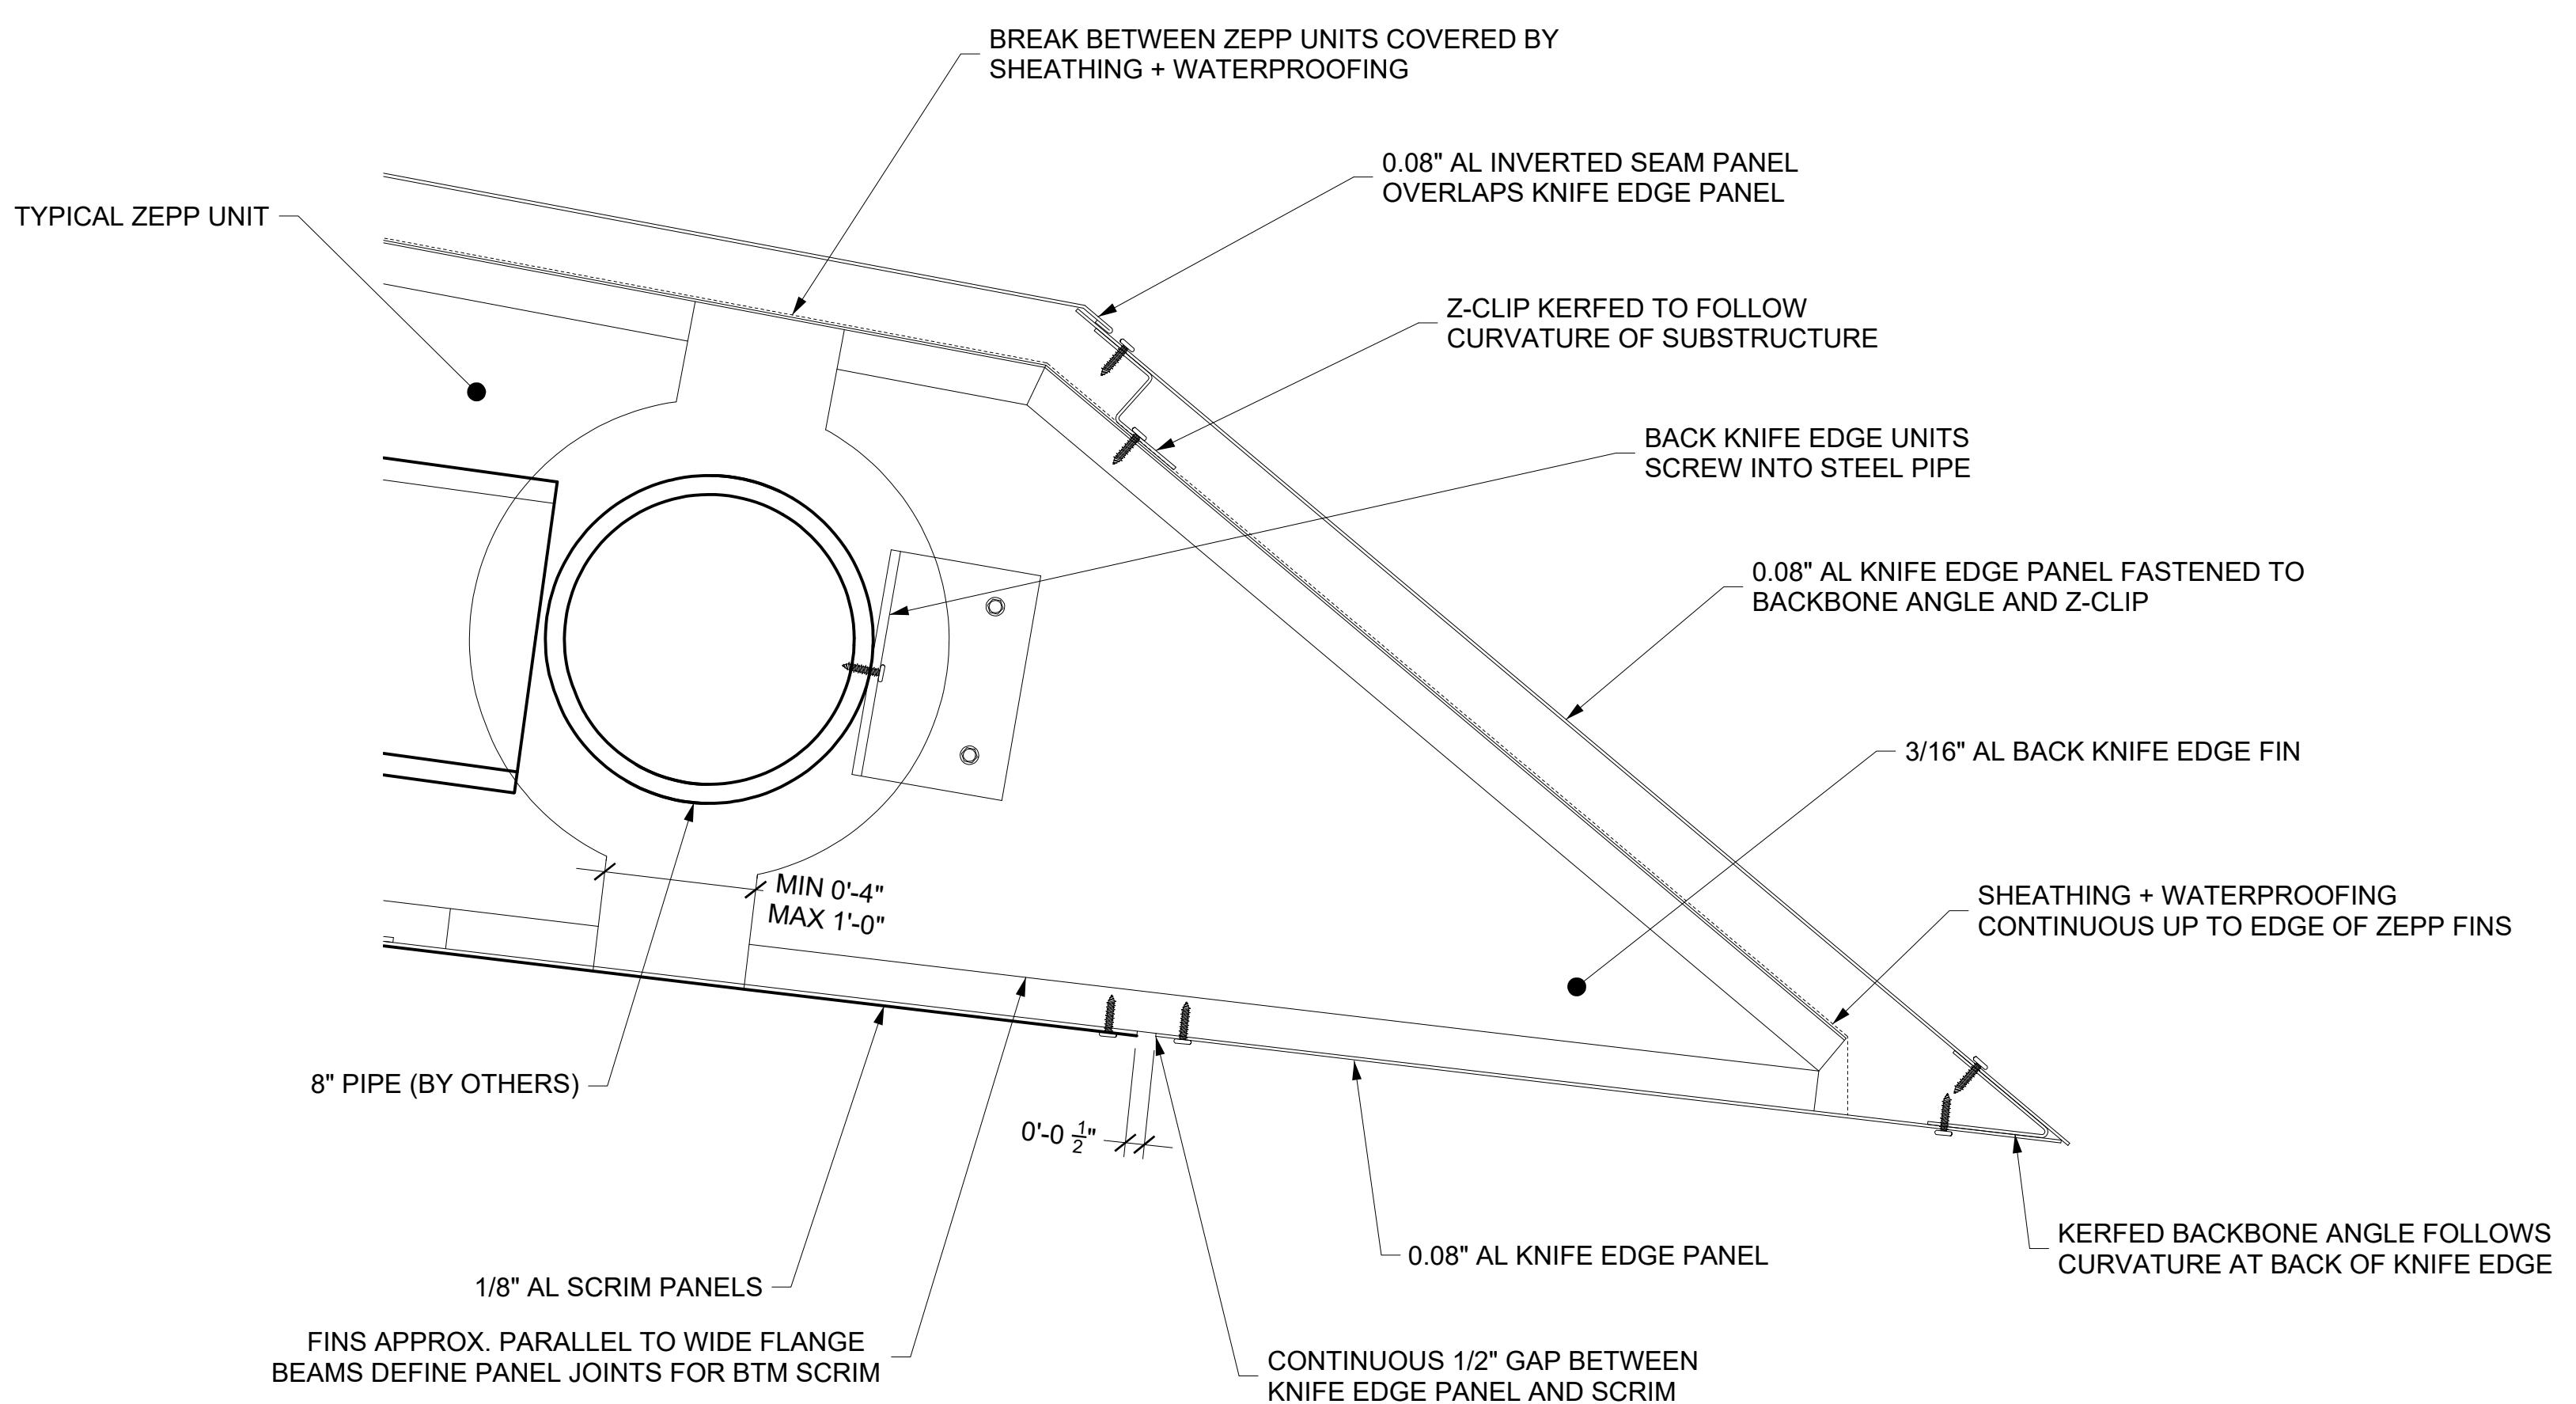


① BACK KNIFE EDGE DETAIL

SCALE: 3' = 1'-0"

ZAHNER REF: N/A
ARCH REF: N/A

SET ISSUE DATES		
DATE	ISSUE	
01/20/22 100% DRAWINGS		

REVISIONS		
NO.	DATE	DESCRIPTION

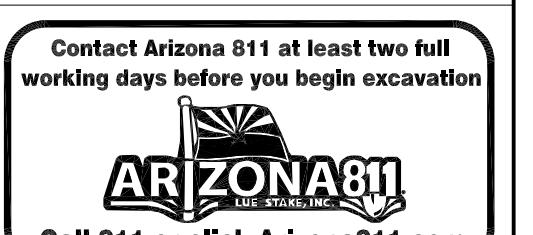


DATE: 01/20/2022	REVISION:	BY:
ENGINEER		PUBLIC WORKS
		CAPITAL PROJECT MANAGEMENT
		74447 E. INDIAN SCHOOL RD. SCOTTSDALE, ARIZONA 85251
SHEET TITLE		

PROJECT TITLE		
CITY OF SCOTTSDALE CIVIC CENTER PLAZA		

THIS SHEET SCALED FOR 24X36" BORDER	SCALE	DESIGNED	BID NO.	XC-A505
	DRAWN DS	AS-BUILT	COS PROJECT NO. DG04	


--	--	--	--

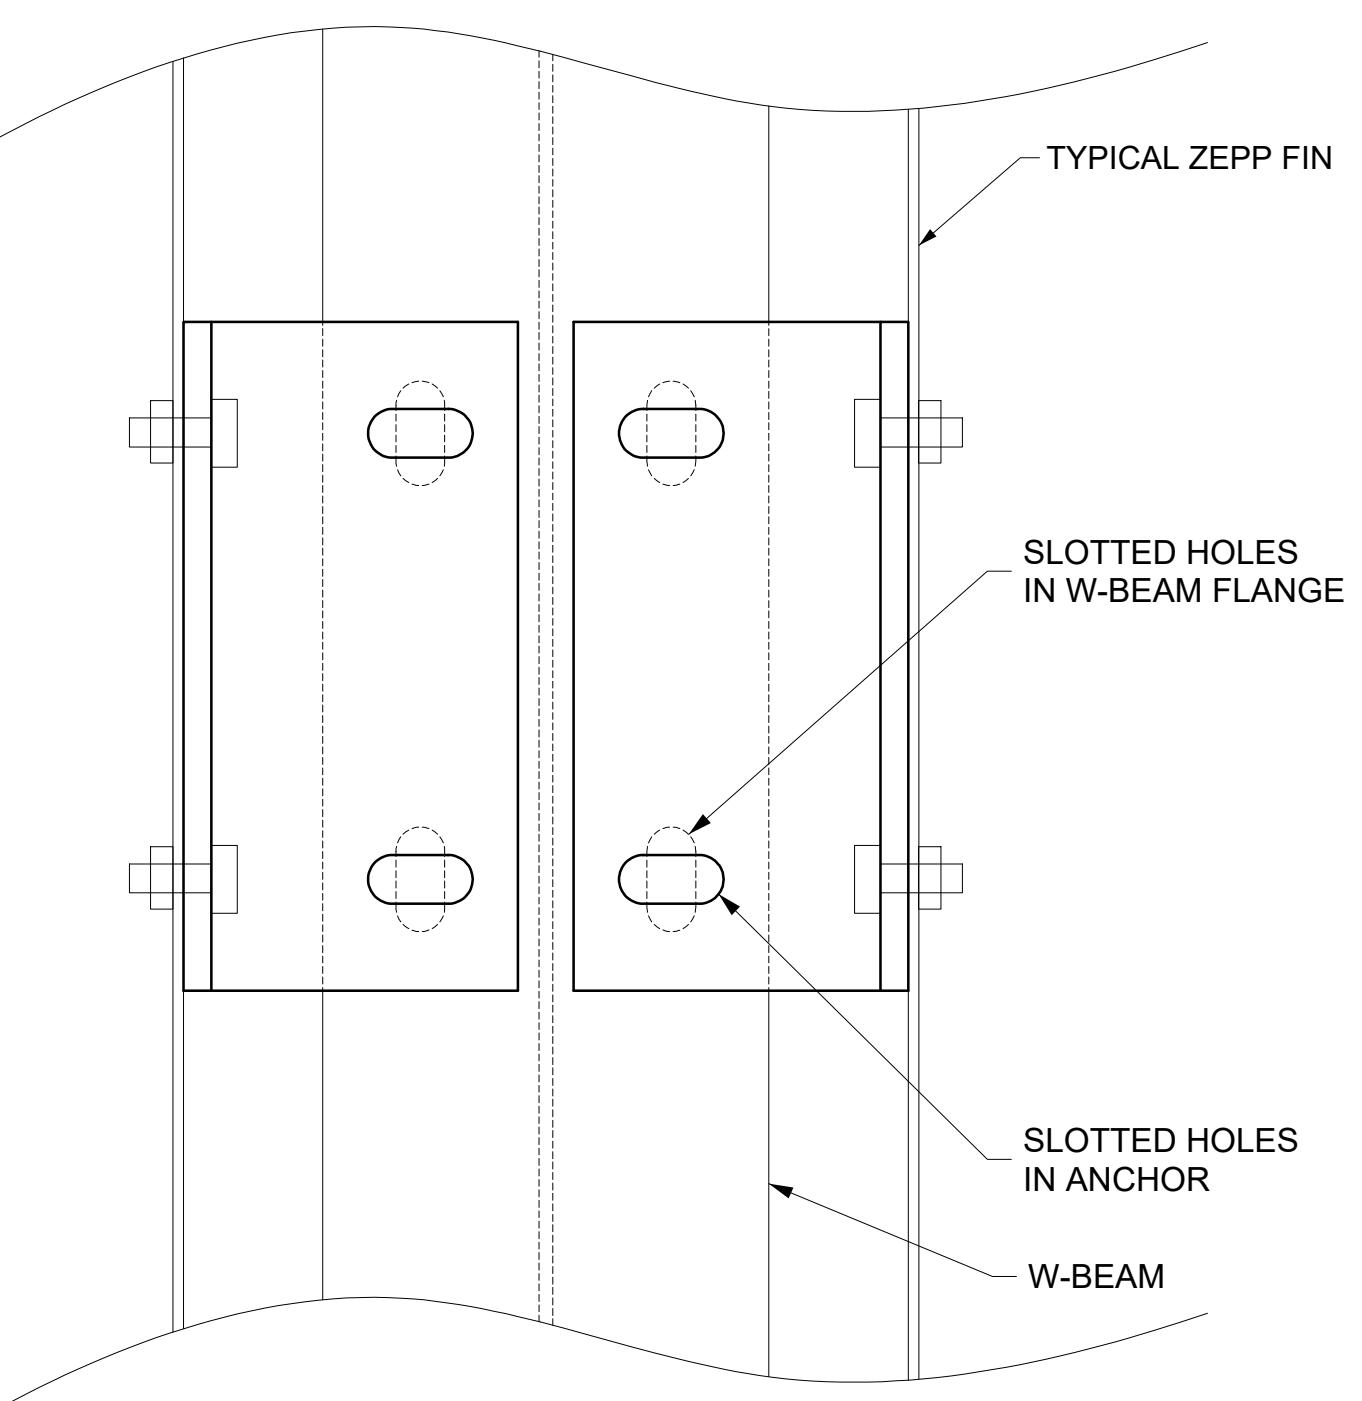

SECTION A-A

SCALE: --


ZAHNER REF: N/A
ARCH REF: N/A

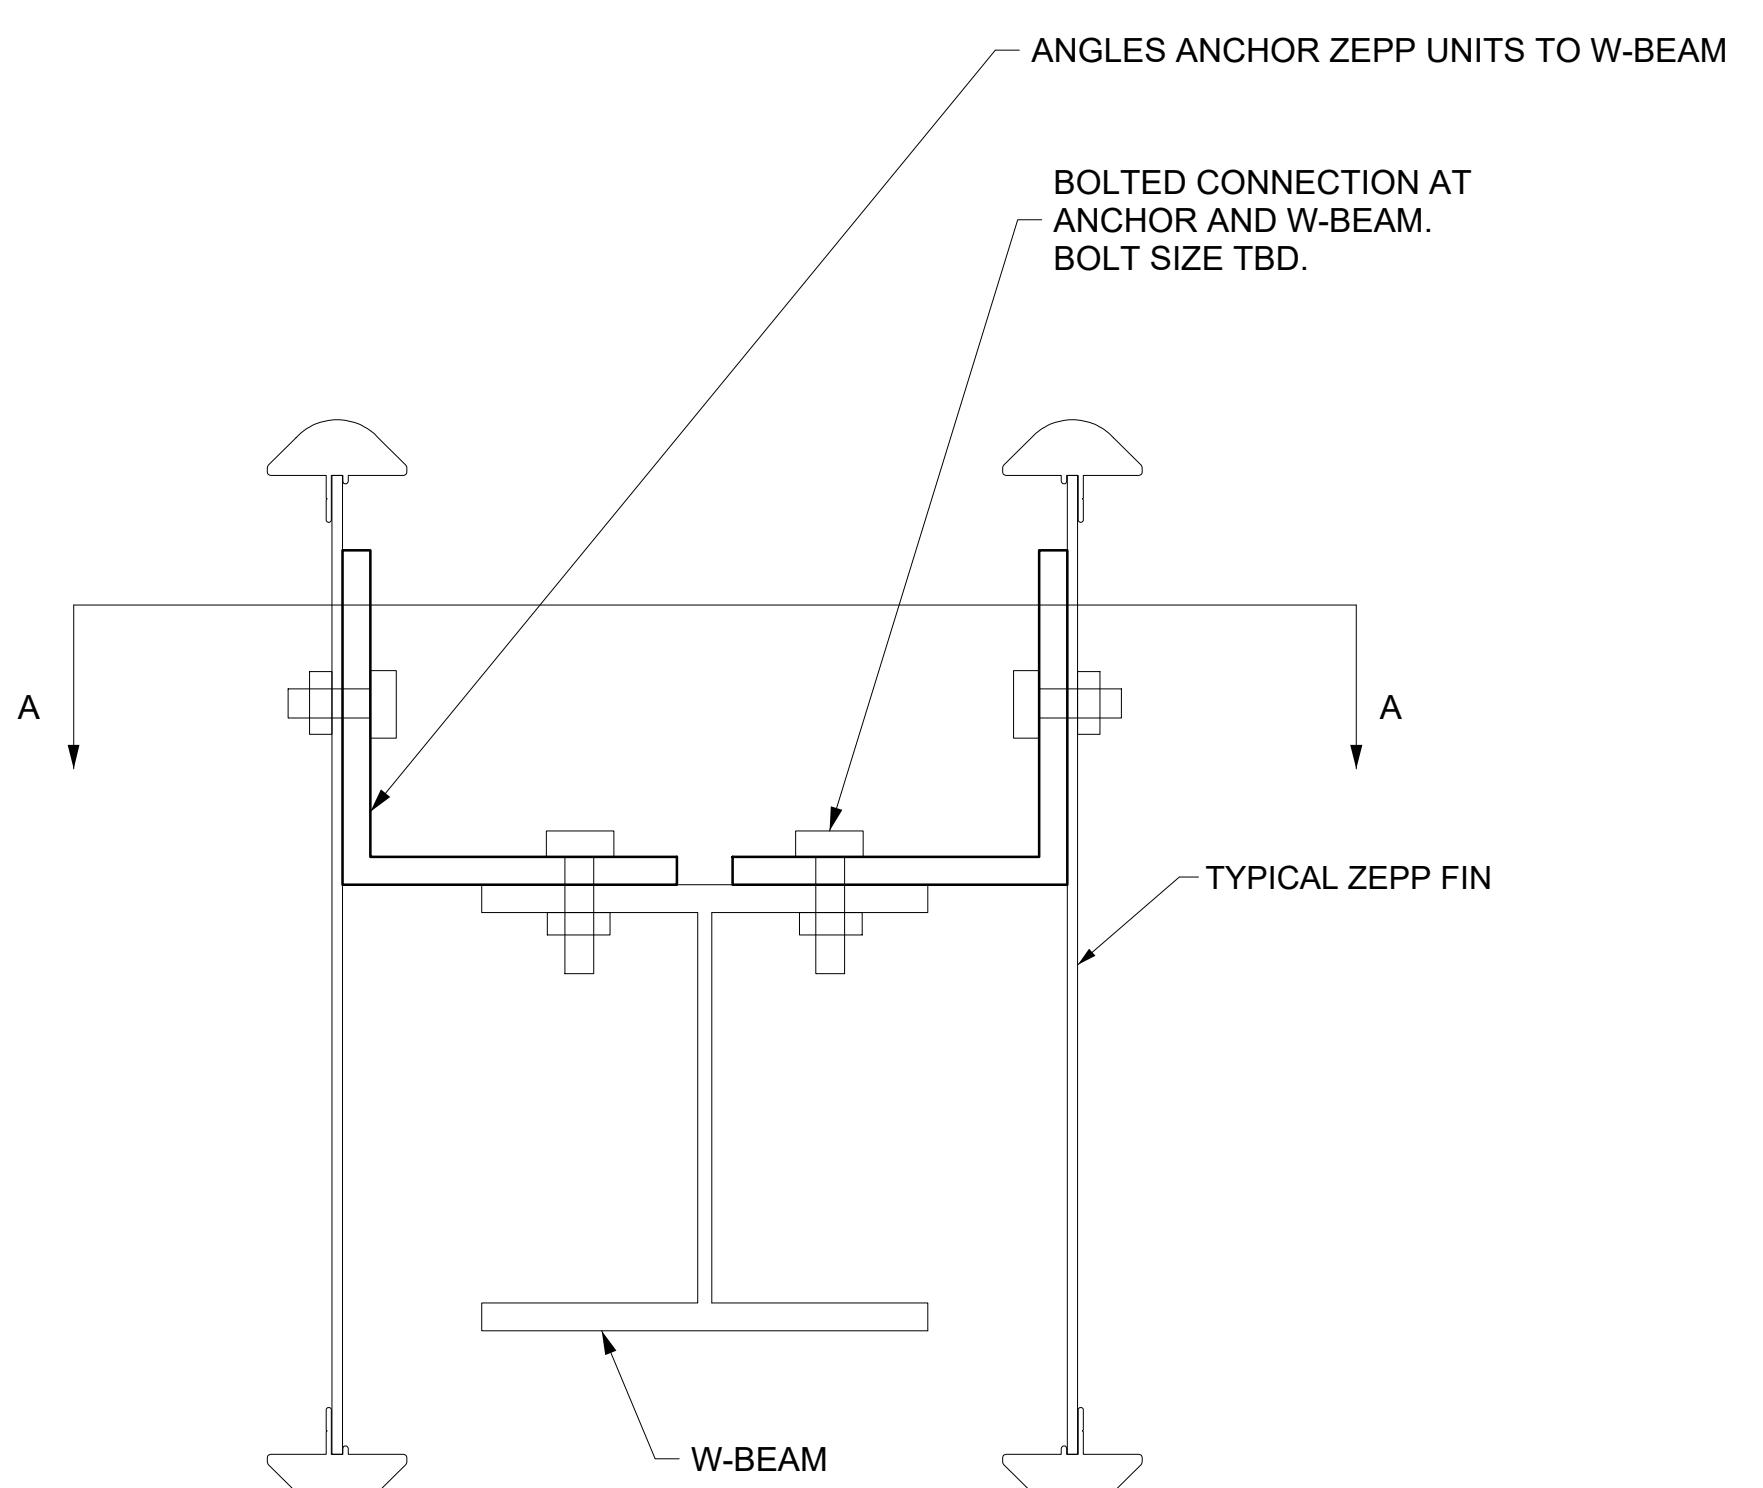


2 ANCHOR DETAIL SCALE: ---

(2) ANSWER
SCALE:


ZAHNER REF: N/A
ARCH REF: N/A

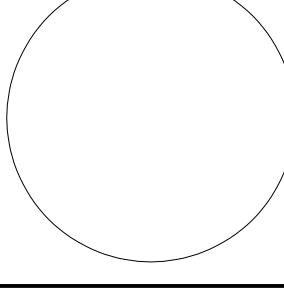SET ISSUE DATES				
DATE	ISSUE			
01/20/22 100% DRAWINGS				
<hr/> <hr/> <hr/> <hr/> <hr/>				
REVISIONS				
NO.	DATE	DESCRIPTION		
		<hr/> <hr/> <hr/> <hr/> <hr/>		
<div style="text-align: right; padding: 10px;"> <p>Contact Arizona 811 at least two full working days before you begin excavation</p>  <p>Call 811 or click Arizona811.com</p> </div>				
DATE: 01/20/2022		REVISION:		BY:
ENGINEER 		PUBLIC WORKS  CAPITAL PROJECT MANAGEMENT <small>7447 E. INDIAN SCHOOL RD. SCOTTSDALE, ARIZONA 85251</small>		
SHEET TITLE				
<h1>EAST BOWL - ANCHOR DETAILS</h1>				
PROJECT TITLE		CITY OF SCOTTSDALE CIVIC CENTER PLAZA		
D R	SCALE	DESIGNED	BID NO.	
	DRAWN DS	AS-BUILT	COS PROJECT NO. DG04	
				XC-A506

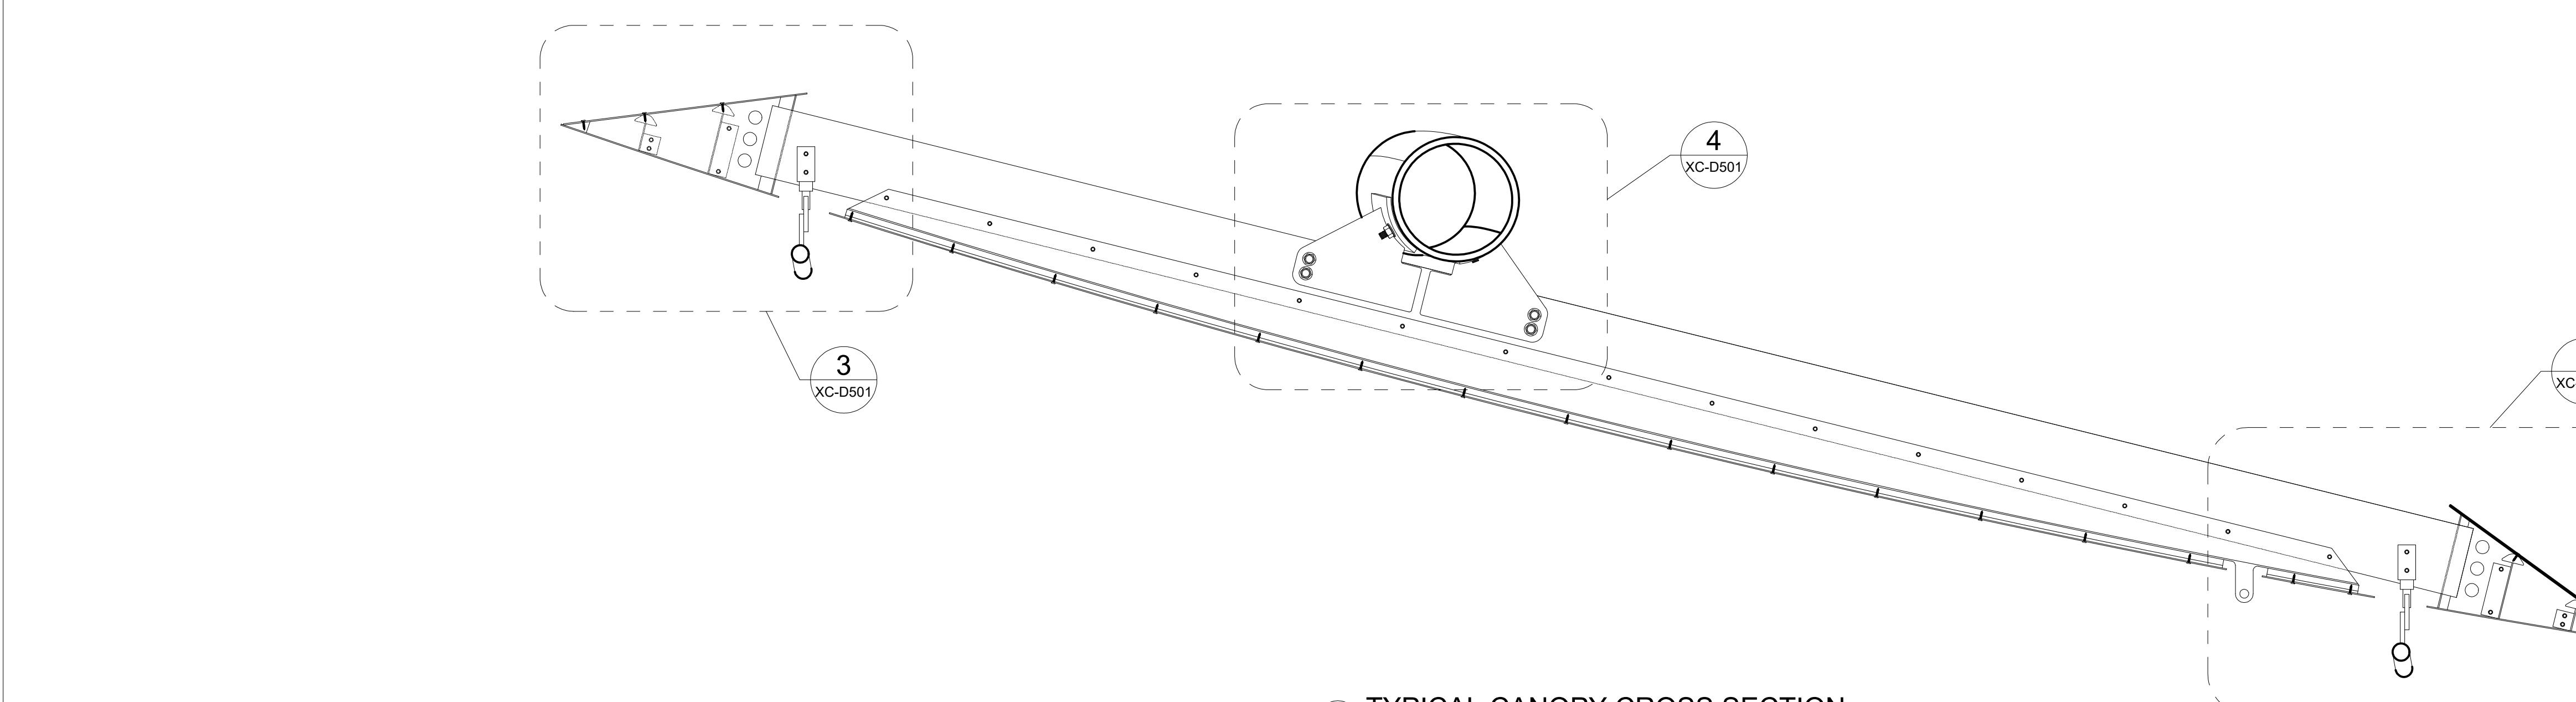


1 TYPICAL CANOPY CROSS SECTION

SCALE: 1" = 1'-0"
ZAHNER REF: N/A
ARCH REF: N/A

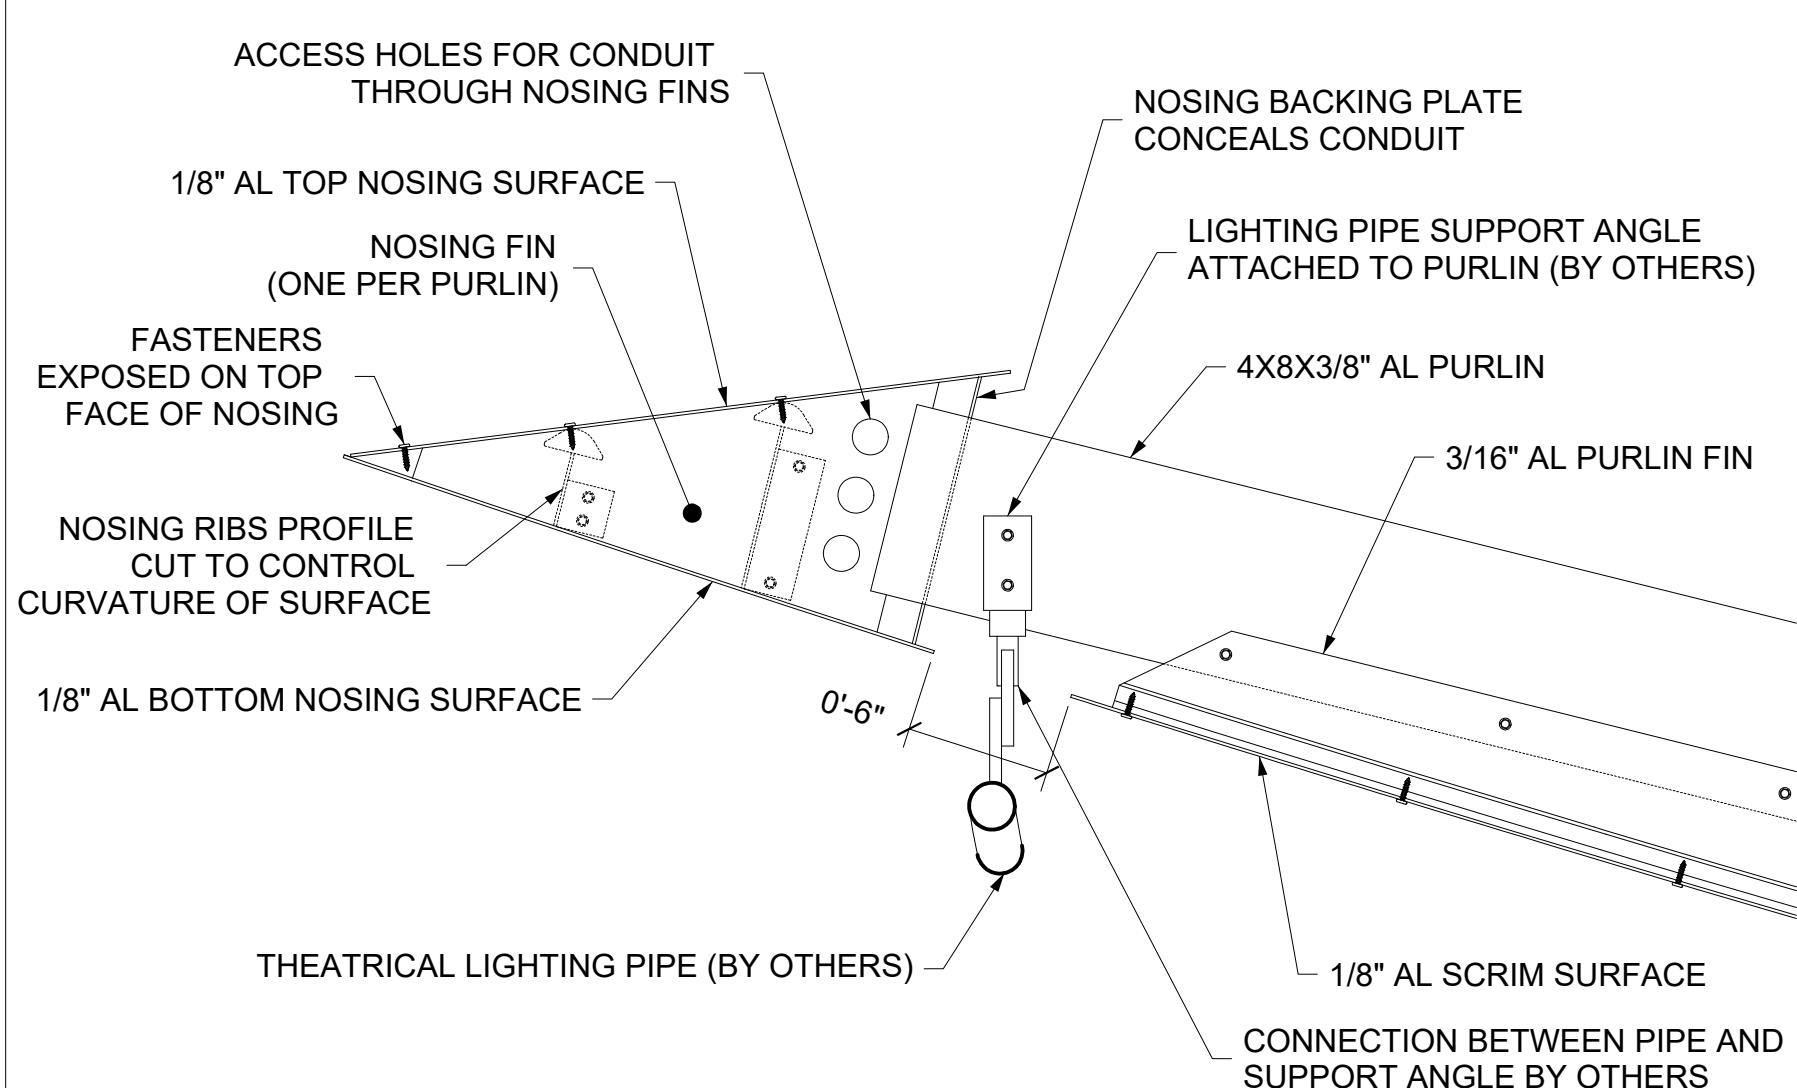


3 OUTSIDE NOSING DETAIL

SCALE: 1" = 1'-0"
ZAHNER REF: N/A
ARCH REF: N/A

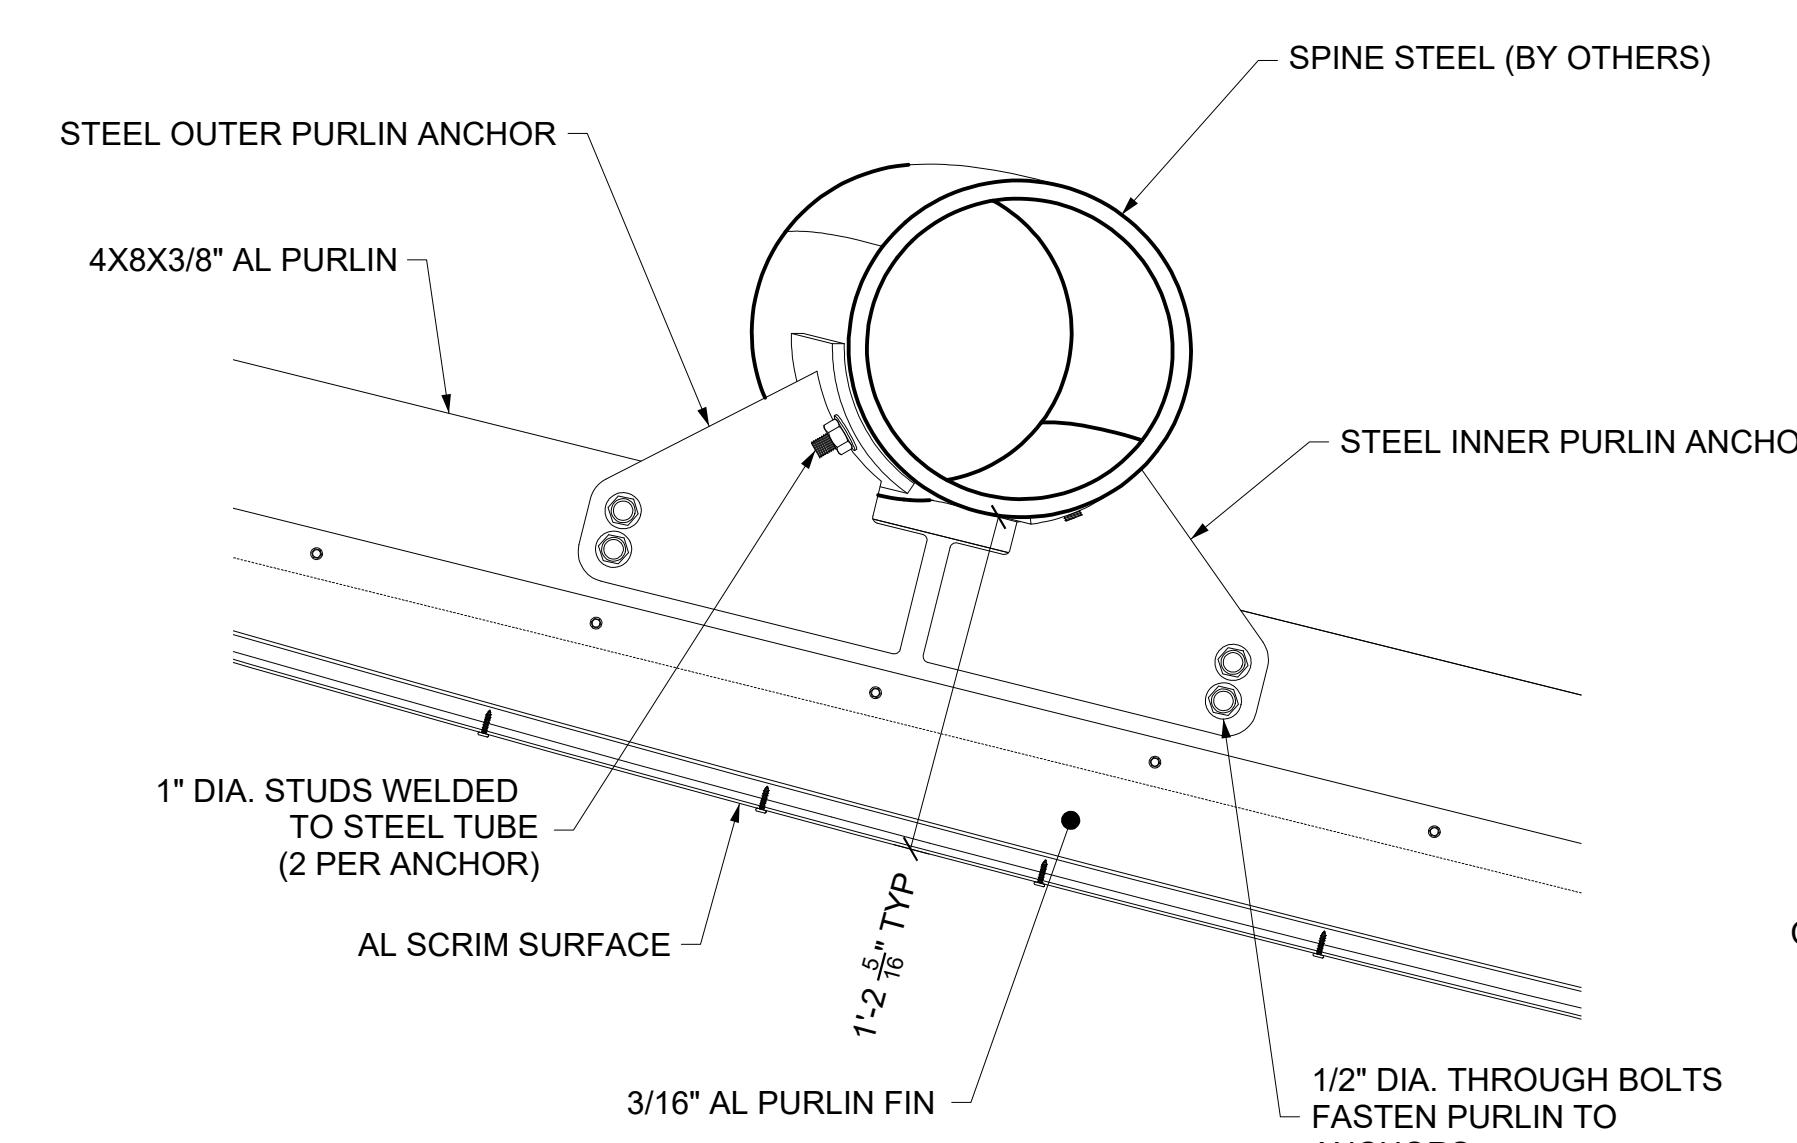


4 ANCHOR DETAIL

SCALE: 1" = 1'-0"
ZAHNER REF: N/A
ARCH REF: N/A

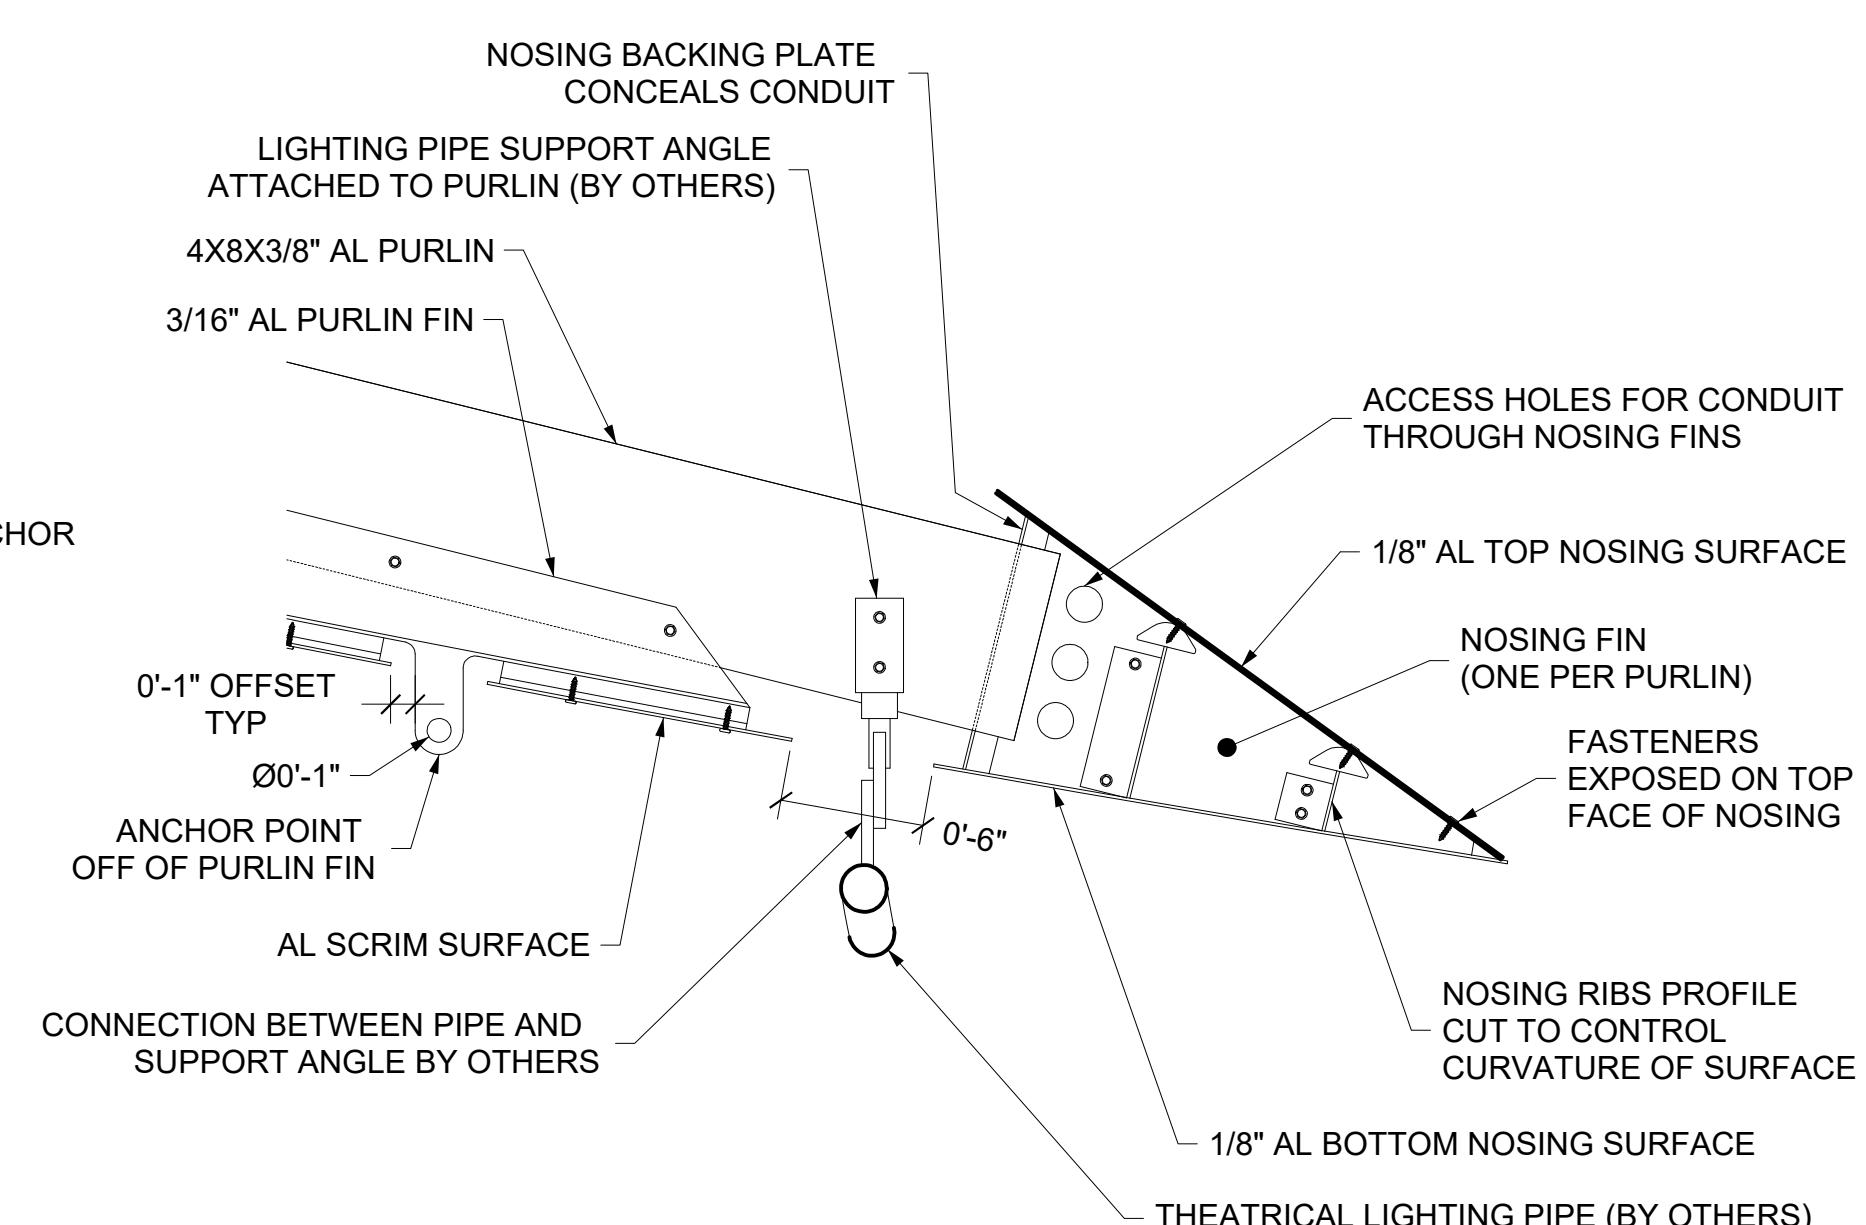


5 INSIDE NOSING DETAIL

SCALE: 1" = 1'-0"
ZAHNER REF: N/A
ARCH REF: N/A

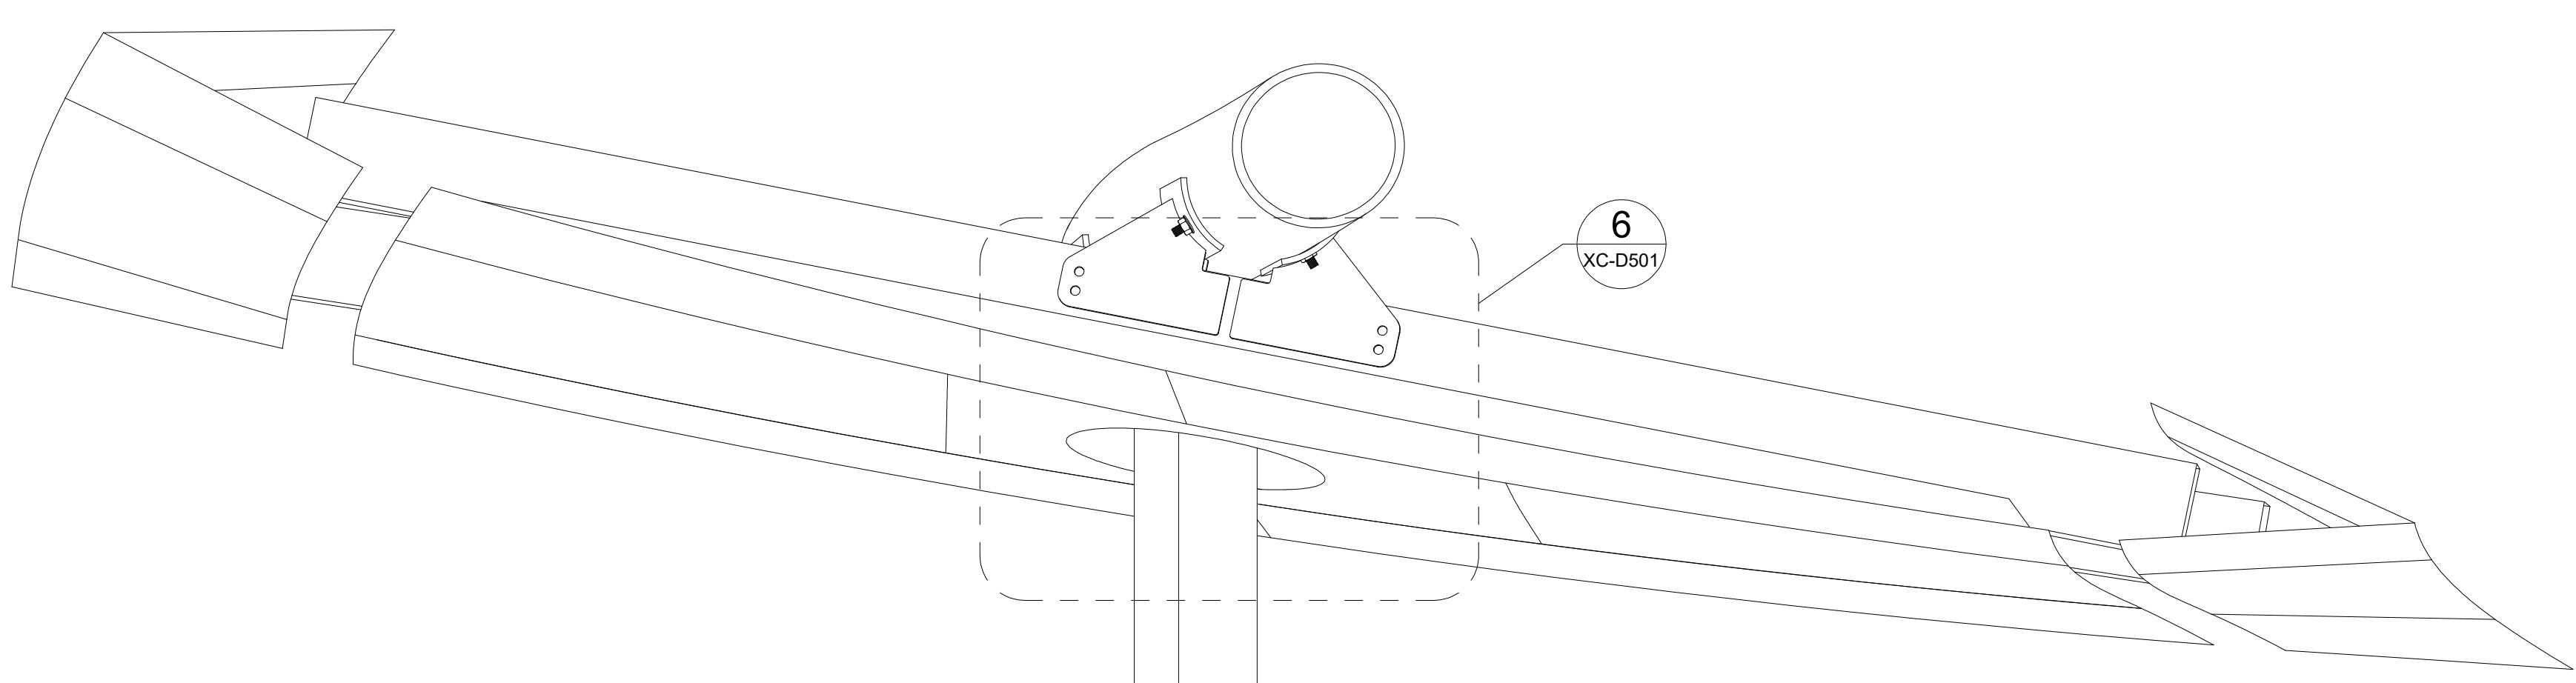

2 CANOPY CROSS SECTION AT COLUMNS

SCALE: 1" = 1'-0"
ZAHNER REF: N/A
ARCH REF: N/A

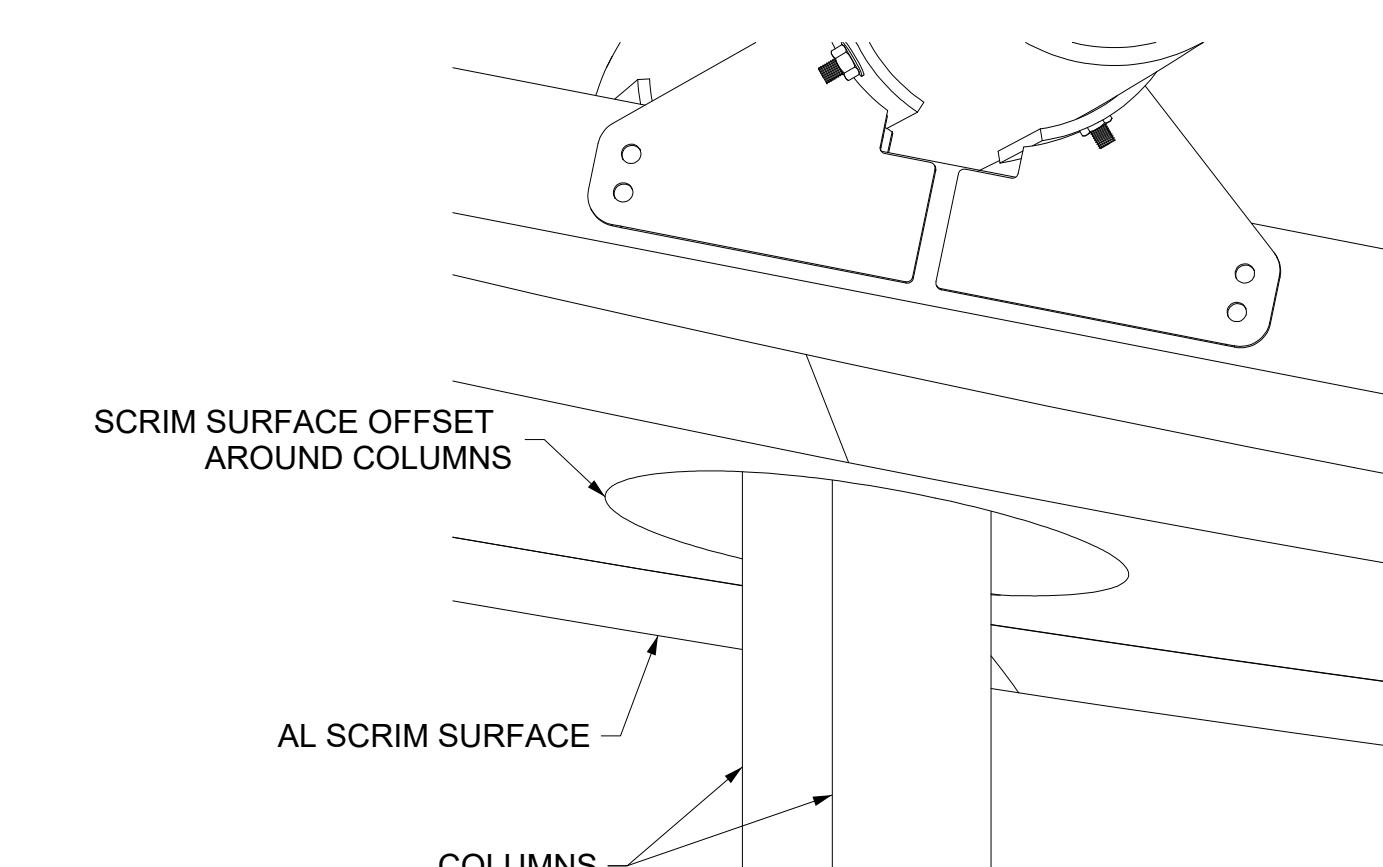

6 SCRIM DETAIL AT COLUMN


SCALE: 1" = 1'-0"
ZAHNER REF: N/A
ARCH REF: N/A

THIS SHEET SCALED
FOR 24X36" BORDER

SCALE	DESIGNED	BID NO.	XC-D501
DRAWN DS	AS-BUILT	COS PROJECT NO.	DG04

SET ISSUE DATES	
DATE	ISSUE
01/20/22 100% DRAWINGS	

REVISIONS		
NO.	DATE	DESCRIPTION

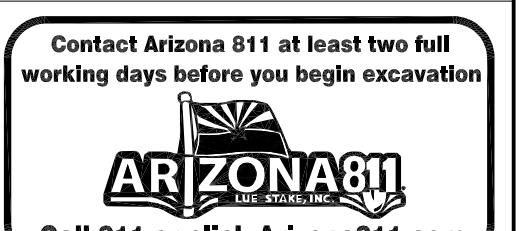

DATE: 01/20/2022 | REVISION: BY:

ENGINEER	PUBLIC WORKS
	CAPITAL PROJECT MANAGEMENT
	7447 E. INDIAN SCHOOL RD., SCOTTSDALE, ARIZONA 85251


SHEET TITLE

360 CANOPY - TYPICAL CANOPY SECTION DETAILS

PROJECT TITLE


CITY OF SCOTTSDALE
CIVIC CENTER PLAZA

SCALE	DESIGNED	BID NO.	XC-D501
DRAWN DS	AS-BUILT	COS PROJECT NO.	DG04

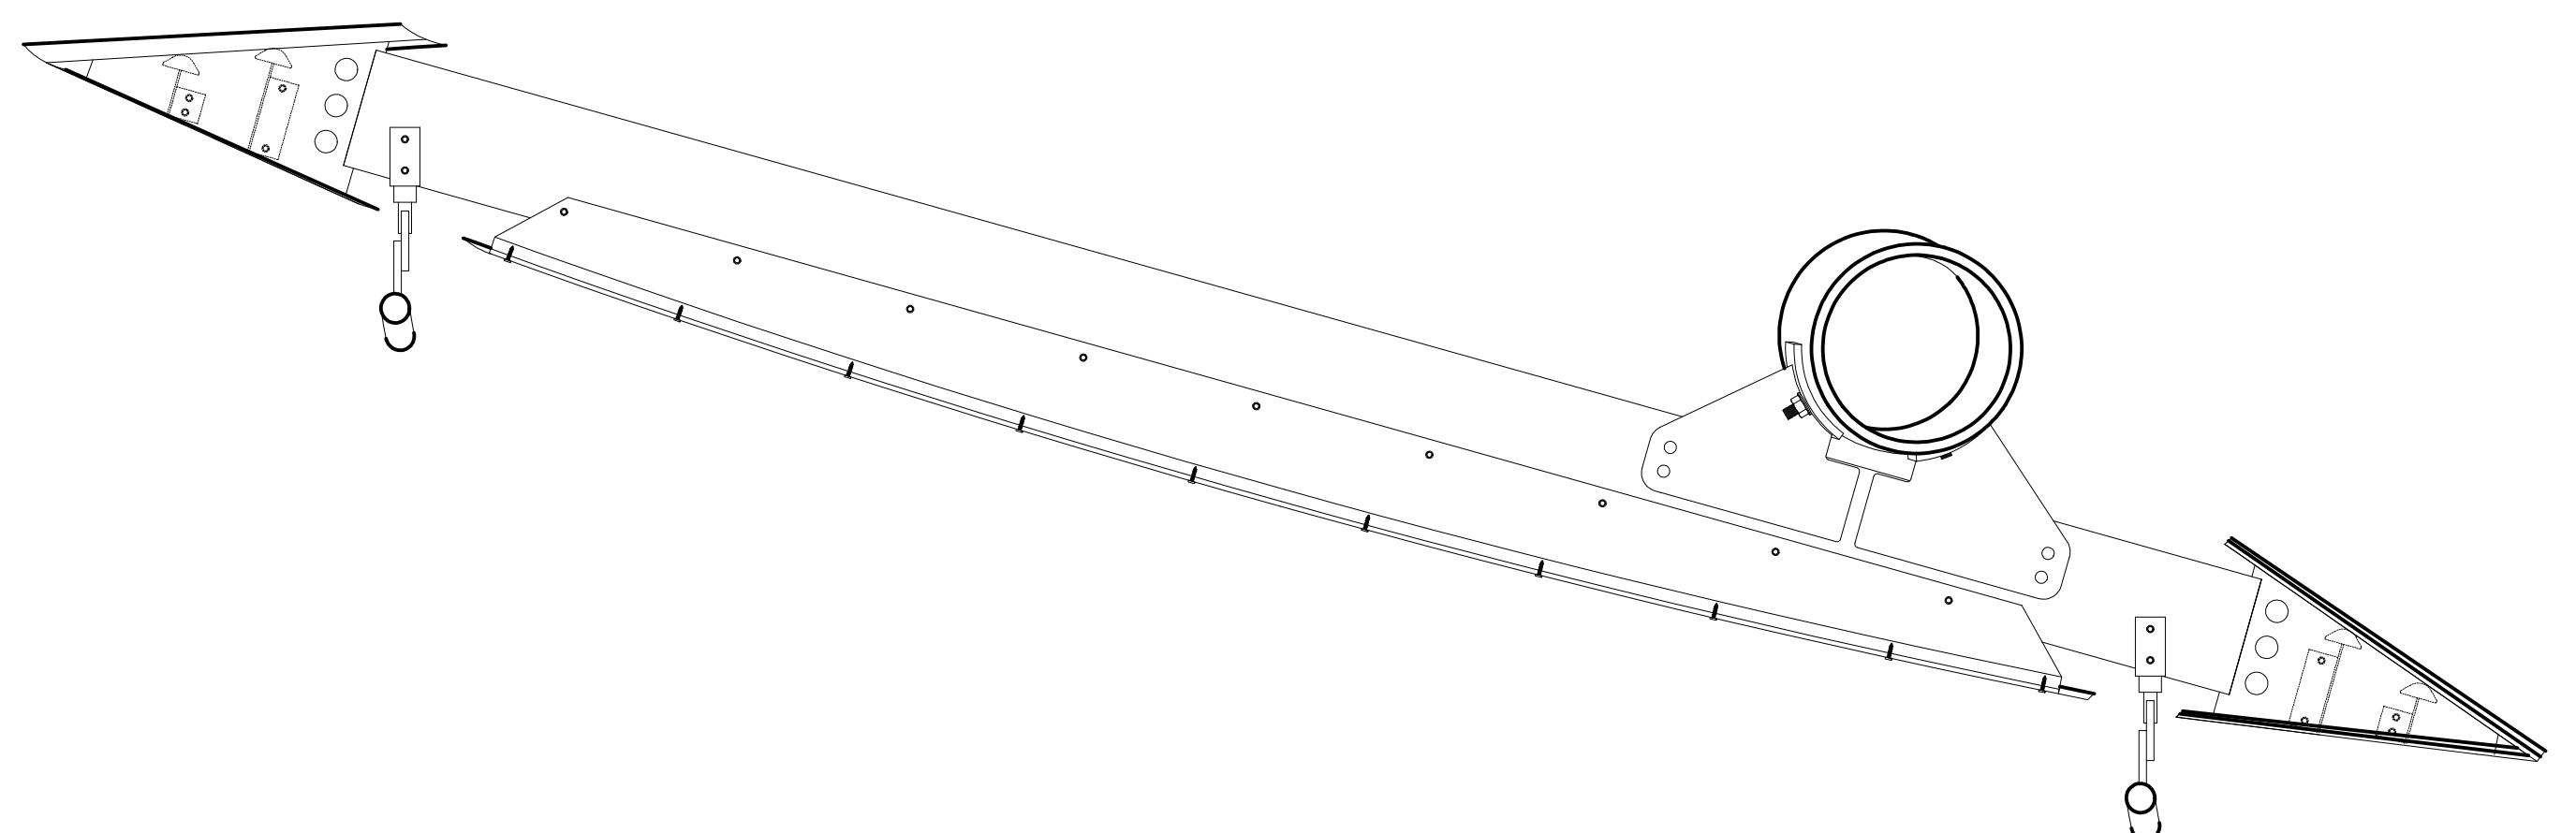

① CANOPY CROSS SECTION AT WALKING PATH


SCALE: 1" = 1'-0"
ZAHNER REF: N/A
ARCH REF: N/A

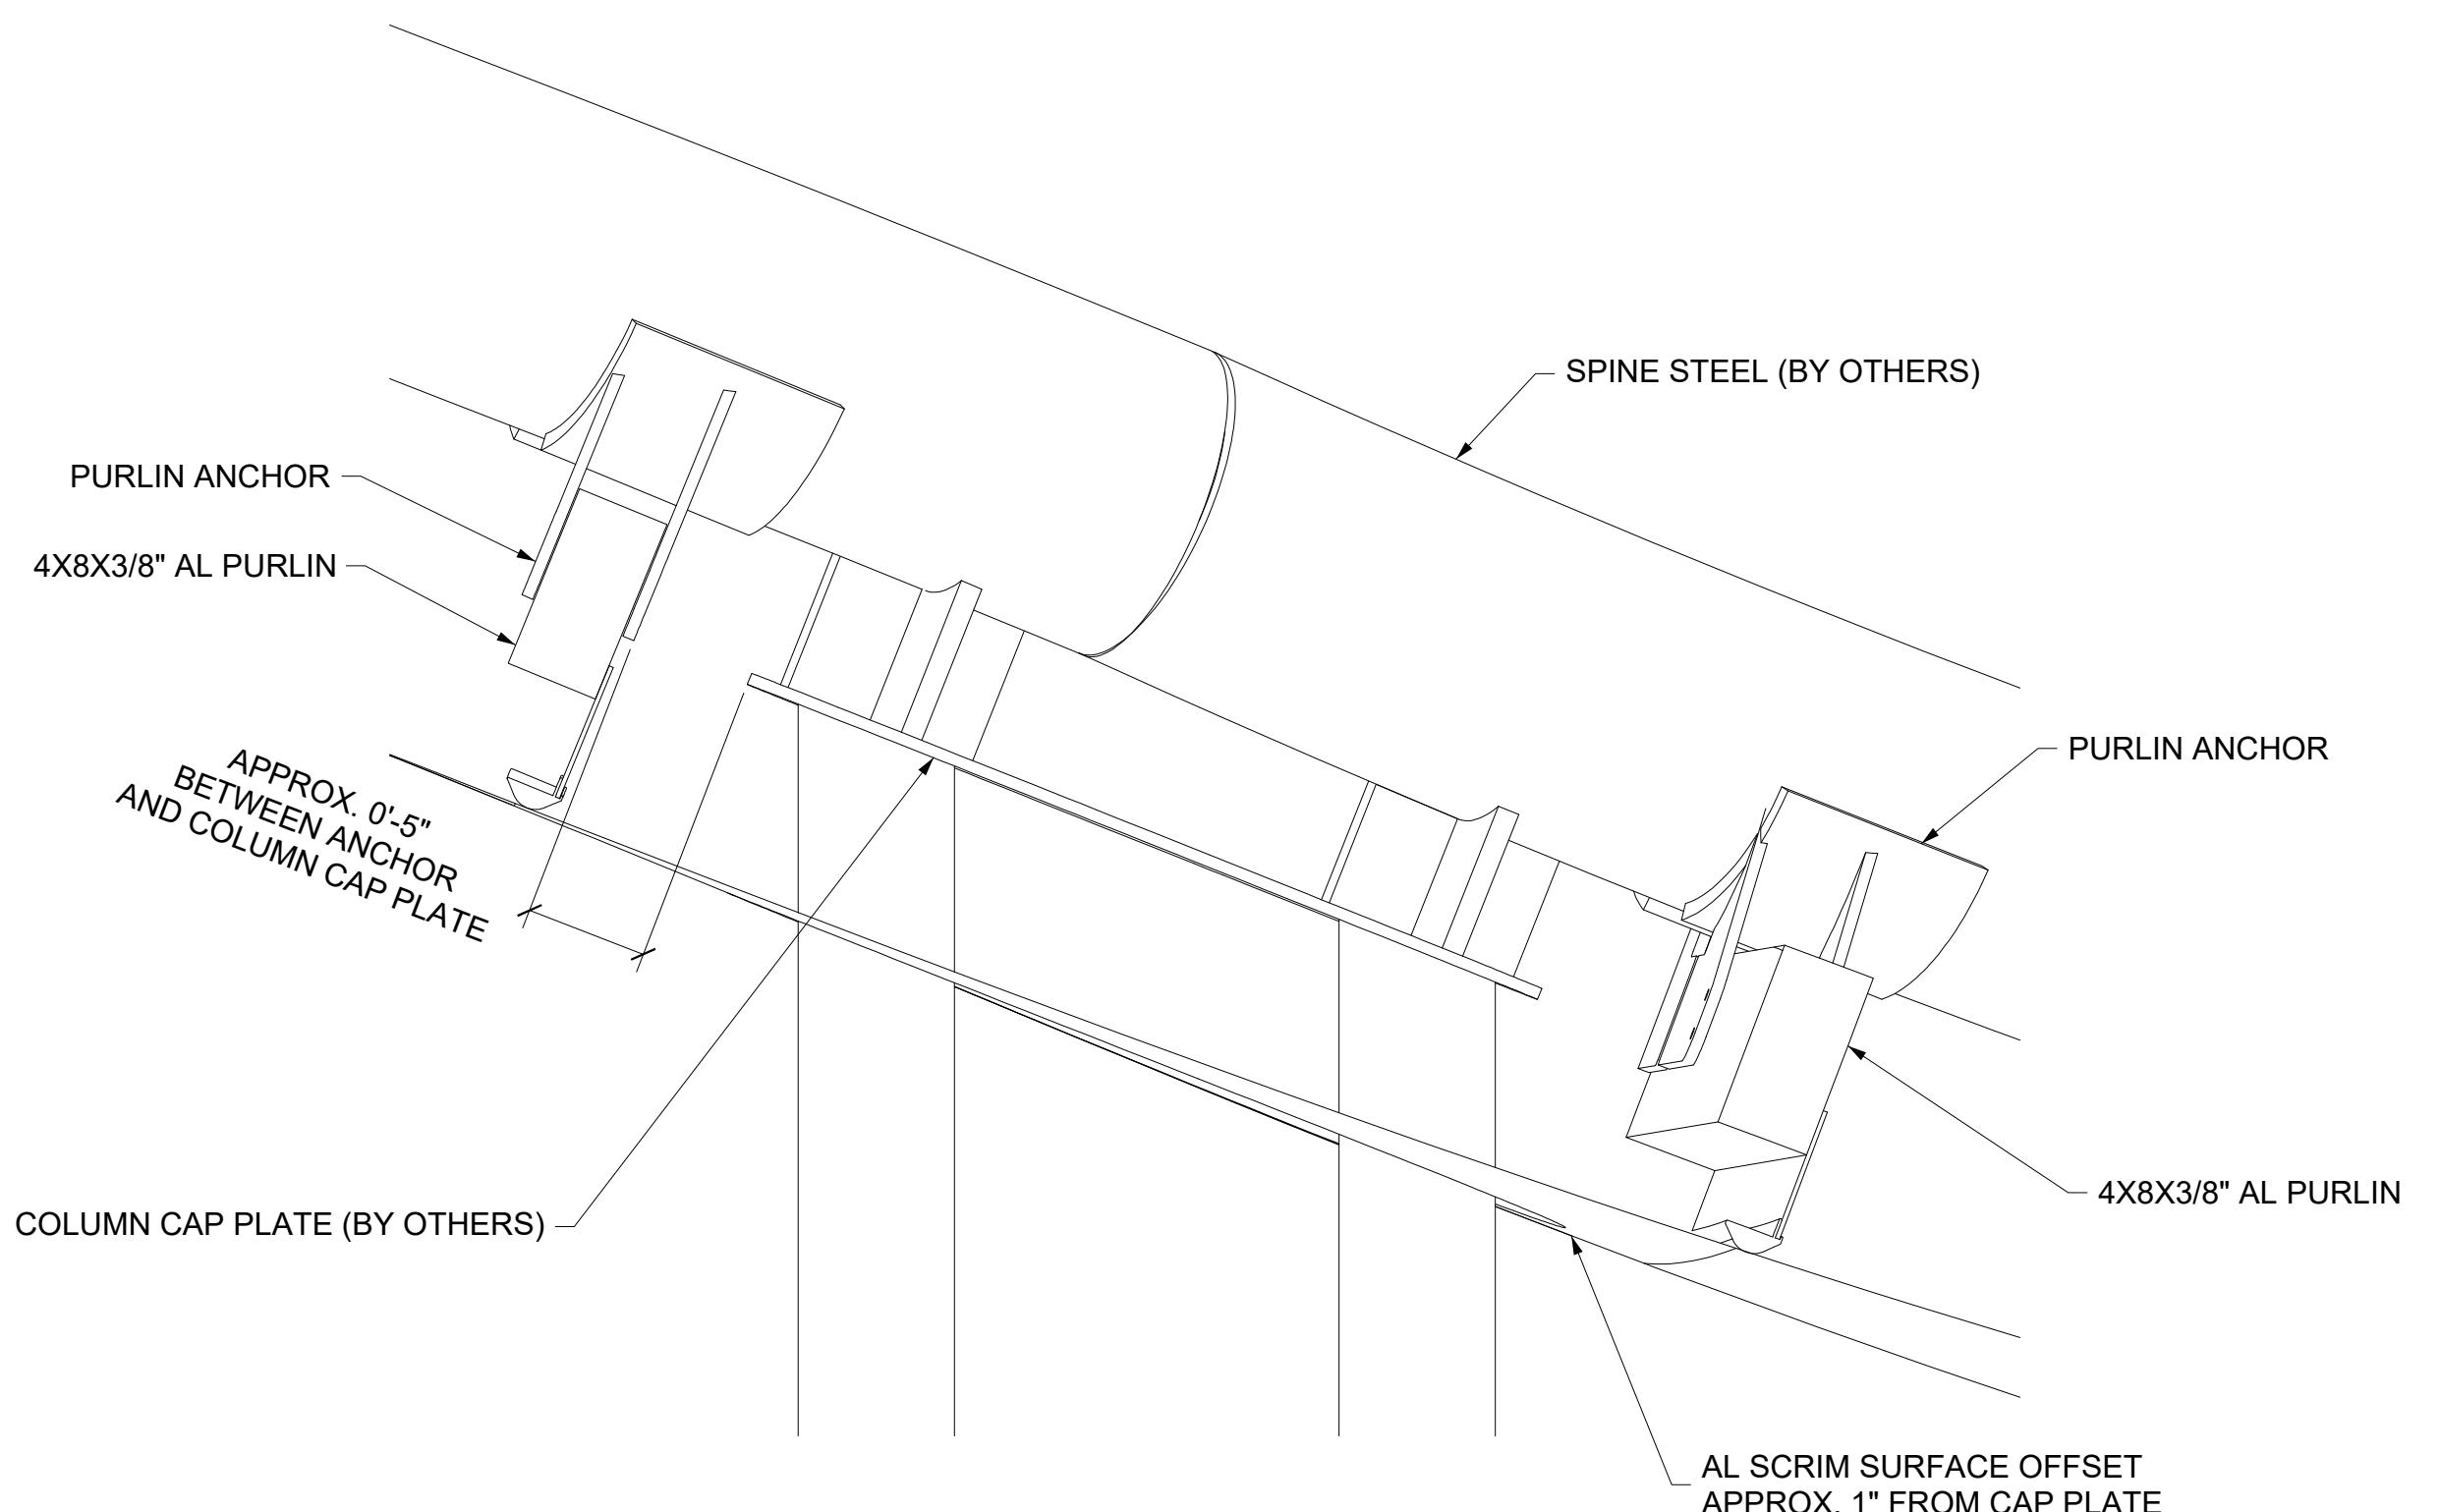

② CANOPY CROSS SECTION AT COLUMNS

SCALE: 1 1/2" = 1'-0"
ZAHNER REF: N/A
ARCH REF: N/A

SET ISSUE DATES		
DATE	ISSUE	
01/20/22 100% DRAWINGS		
REVISIONS		
NO.	DATE	DESCRIPTION

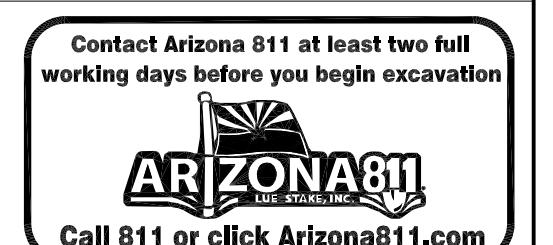

DATE: 01/20/2022 REVISION: BY:		
ENGINEER	PUBLIC WORKS	
CAPITAL PROJECT MANAGEMENT		
7447 E. INDIAN SCHOOL RD., SCOTTSDALE, ARIZONA 85251		
SHEET TITLE	360 CANOPY - CROSS SECTION AT WALKING PATH	
PROJECT TITLE	CITY OF SCOTTSDALE CIVIC CENTER PLAZA	
THIS SHEET SCALED FOR 24X36" BORDER		
SCALE	DESIGNED	BID NO.
DRAWN DS	AS-BUILT	COS PROJECT NO. DG04